


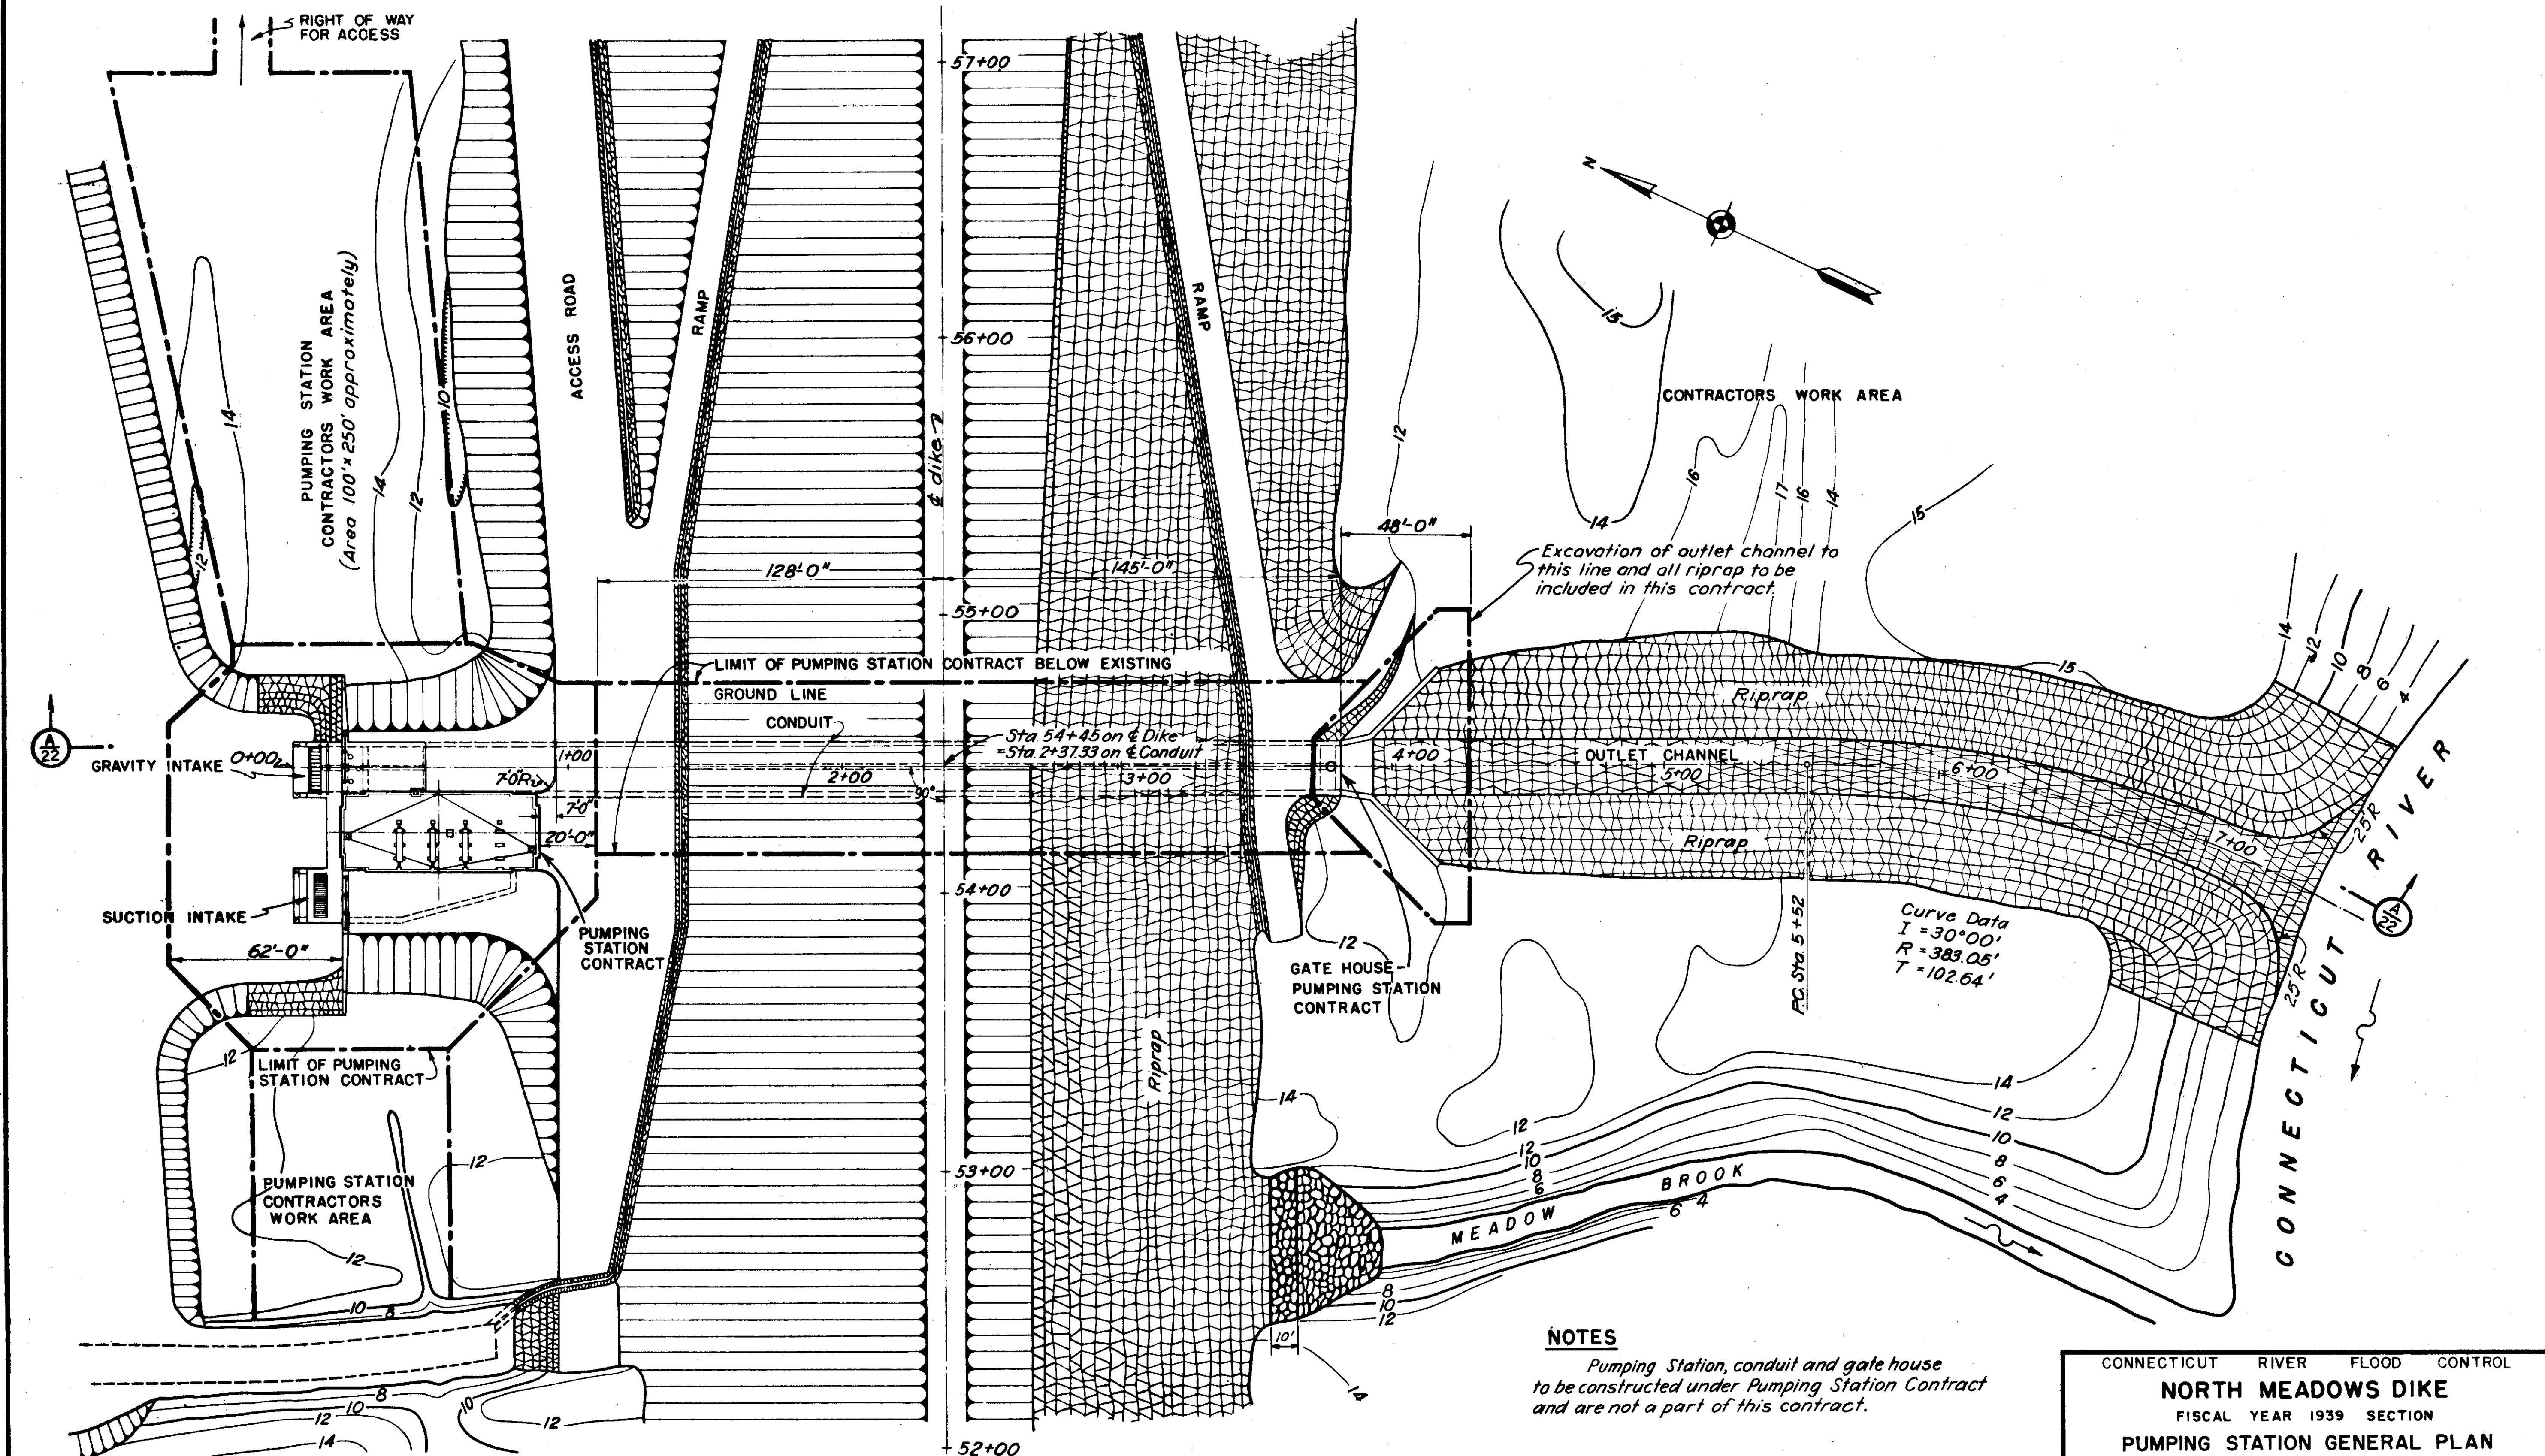

## NOTES

Pumping Station, conduit and gate house to be constructed under Pumping Station Contract and are not a part of this contract.

| DATE     | REVISION | REV BY | CHK BY | AP BY |
|----------|----------|--------|--------|-------|
| 12/31/45 | As-Built |        |        |       |

|                                                    |                              |
|----------------------------------------------------|------------------------------|
| CONNECTICUT RIVER FLOOD CONTROL                    |                              |
| NORTH MEADOWS DIKE                                 |                              |
| FISCAL YEAR 1939 SECTION                           |                              |
| PUMPING STATION GENERAL PLAN                       |                              |
| HARTFORD, CONN.                                    |                              |
| CONNECTICUT RIVER                                  | CONNECTICUT                  |
| IN 66 SHEETS                                       | SHEET NO 21                  |
| SCALE 1 IN. = 30 FT.                               |                              |
| U.S. ENGINEER OFFICE, PROVIDENCE, R.I., APRIL 1939 |                              |
| SUBMITTED: <i>David B. Hartley</i>                 | APPROVED: <i>W. B. Mc...</i> |
| SENIOR ENGINEER                                    | PRINCIPAL ENGINEER           |
| HEAD, DESIGN SECTION                               | CHIEF, F.C. ENGINEERING DIV. |
| DESIGNED: <i>Hartley</i>                           | DRAWN BY: N.B. MC...         |
| TRACED BY: N.B. MC...                              | CHECKED BY: W.B. MC...       |
| FILE NO. CT-4-1450                                 |                              |