


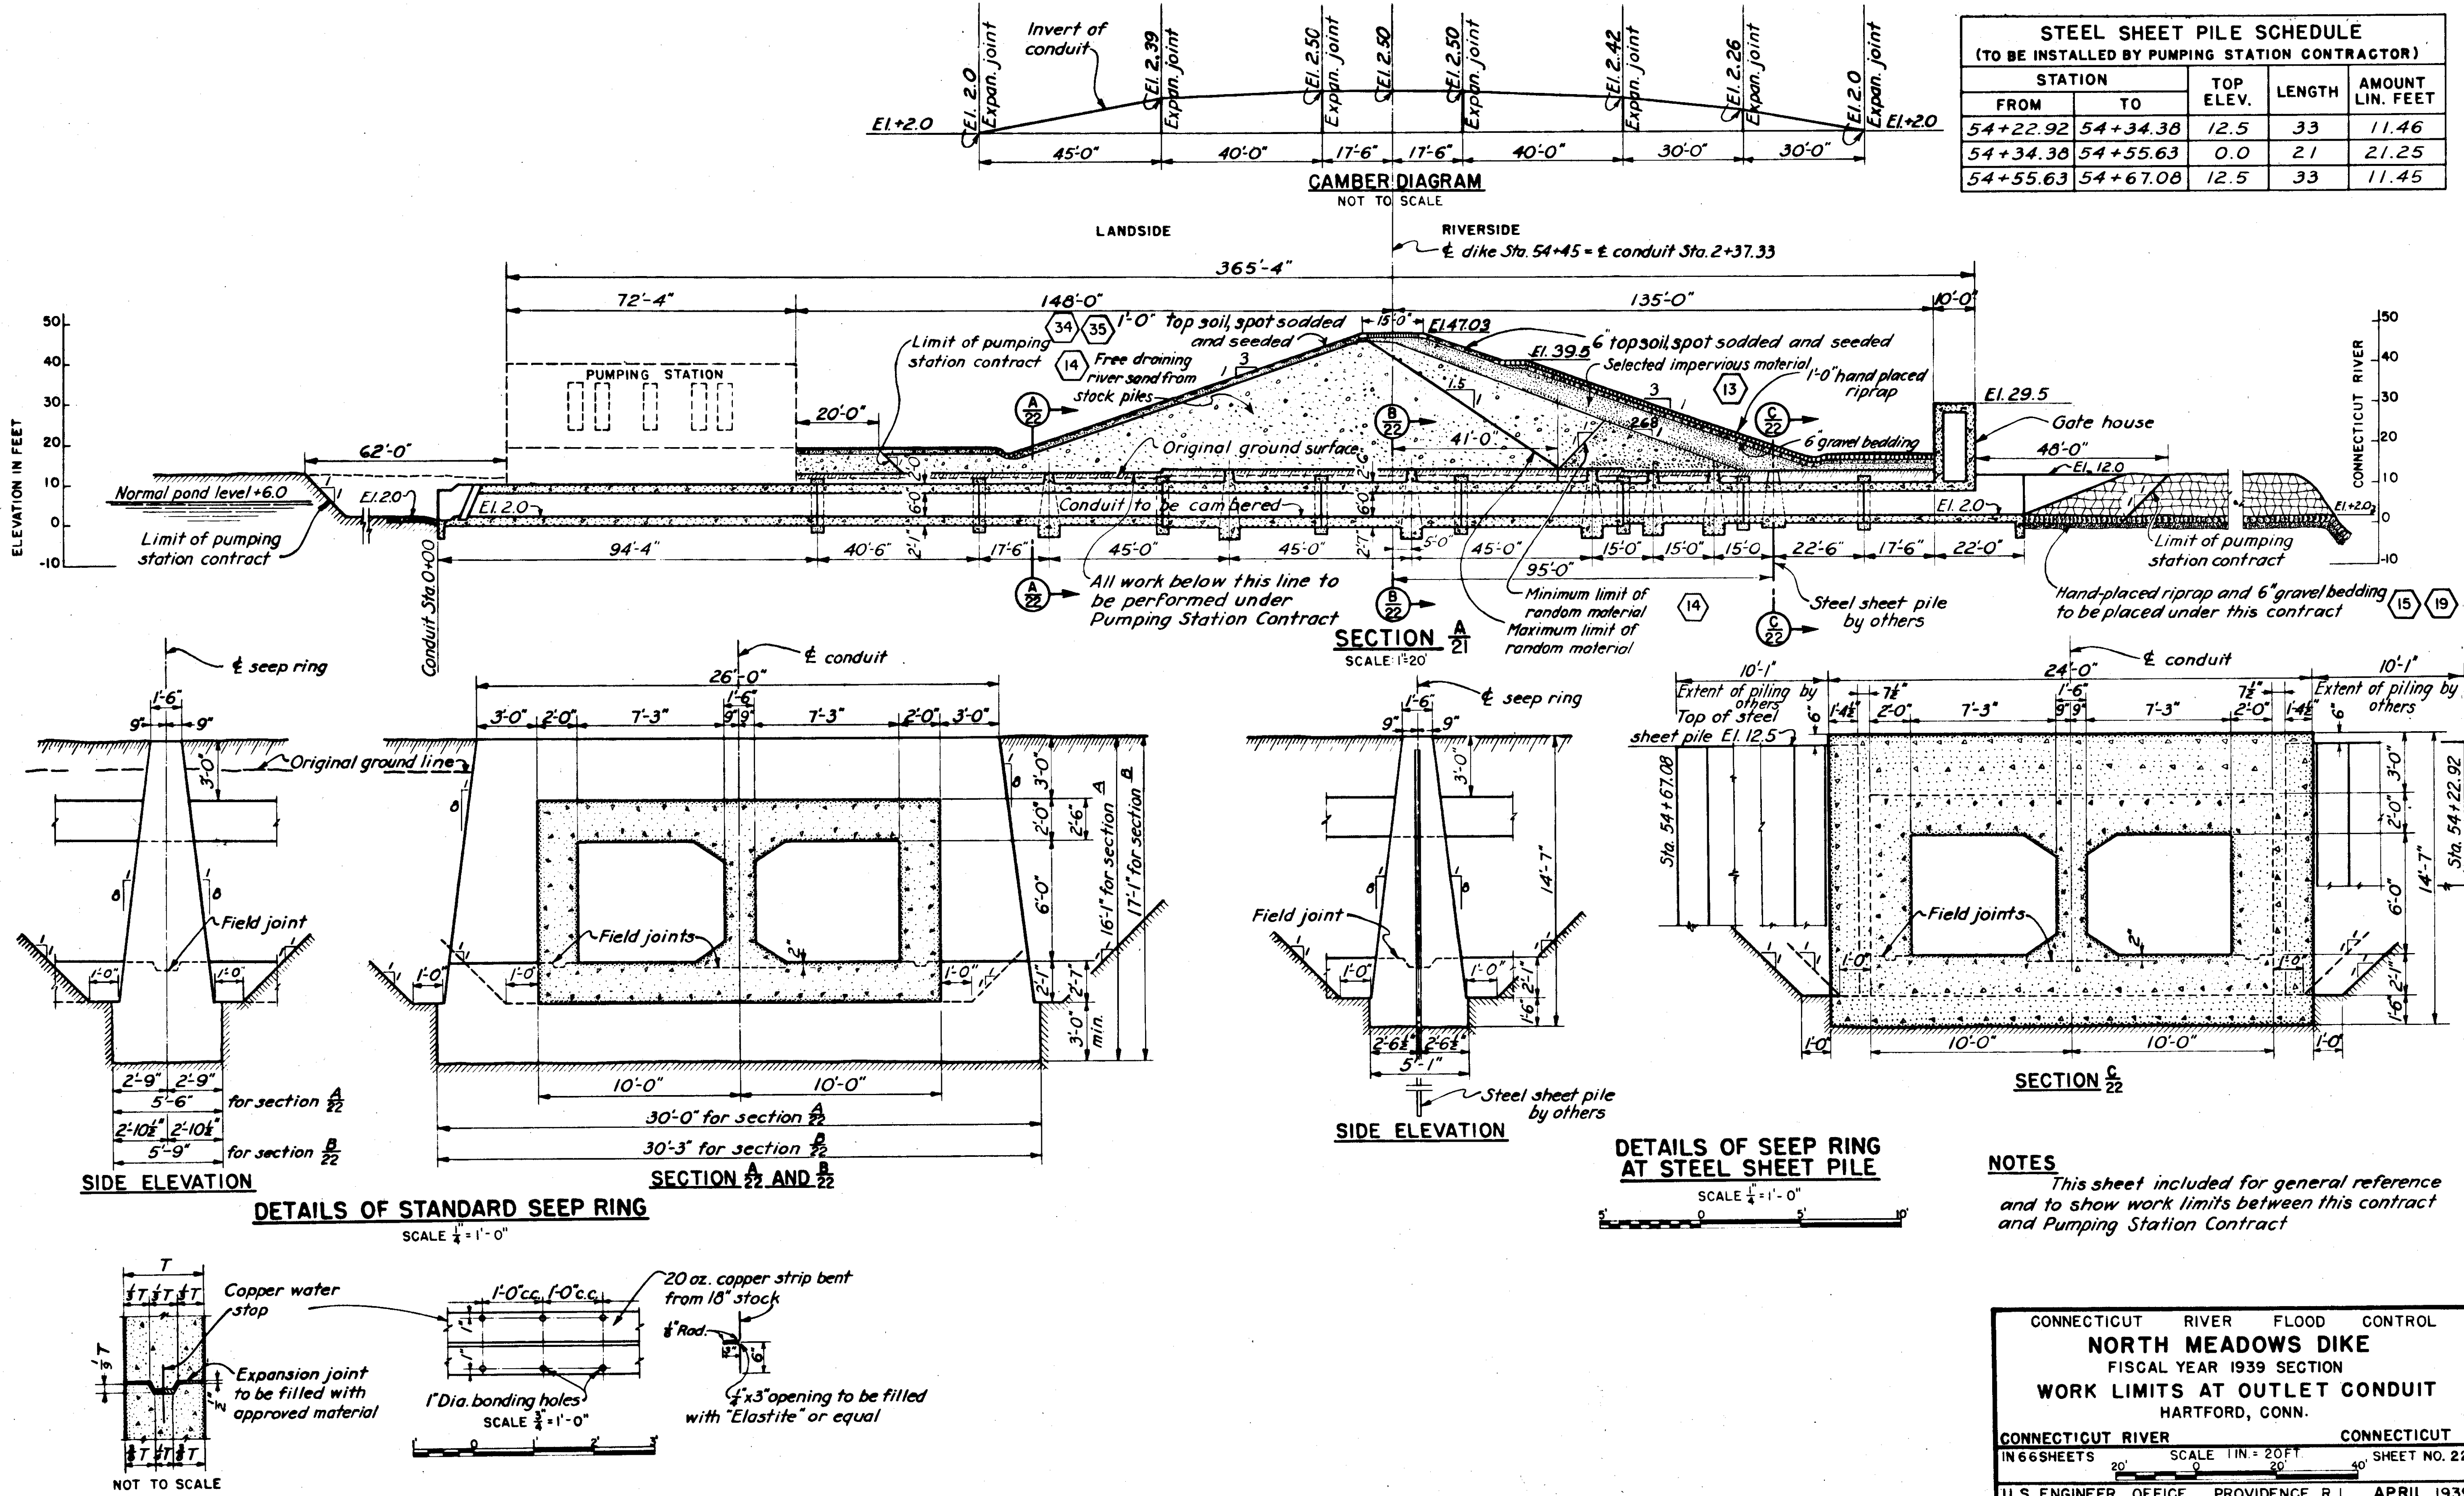

| STEEL SHEET PILE SCHEDULE                       |          |           |        |                  |
|-------------------------------------------------|----------|-----------|--------|------------------|
| (TO BE INSTALLED BY PUMPING STATION CONTRACTOR) |          |           |        |                  |
| STATION                                         |          | TOP ELEV. | LENGTH | AMOUNT LIN. FEET |
| FROM                                            | TO       |           |        |                  |
| 54+22.92                                        | 54+34.38 | 12.5      | 33     | 11.46            |
| 54+34.38                                        | 54+55.63 | 0.0       | 21     | 21.25            |
| 54+55.63                                        | 54+67.08 | 12.5      | 33     | 11.45            |

**NOTES**

This sheet included for general reference and to show work limits between this contract and Pumping Station Contract

CONNECTICUT RIVER FLOOD CONTROL

**NORTH MEADOWS DIKE**

FISCAL YEAR 1939 SECTION

**WORK LIMITS AT OUTLET CONDUIT**

HARTFORD, CONN.

CONNECTICUT RIVER

IN 66 SHEETS

CONNECTICUT

SHEET NO. 22

U. S. ENGINEER OFFICE, PROVIDENCE, R. I.

APRIL 1939

SUBMITTED: *W. H. H. H.*

APPROVAL: *W. H. H. H.*

DESIGNED: *W. H. H. H.*

DRAWN BY: *W. H. H. H.*

TRACED BY: *W. H. H. H.*

CHECKED BY: *W. H. H. H.*

SENIOR ENGINEER

PRINCIPAL ENGINEER

HEAD DESIGN SECTION

CHIEF, E. C. ENGINEERING DIV.

ASSOC. ENGINEER

LT. COL. CORPS ENGINEERS

FILE NO. CT-4-1451

|          |          |         |        |        |  |
|----------|----------|---------|--------|--------|--|
| 12/31/45 | As-Built |         |        |        |  |
| DATE     | REVISION | REV. BY | CK. BY | AR. BY |  |