
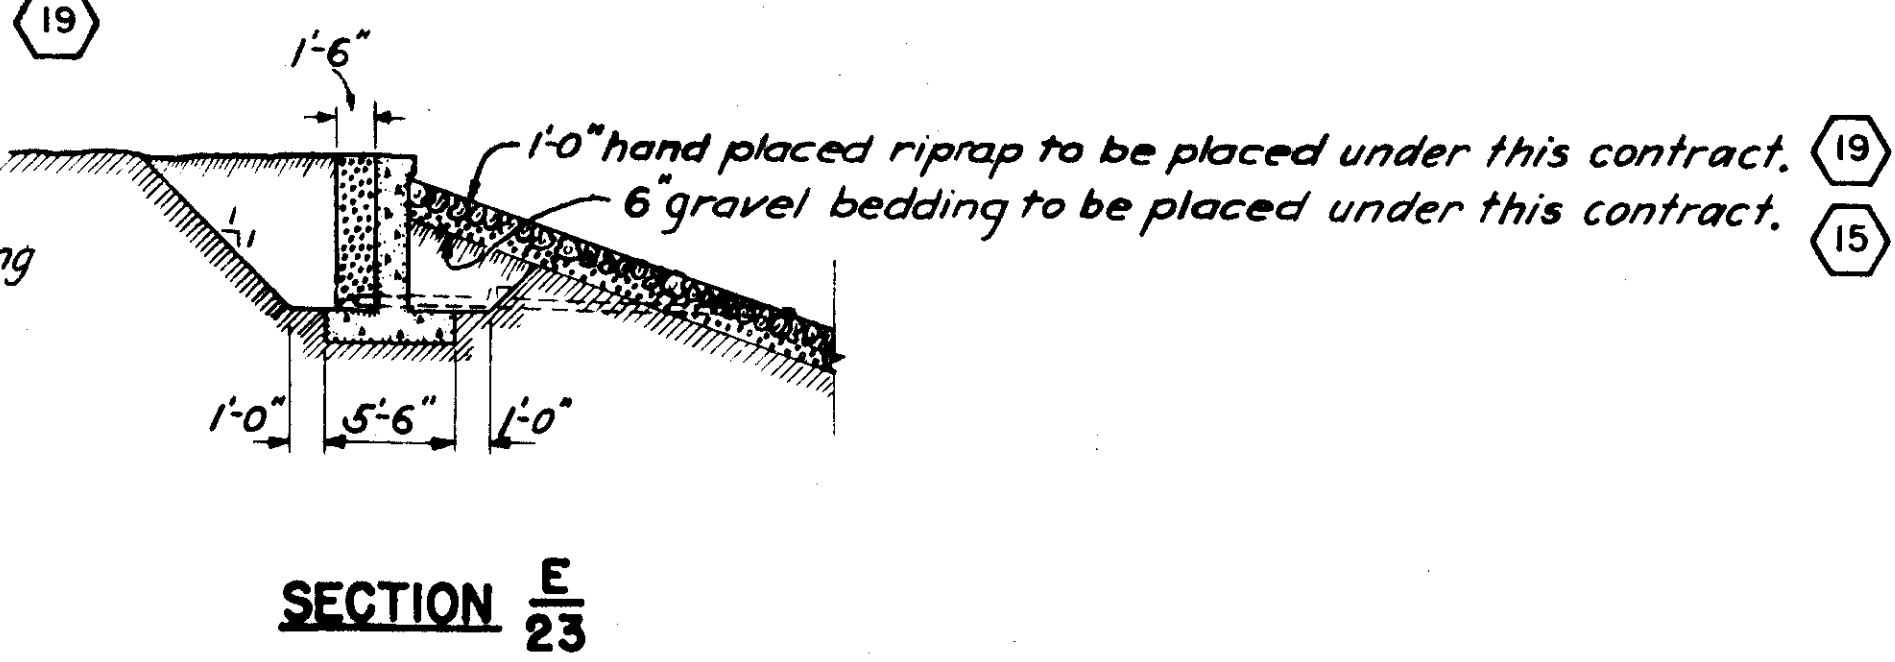
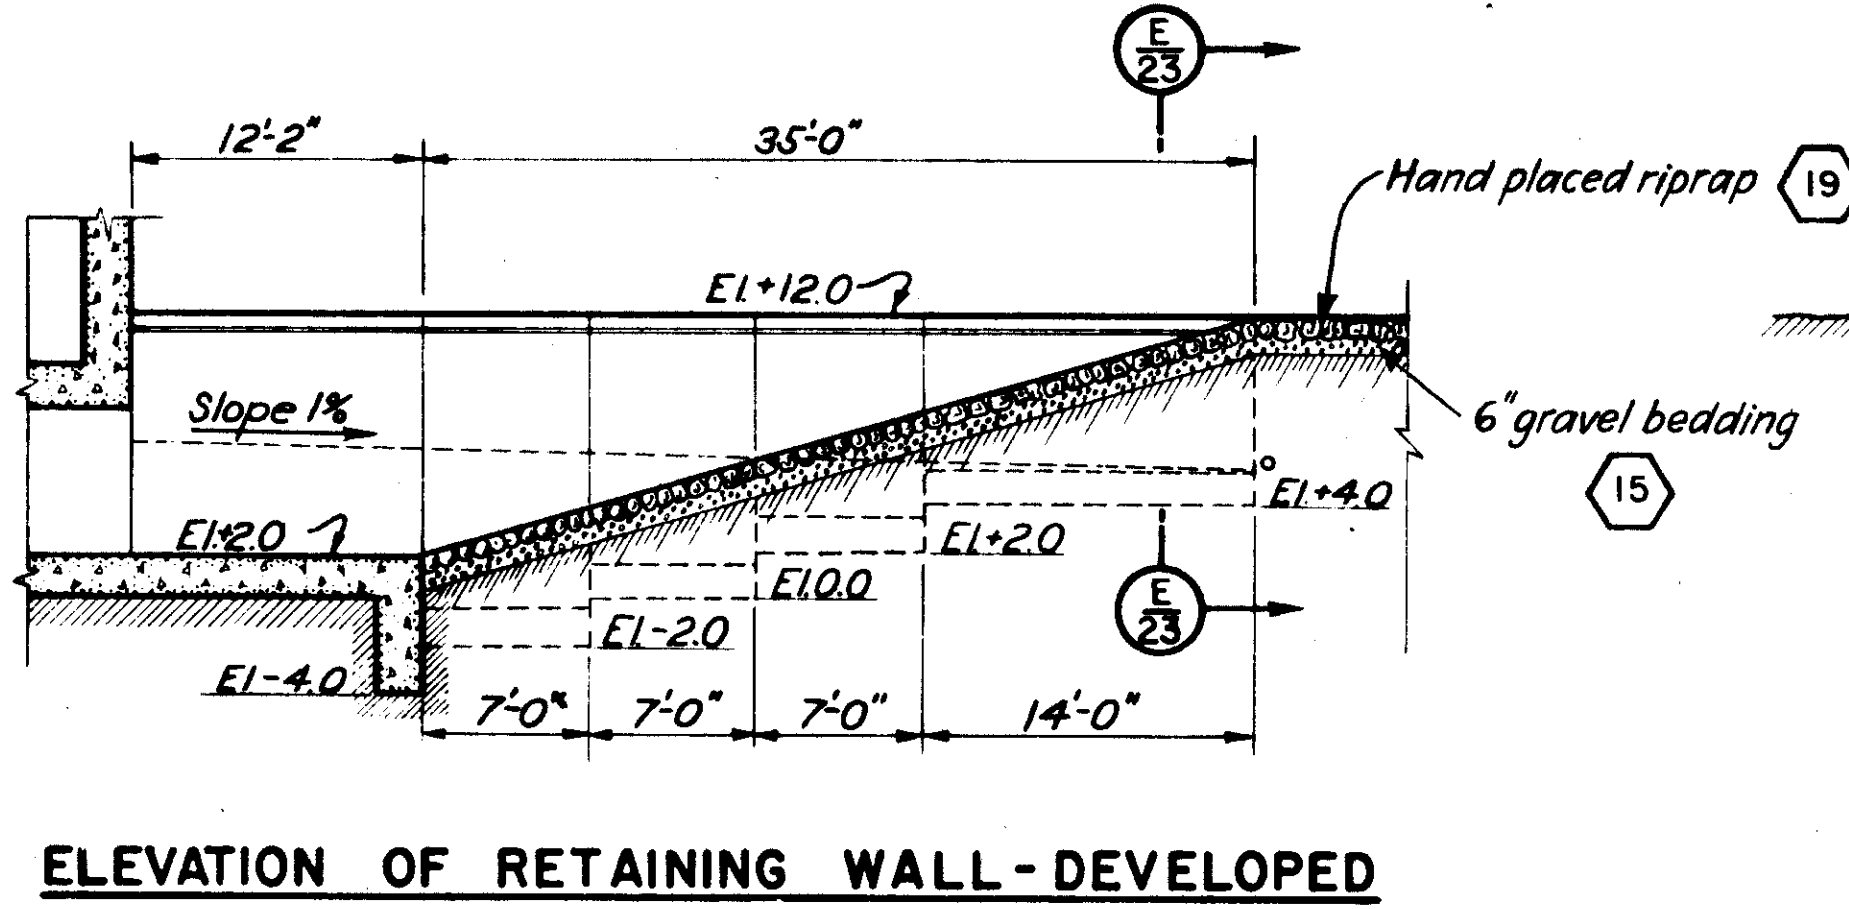
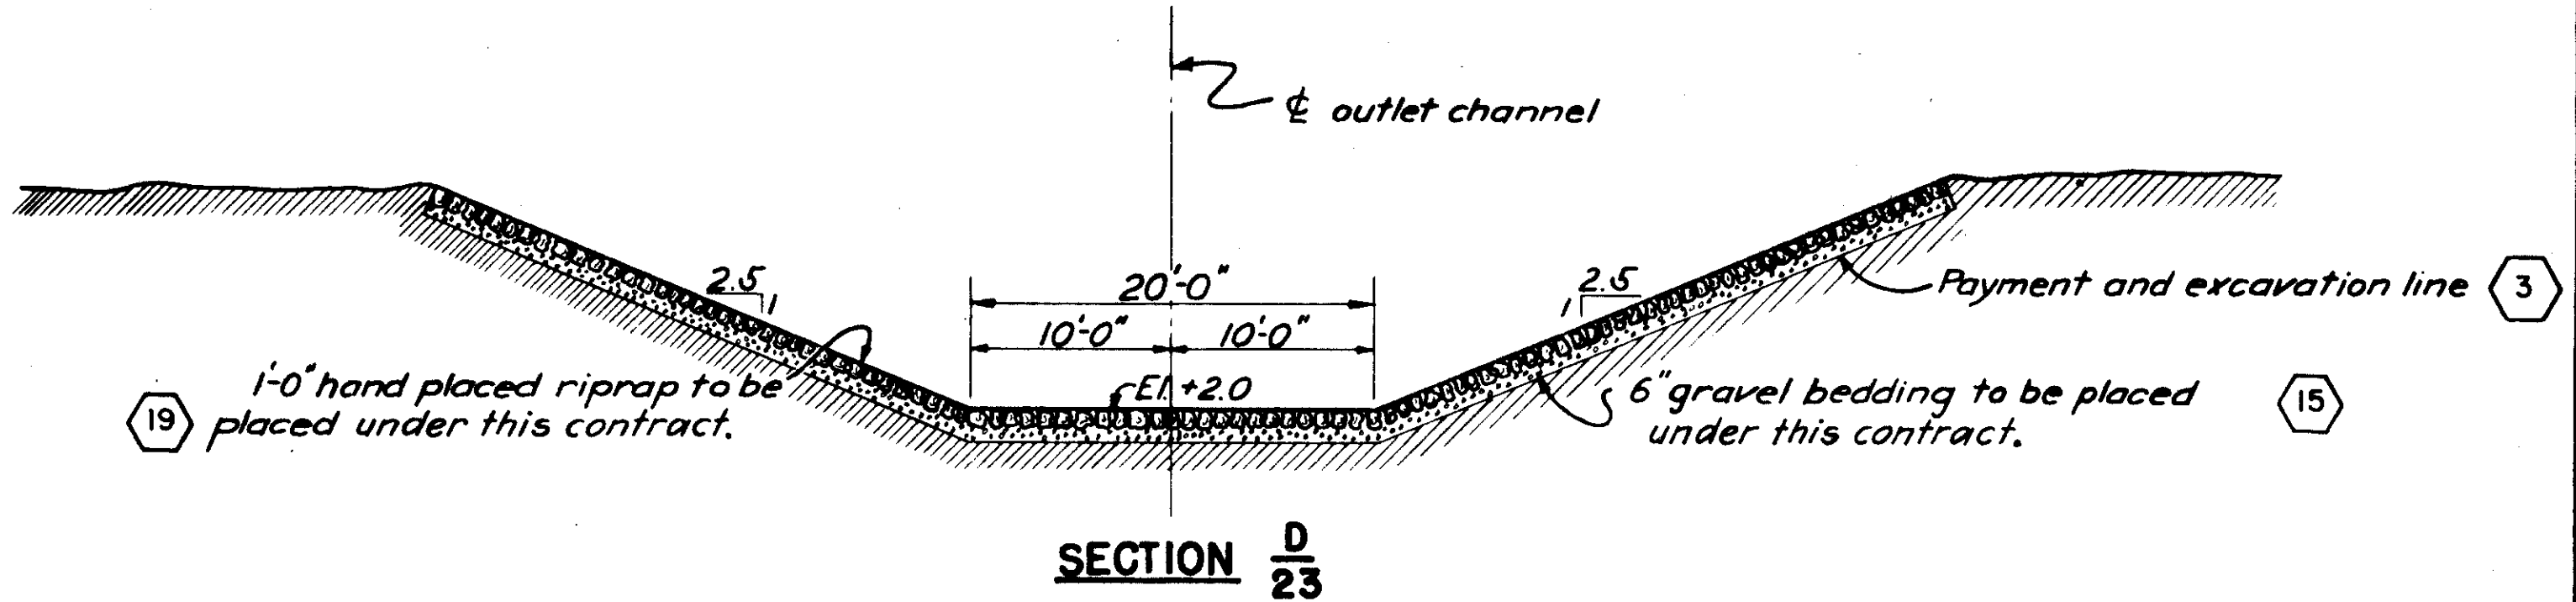
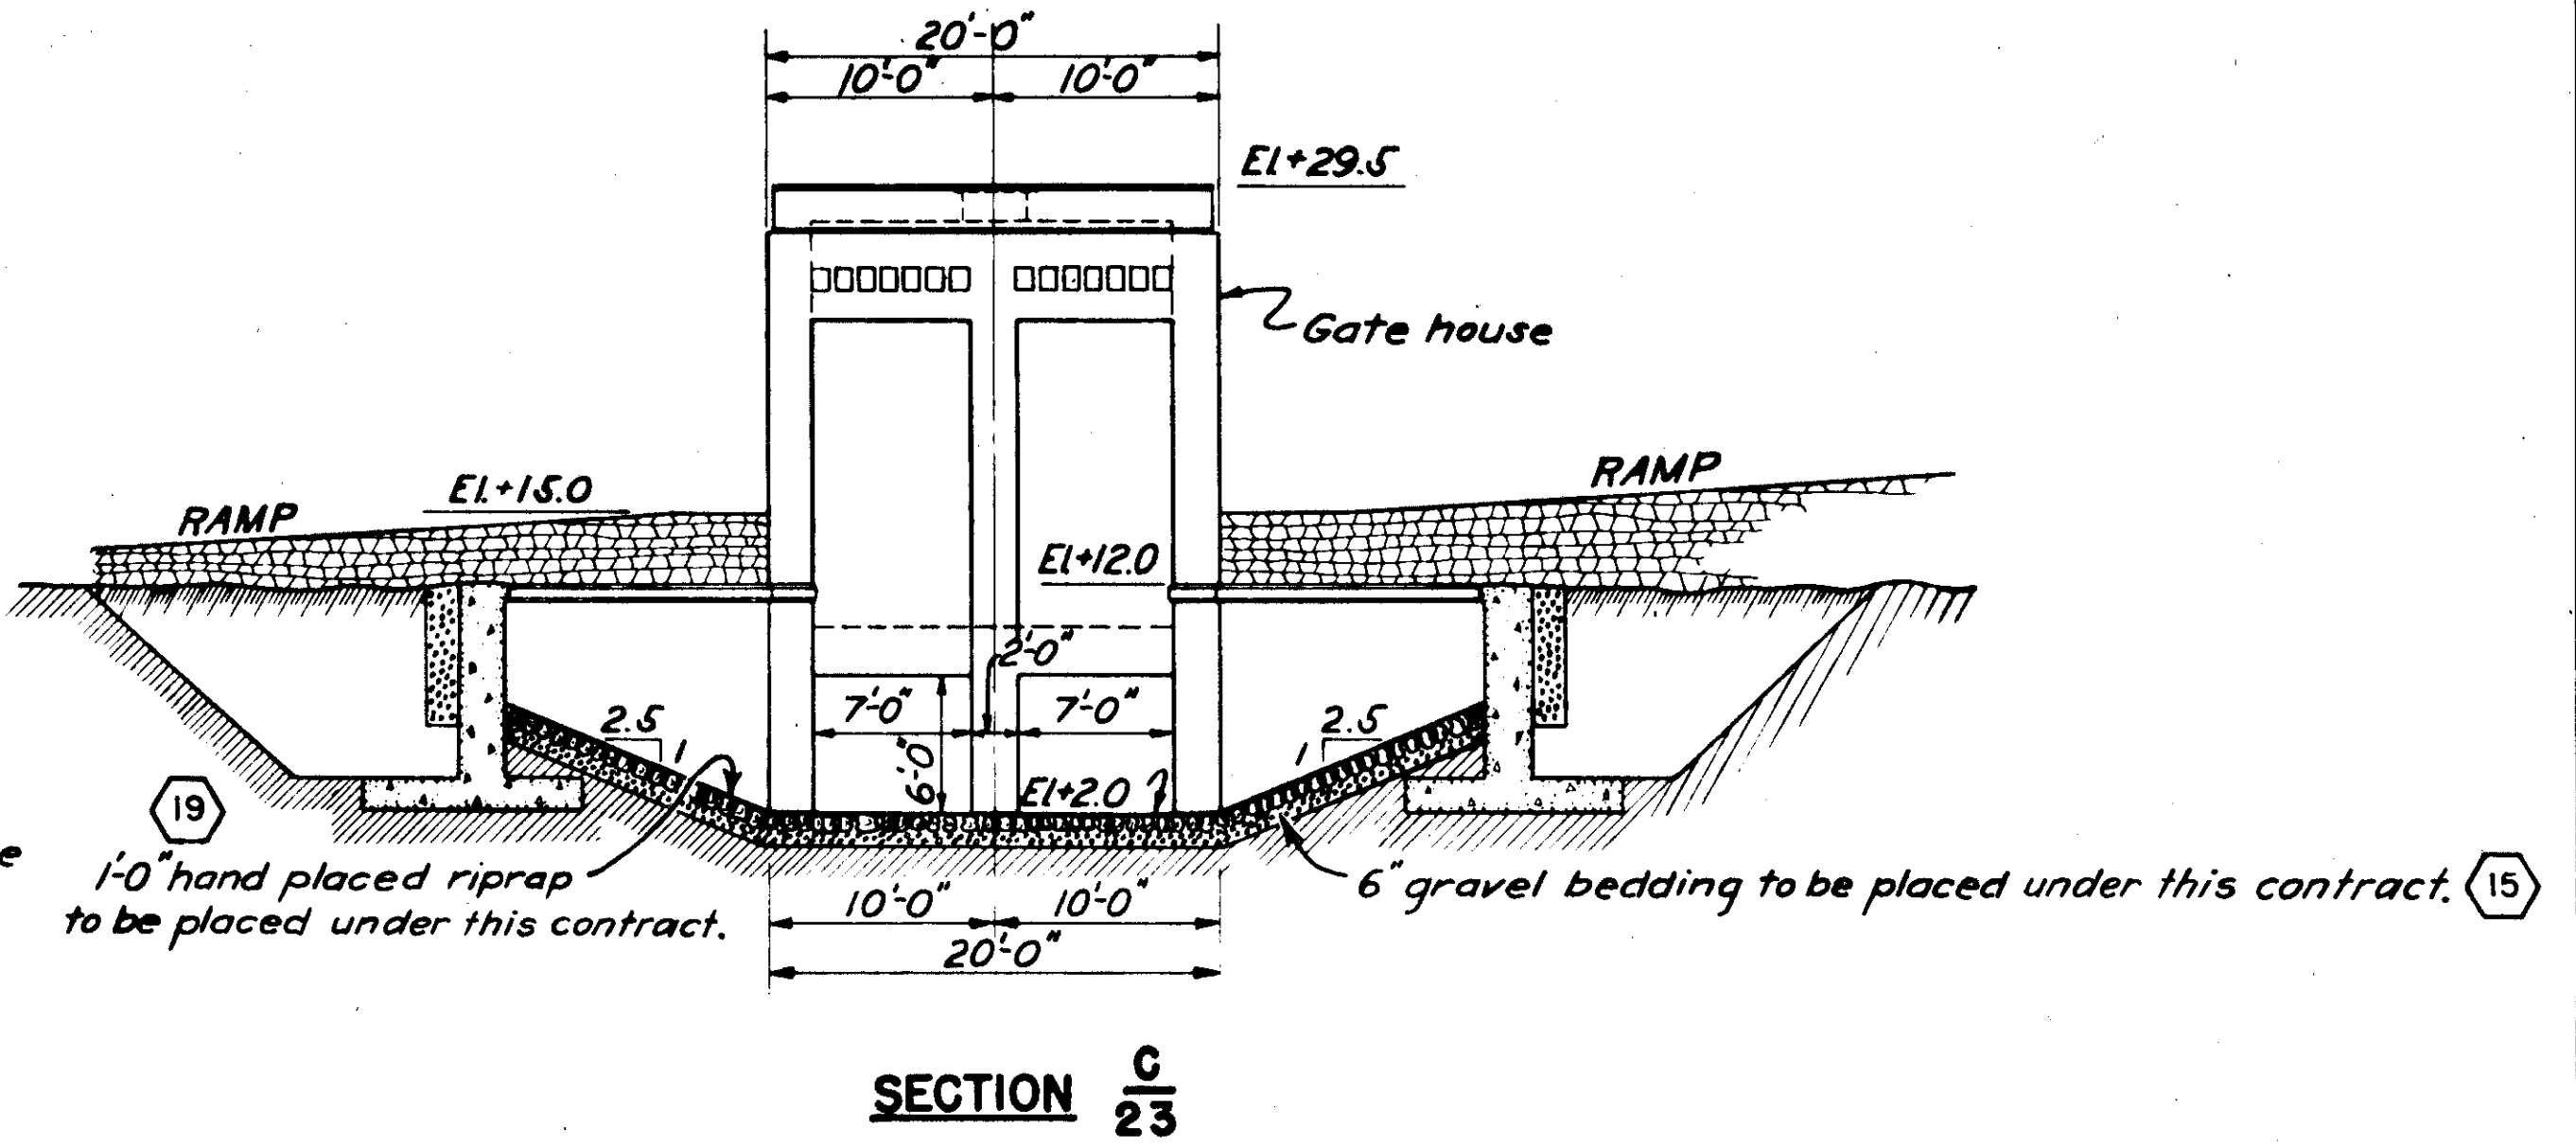


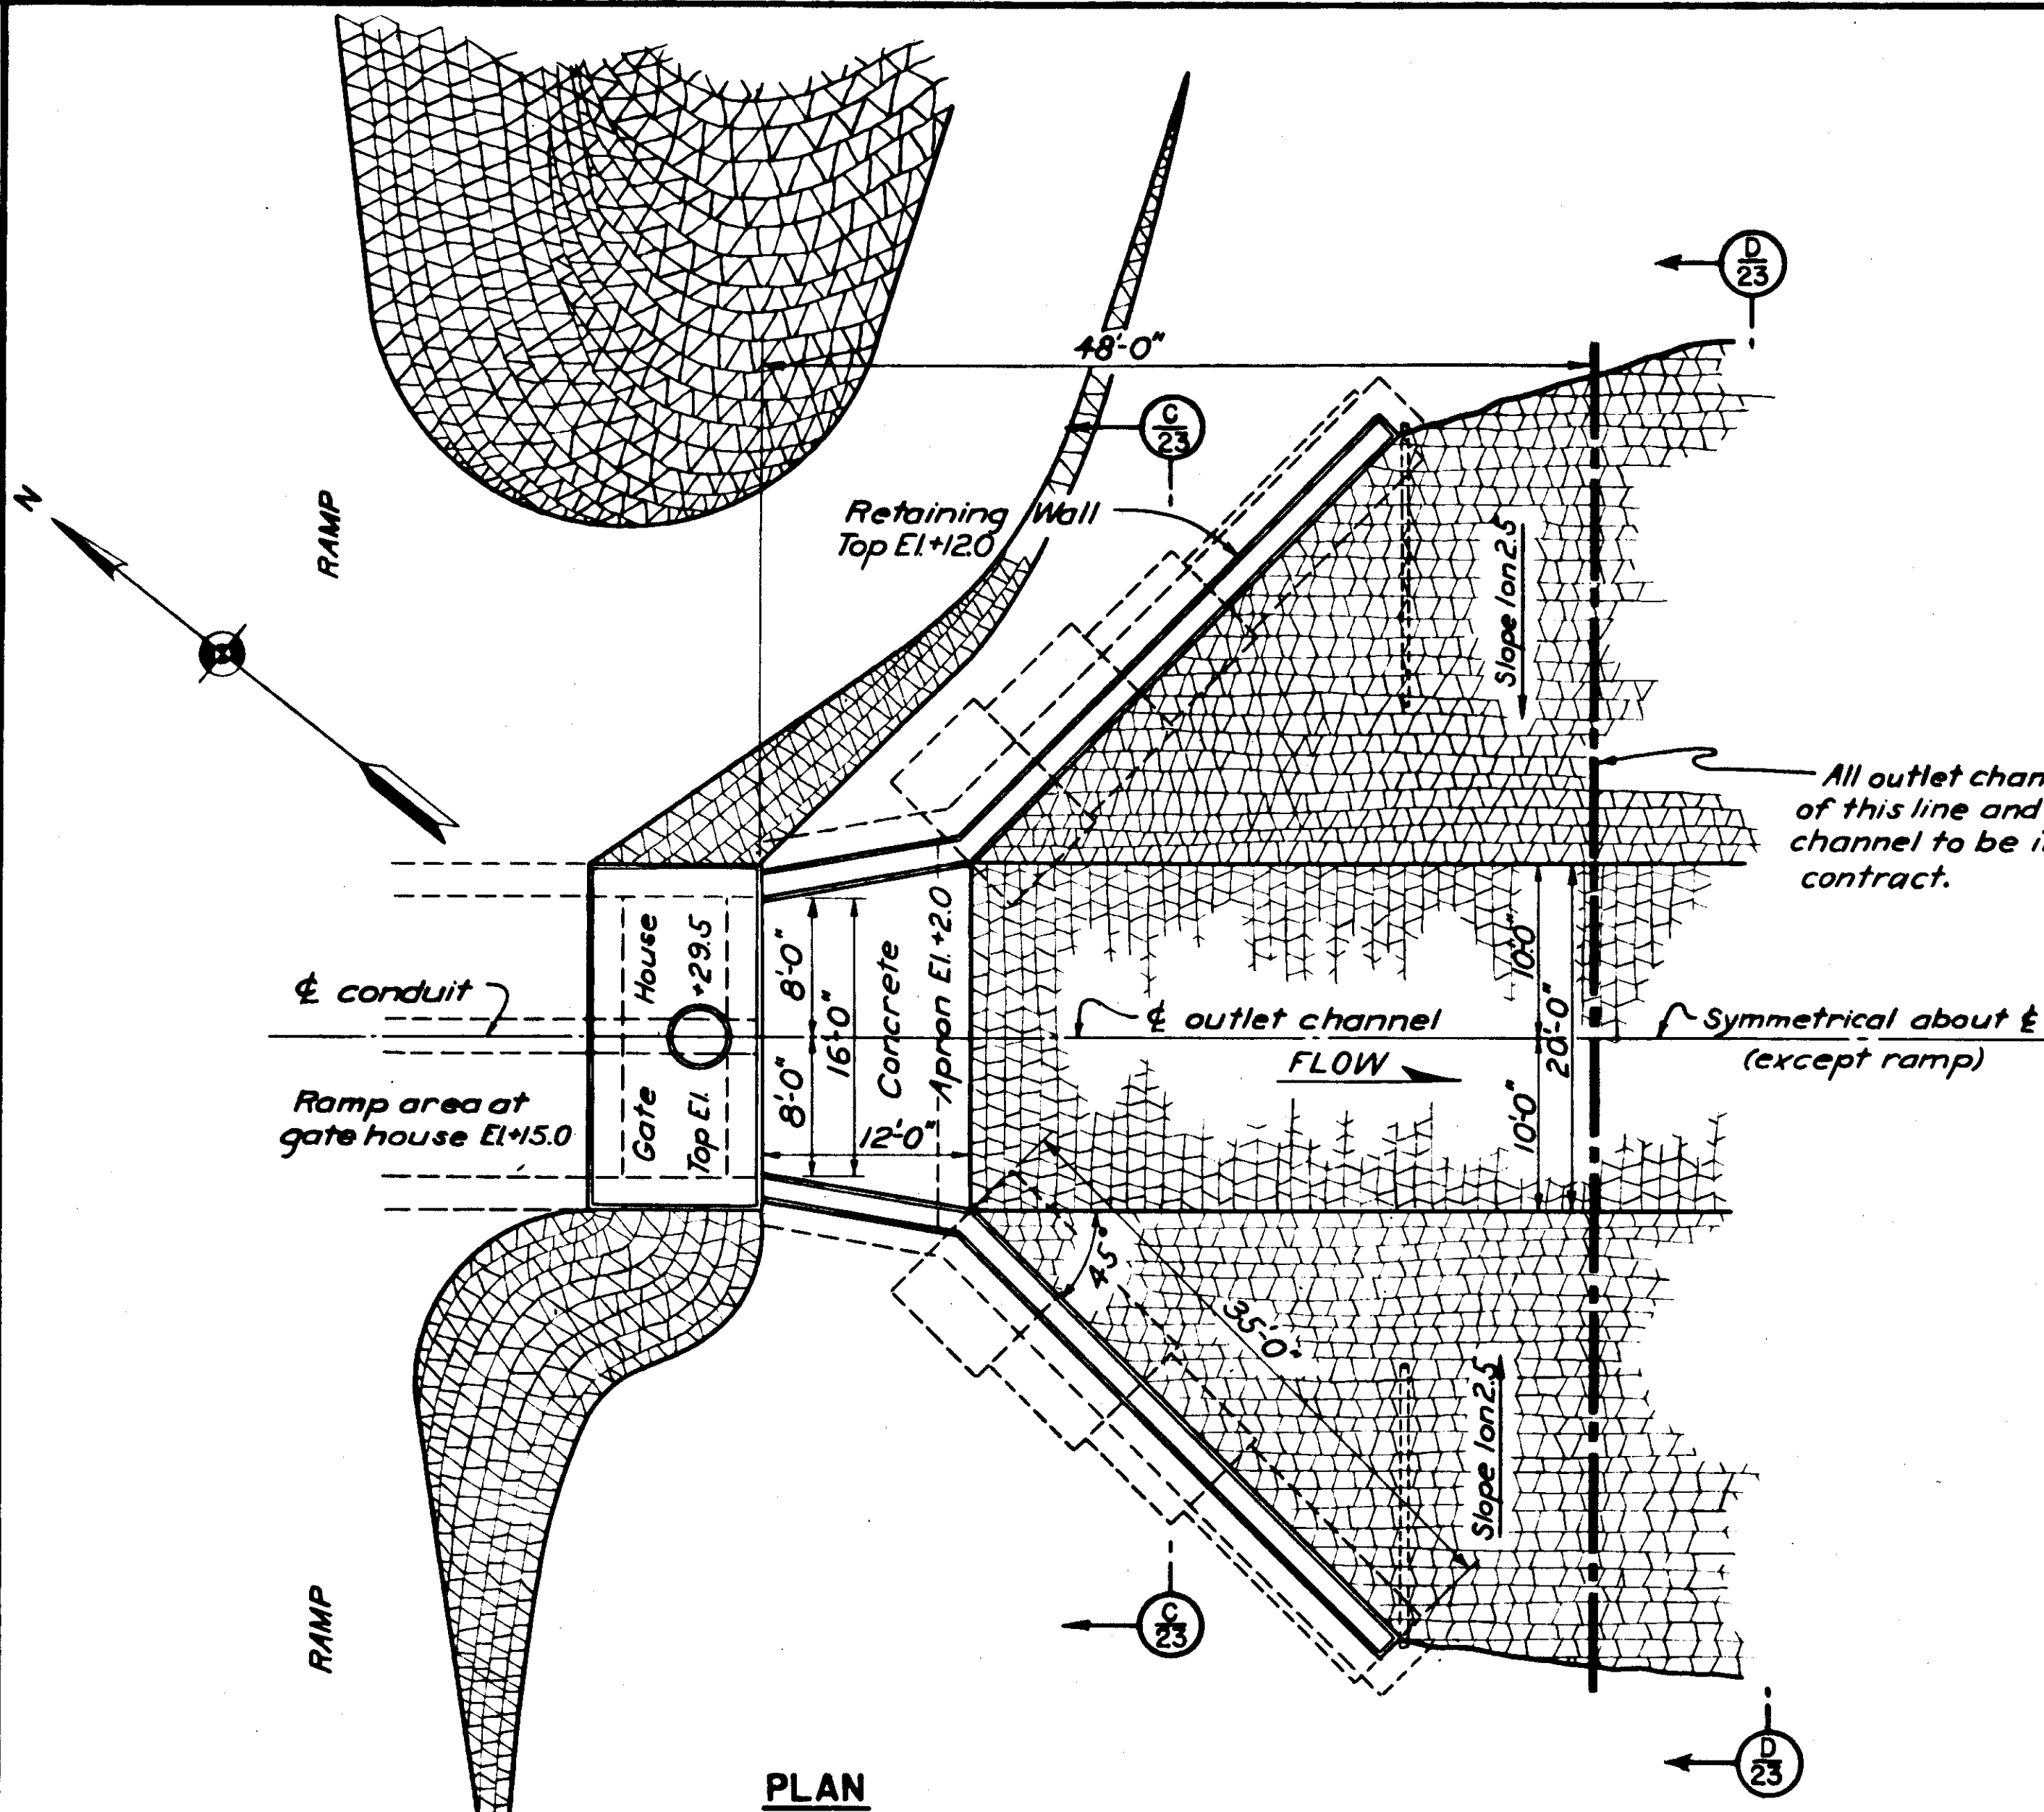

NOTES
Elevations refer to Mean Sea Level Datum

12/31/45	As-Built				
DATE	REVISION	REV BY	CHK BY	AP BY	

CONNECTICUT RIVER FLOOD CONTROL	
NORTH MEADOWS DIKE	
FISCAL YEAR 1939 SECTION	
OUTLET CHANNEL DETAILS	
HARTFORD, CONN.	
CONNECTICUT RIVER	CONNECTICUT
1 IN 6 SHEETS	SHEET NO. 23
SCALE 1/8" = 1'-0"	
U.S. ENGINEER OFFICE, PROVIDENCE, R.I., APRIL 1939	
SUBMITTED BY: <i>Robert B. Hester</i>	APPROVED BY: <i>J. D. Bunker</i>
DESIGNED BY: <i>H. H. Hester</i>	DRAWN BY: <i>MB MC</i>
CHECKED BY: <i>H. H. Hester</i>	TRACED BY: <i>H. H. Hester</i>
FILE NO. CT-4-1452	