
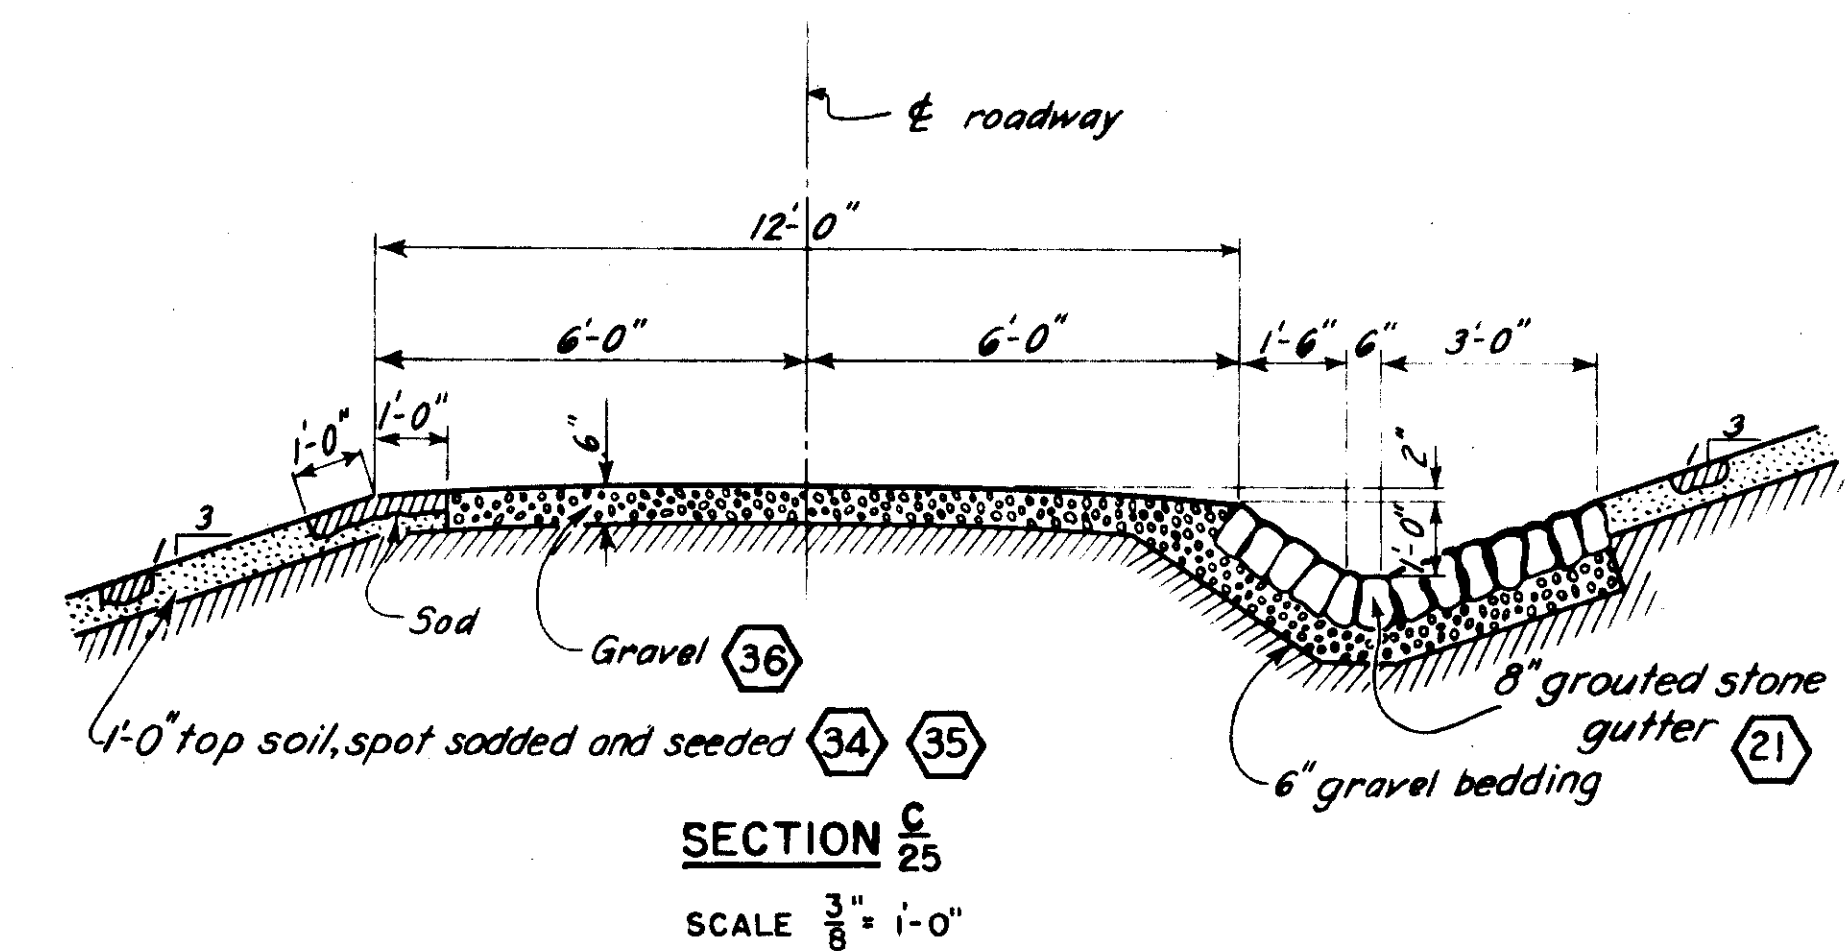
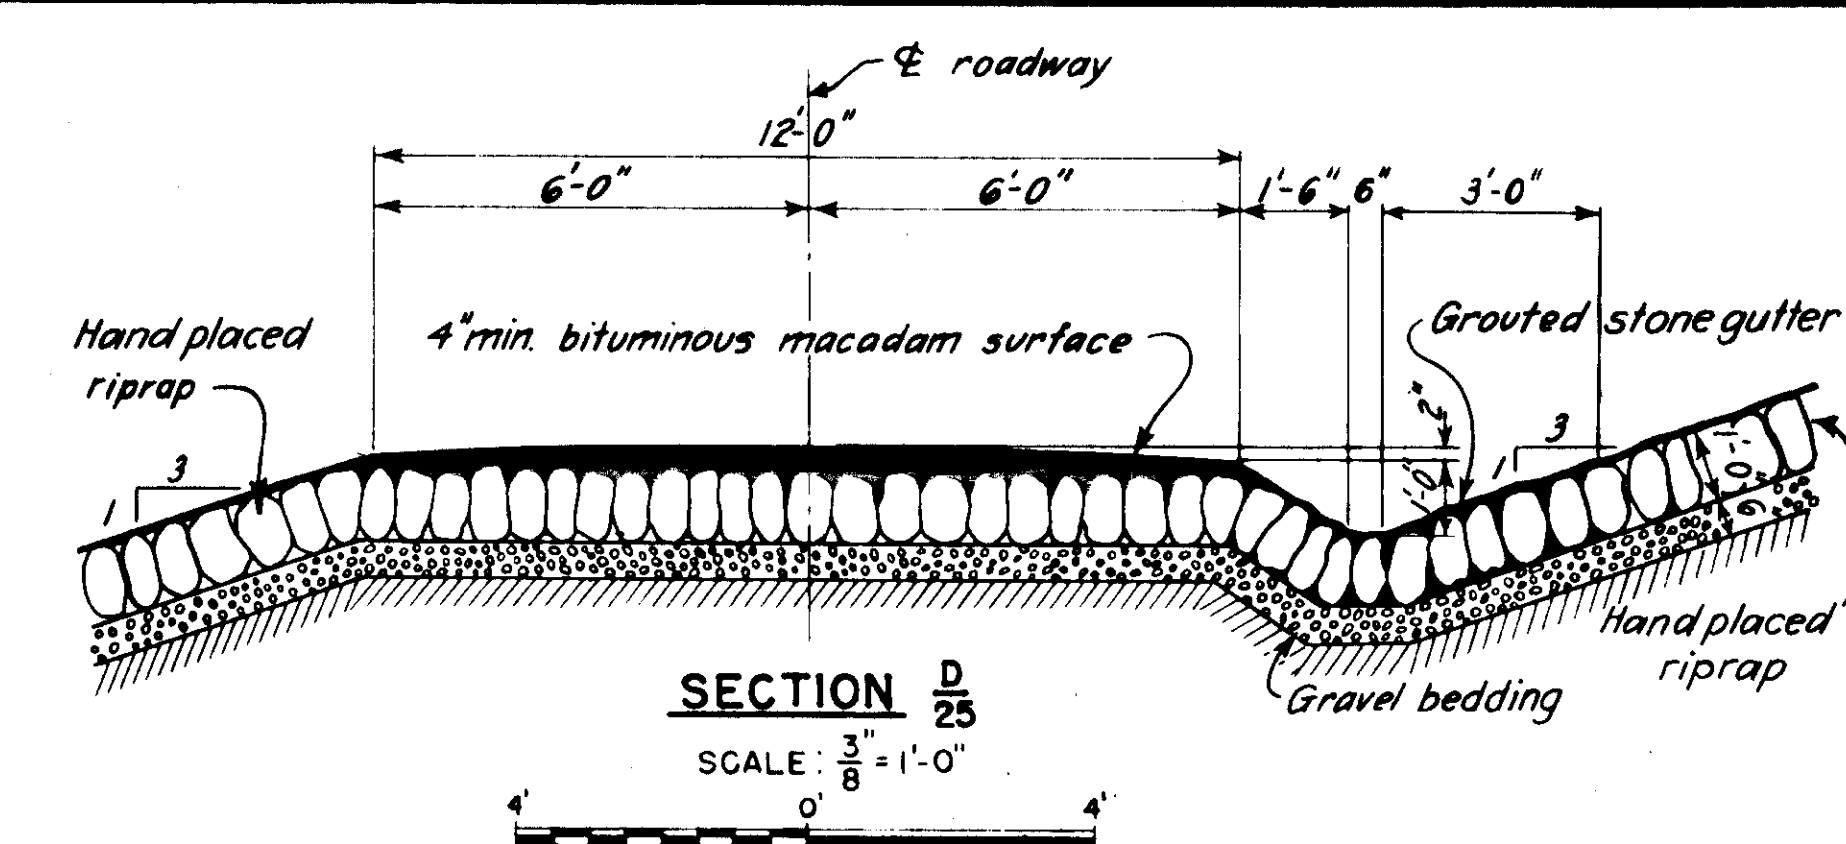
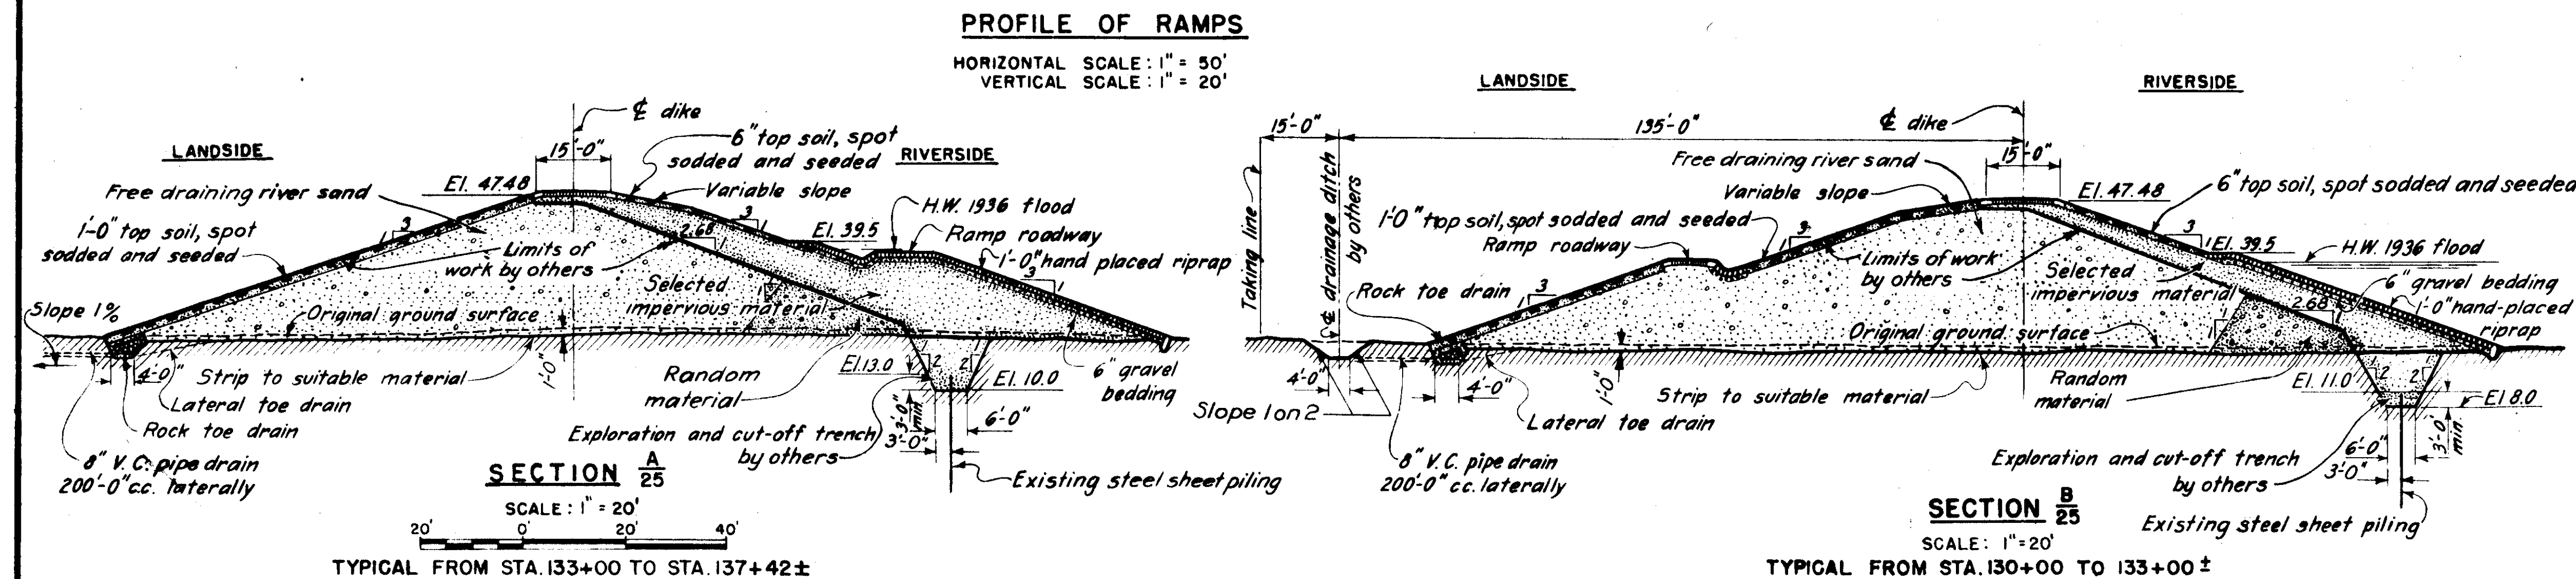
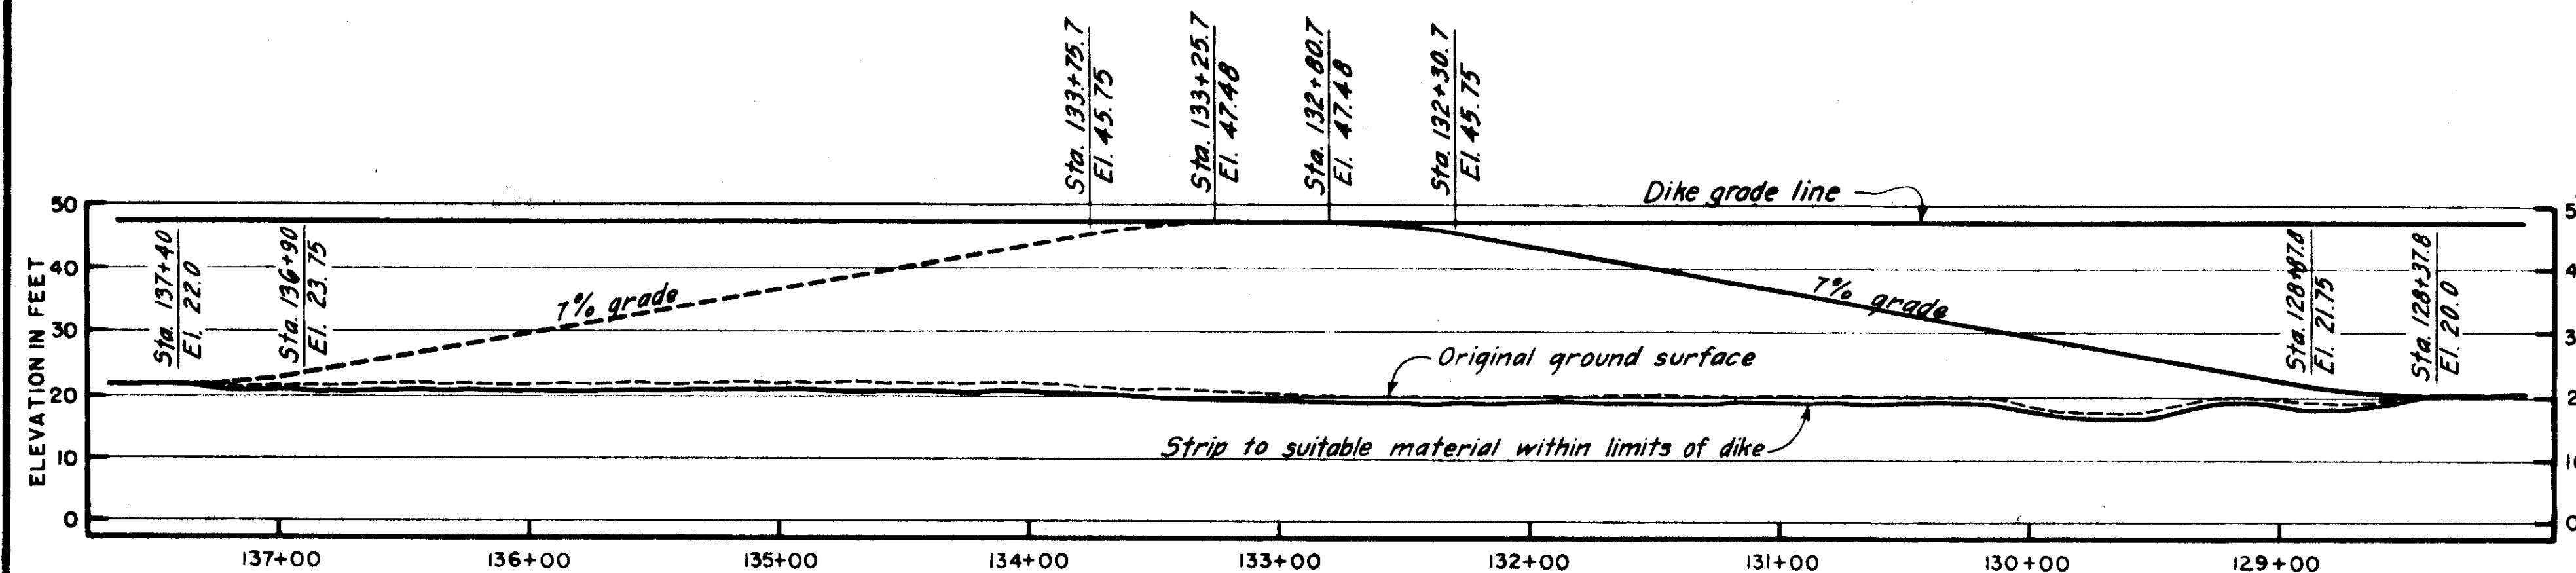


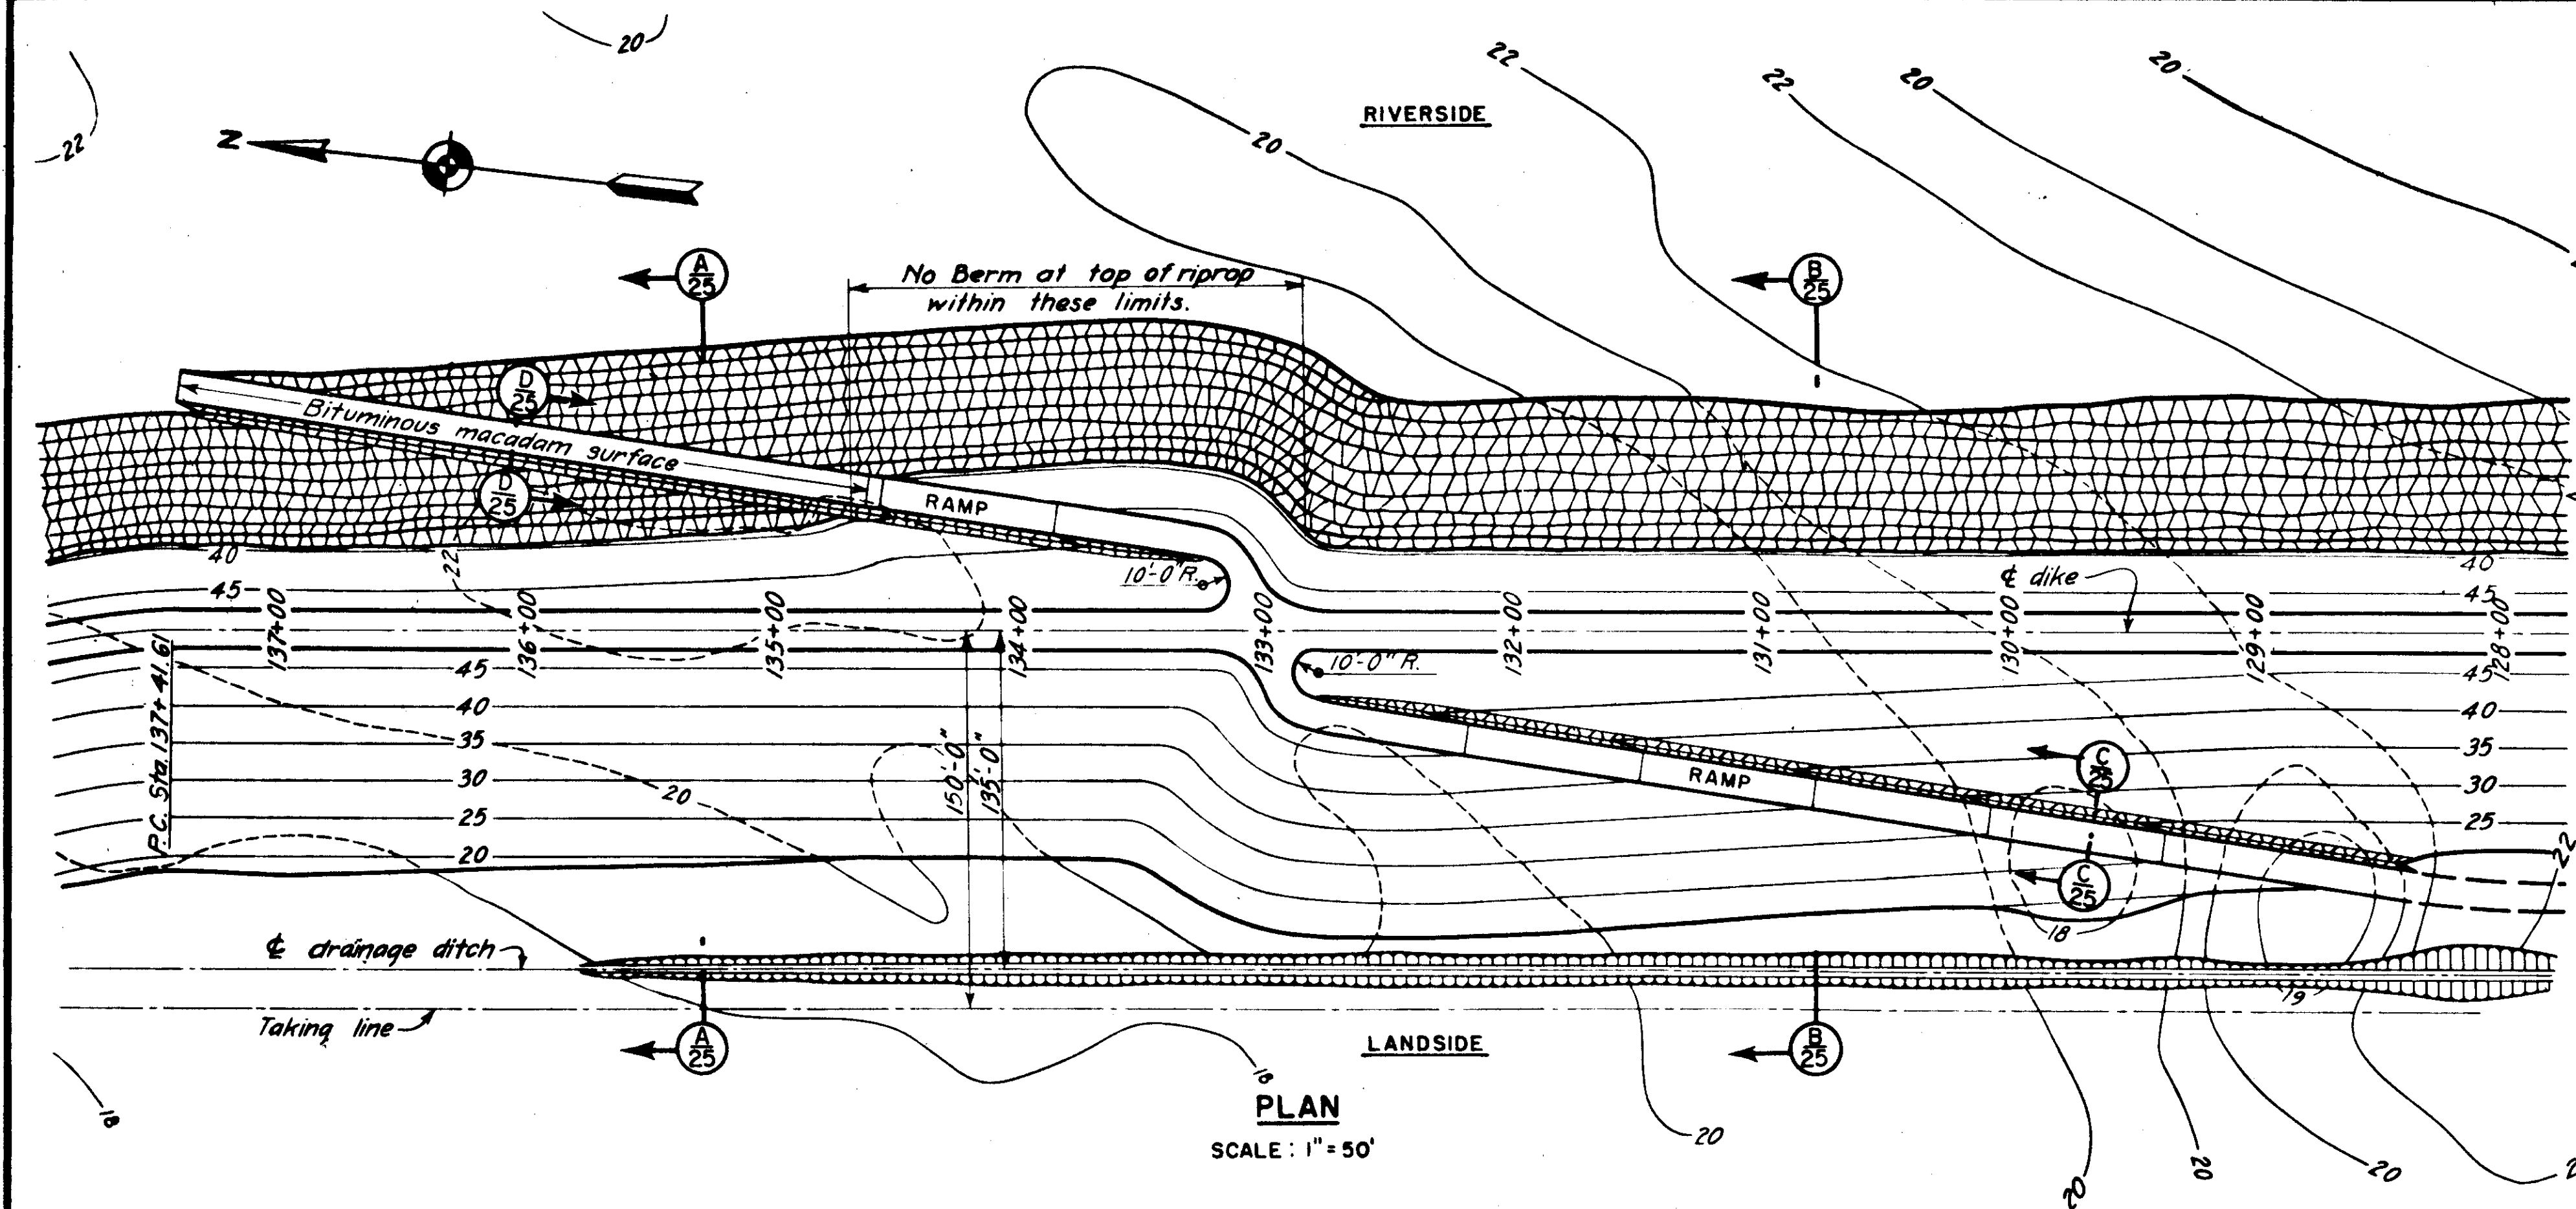

NOTES

Elevations refer to Mean Sea Level datum.
This sheet is included for details if contract is
extended to Sta. 130+00

12/31/45	As-Built	DATE	REVISION	REV. BY	GK. BY	AP. BY
CONNECTICUT RIVER FLOOD CONTROL						
NORTH MEADOWS DIKE						
FISCAL YEAR 1939 SECTION						
RAMP DETAILS NO. 2						
STA. 128+00 TO STA. 137+50±						
HARTFORD, CONN.						
CONNECTICUT RIVER, CONNECTICUT						
IN 66 SHEETS SCALE: 1" = 50 FT. SHEET NO. 25						
U. S. ENGINEER OFFICE, PROVIDENCE, R. I., APRIL 1939						
SUBMITTED	APPROVAL RECOMMENDED	APPROVED				
SENATOR ENGINEER	PRINCIPAL ENGINEER	CHIEF OF ENGINEERS				
HEAD DESIGN SECTION	CHIEF, P. C. ENGINEERING DIV.	DISTRICT ENGINEER				
DESIGNED	DRAWN BY	TRACED BY				
W. E. L.	M. B. H.	W. E. L.				
W. E. L.	W. E. L.	W. E. L.				
			FILE NO. CT-4-1454			