
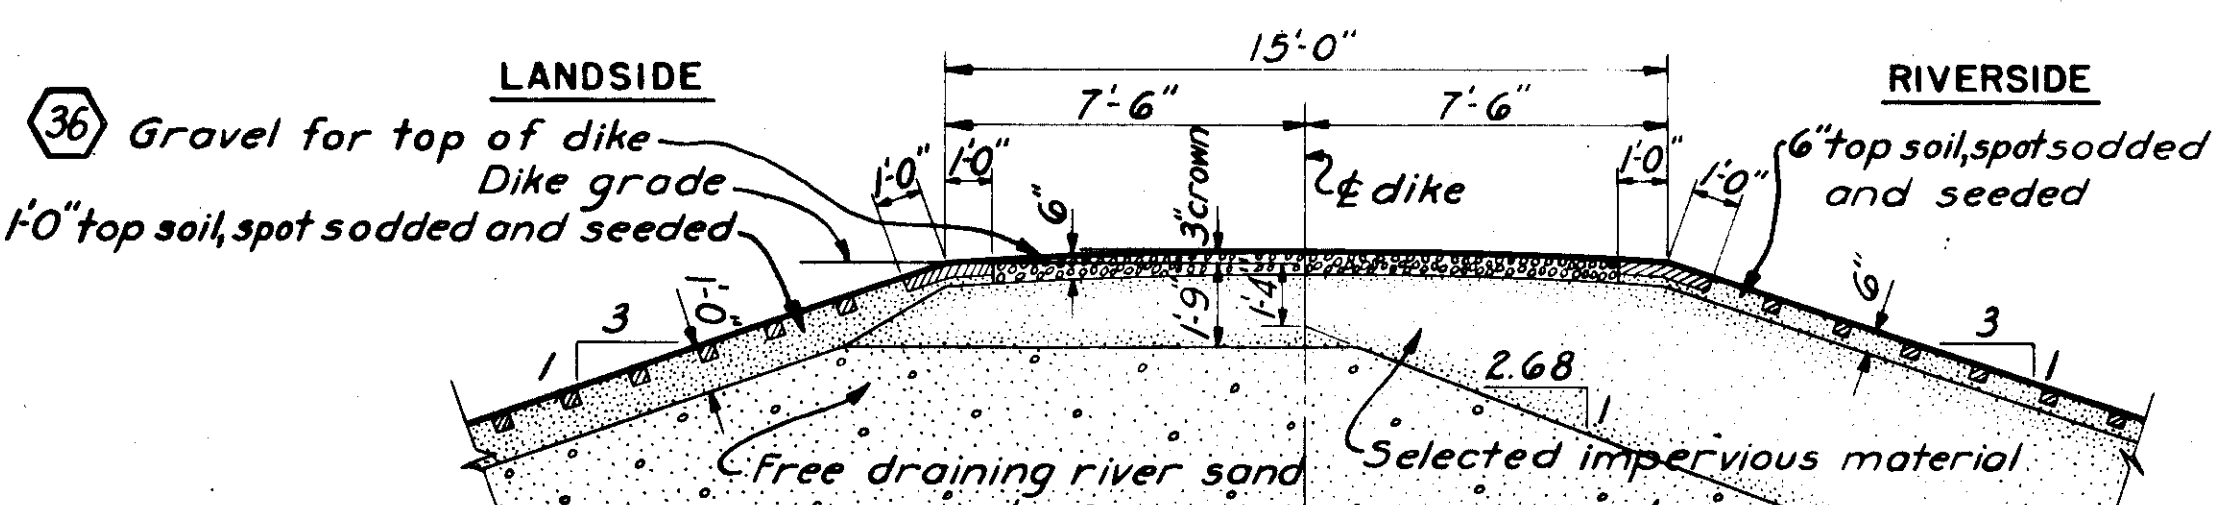
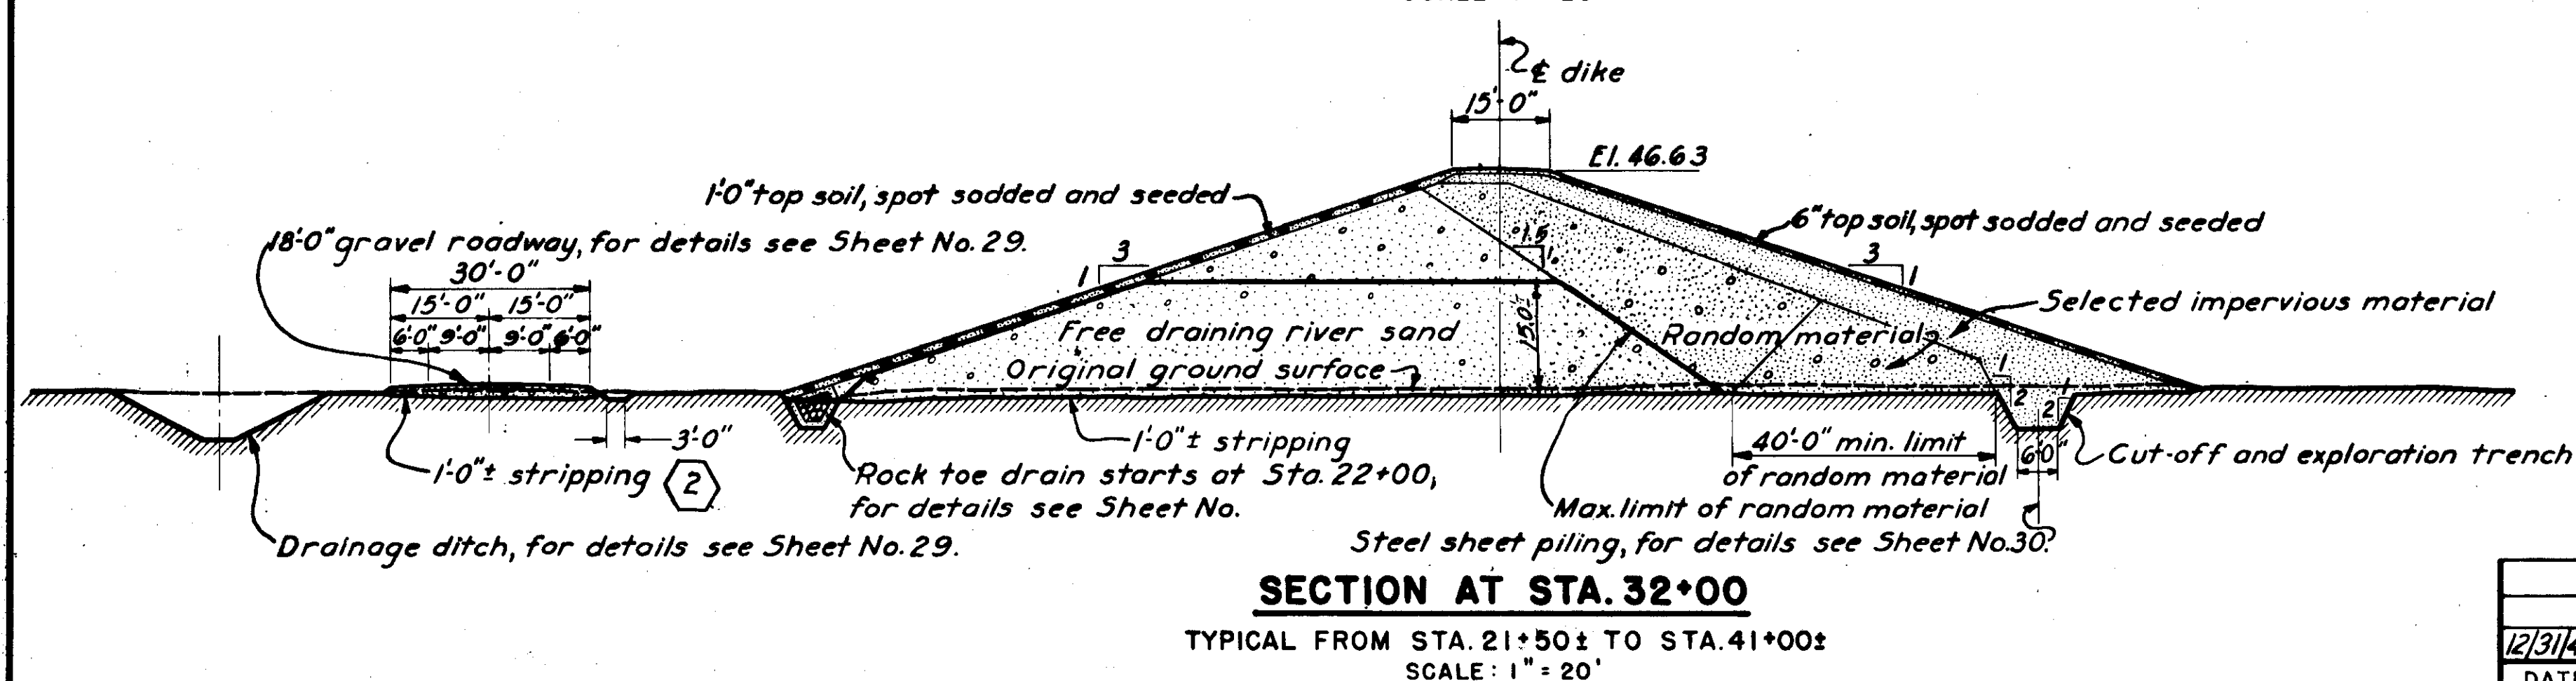
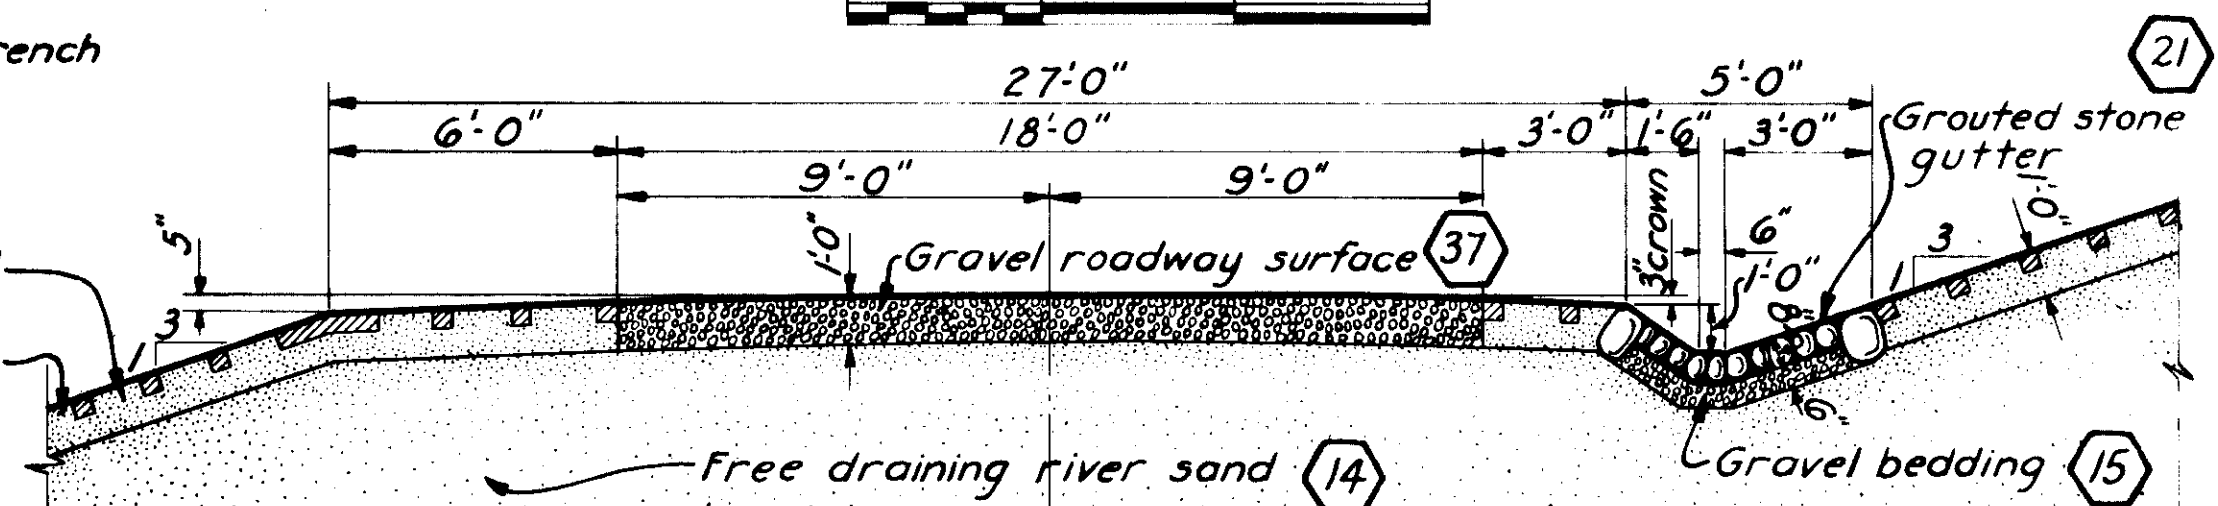
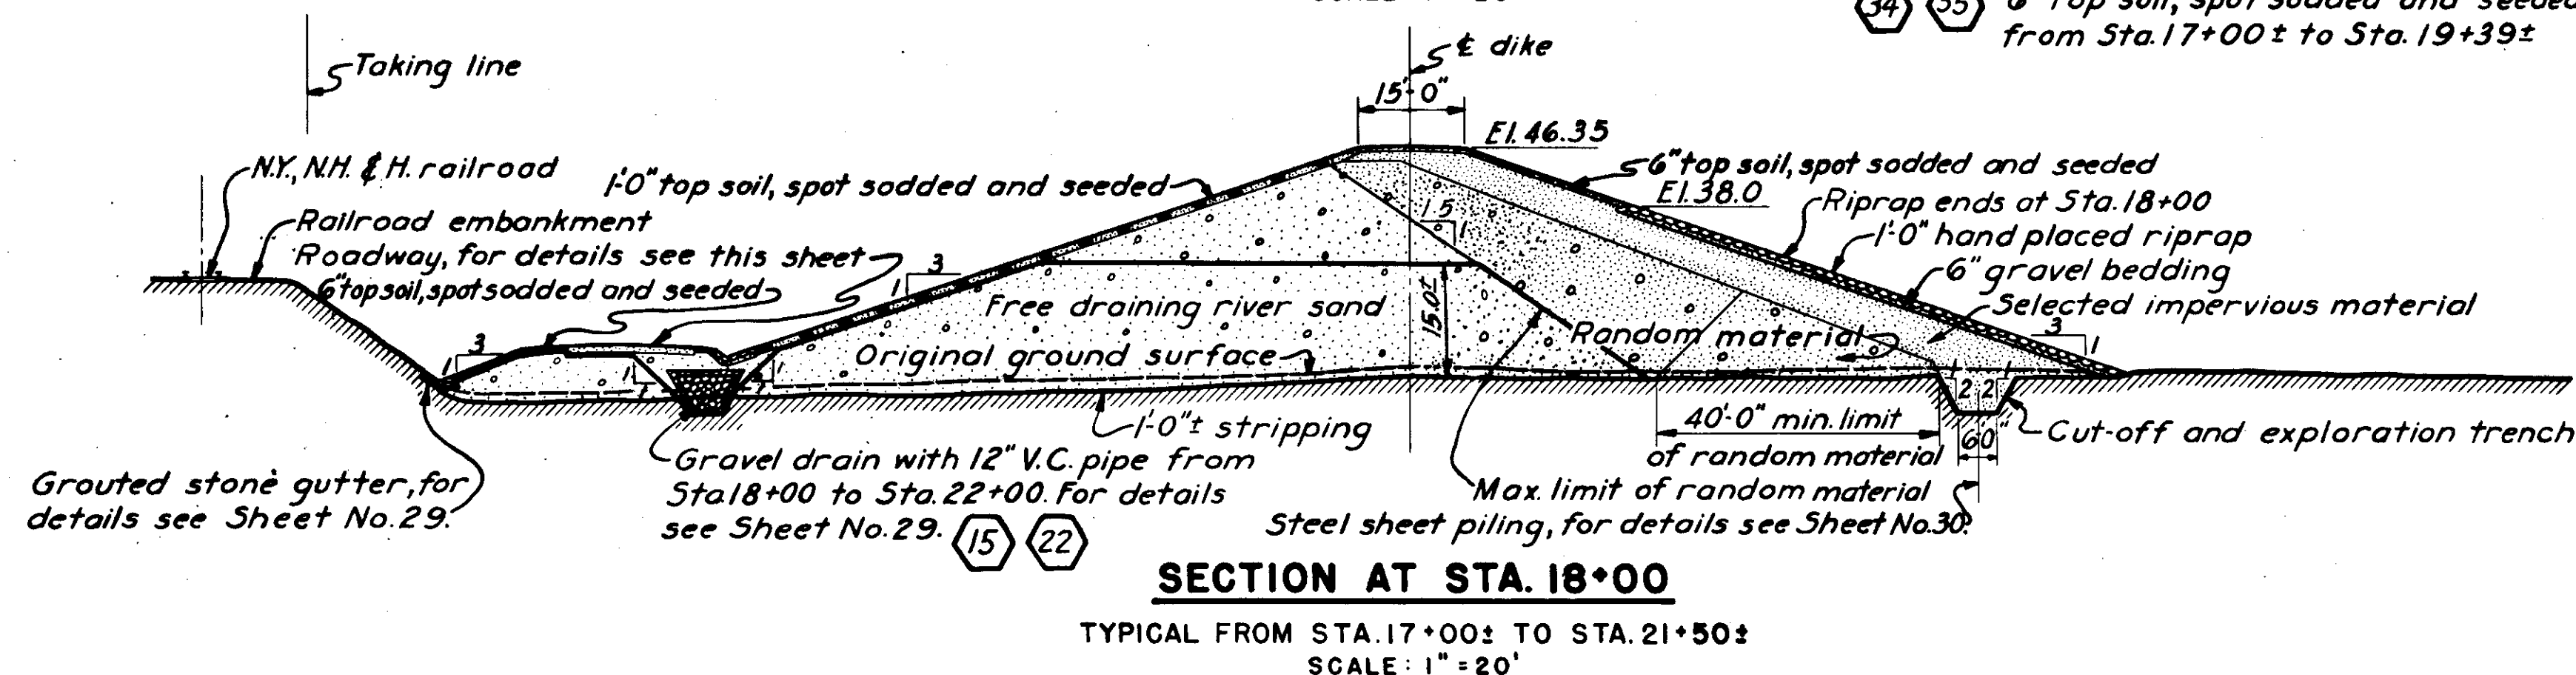
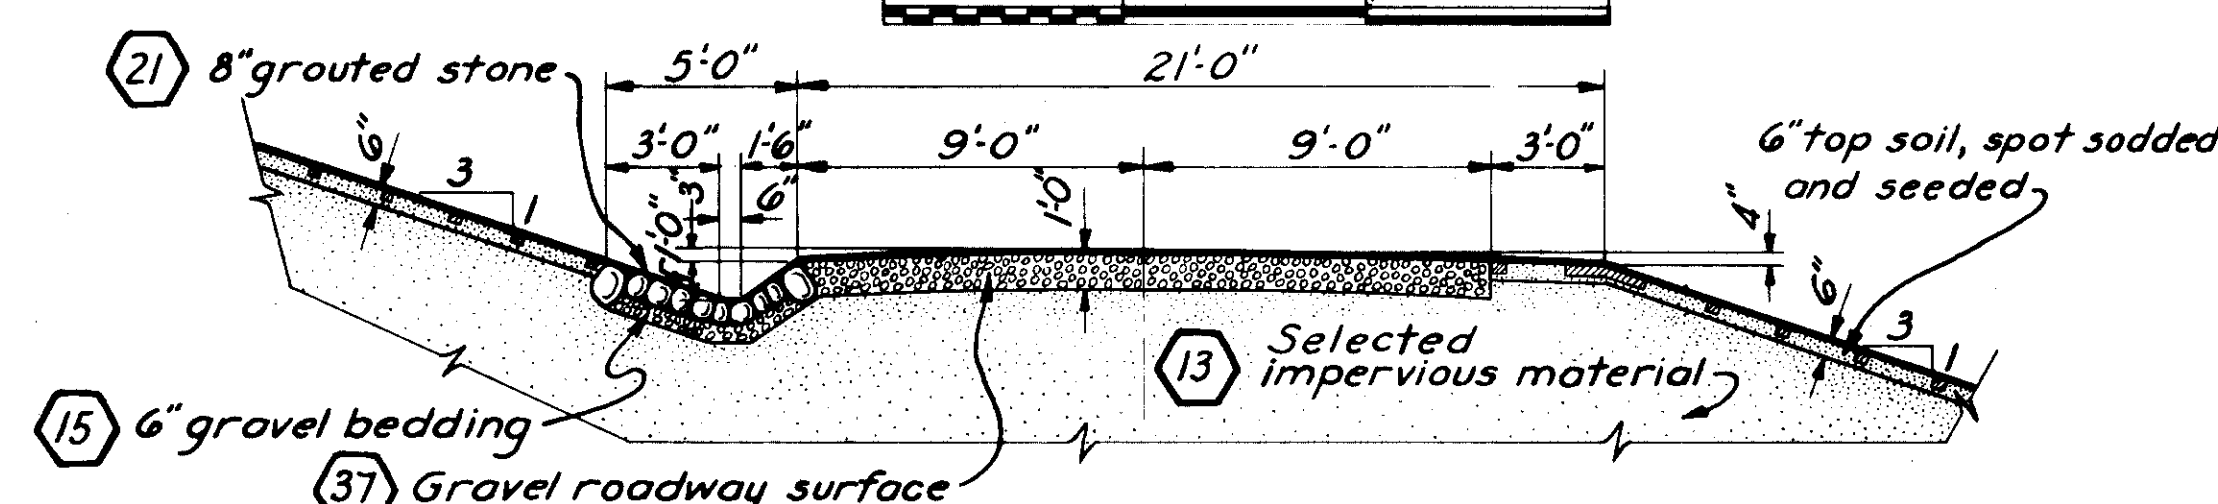
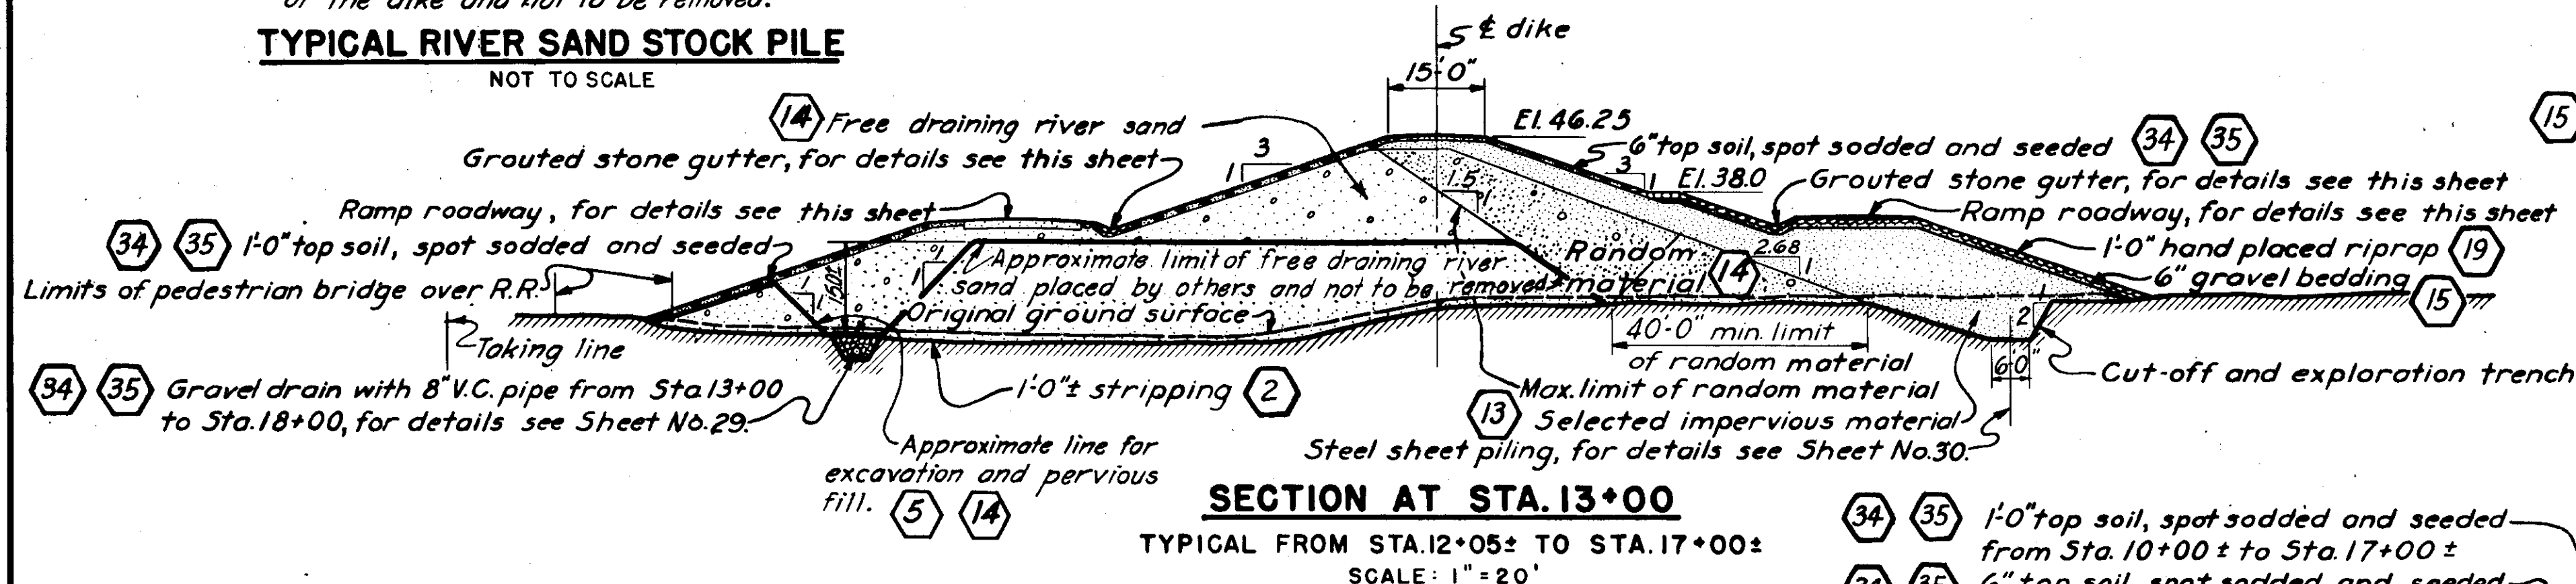
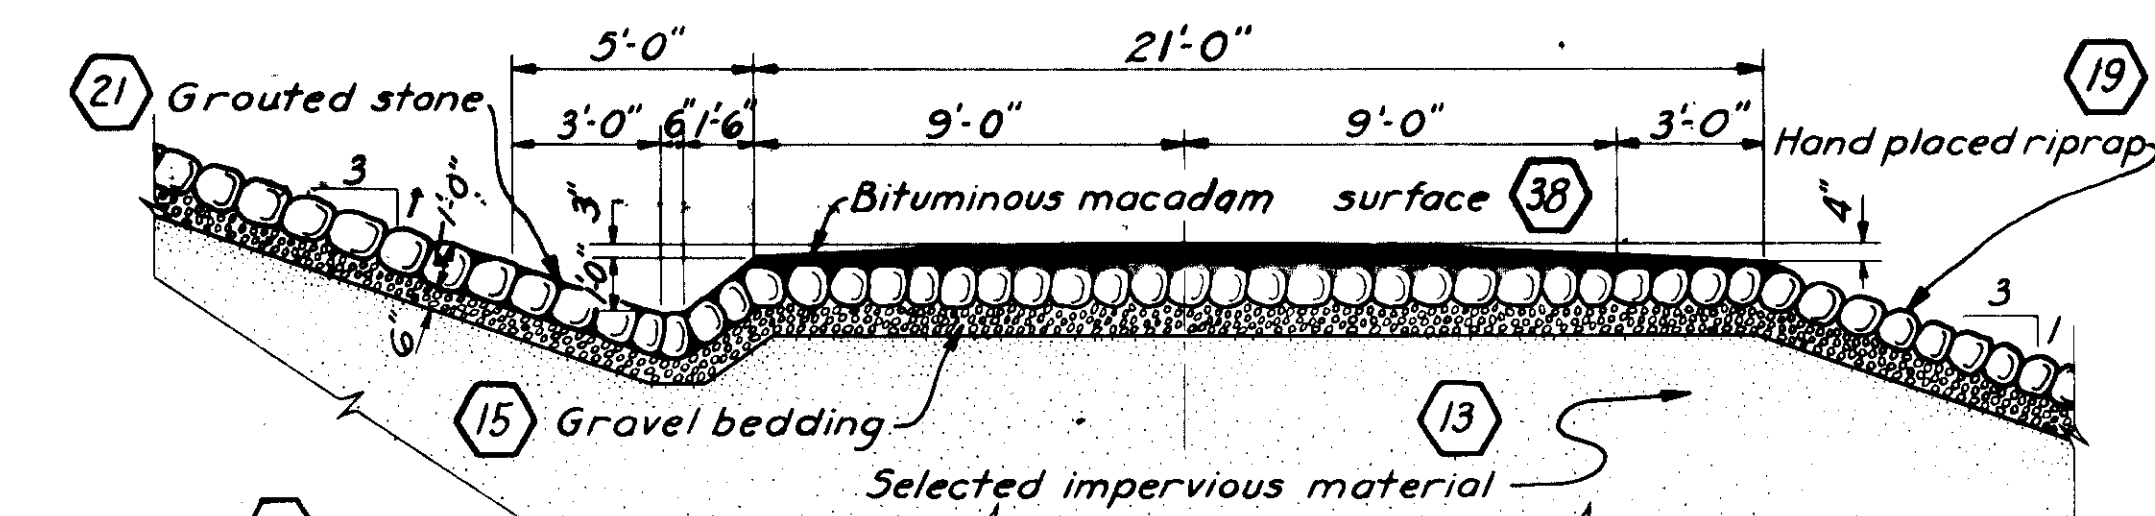


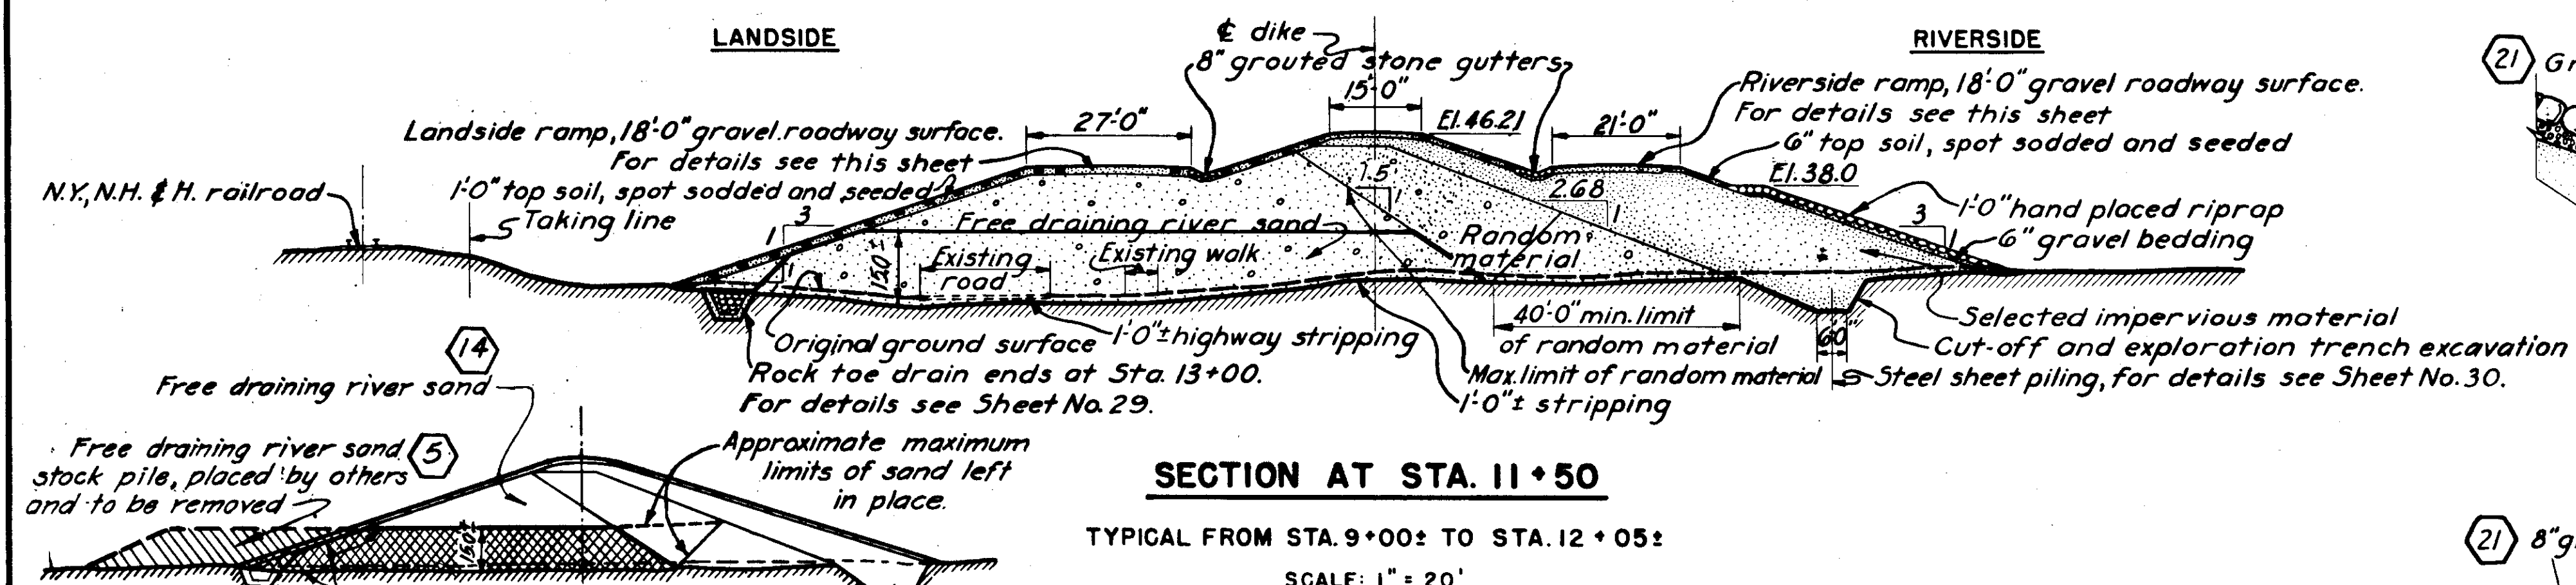

NOTE

For general notes applying to details shown on this sheet, see Sheet No. 26.

12/31/45	As-Built				
DATE	REVISION	REV. BY	CK. BY	AP. BY	

CONNECTICUT RIVER FLOOD CONTROL					
NORTH MEADOWS DIKE					
FISCAL YEAR 1939 SECTION					
TYPICAL CROSS SECTIONS NO. 2					
HARTFORD, CONN.					
CONNECTICUT RIVER			CONNECTICUT		
IN 66 SHEETS			SHEET NO. 27		
U. S. ENGINEER OFFICE, PROVIDENCE, R. I.			APRIL 1939		
SUBMITTED: <i>H. B. L.</i>		APPROVED: <i>J. D. Burns</i>		APPROVED: <i>M. S. L.</i>	
SENIOR ENGINEER		PRINCIPAL ENGINEER		DISTRICT ENGINEER	
HEAD, DESIGN SECTION		CHIEF, F. C. ENGINEERING DIV.		FILE NO. CT-4-1456	
DESIGNED: <i>J. H. L.</i>		DRAWN: P. D. M.		CHECKED: <i>W. B. L.</i>	
ASSOC. ENGINEER		TRACED: P. V. S.			