
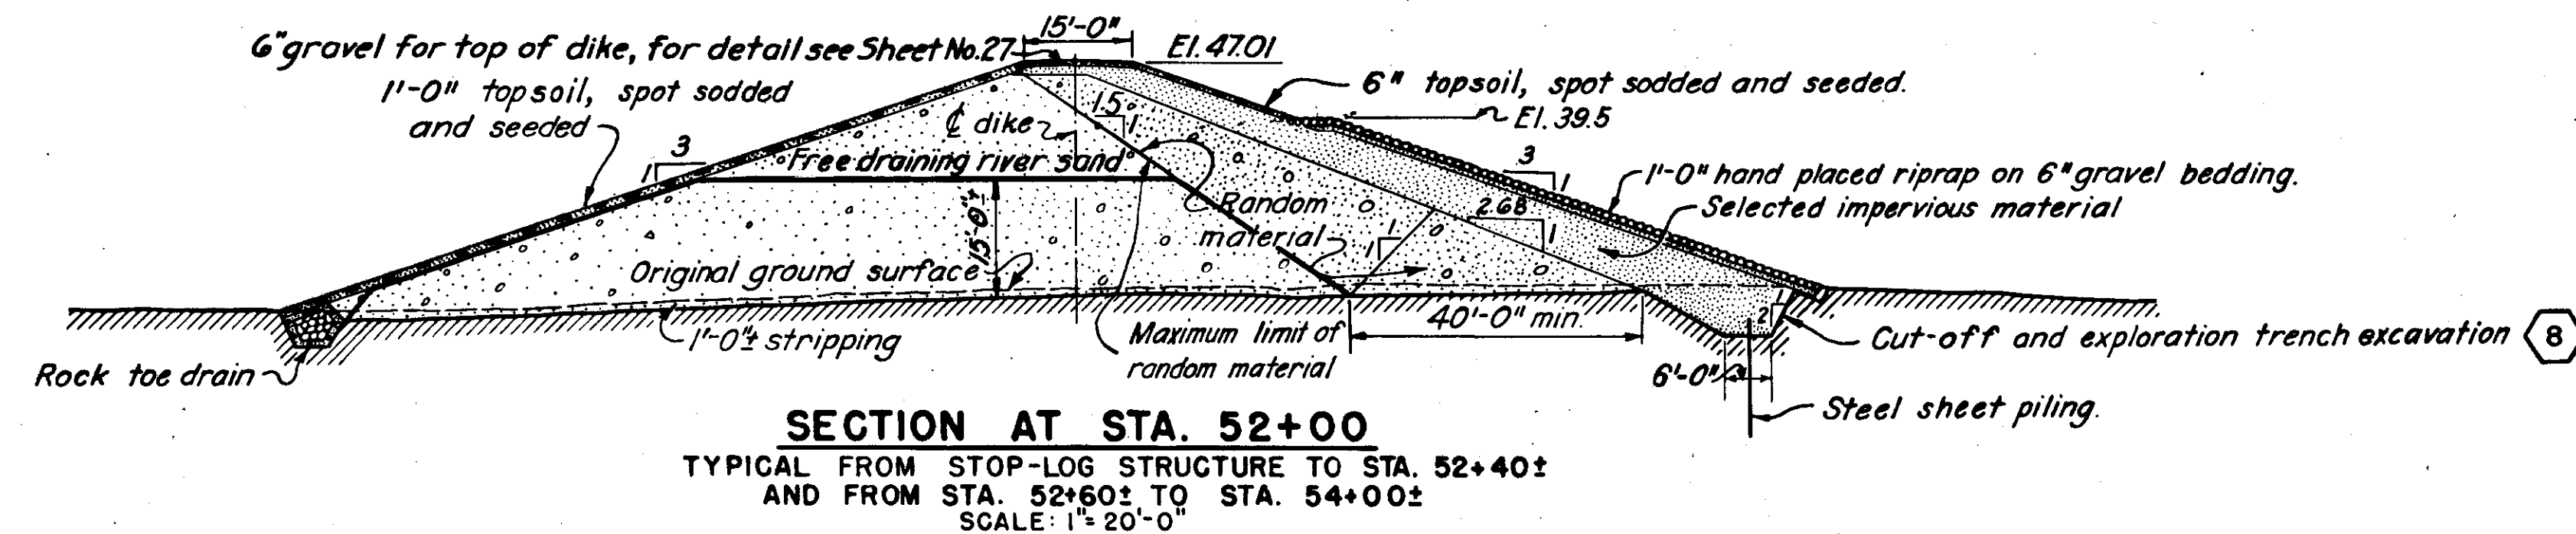
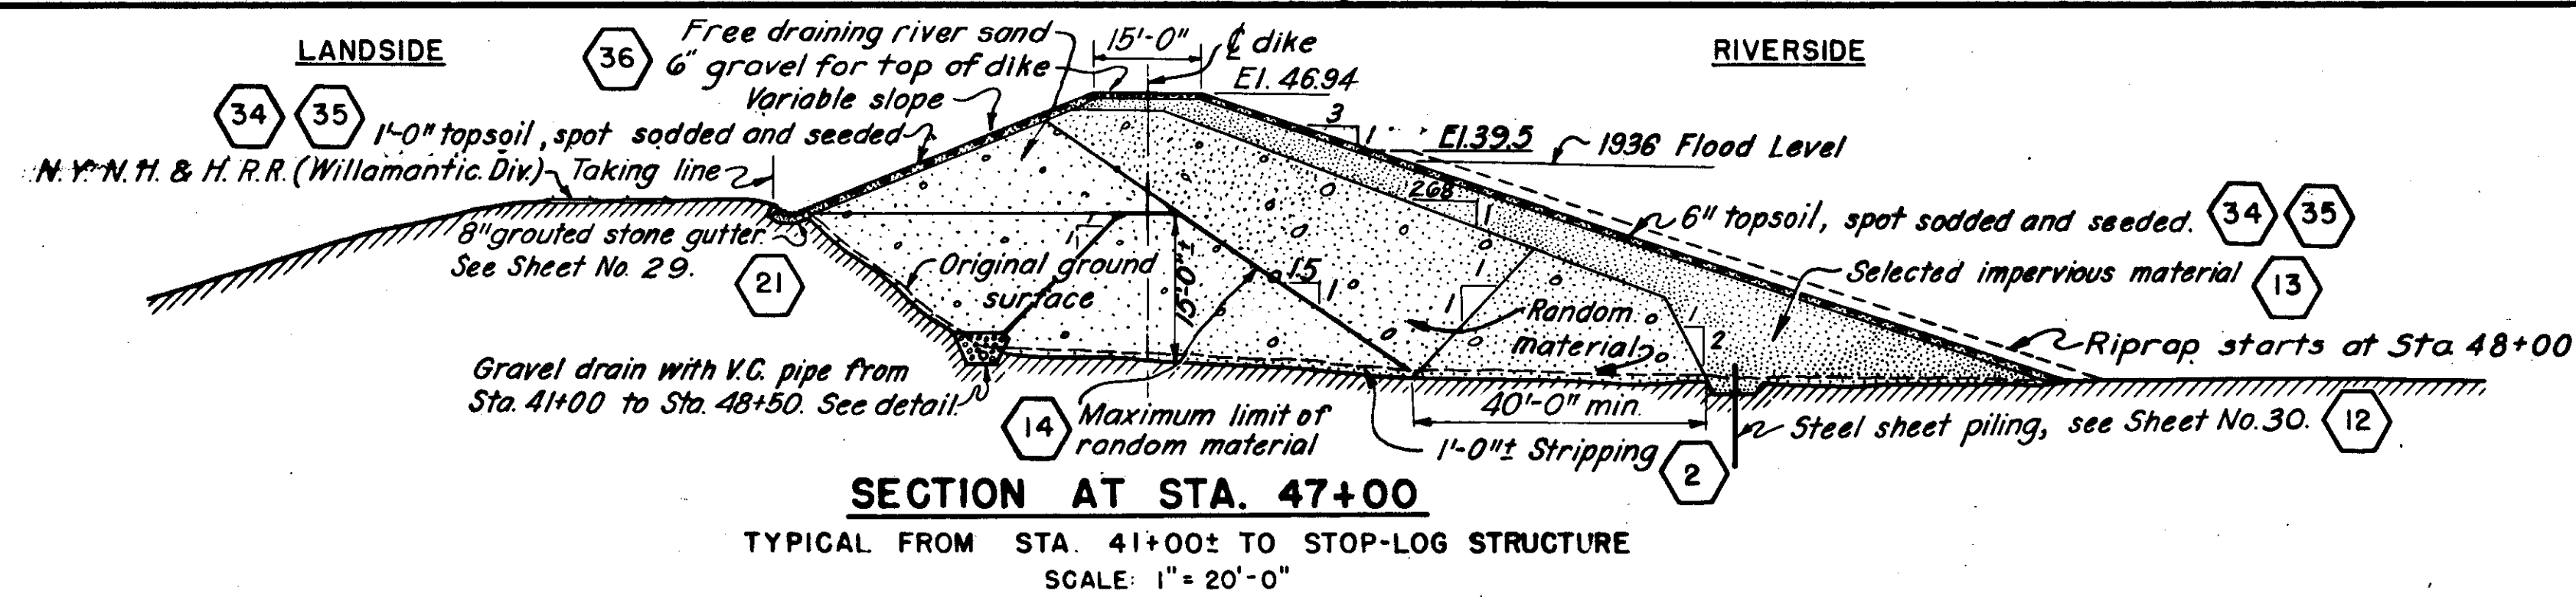
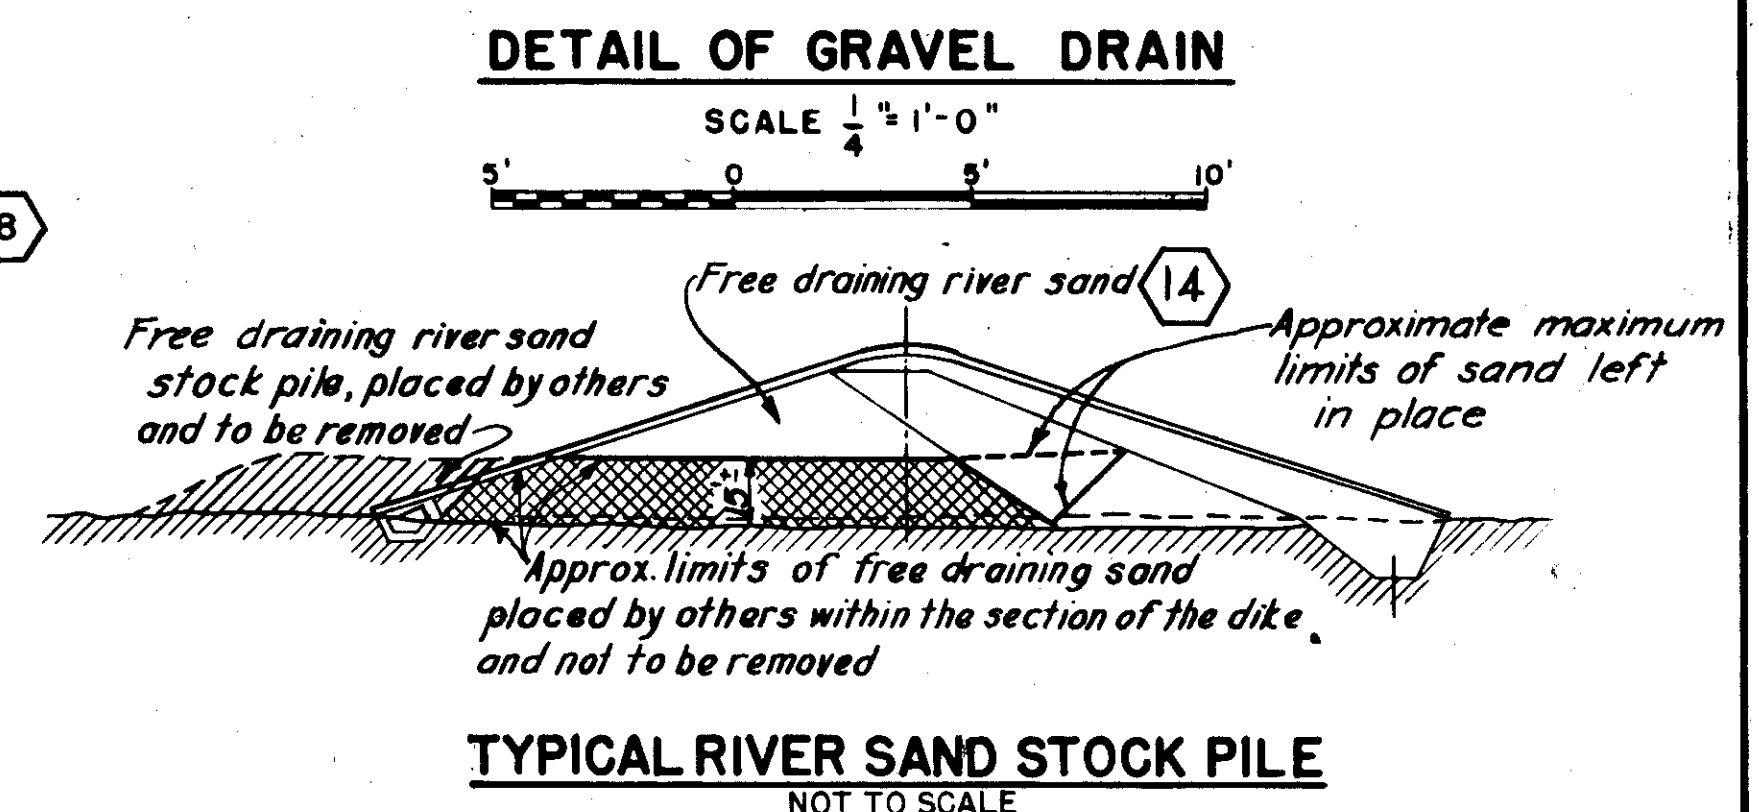


LIMITS OF WORK BY OTHERS STA. 60-00 TO STA. 98-00
LIMITS OF WORK BY OTHERS STA. 98-00 TO STA. 130-00

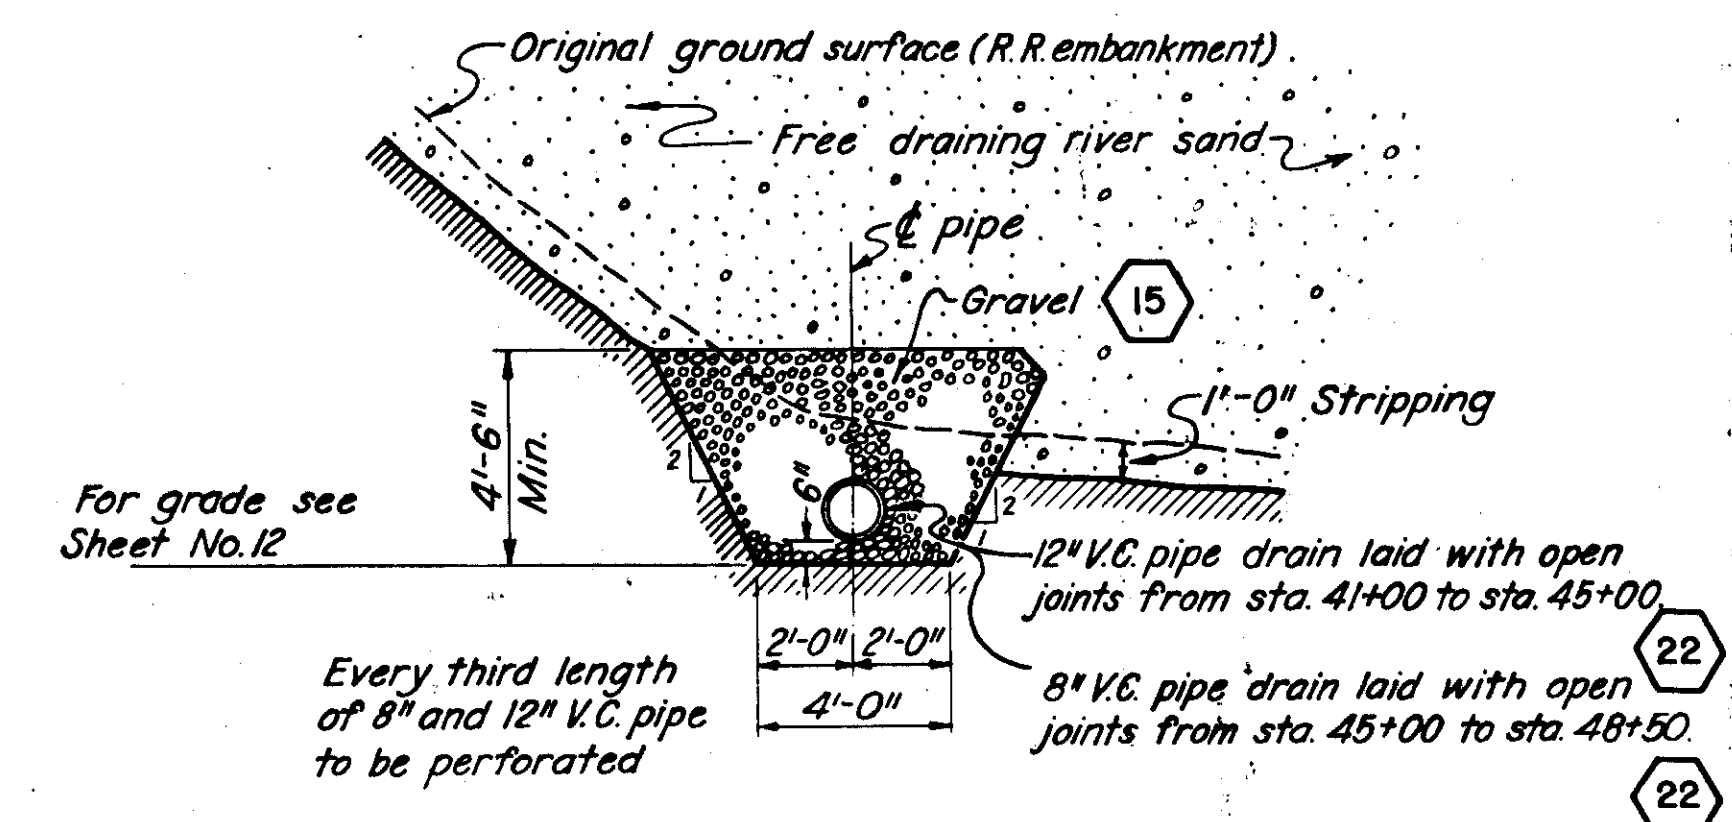

NOTES

For general notes applying to details shown on this sheet see Sheet No. 26.

12/31/45	As-Built				
DATE	REVISION	REV. BY	CK. BY	AP. BY	
CONNECTICUT RIVER FLOOD CONTROL					
NORTH MEADOWS DIKE					
FISCAL YEAR 1939 SECTION					
TYPICAL CROSS SECTIONS NO. 3					
HARTFORD, CONN.					
CONNECTICUT RIVER					
IN 66 SHEETS					
SCALE 1" = 20' FT.					
SHEET NO. 28					
U. S. ENGINEER OFFICE, PROVIDENCE, R. I., APRIL 1939					
SUBMITTED: <i>David B. DeBor</i>		APPROVAL RECOMMENDED: <i>J. S. DeBor</i>		APPROVED: <i>J. S. DeBor</i>	
SENIOR ENGINEER		PRINCIPAL ENGINEER		DISTRICT ENGINEER	
HEAD, DESIGN SECTION		CHIEF, F. C. ENGINEERING DIV.			
DESIGNED: <i>J. Hartley</i>		DRAWN: P. D. M.		FILE NO. CT-4-1457	
ASSOC. ENGINEER		CHECKED: <i>W. B. S.</i>			