

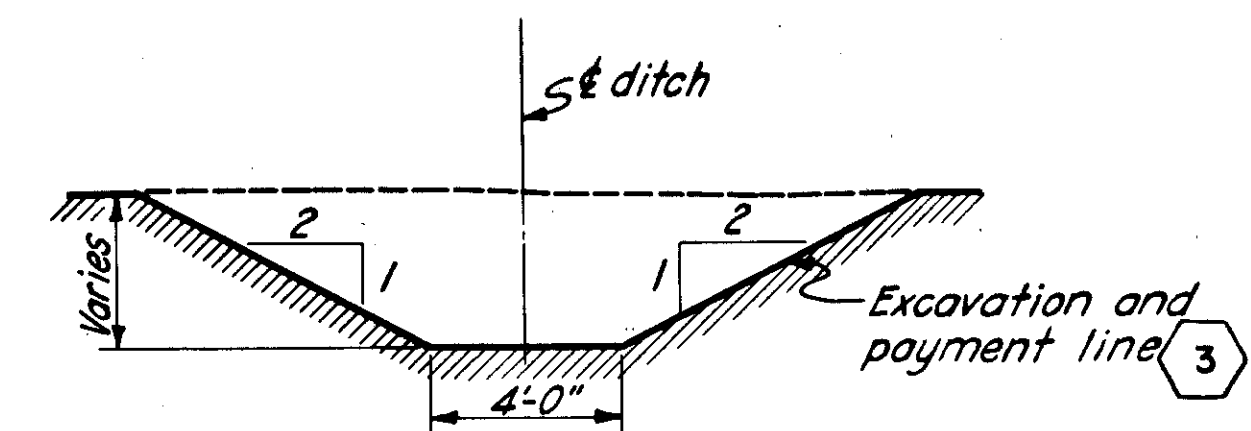
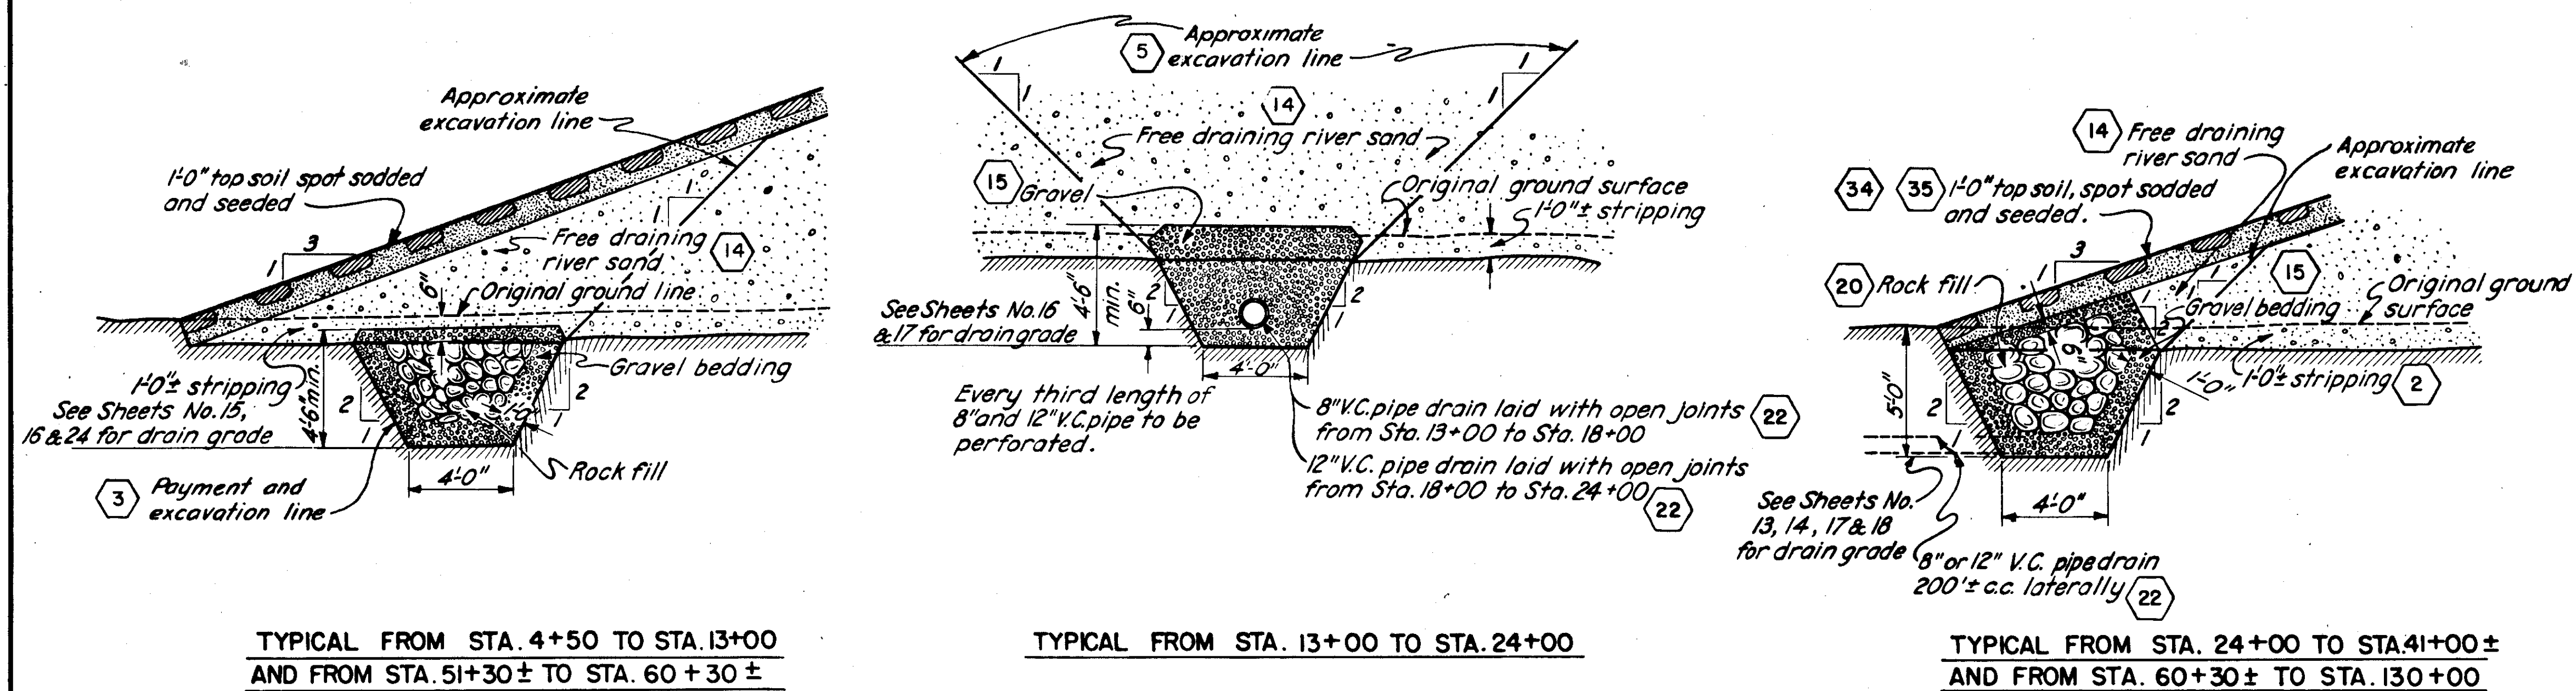
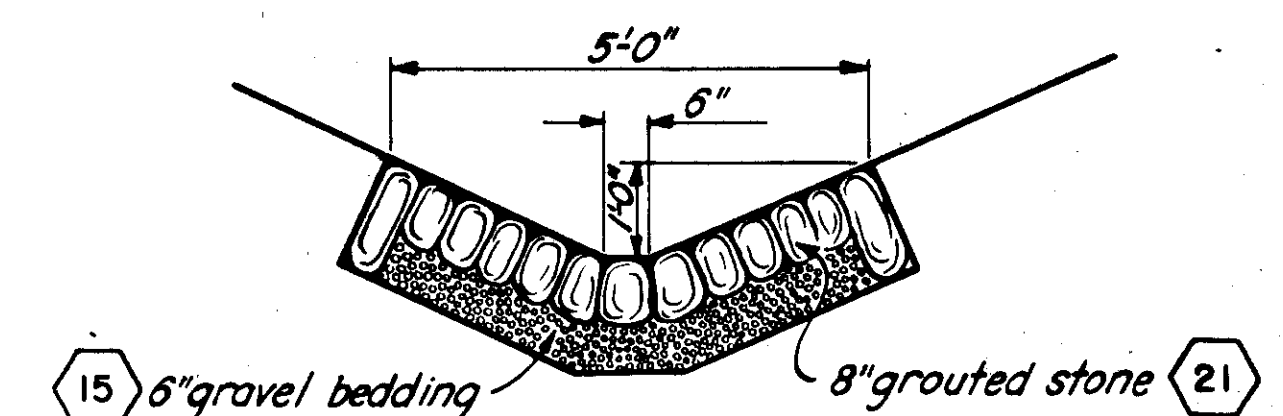
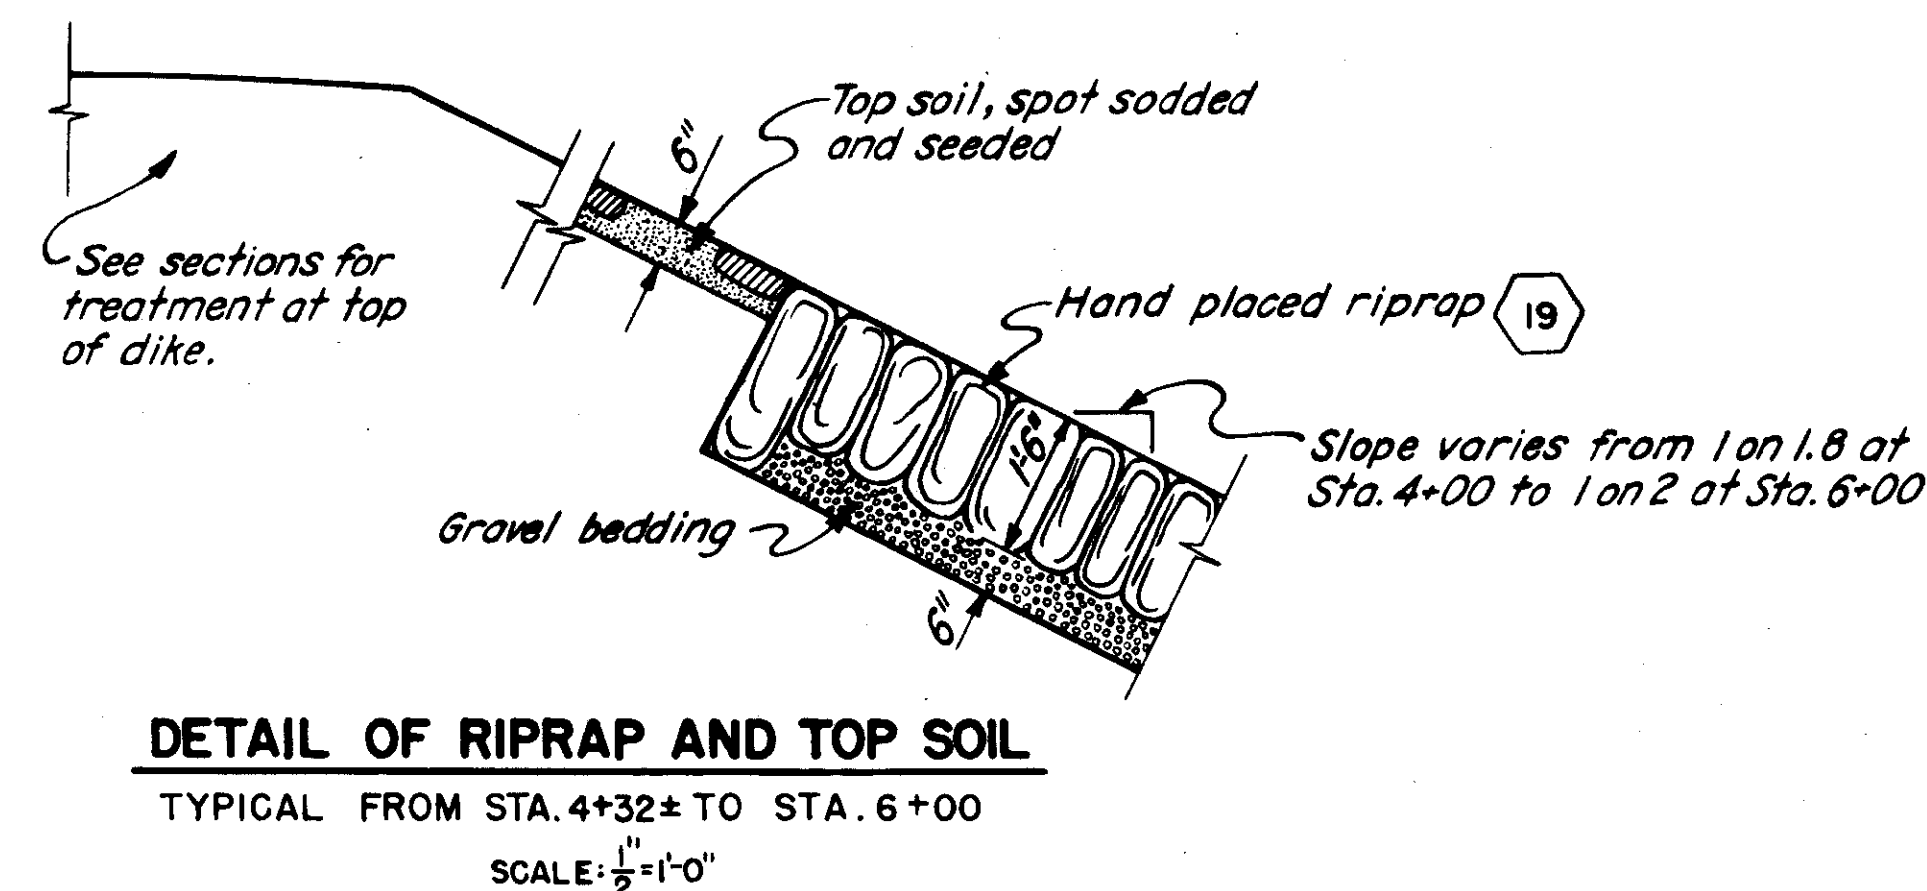
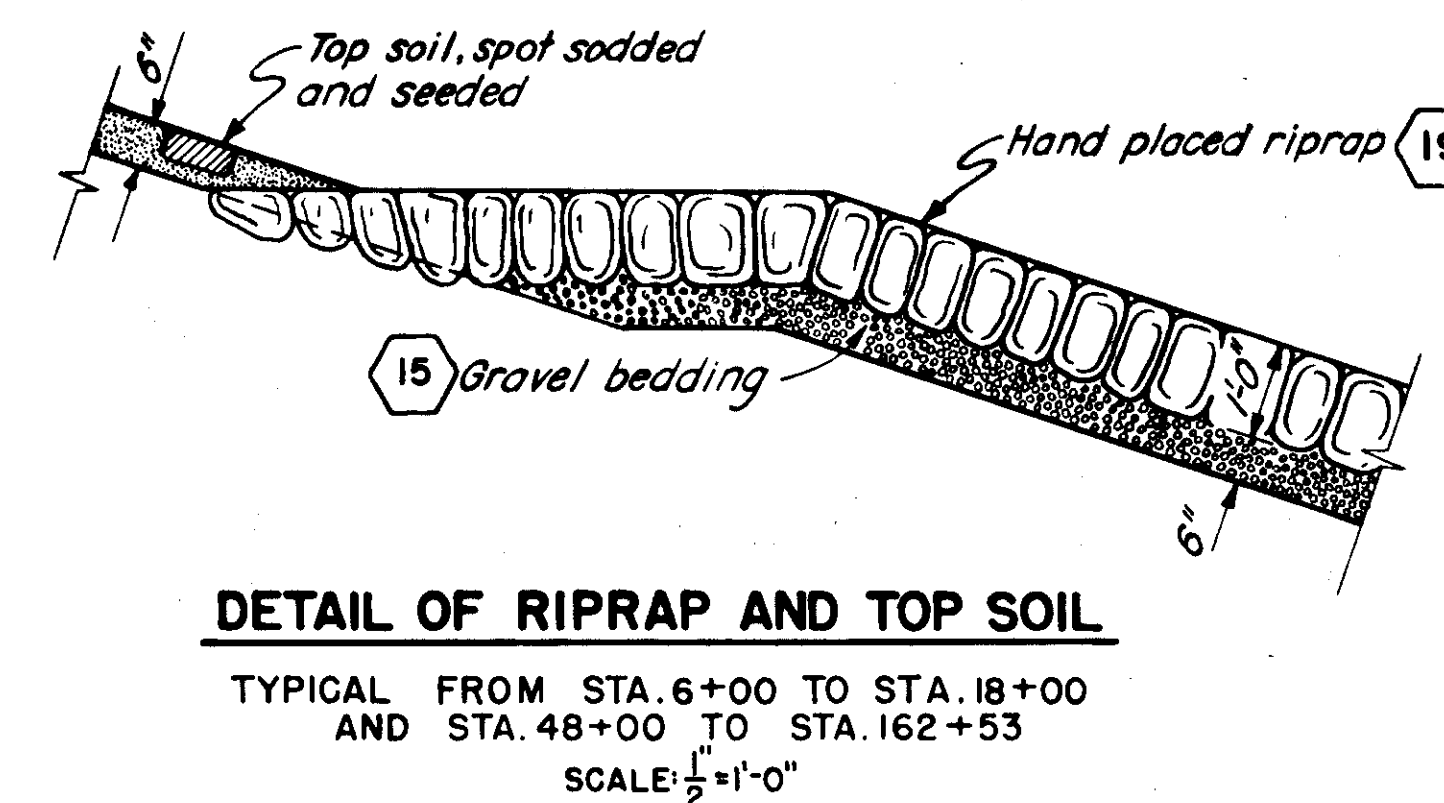
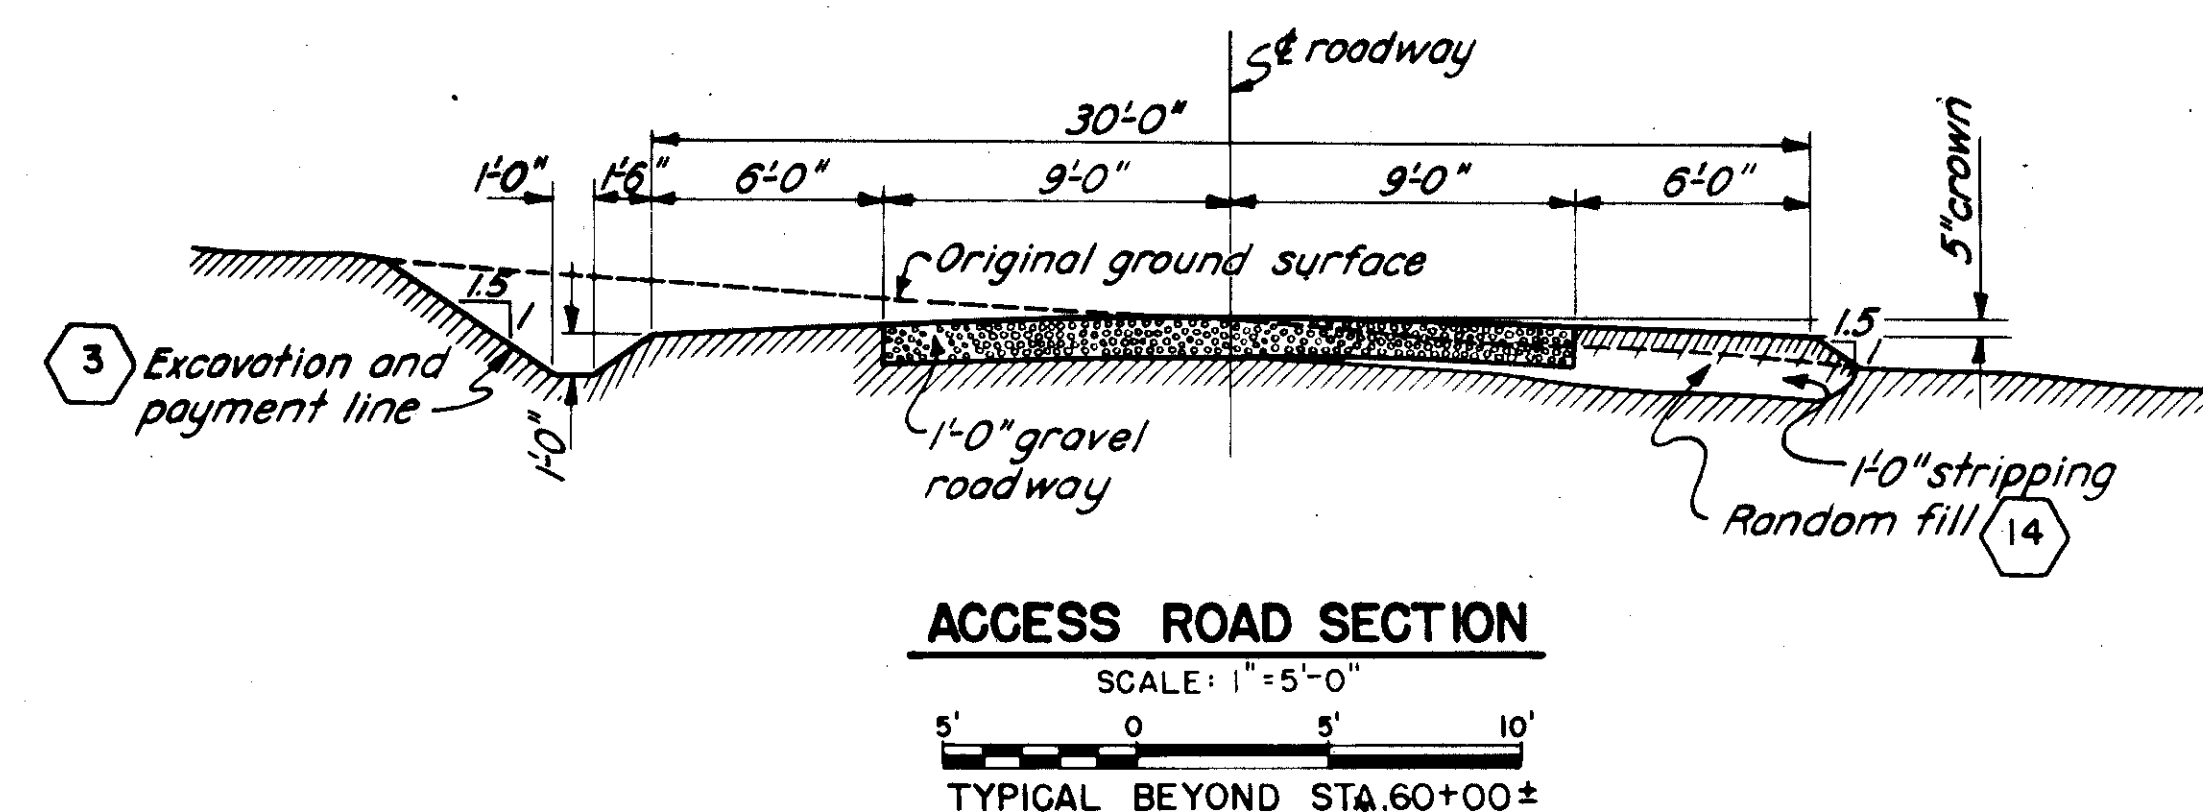
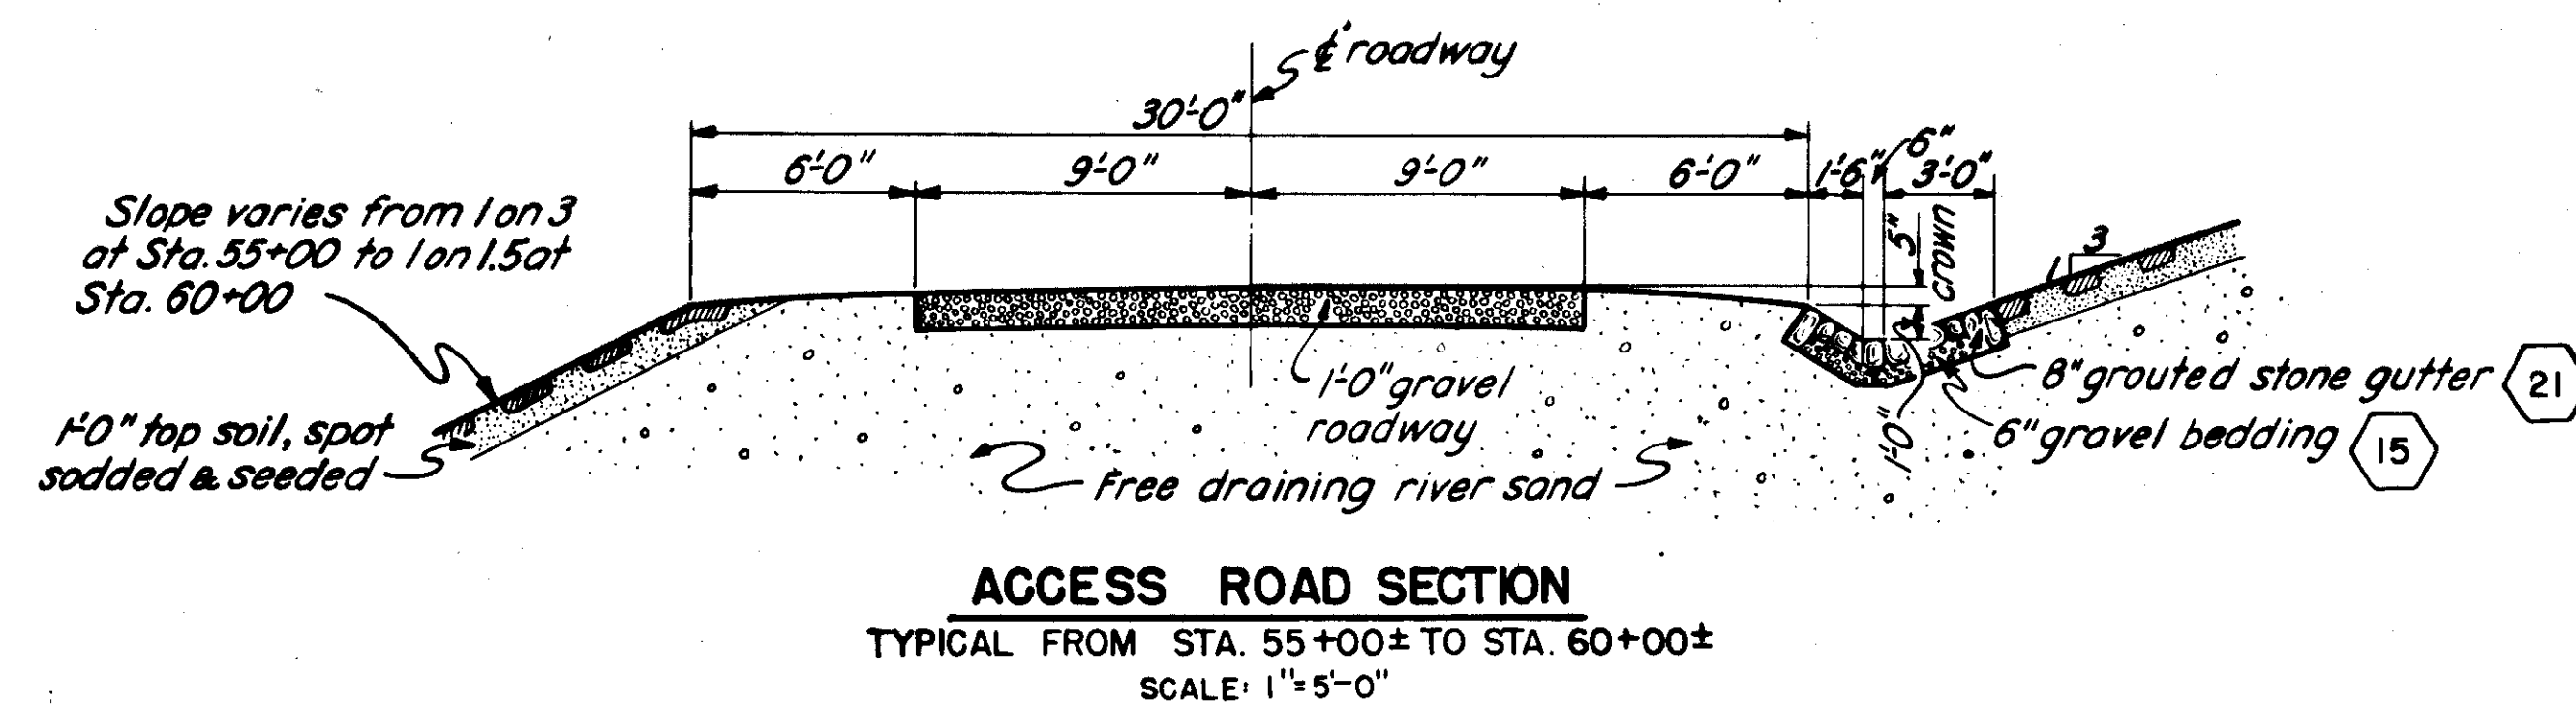


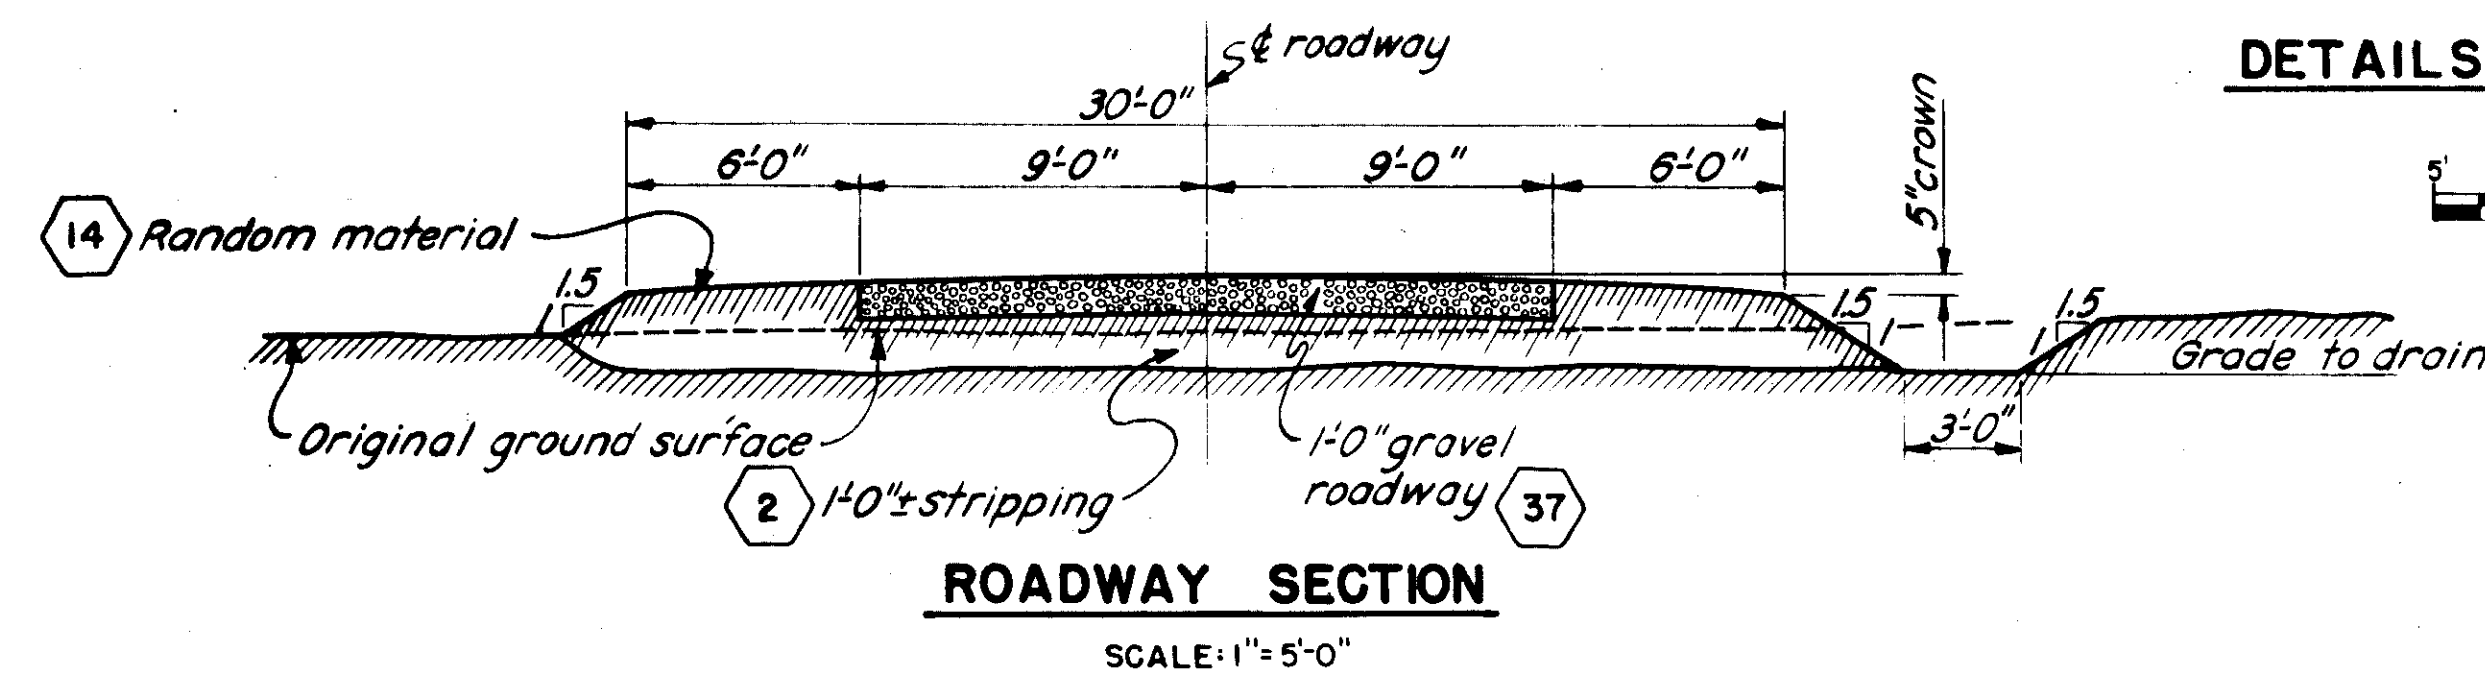

DETAILS OF LANDSIDE OF TOE DRAIN

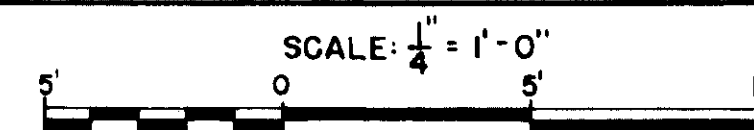

NOTE
For general notes applying to details on this sheet see Sheet No. 25.

DATE	REVISION	REV. BY	CHK. BY	AP. BY
12/31/45	As-Built Revisions			

CONNECTICUT RIVER FLOOD CONTROL			
NORTH MEADOWS DIKE			
FISCAL YEAR 1939 SECTION			
TYPICAL CROSS SECTIONS NO. 4			
HARTFORD, CONN.			
CONNECTICUT RIVER		CONNECTICUT	
IN 66 SHEETS		SHEET NO. 29	
U. S. ENGINEER OFFICE, PROVIDENCE, R. I., APRIL 1939			
SUBMITTED:	APPROVAL RECOMMENDED:	APPROVED:	
HEAD, DESIGN SECTION	PRINCIPAL ENGINEER	CHIEF, C. ENGINEERING DIV.	
DESIGNED:	DRAWN: R. D. M.	FILE NO. QT-4-1458	
TRACED: G. F. B.	CHECKED: 10/4/39		