
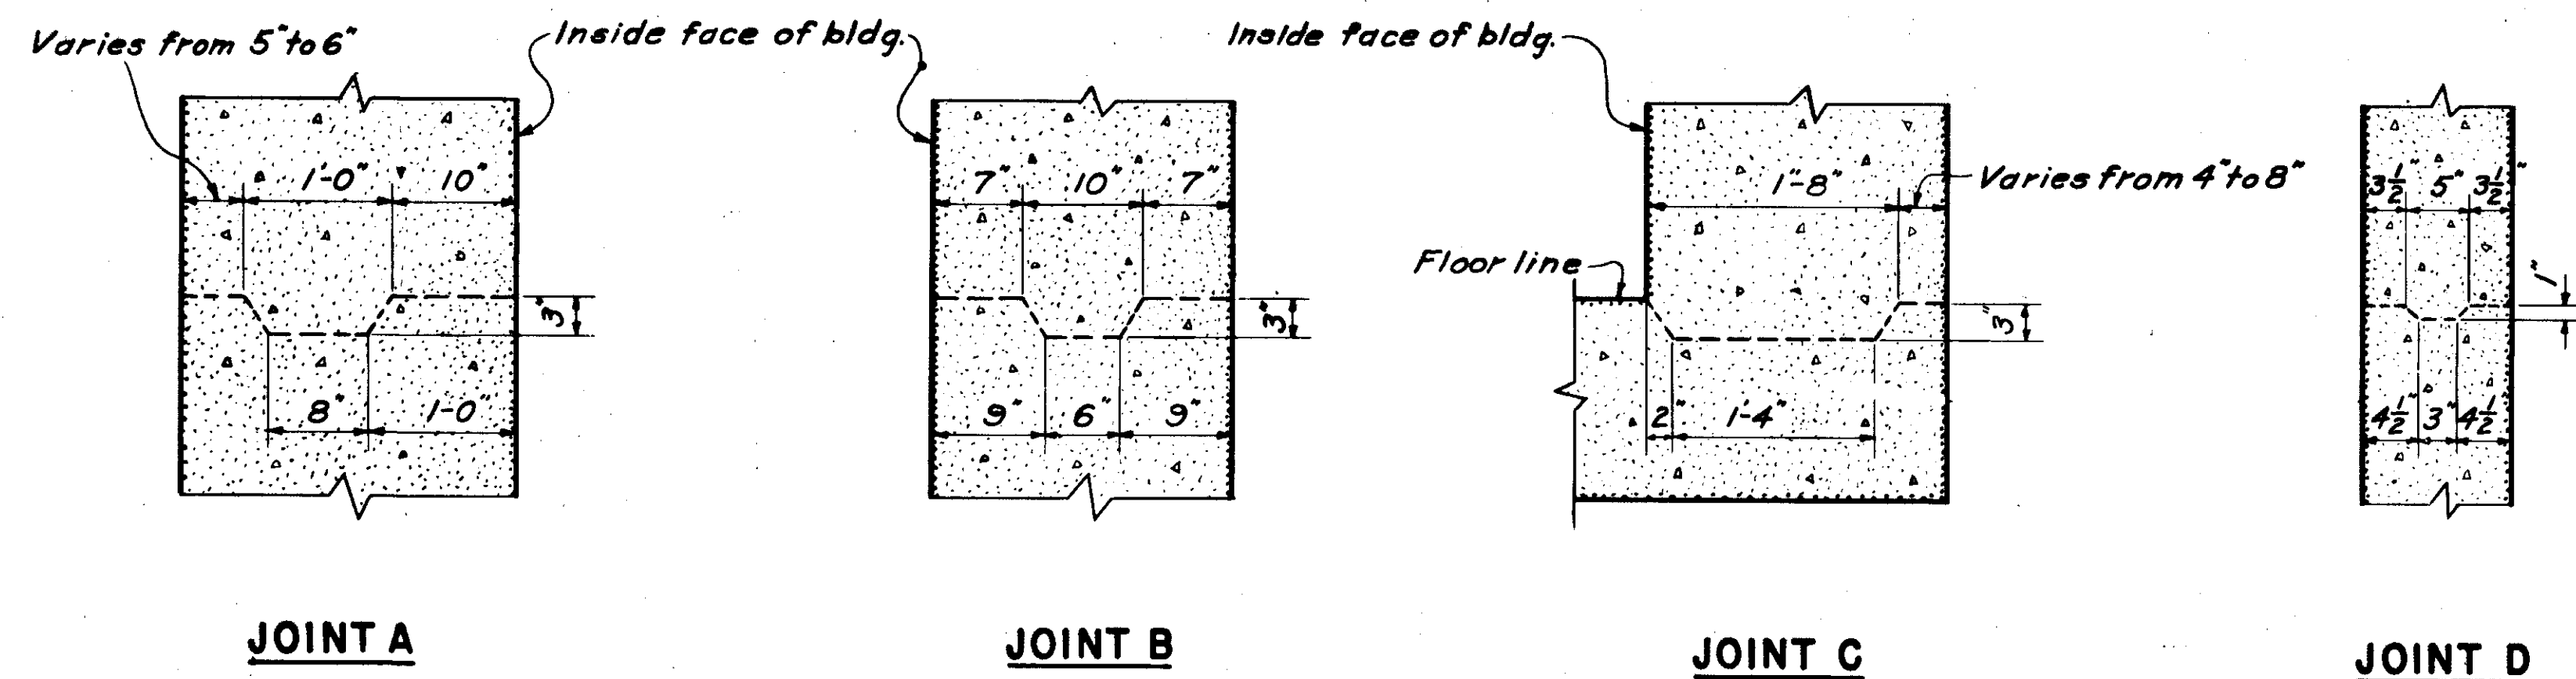


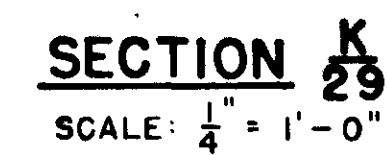

**SECTION  $\frac{G}{25}$**   
SCALE:  $\frac{1}{2}" = 1'-0"$

|                                                   |  |                           |               |                             |  |
|---------------------------------------------------|--|---------------------------|---------------|-----------------------------|--|
| CONNECTICUT RIVER                                 |  |                           | FLOOD CONTROL |                             |  |
| NORTH MEADOWS PUMPING STATION                     |  |                           |               |                             |  |
| FISCAL YEAR 1939 SECTION                          |  |                           |               |                             |  |
| CONDUIT DETAILS NO. 1                             |  |                           |               |                             |  |
| CONNECTICUT RIVER                                 |  |                           | CONNECTICUT   |                             |  |
| IN 62 SHEETS                                      |  | SCALE: 1/4IN. = 1 FT.     |               | SHEET NO. 33                |  |
|                                                   |  |                           |               |                             |  |
| U.S. ENGINEER OFFICE, PROVIDENCE, R.I., FEB. 1939 |  |                           |               |                             |  |
| SUBMITTED:                                        |  | APPROVAL RECOMMENDED:     |               | APPROVED:                   |  |
| <i>Howard B. Niebuhr</i>                          |  | <i>W. D. Burns</i>        |               | <i>W. D. Burns</i>          |  |
| SENIOR ENGINEER                                   |  | PRINCIPAL ENGINEER        |               | LT. COL. CORPS OF ENGINEERS |  |
| HEAD DESIGN SECTION                               |  | CHIEF OF ENGINEERING DIV. |               | DISTRICT ENGINEERS          |  |
| DESIGNED:                                         |  | DRAWN:                    |               | FILE NO. CT-4-1281          |  |
| <i>E. M. Viner</i>                                |  | <i>W. M. V.</i>           |               |                             |  |
| ASSOC. ENGINEER                                   |  | CHECKED BY:               |               |                             |  |

|          |                                |        |       |      |
|----------|--------------------------------|--------|-------|------|
|          |                                |        |       |      |
| 12-31-45 | As built                       |        |       |      |
| 6/28/39  | Section 4/29 item nos. changed | J.C.D. | K.W.  | J.H. |
| DATE     | REVISION                       | REV BY | CK BY | APP  |