
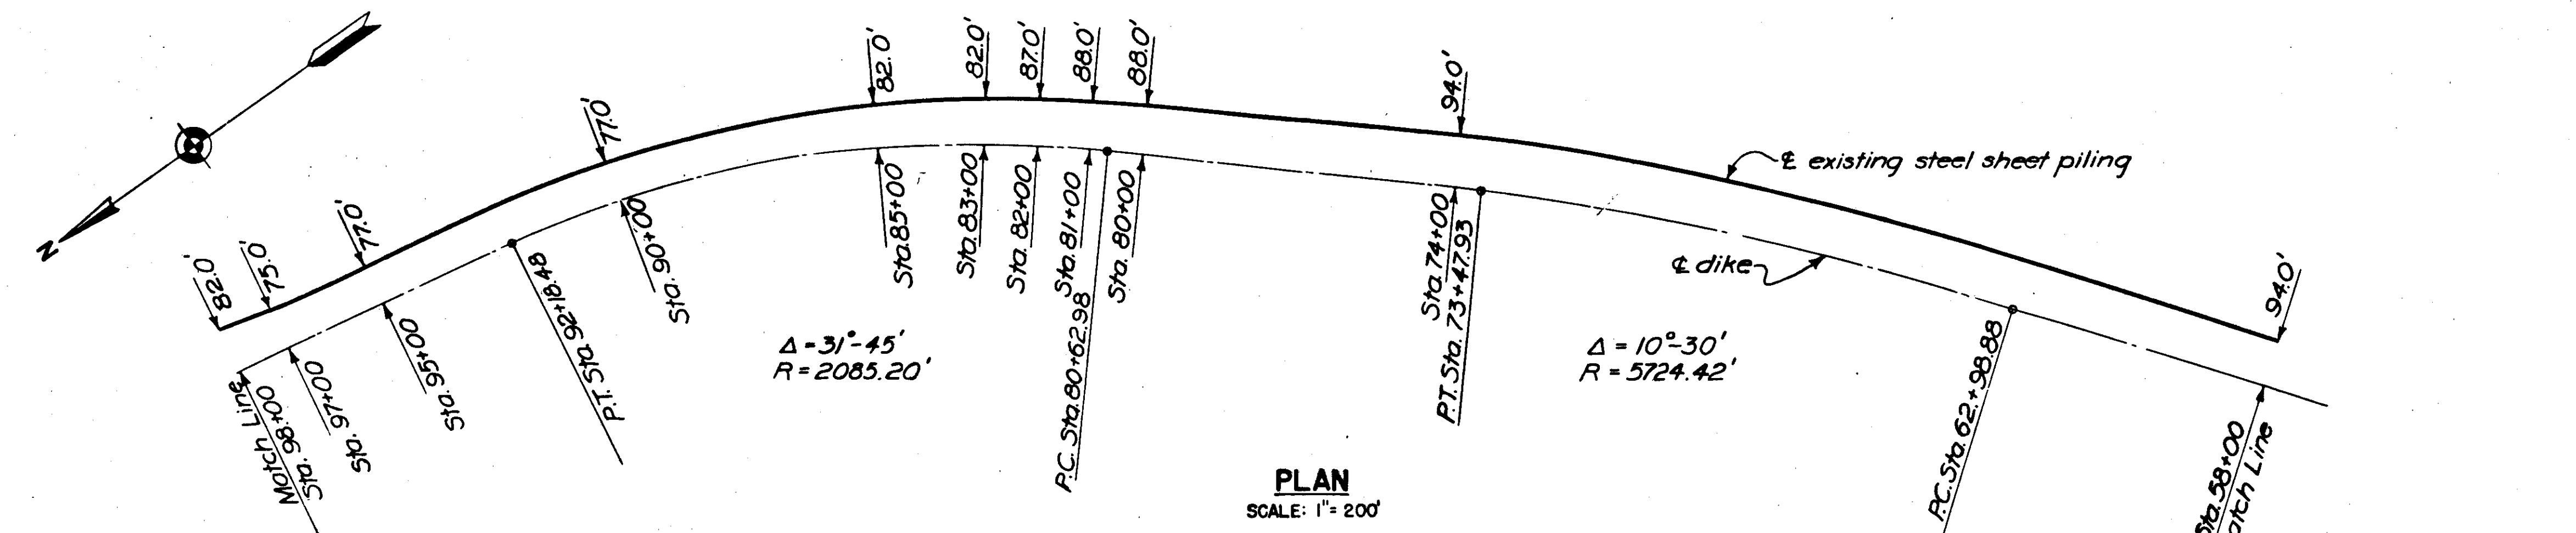
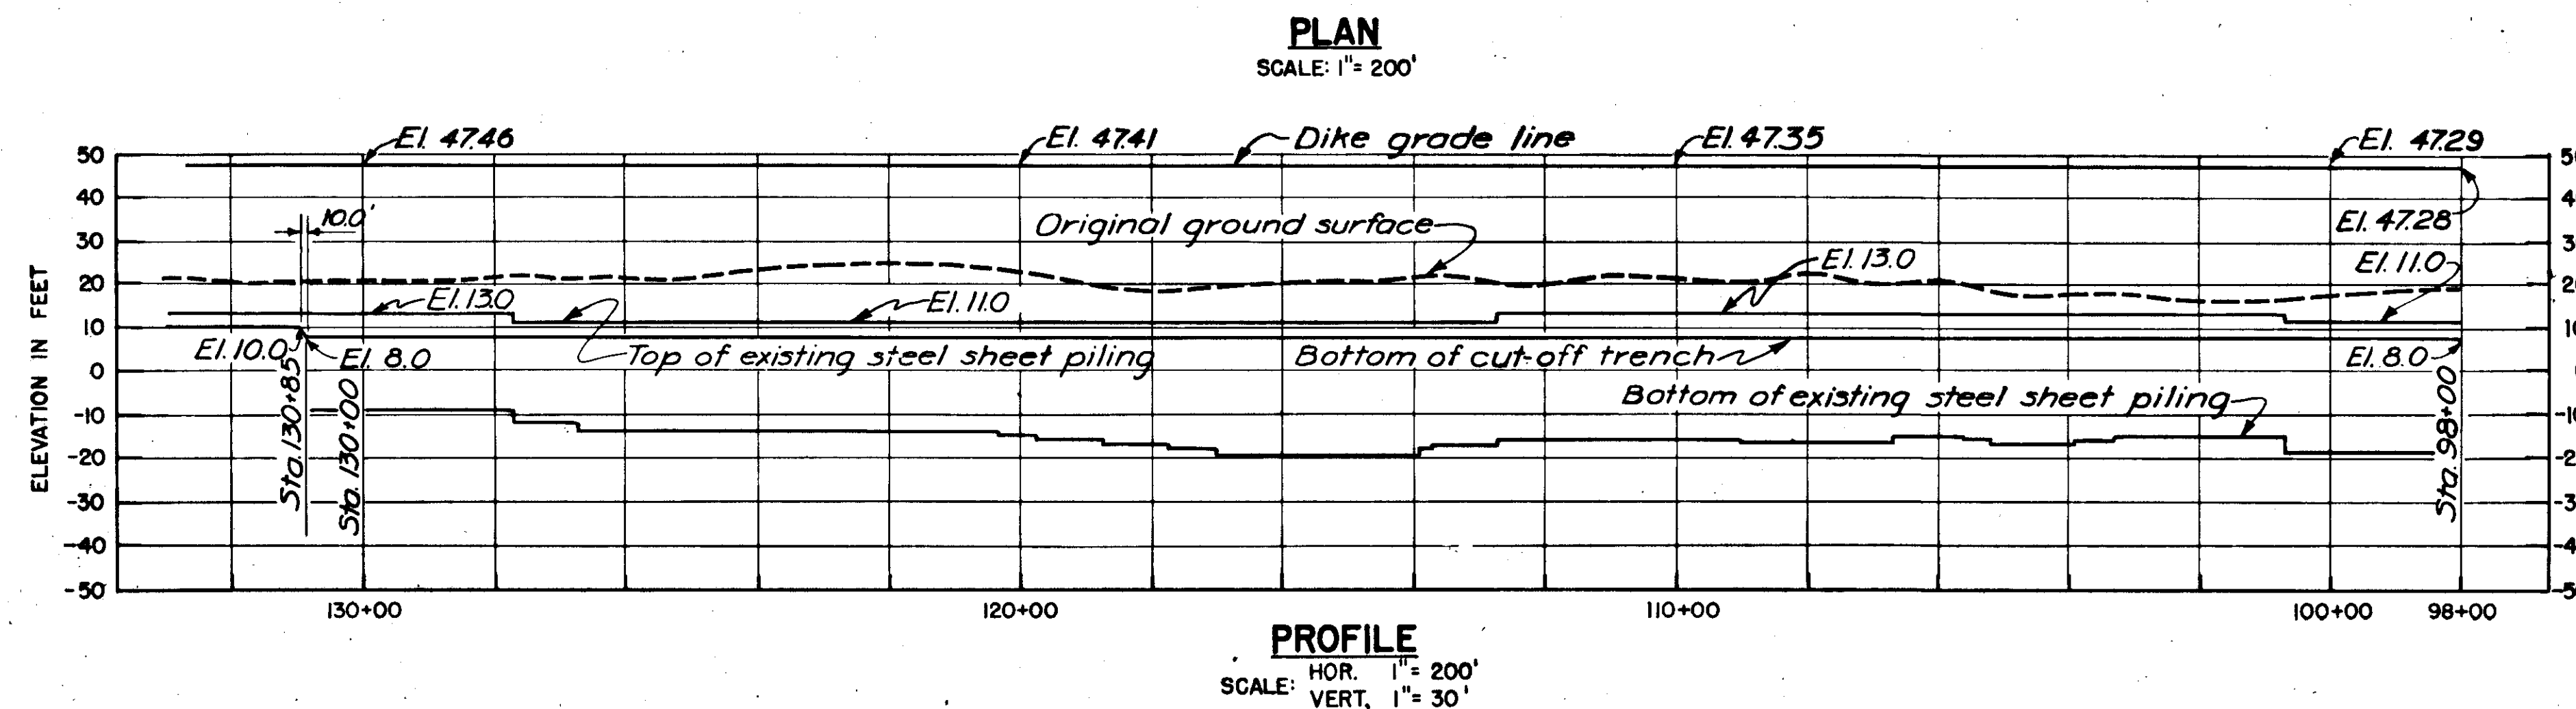
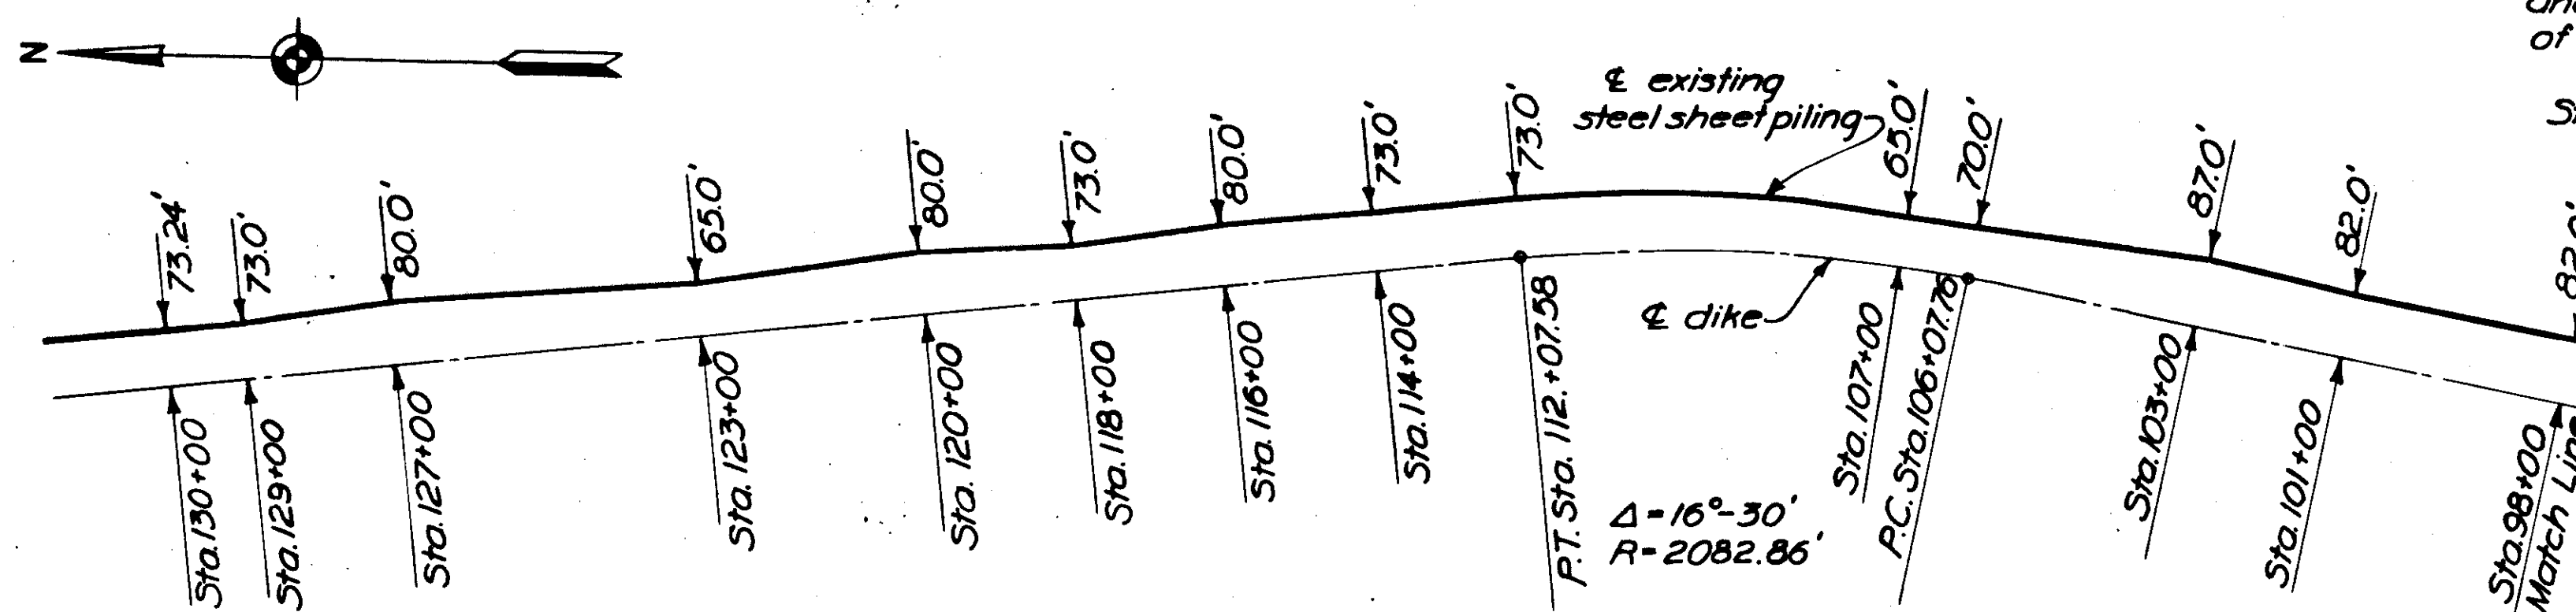


Note
Stripped material from previous operations to be used for top soil, or to be wasted as directed by the contracting officer. (10)

Material from previous cut off trench excavation to be rehandled and placed in the random section of the dike embankment by others

Stripping completed by others

See Profile for bond into cut-off trench of existing sheet pile.

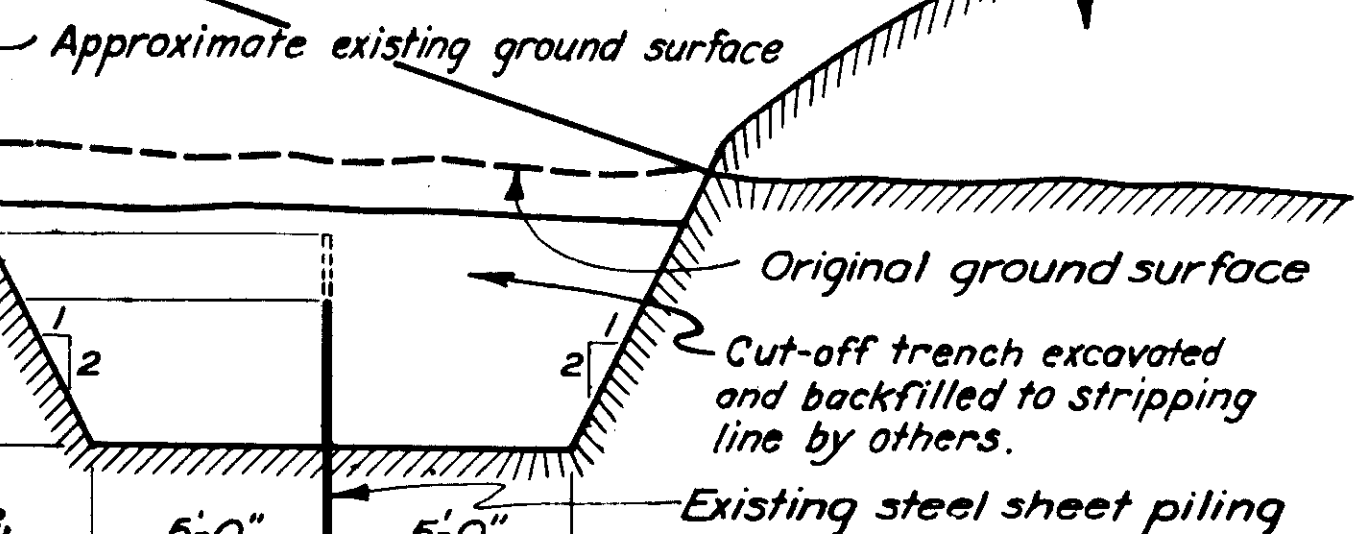

NOTES

Elevations refer to Mean Sea Level Datum.

Figures in hexagons refer to bid item numbers under which payment will be made.

Steel sheet piling shown on this sheet is already in place. Sheet is included to show cut-off trench alignment and treatment.

12/31/45 As-Built			
DATE	REVISION	REV. BY	CK. BY
CONNECTICUT RIVER FLOOD CONTROL			
NORTH MEADOWS DIKE			
FISCAL YEAR 1939 SECTION			
STEEL SHEET PILING LAYOUT NO. 4			
HARTFORD, CONN.			
CONNECTICUT RIVER		CONNECTICUT	
IN 66 SHEETS	SCALE: 1 IN. = 200 FT.	SHEET NO. 33	
U. S. ENGINEER OFFICE, PROVIDENCE, R. I., APRIL 1939			
SUBMITTED	APPROVAL	RECOMMENDED	APPROVED
DESIGNED	DRAWN	CHECKED	FILE NO. CT-4-1462