



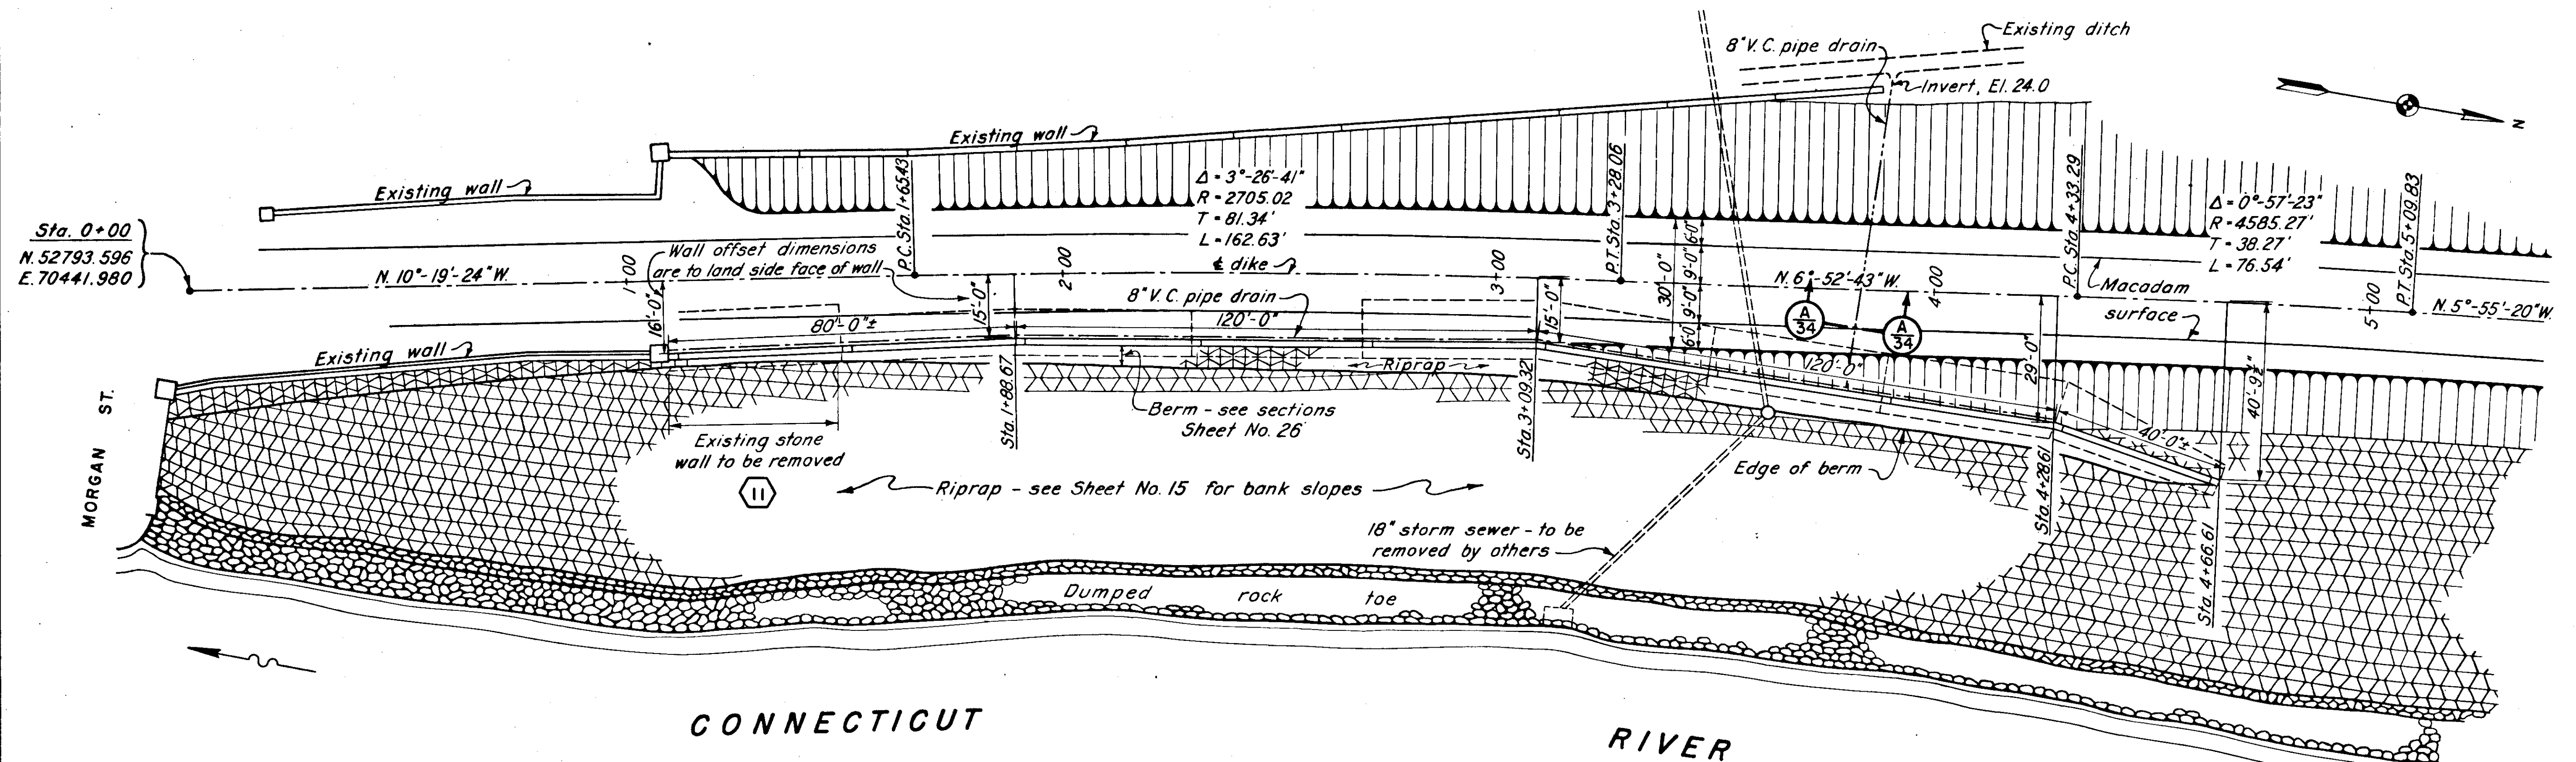

PLAN

SCALE: 1" = 20'-0"

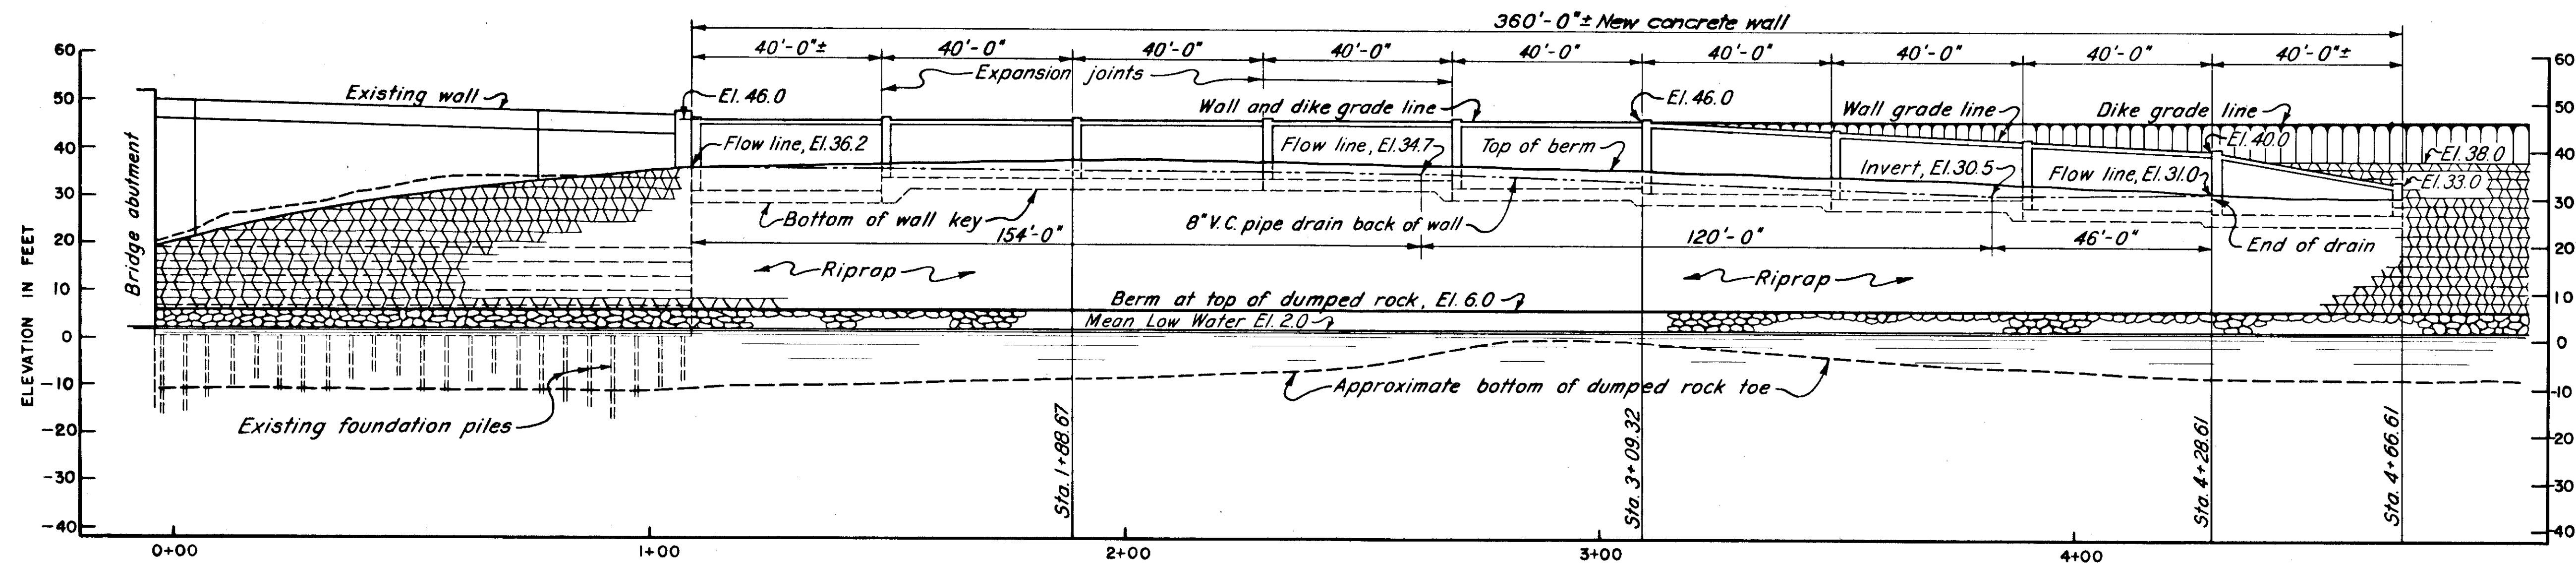

ELEVATION - DEVELOPED

SCALE: 1" = 20'-0"


NOTES

Elevations refer to Mean Sea Level datum.

For details of wall, see Sheet No. 35.

For steel reinforcement, see Sheets No. 36, 37 and 38.

Coordinates refer to City of Hartford system.

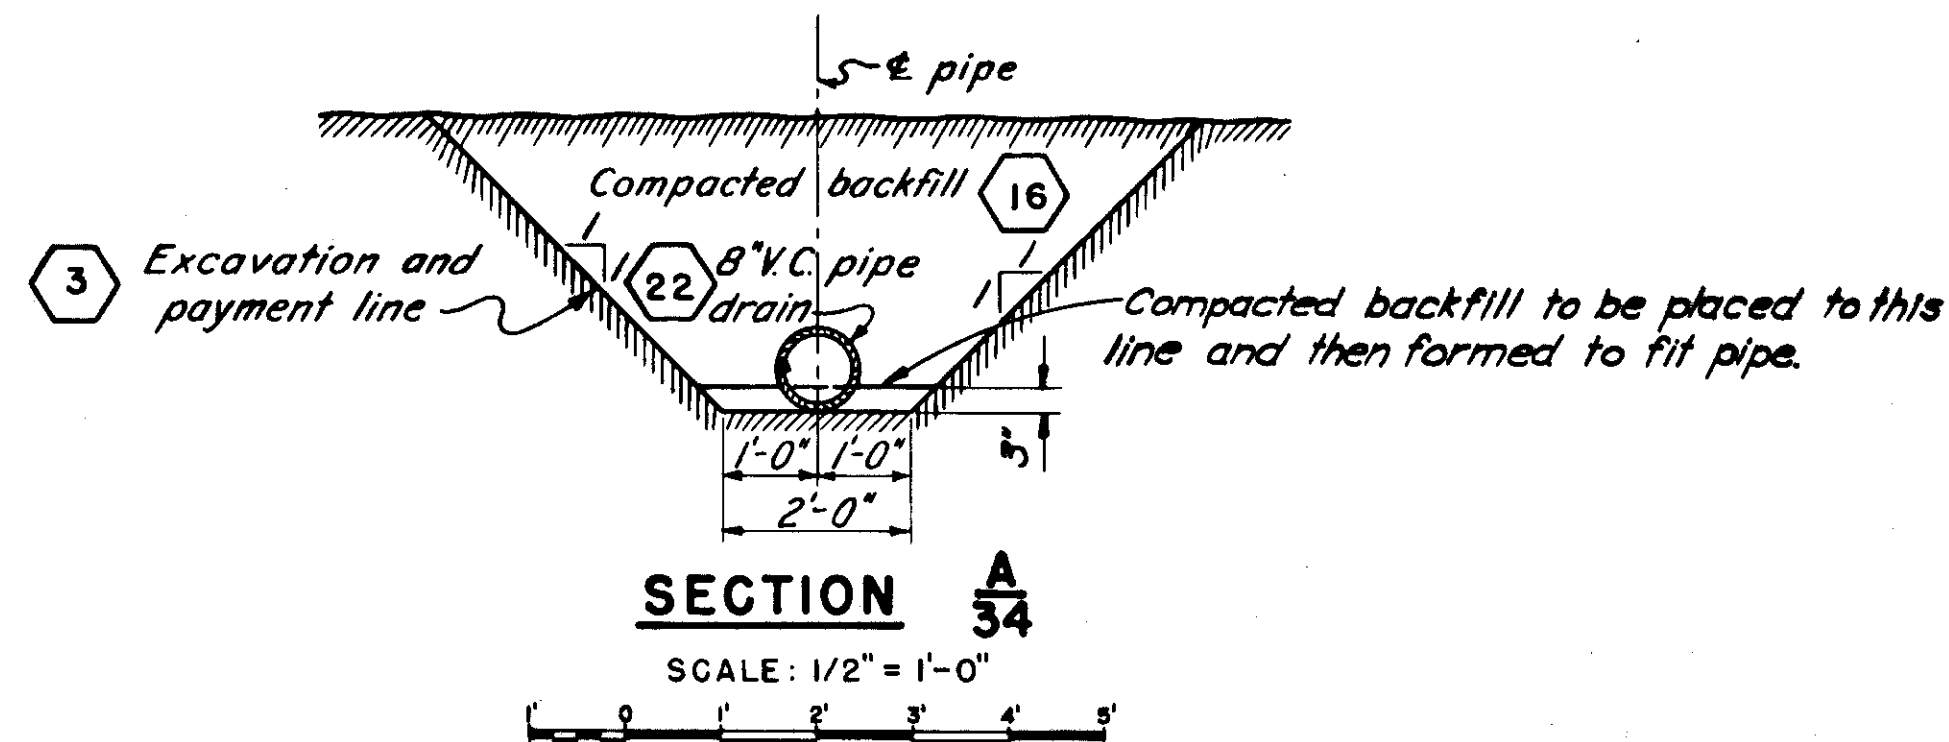

SECTION A-34

SCALE: 1/2" = 1'-0"

DATE	REVISION	REV. BY	CK. BY	AP. BY
12/31/45	As-Built			

CONNECTICUT RIVER FLOOD CONTROL

NORTH MEADOWS DIKE

FISCAL YEAR 1939 SECTION

PLAN OF CONCRETE WALL

HARTFORD, CONN.

CONNECTICUT RIVER

IN 66 SHEETS

SCALE: 1" = 20' FT.

CONNECTICUT

SHEET NO. 34

U. S. ENGINEER OFFICE, PROVIDENCE, R. I., APRIL 1939

SUBMITTED: H. B. Nichols SENIOR ENGINEER HEAD, DESIGN SECTION	APPROVAL RECOMMENDED: J. S. Burns PRINCIPAL ENGINEER CHIEF, F. C. ENGINEERING DIV.	APPROVED: J. S. Burns DISTRICT ENGINEER
DESIGNED: J. S. Burns ASSOC. ENGINEER	DRAWN: M. B. Mc. CHECKED: LOGL	FILE NO. CT-4-1463