


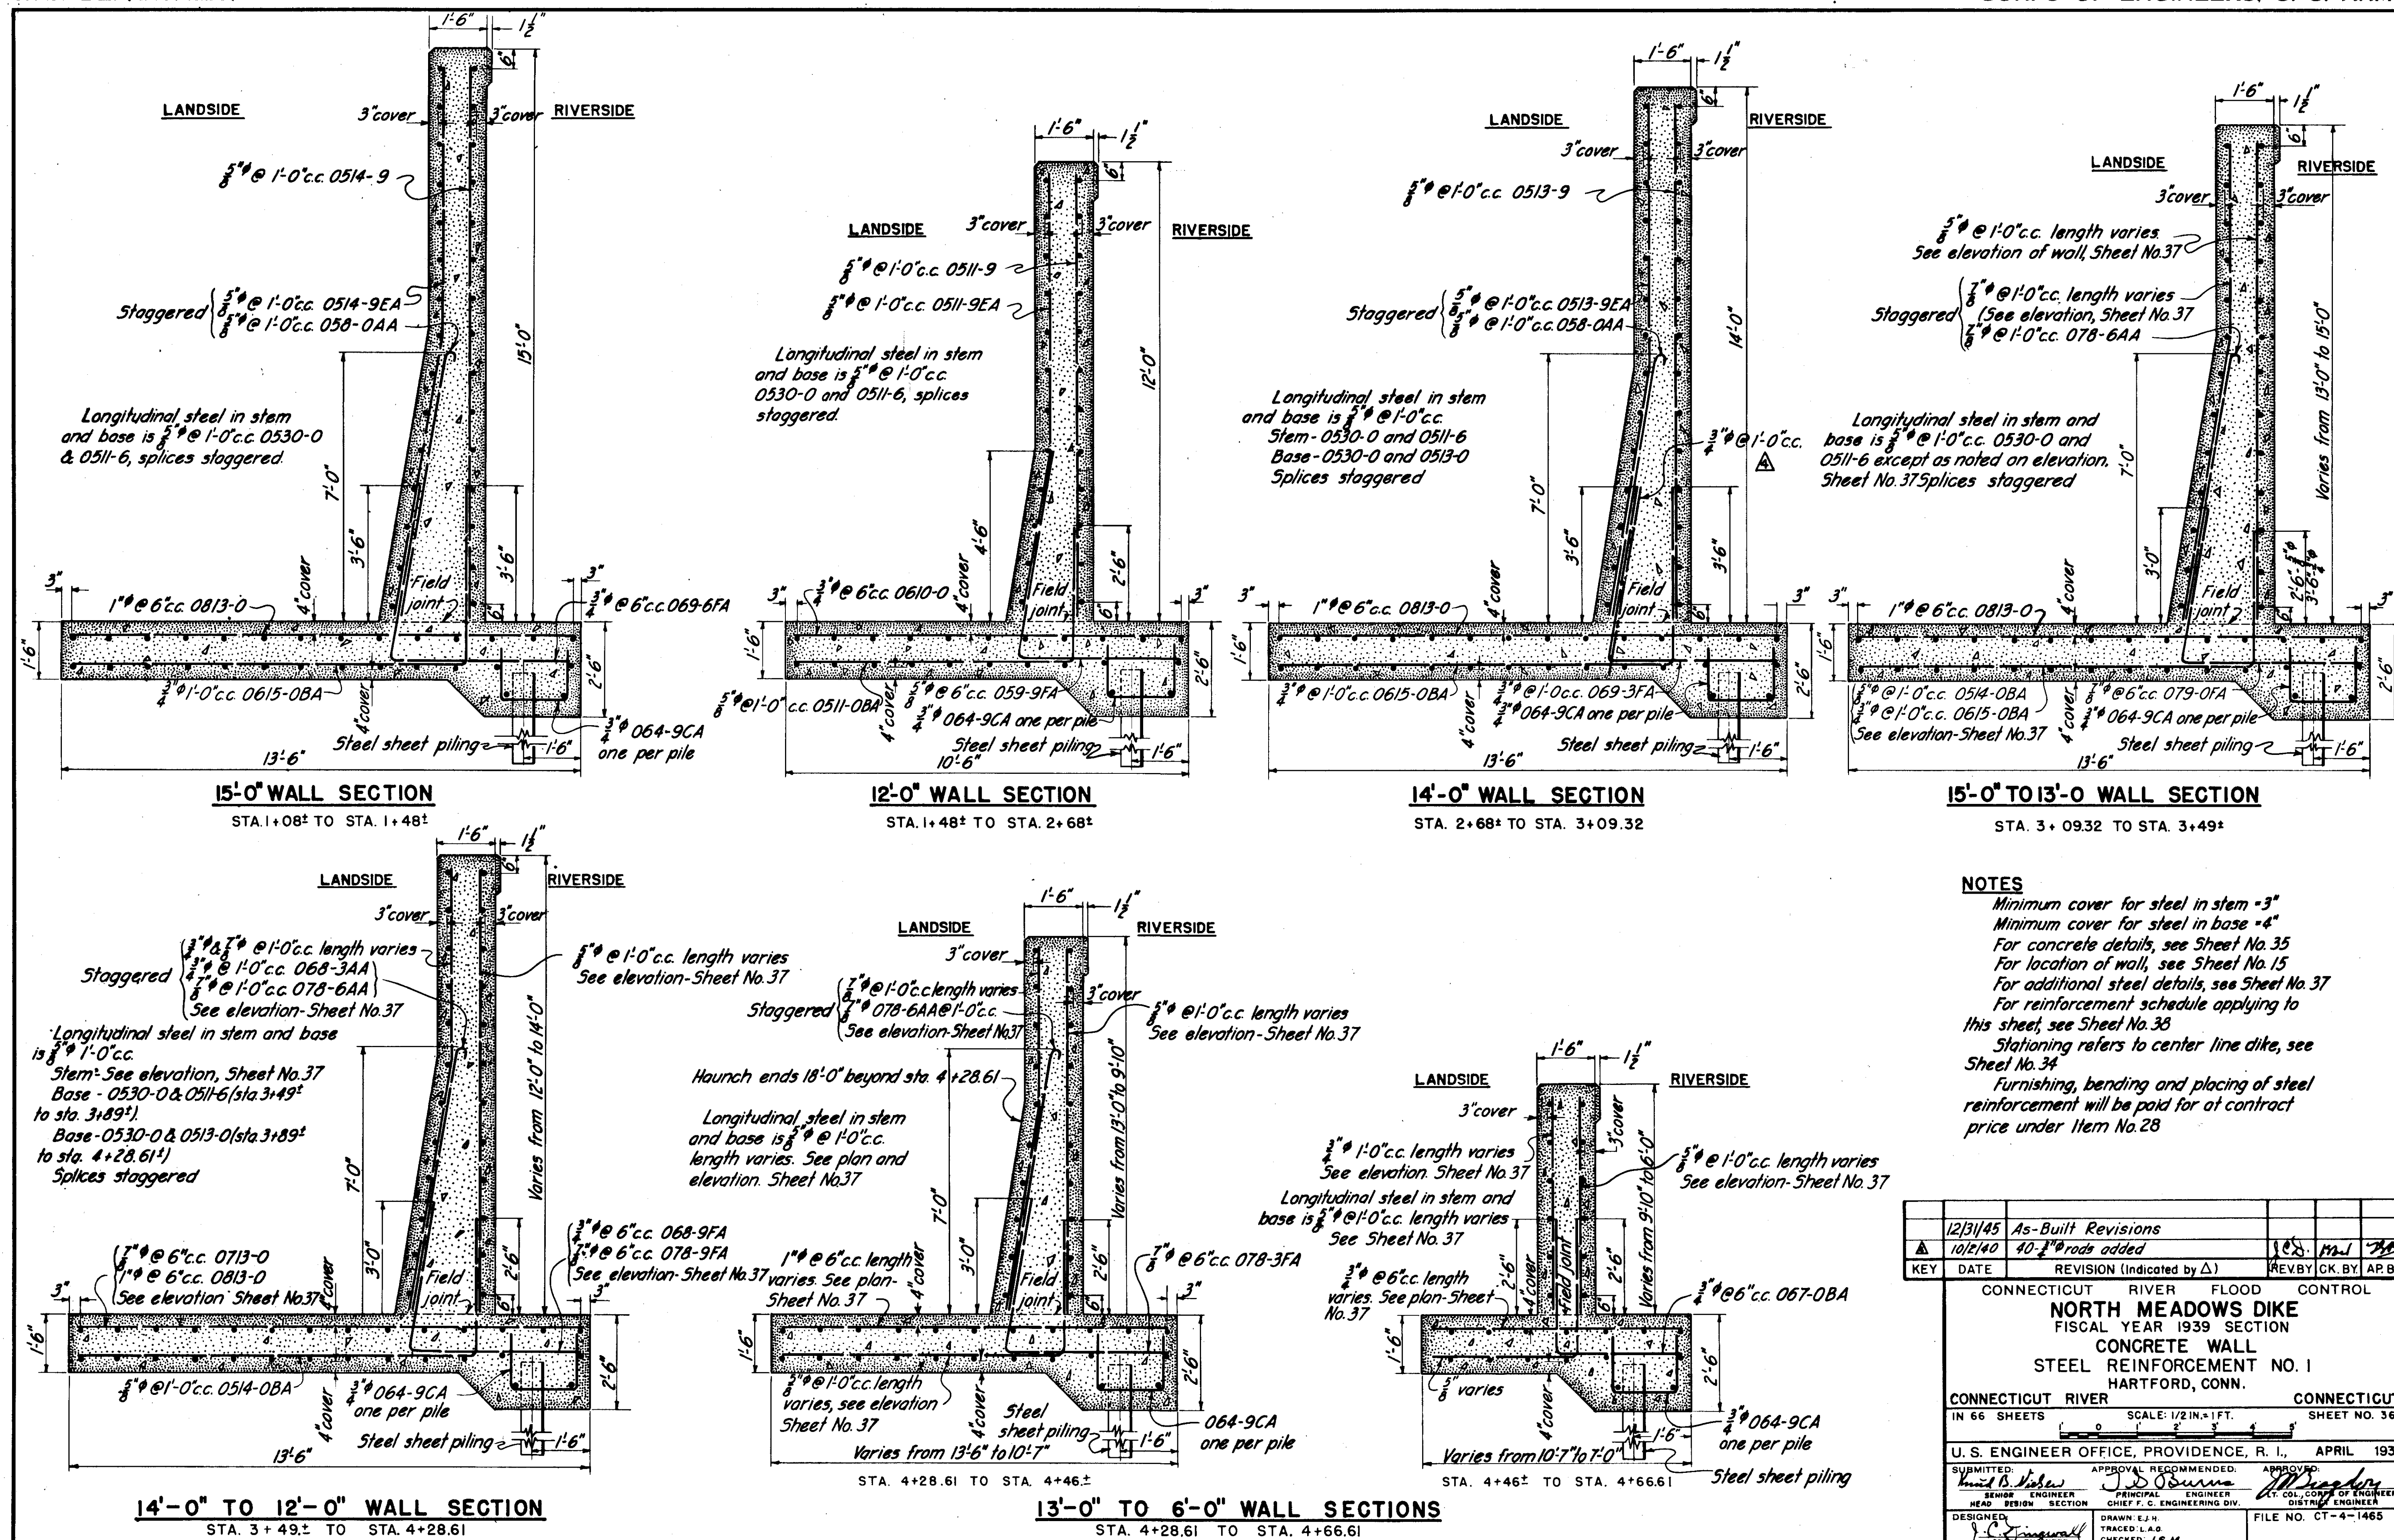

KEY	DATE	REVISION (Indicated by Δ)	REV BY	CHK BY	AP BY
	12/31/45	As-Built Revisions			
	10/2/40	40-3" Rods added			

CONNECTICUT RIVER FLOOD CONTROL	
NORTH MEADOWS DIKE	
FISCAL YEAR 1939 SECTION	
CONCRETE WALL	
STEEL REINFORCEMENT NO. 1	
HARTFORD, CONN.	
CONNECTICUT RIVER	CONNECTICUT
IN 66 SHEETS	SHEET NO. 36
SCALE: 1/2" = 1 FT.	
U. S. ENGINEER OFFICE, PROVIDENCE, R. I., APRIL 1939	
SUBMITTED BY HEAD DESIGN SECTION	APPROVED BY CHIEF F. C. ENGINEERING DIV.
DESIGNED BY ASSOC. ENGINEER	FILE NO. CT-4-1465