
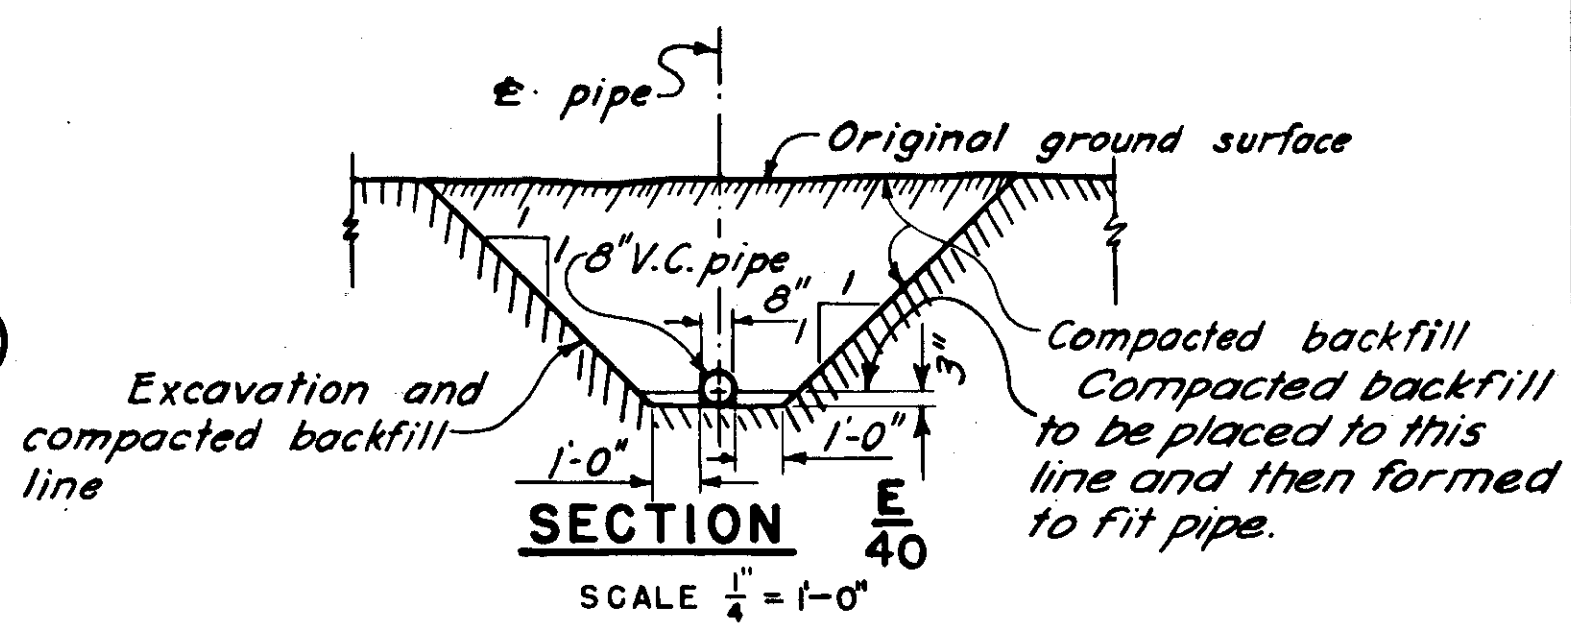
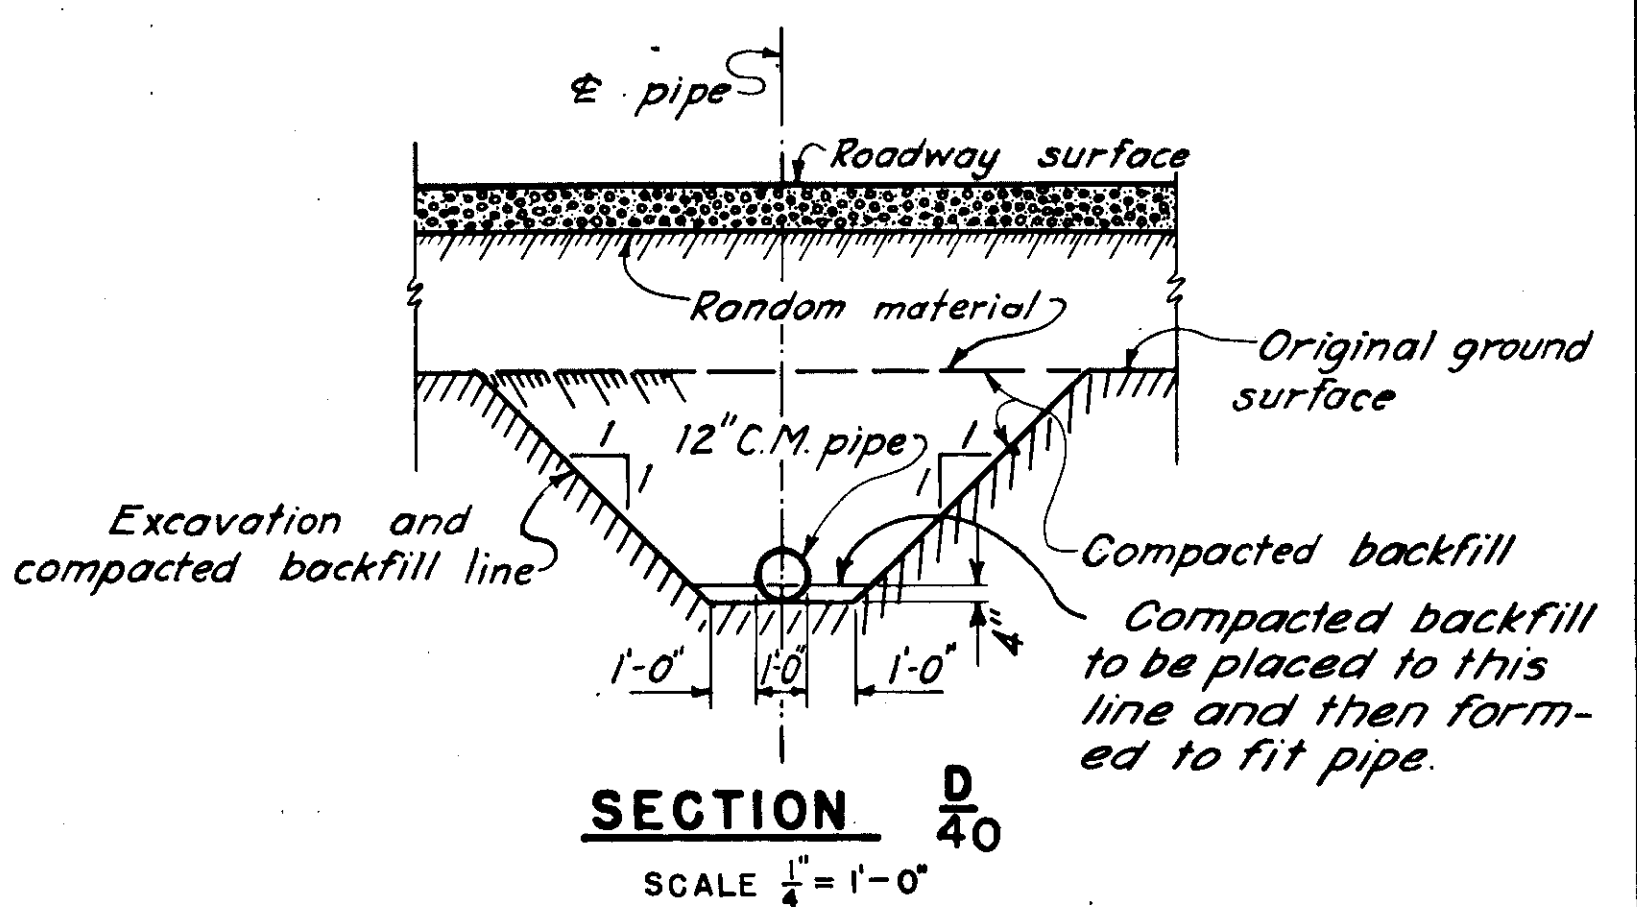
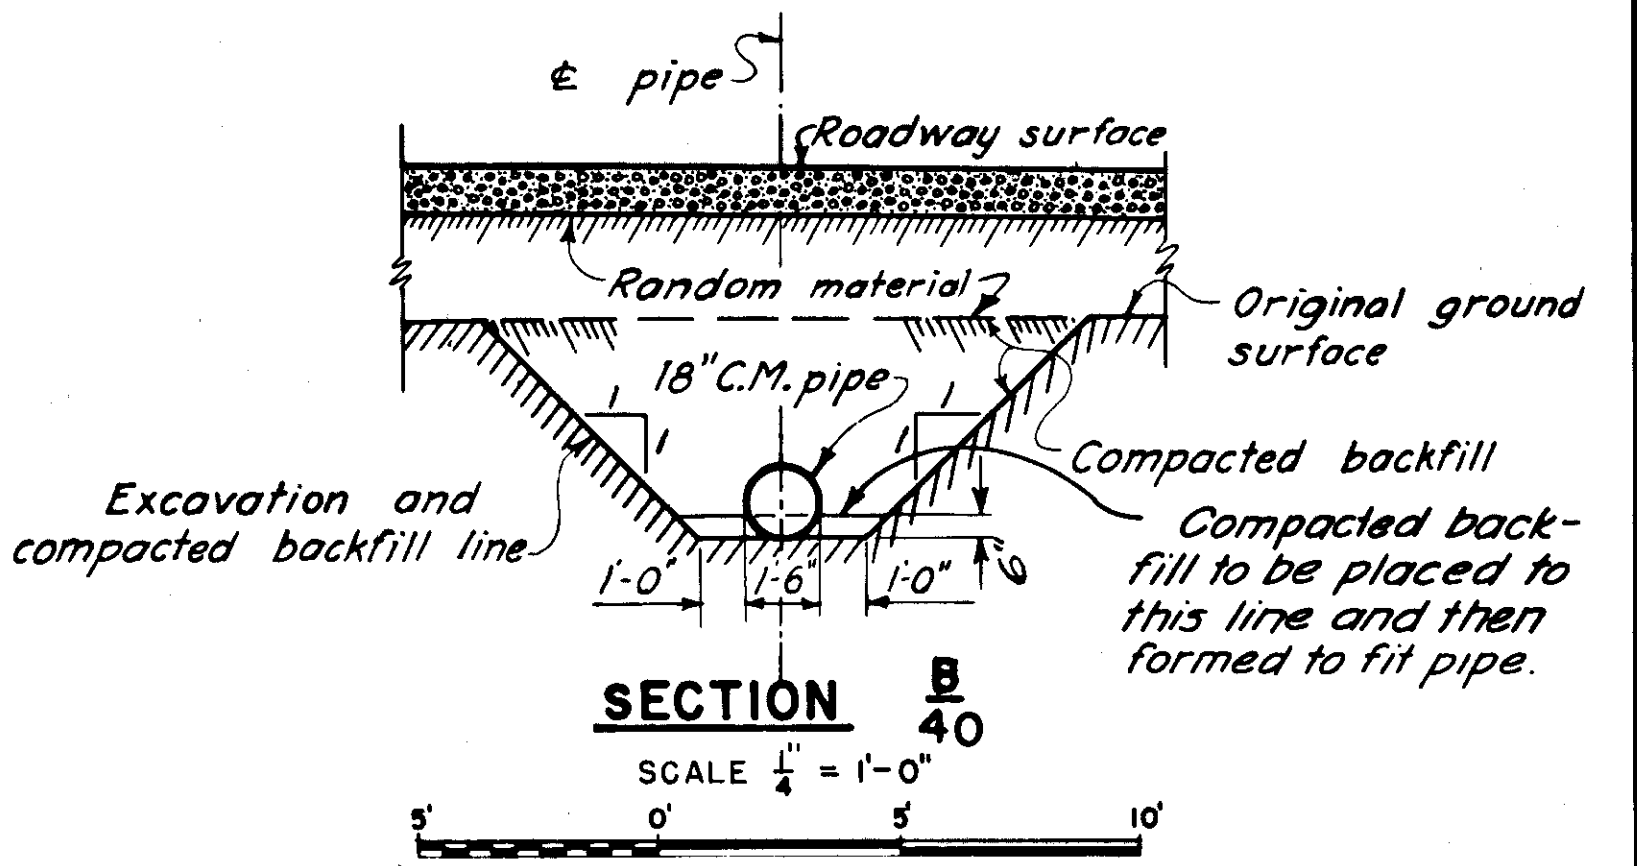
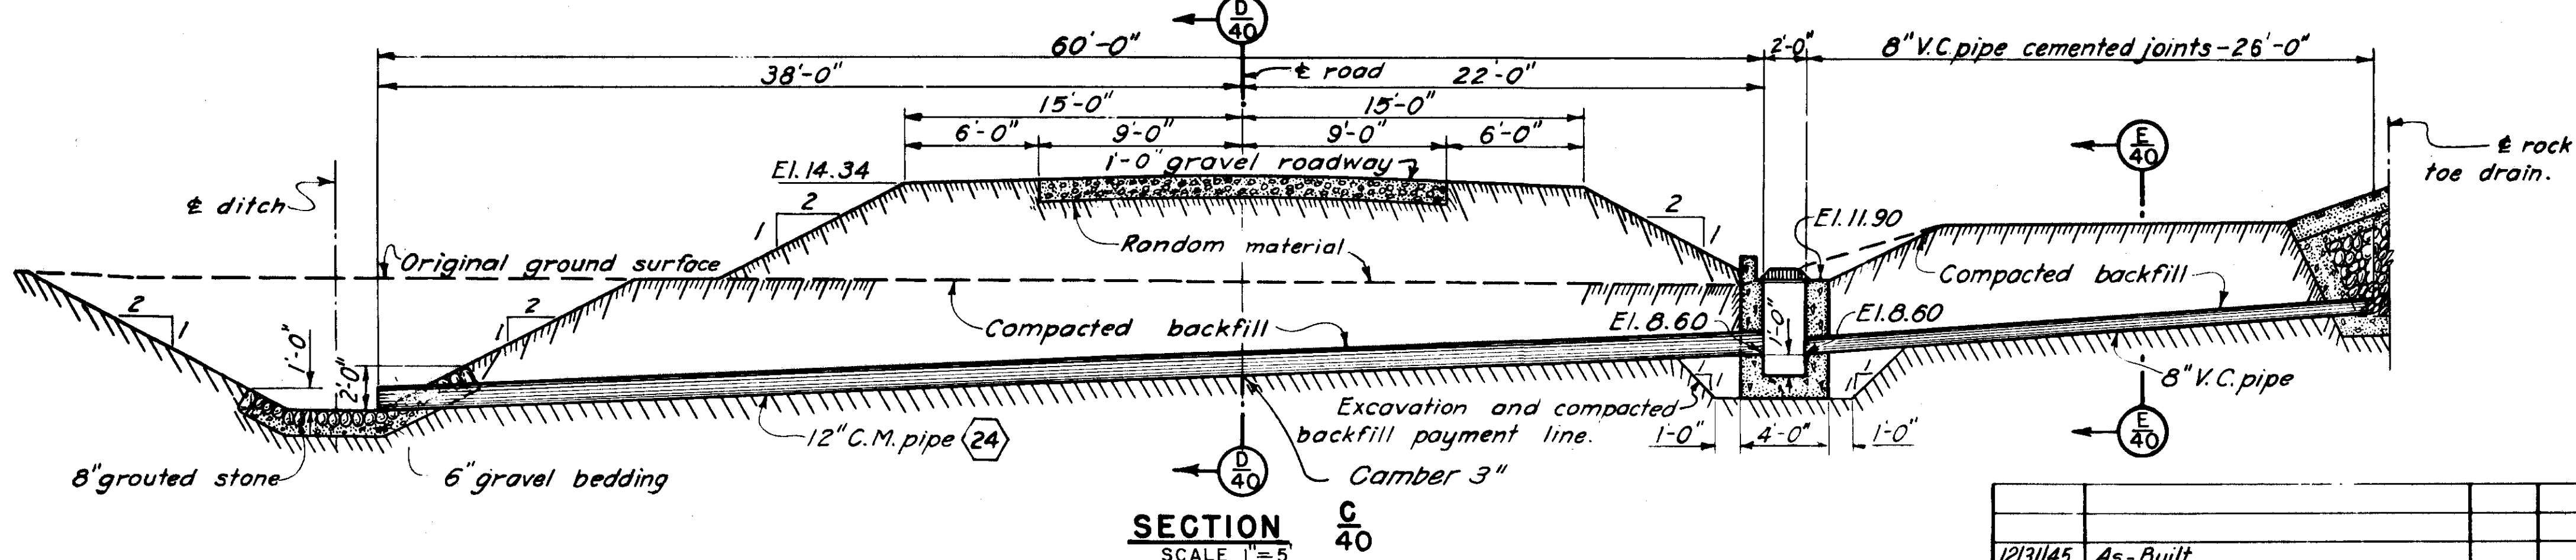
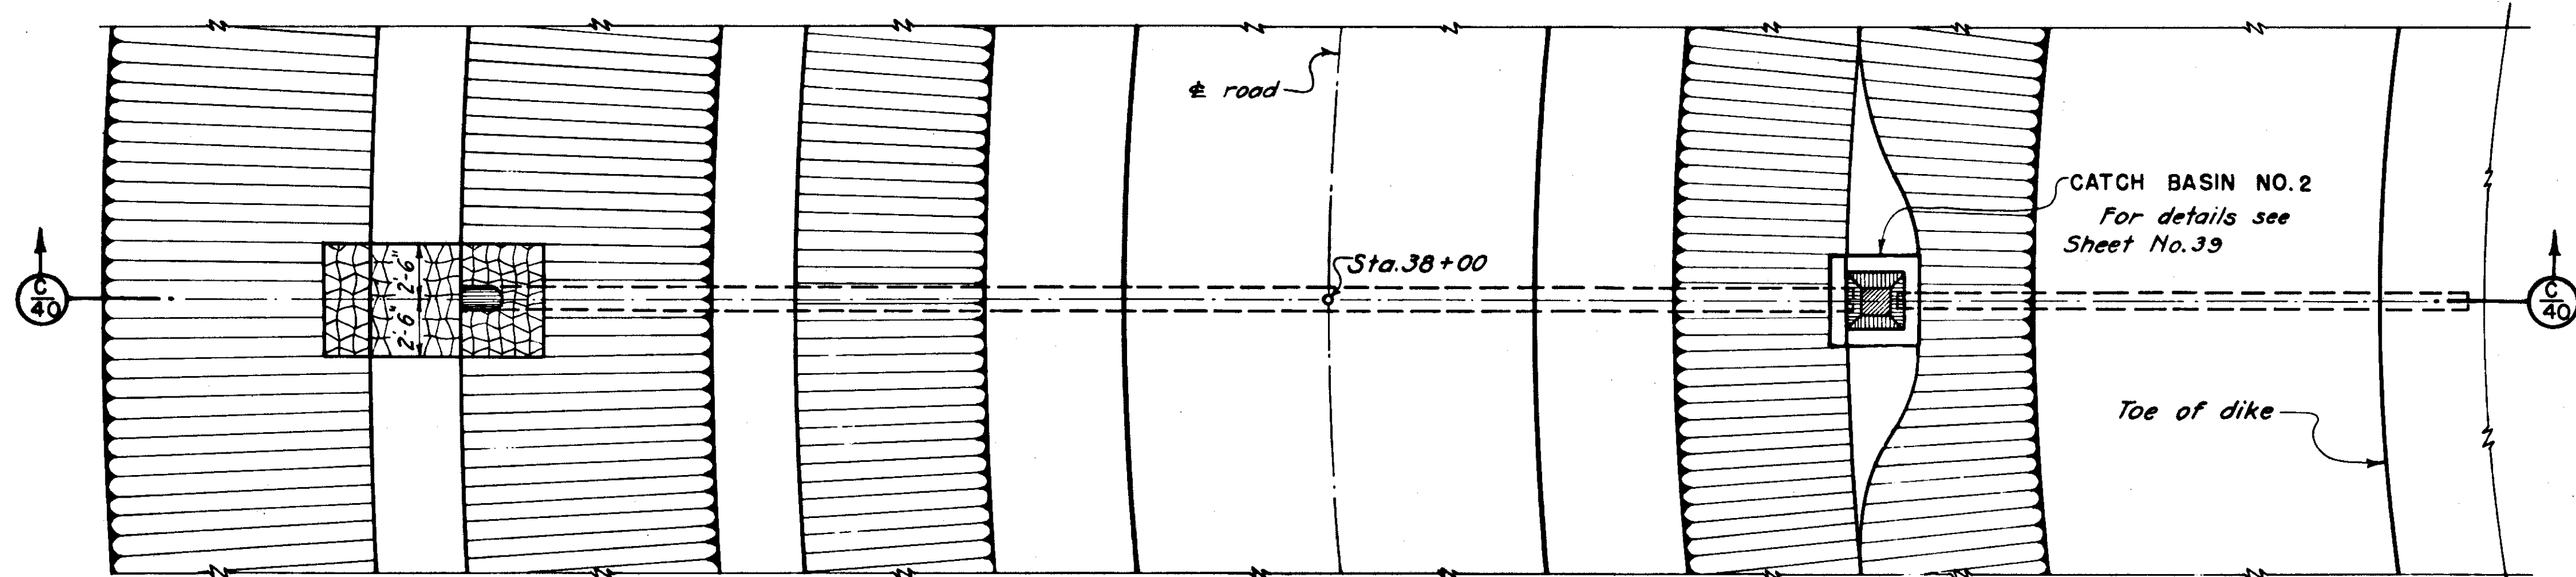
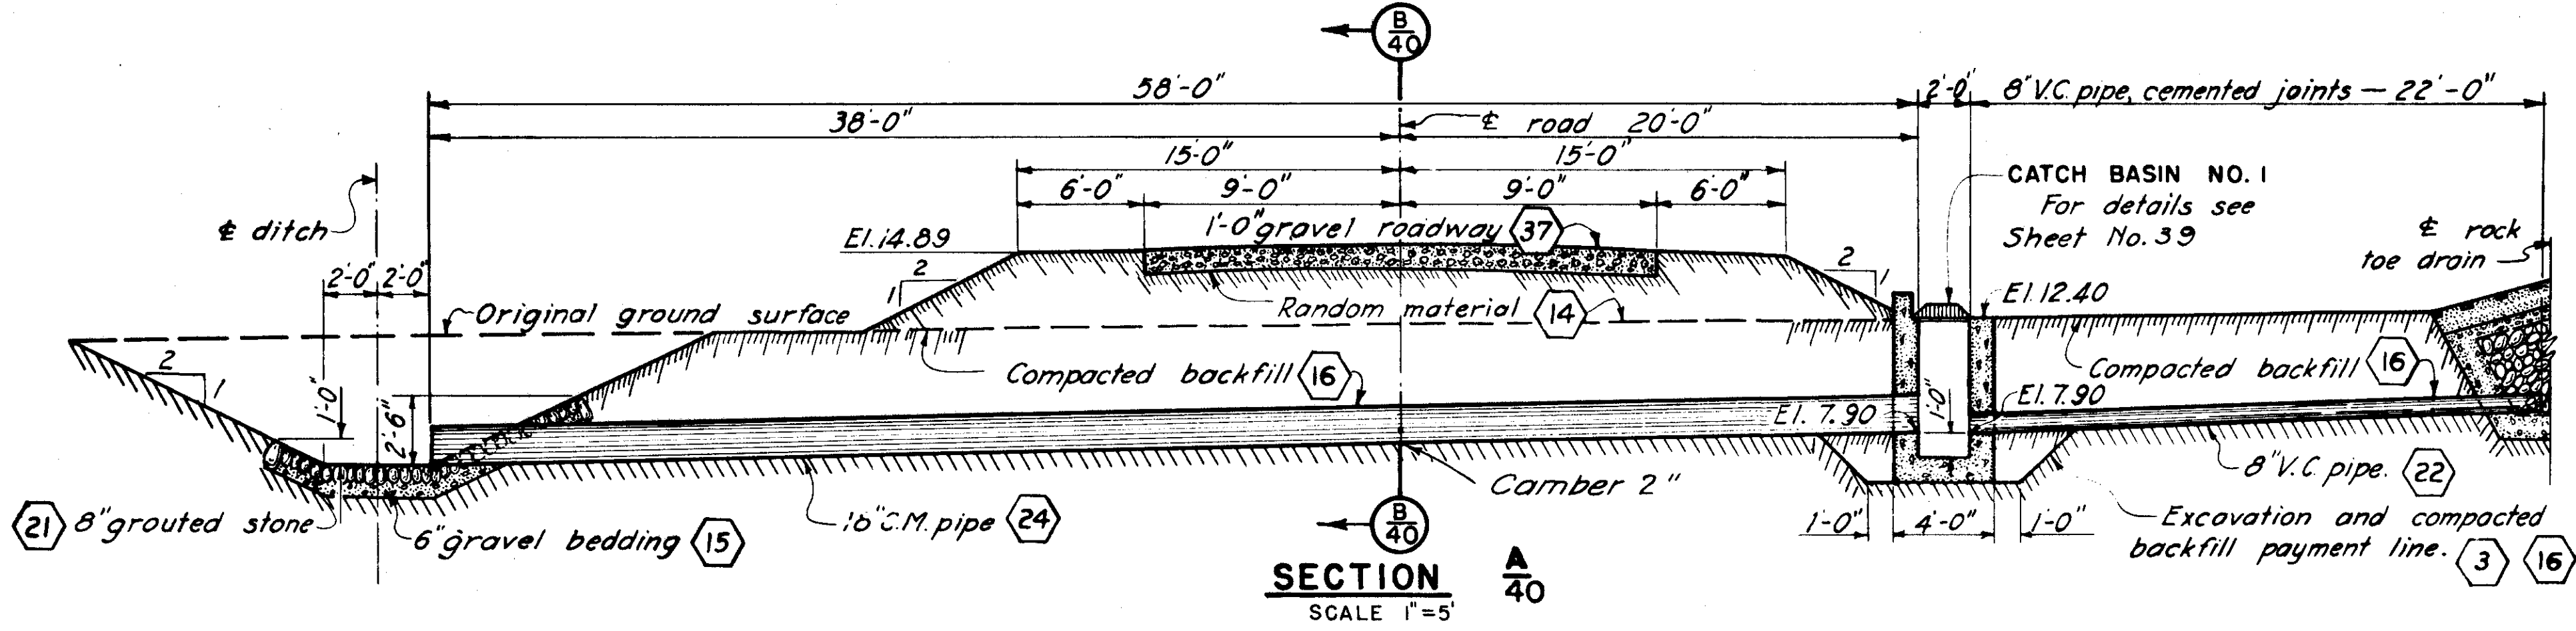


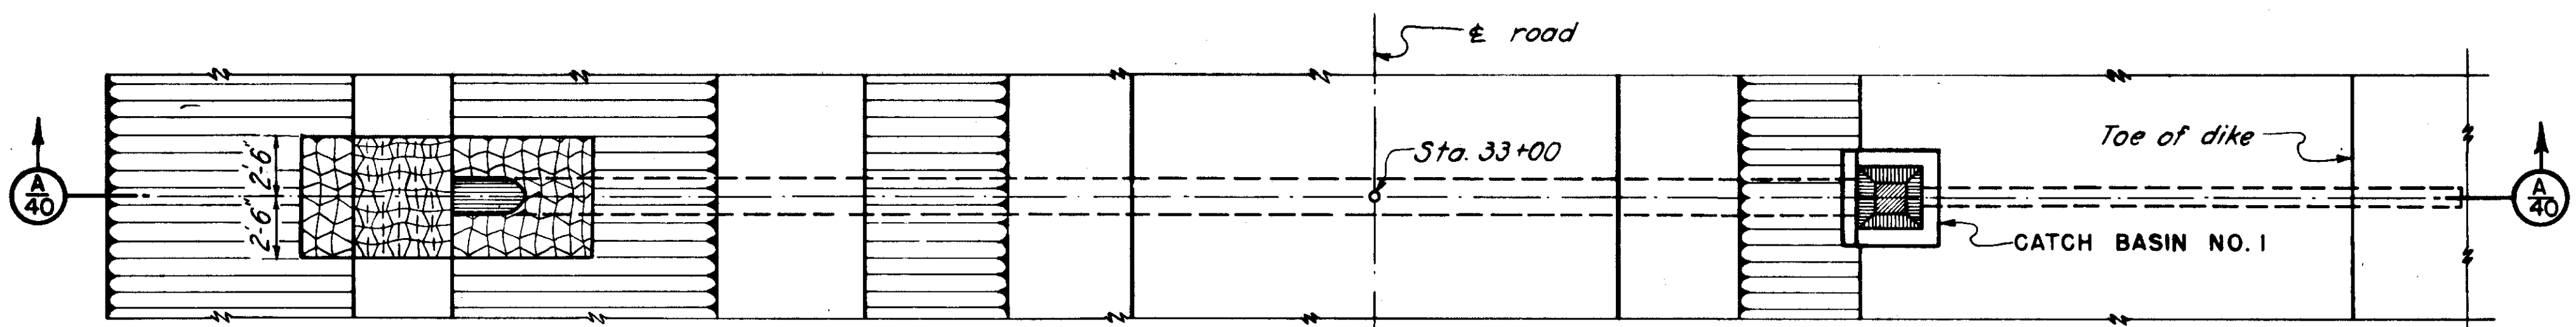

NOTES
For general notes applying to details shown on this sheet see Sheet No. 39.

CONNECTICUT RIVER FLOOD CONTROL			
NORTH MEADOWS DIKE			
FISCAL YEAR 1939 SECTION			
DRAINAGE STRUCTURES DETAILS NO. 2			
HARTFORD, CONN.			
CONNECTICUT RIVER		CONNECTICUT	
IN 66 SHEETS		SHEET NO. 40	
U. S. ENGINEER OFFICE, PROVIDENCE, R. I.			
APRIL 1939			
SUBMITTED: <i>Handwritten signature</i>		APPROVAL RECOMMENDED: <i>Handwritten signature</i>	
DESIGNED: <i>Handwritten signature</i>		FILE NO. CT-4-1469	
DATE: 12/31/45		REVISION: As-Built	
REV. BY: CK. BY: AP. BY:			