

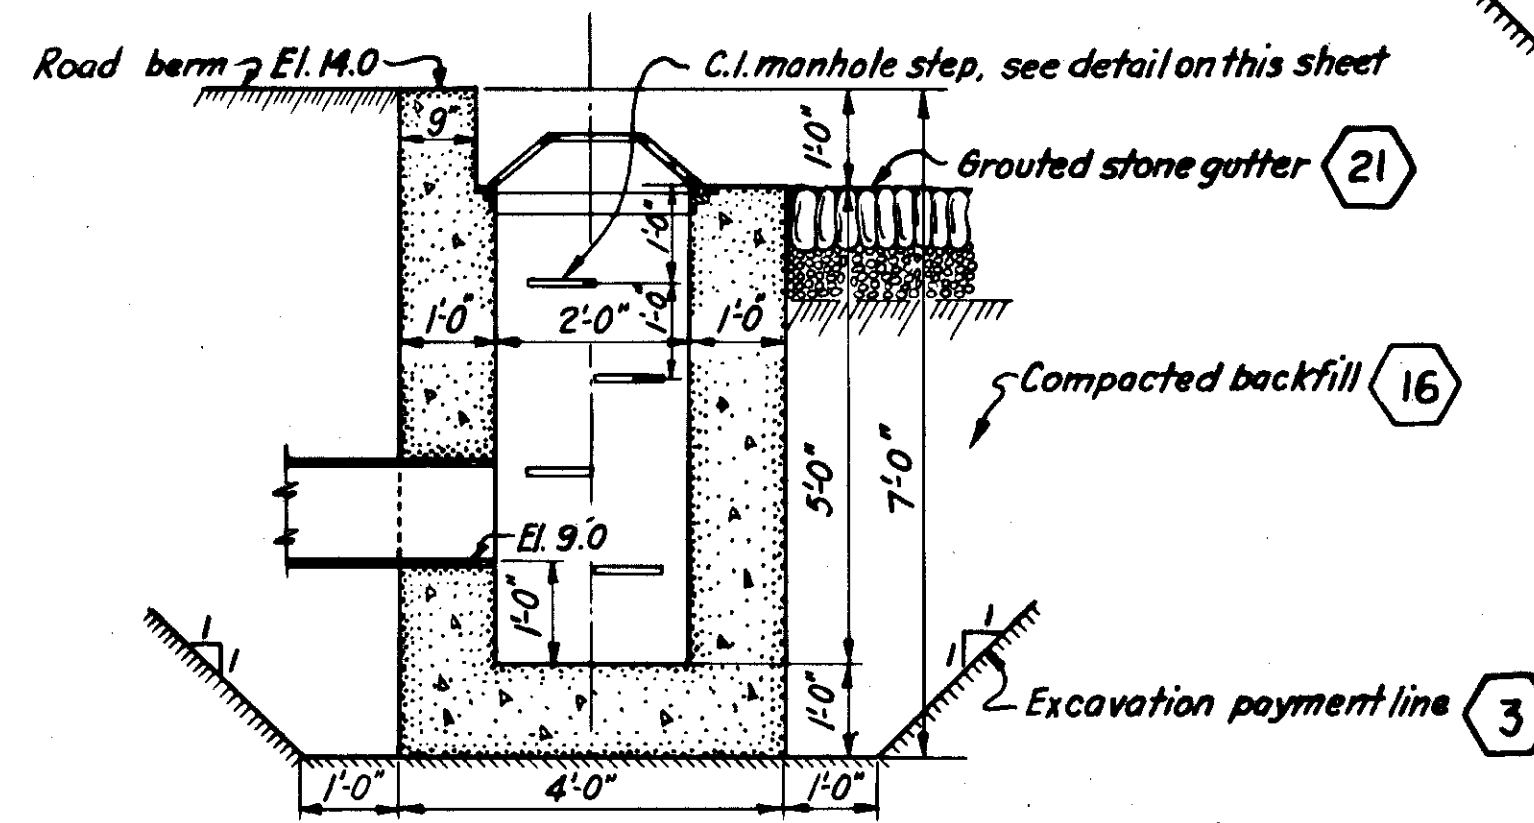
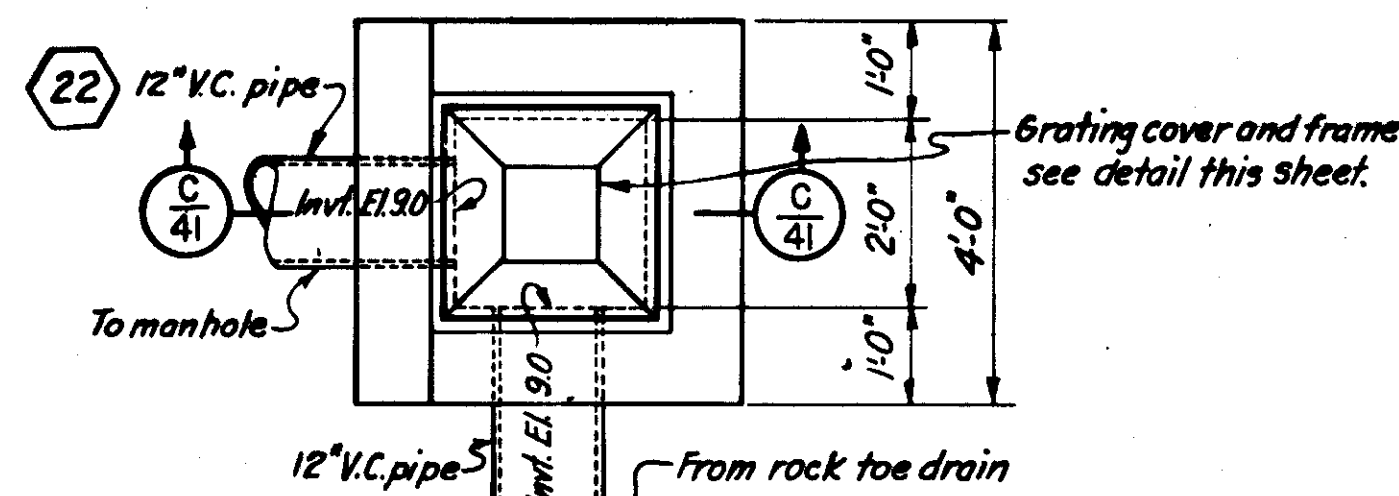
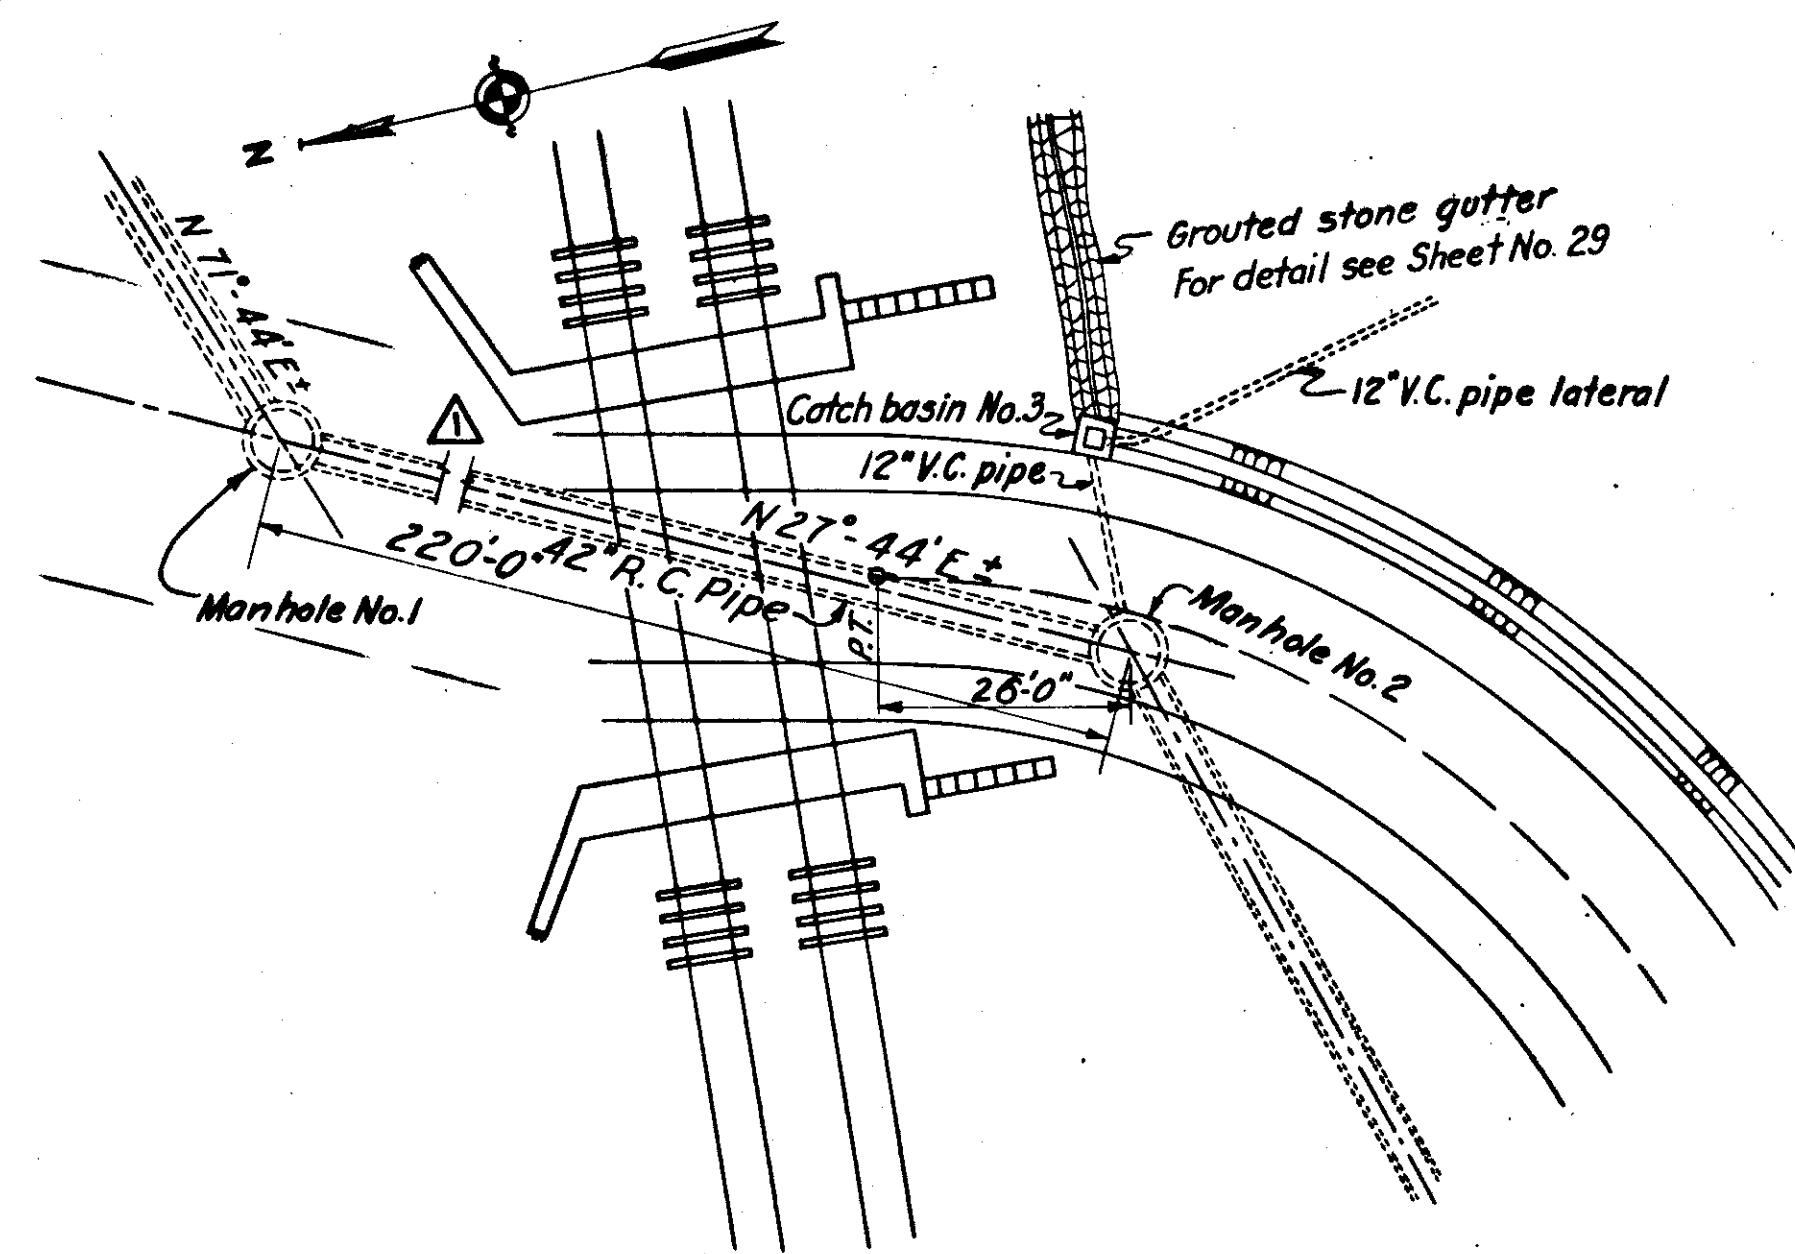


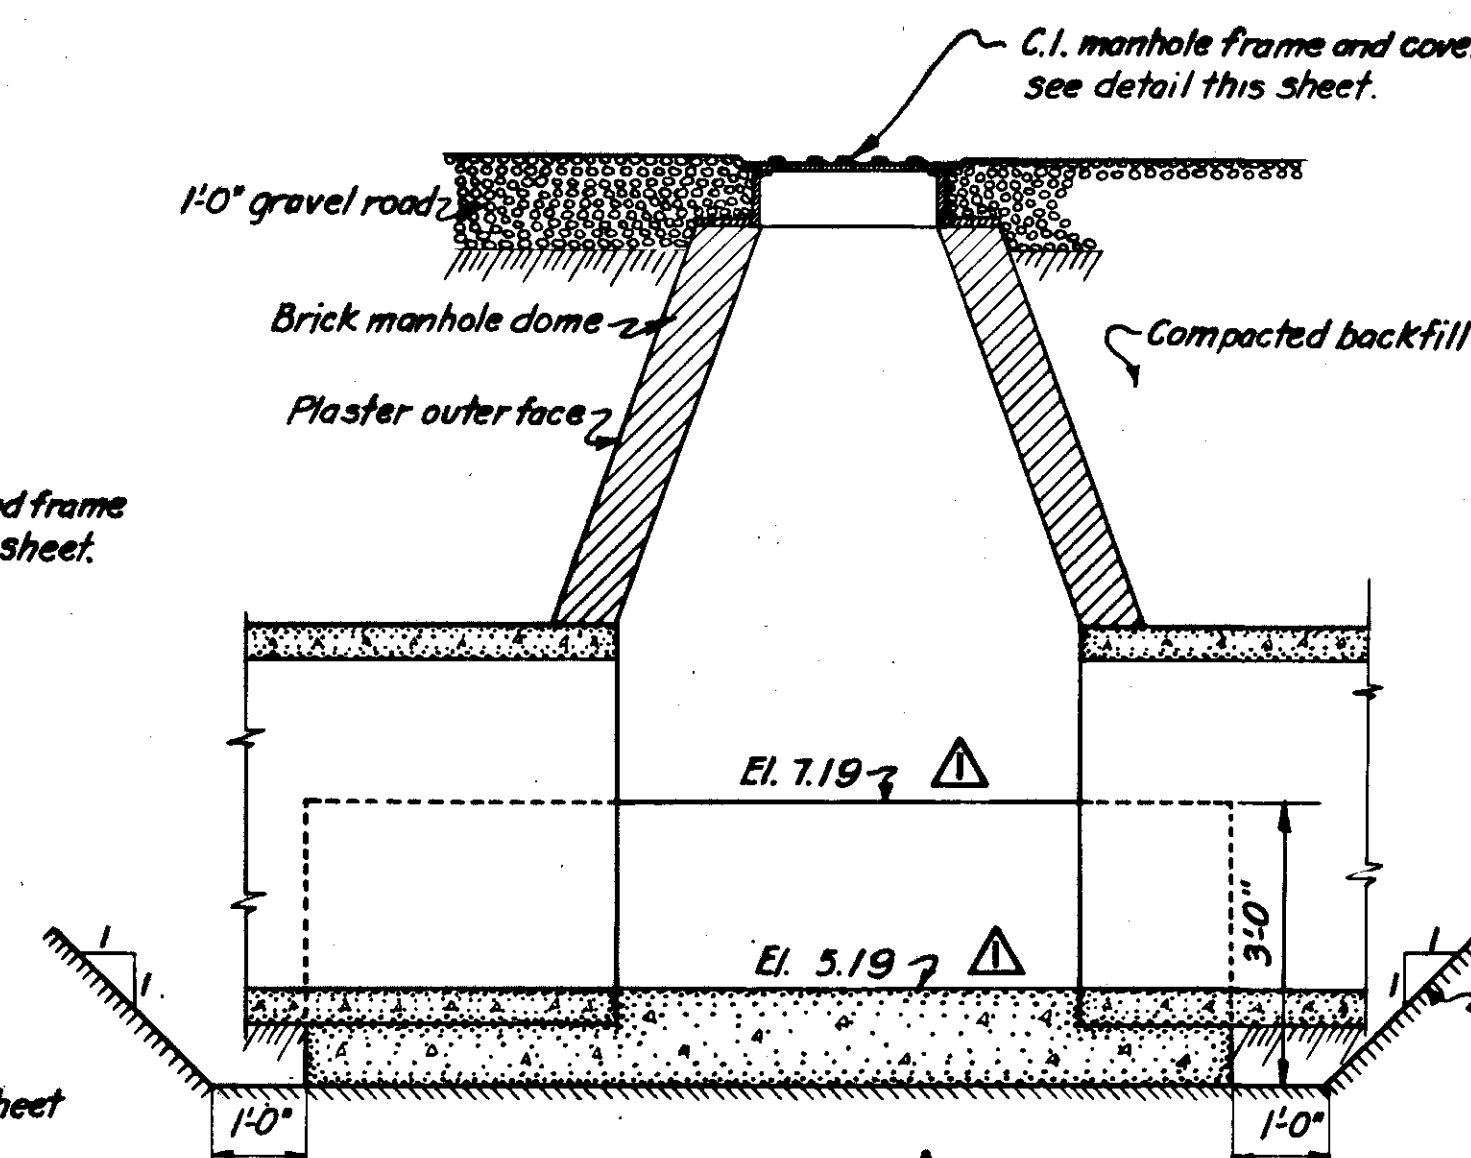


DETAILS OF CATCH BASIN NO. 3

SCALE: 1/2" = 1'-0"


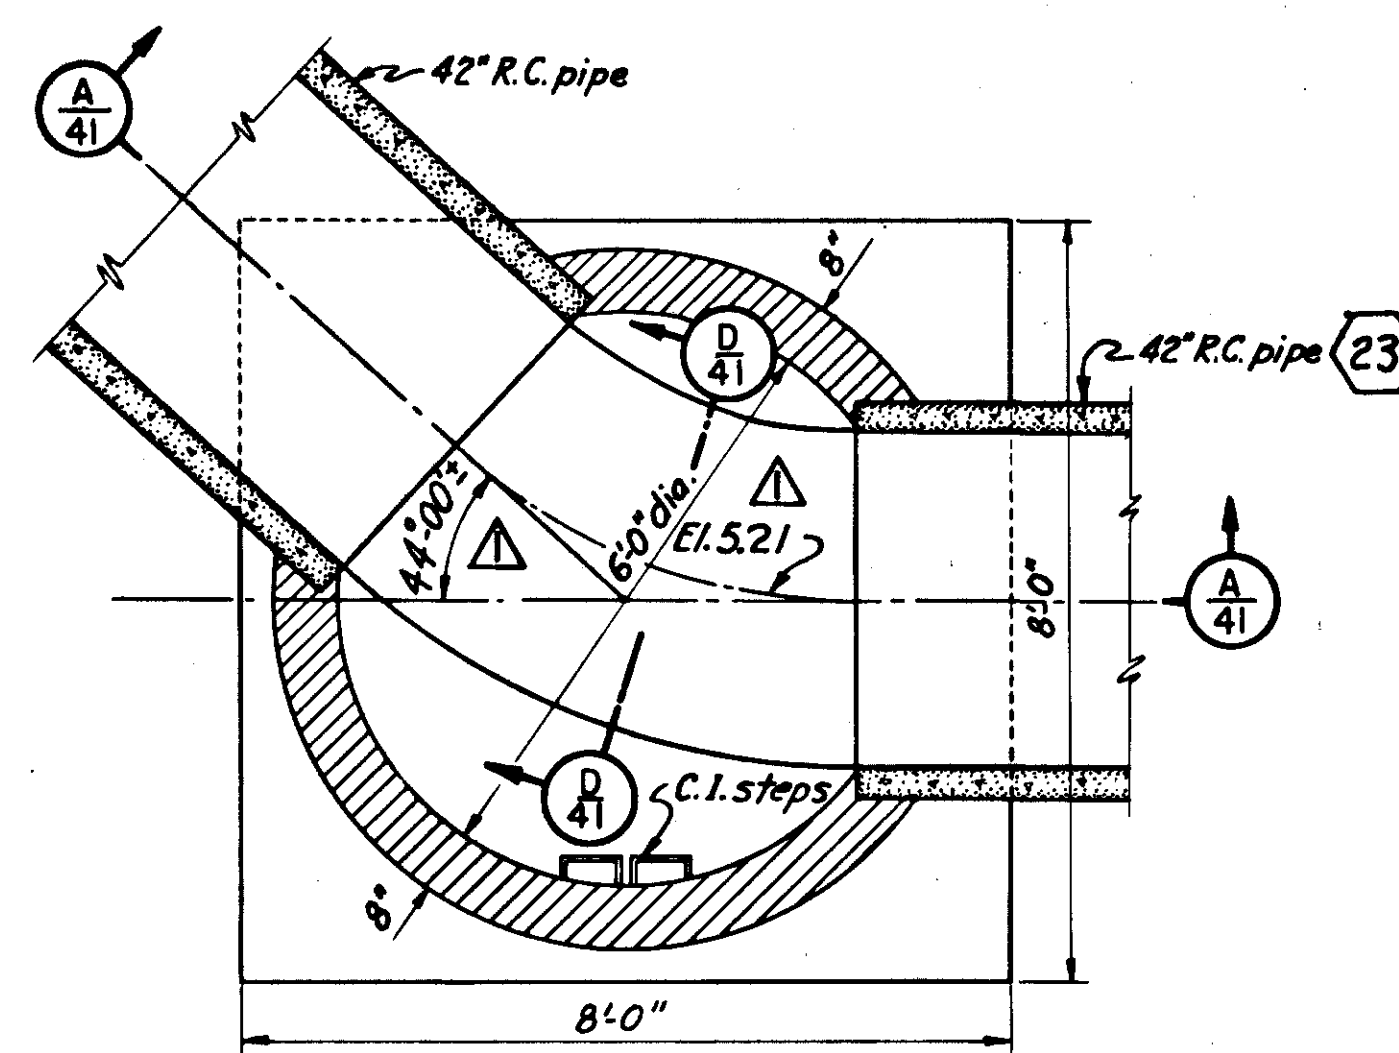


DETAILS OF MANHOLE NO. 1

SCALE: 1/2" = 1'-0"

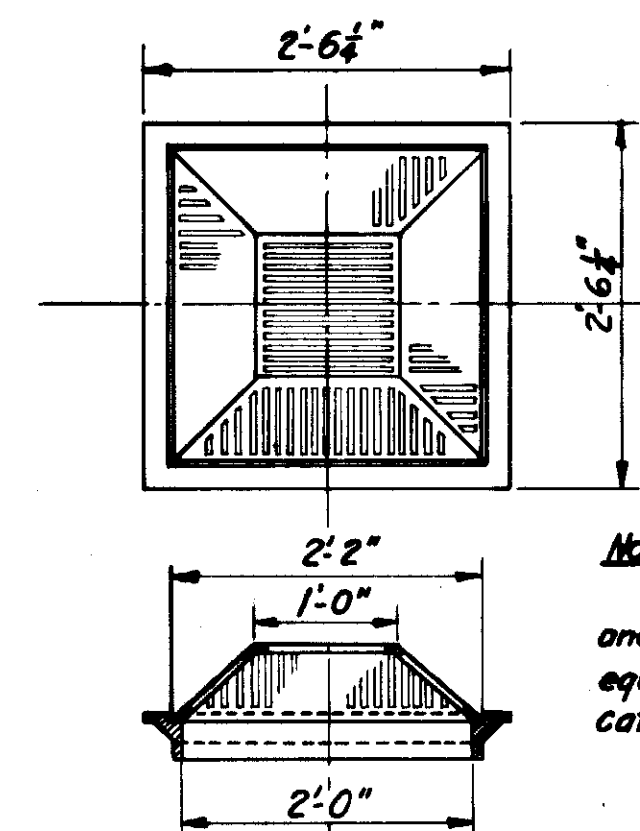


CATCH BASIN FRAME AND COVER (30)

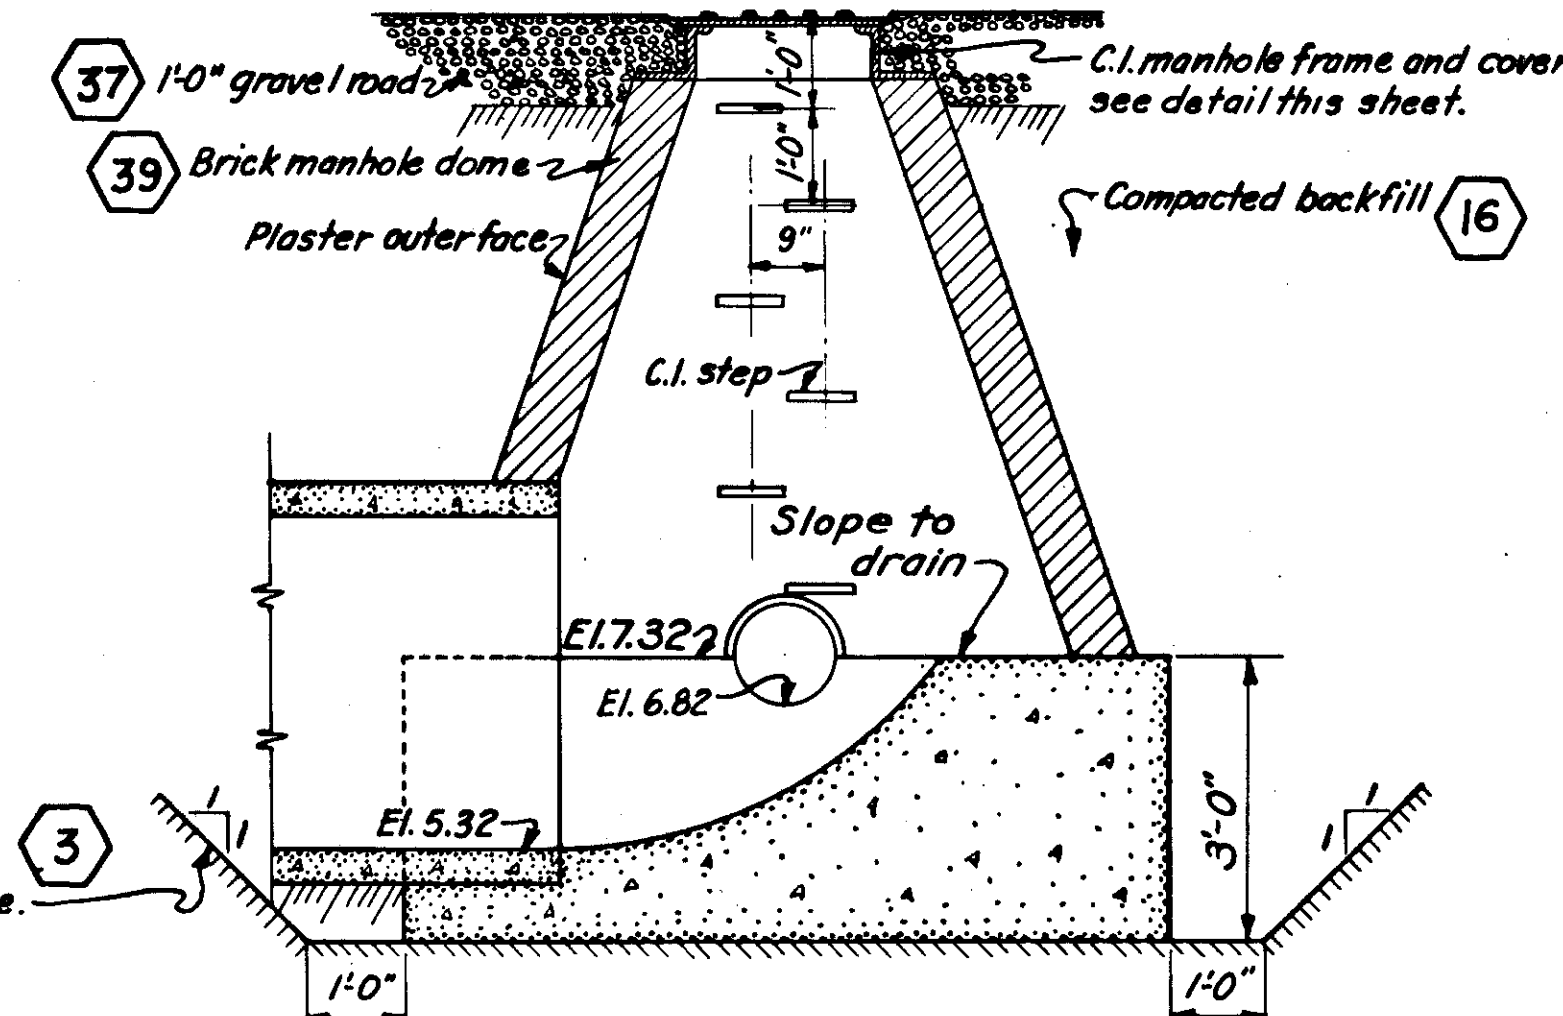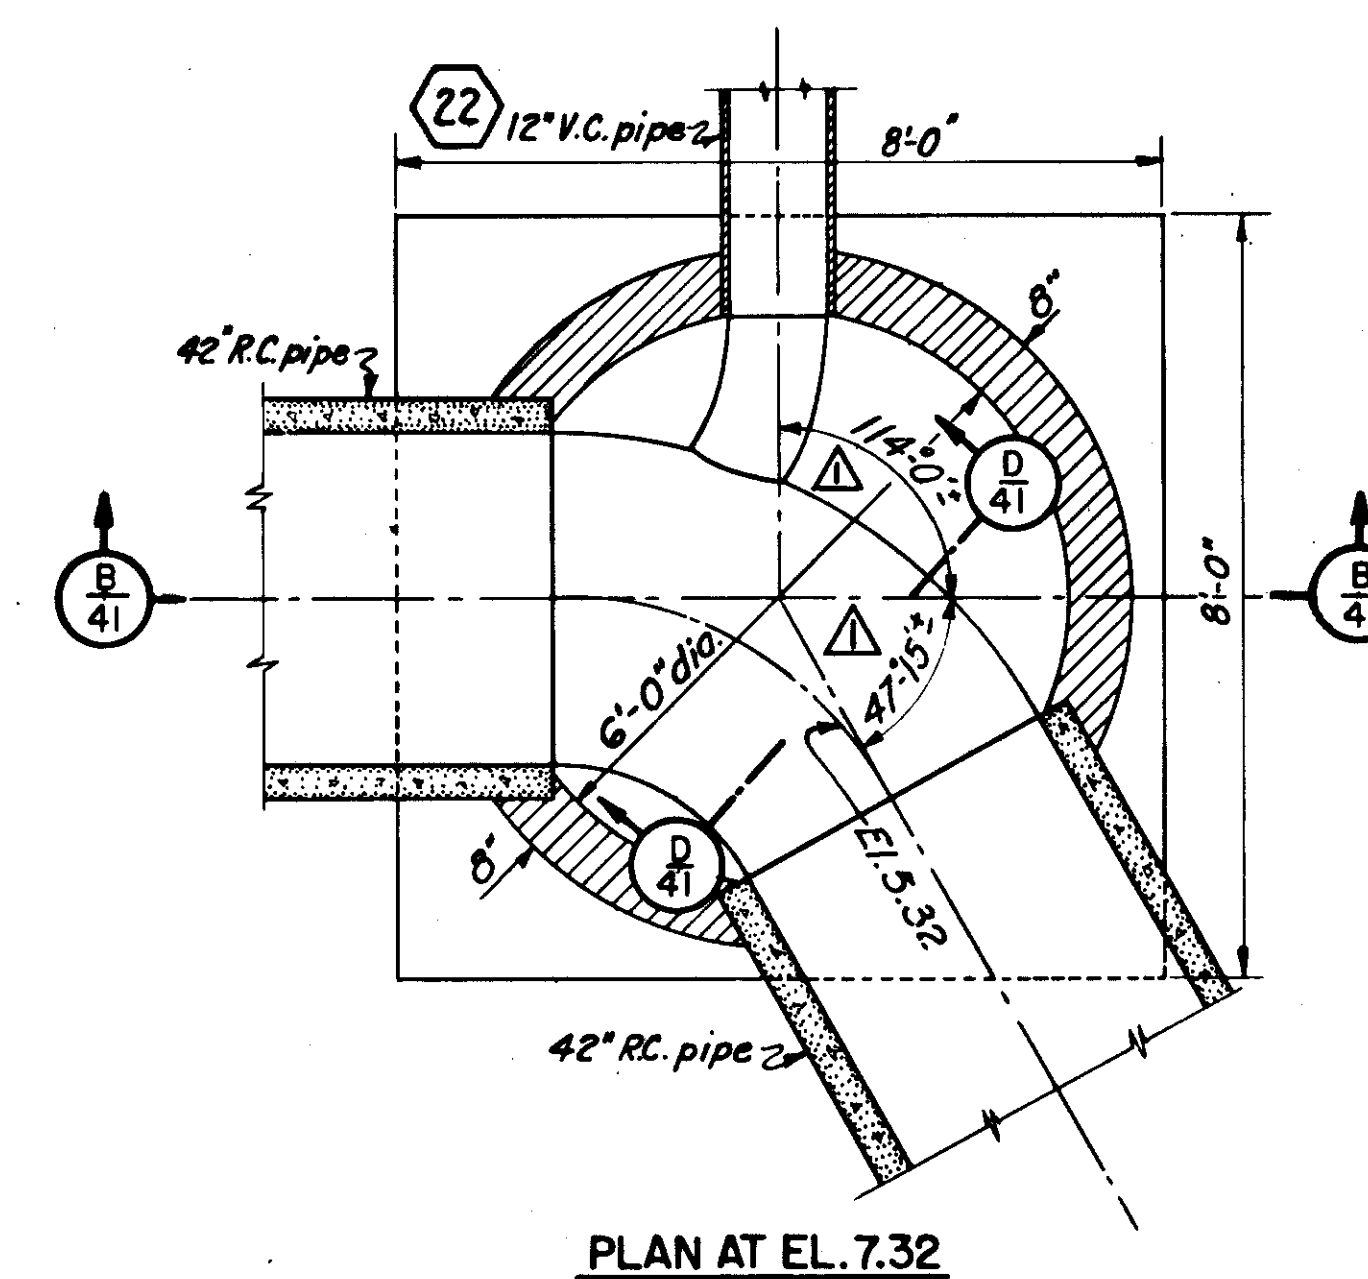
4 REQUIRED - TOTAL WEIGHT = 900 LBS.
SCALE: 3/4" = 1'-0"

DETAILS OF MANHOLE NO. 2


SCALE: 1/2" = 1'-0"

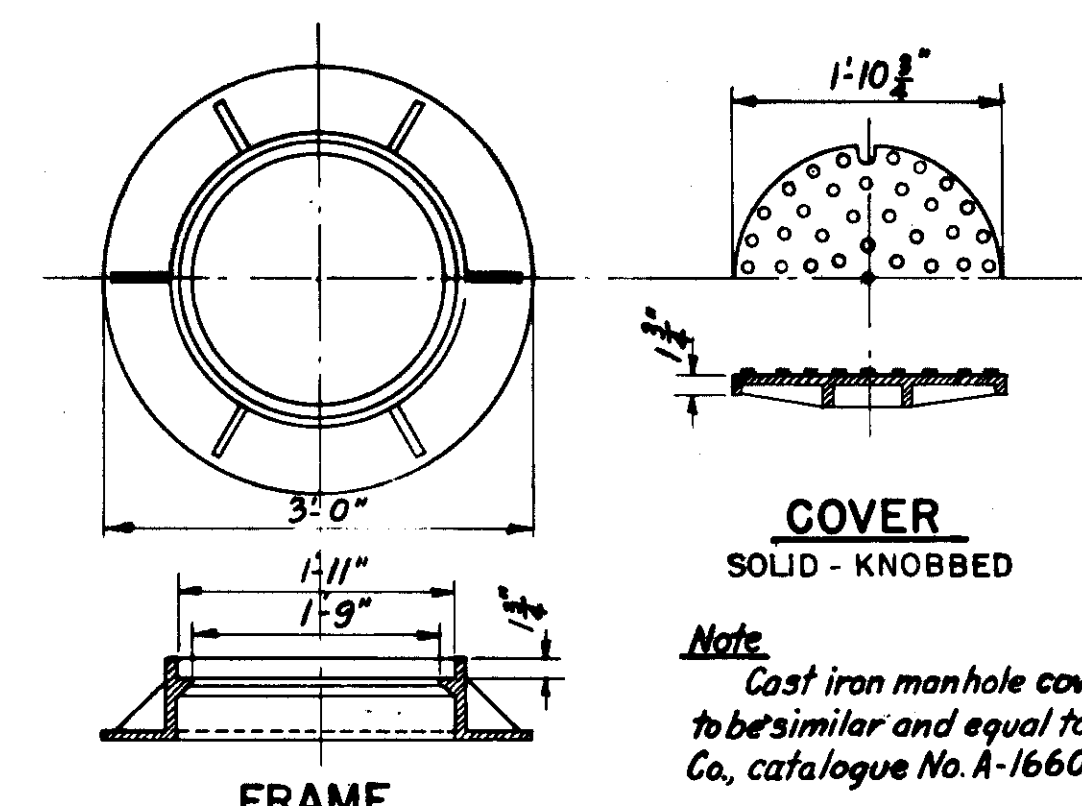

MANHOLE FRAME AND COVER (30)

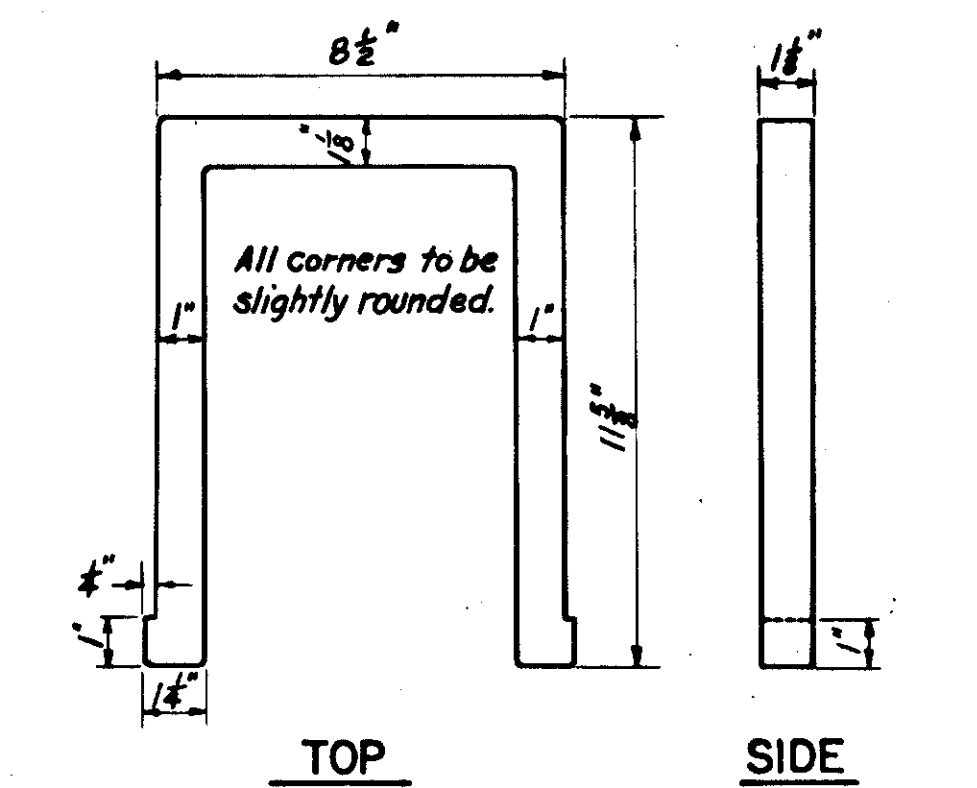2 REQUIRED - TOTAL WEIGHT = 800 LBS.
SCALE: 3/4" = 1'-0"

CAST IRON MANHOLE STEP (30)

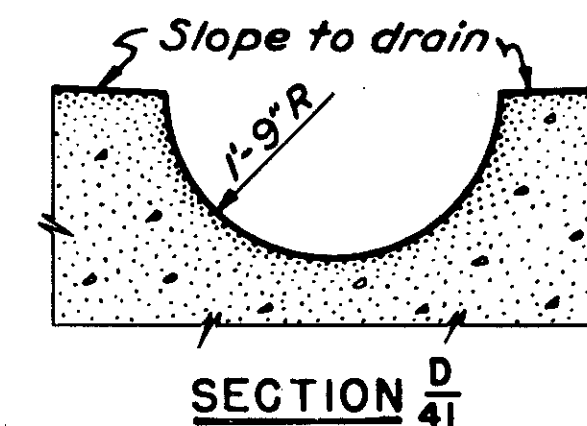27 STEPS REQUIRED - TOTAL WEIGHT = 237 LBS.
SCALE: 1/4" = 1'-0"**NOTES**

For general notes applying to details shown on this sheet see Sheet No. 39.

For details of steel reinforcement see Sheet No. 43.

12/31/45	As-Built Revisions			
7/27/39	Manholes and 42" drain revised	91	94	2813
KEY	DATE	REVISION (Indicated by Δ)	REV. BY	OK. BY
CONNECTICUT RIVER FLOOD CONTROL				
NORTH MEADOWS DIKE				
FISCAL YEAR 1939 SECTION				
DRAINAGE STRUCTURES DETAILS NO. 3				
HARTFORD, CONN.				
CONNECTICUT RIVER				
IN 66 SHEETS				
SCALE: 1/2" = 1'-0"				
SHEET NO. 41				
U. S. ENGINEER OFFICE, PROVIDENCE, R. I., APRIL 1939				
SUBMITTED	APPROVAL	RECOMMENDED	APPROVED	
SENIOR ENGINEER	CHIEF F. C. ENGINEERING DIV.	CHIEF F. C. ENGINEERING DIV.	CHIEF F. C. ENGINEERING DIV.	
HEAD, DESIGN SECTION				
DESIGNED	DRAWN	CHECKED	FILE NO.	
J. Hartley	E. J. S.	W. A. T.	CT-4-1470	
ASOC. ENGINEER	CHECKED	W. A. T.		