



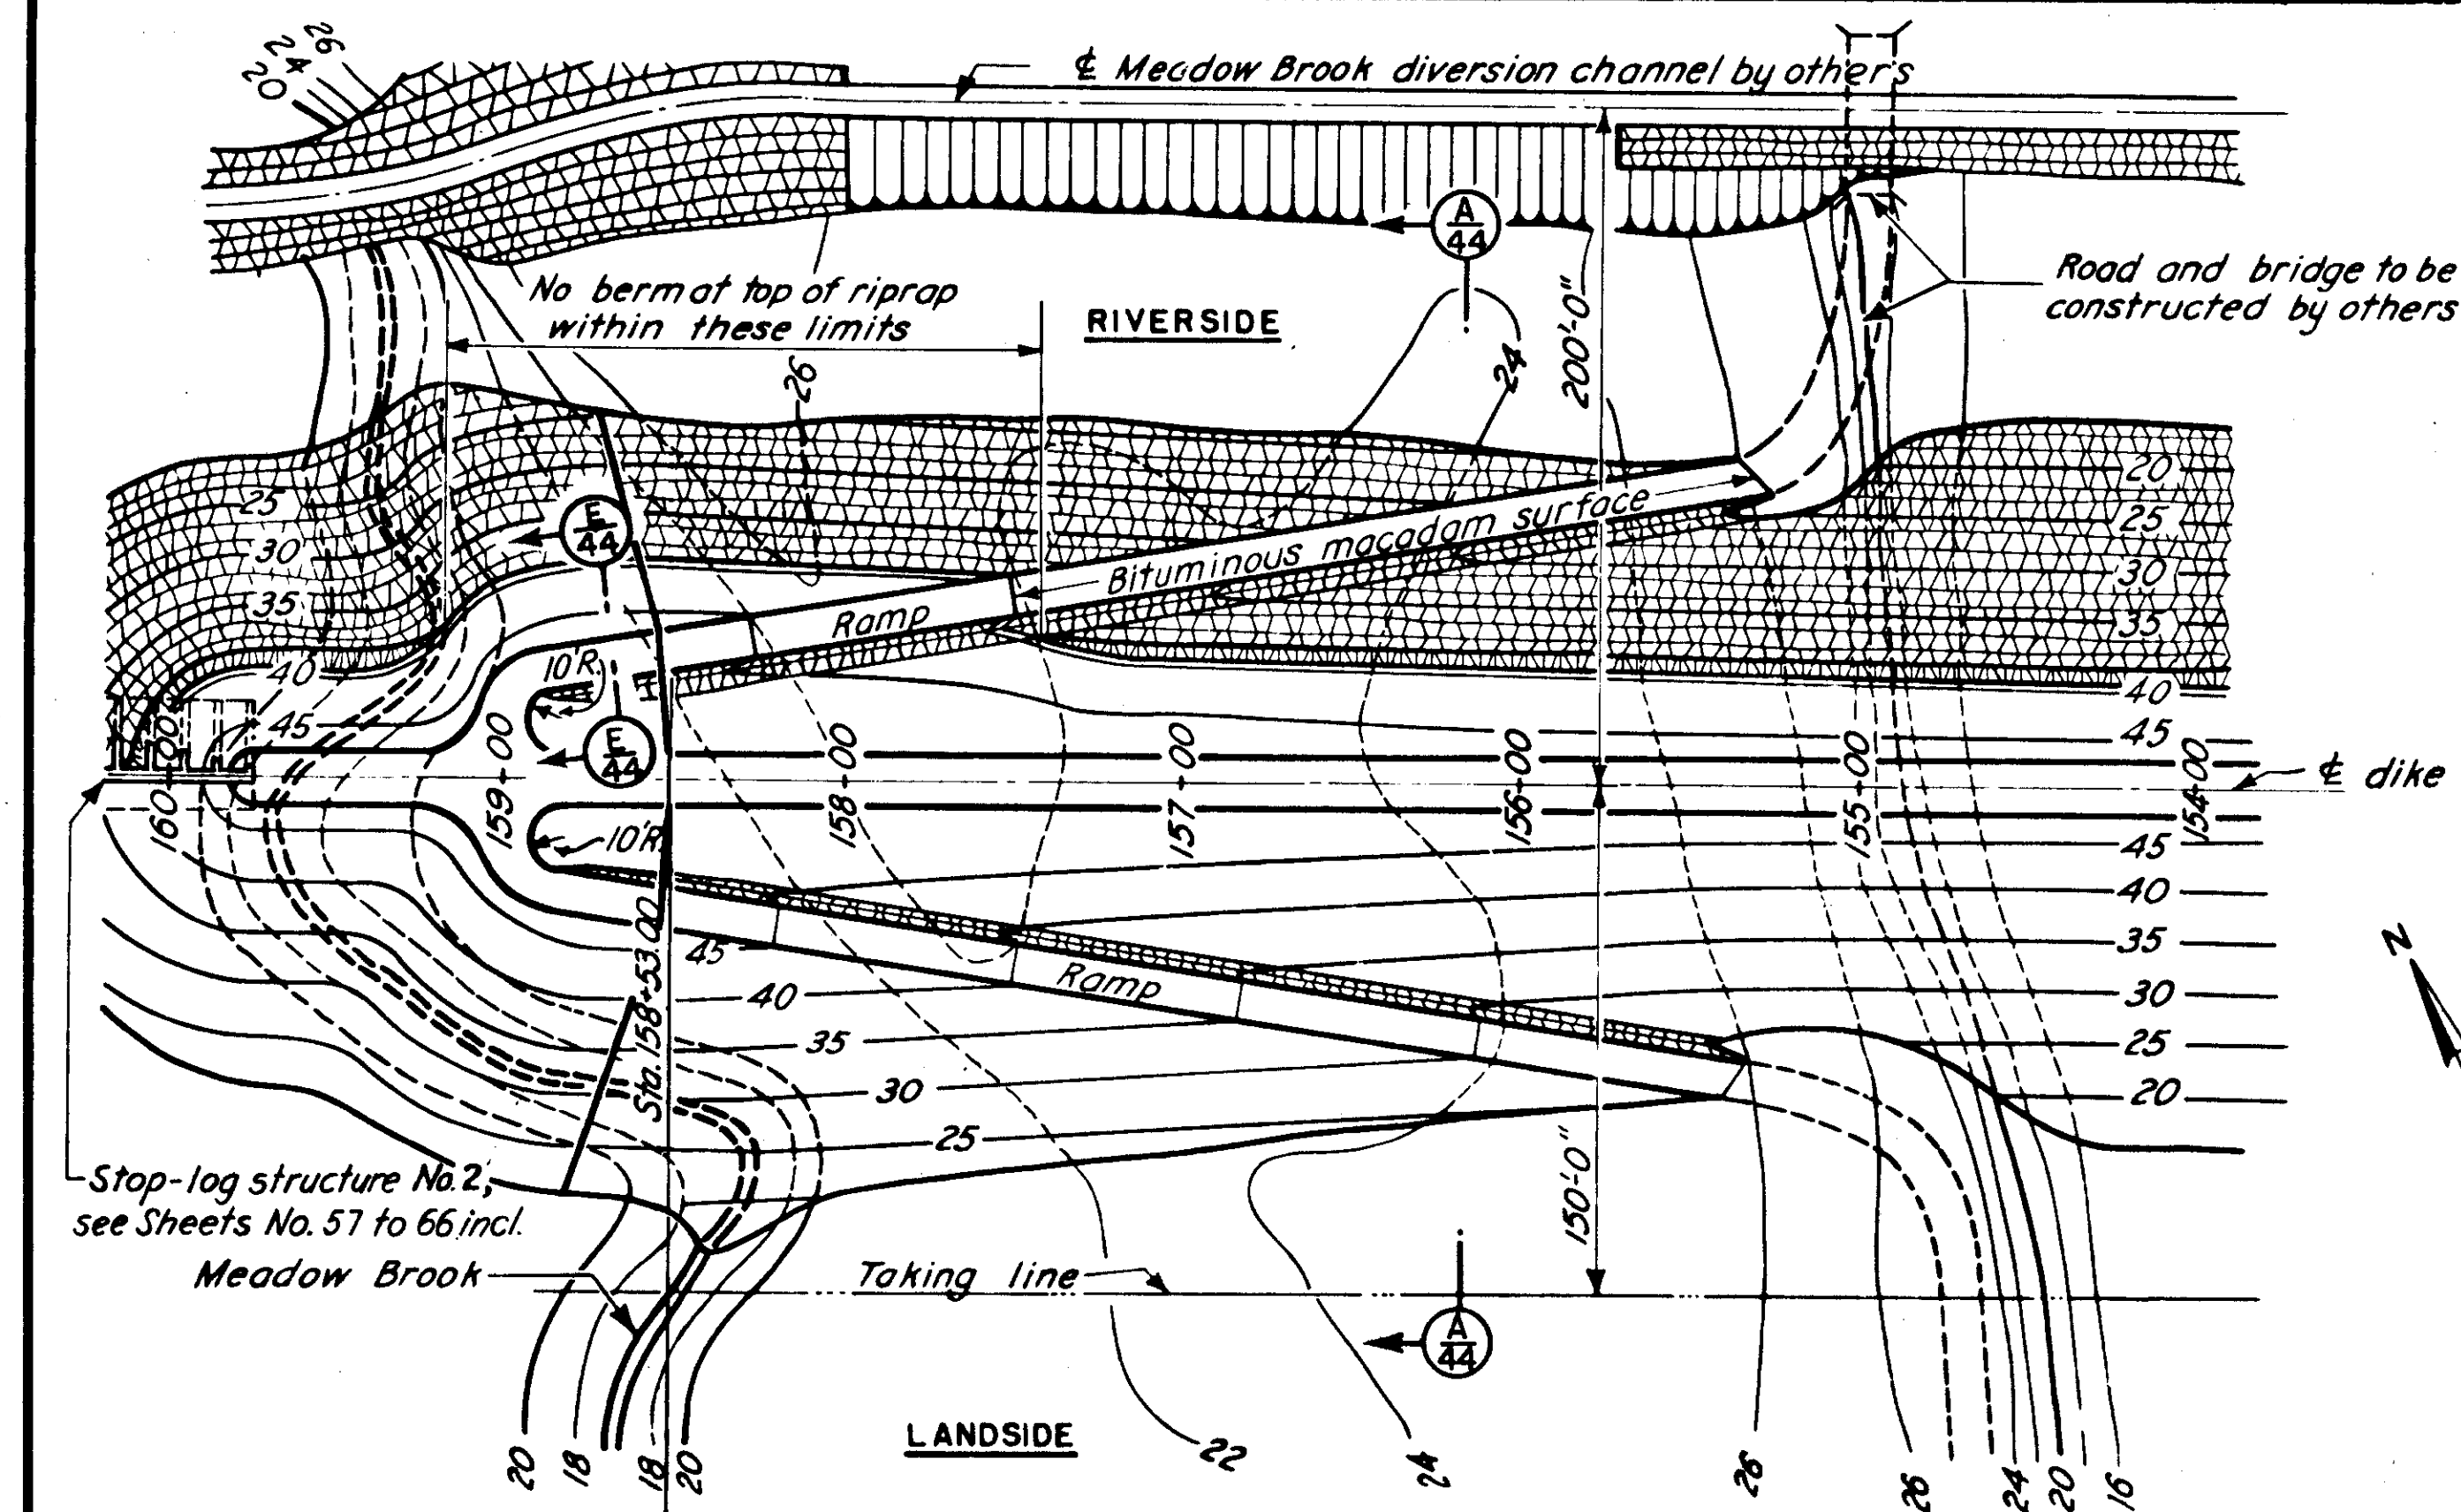


PLAN

SCALE: 1" = 50'

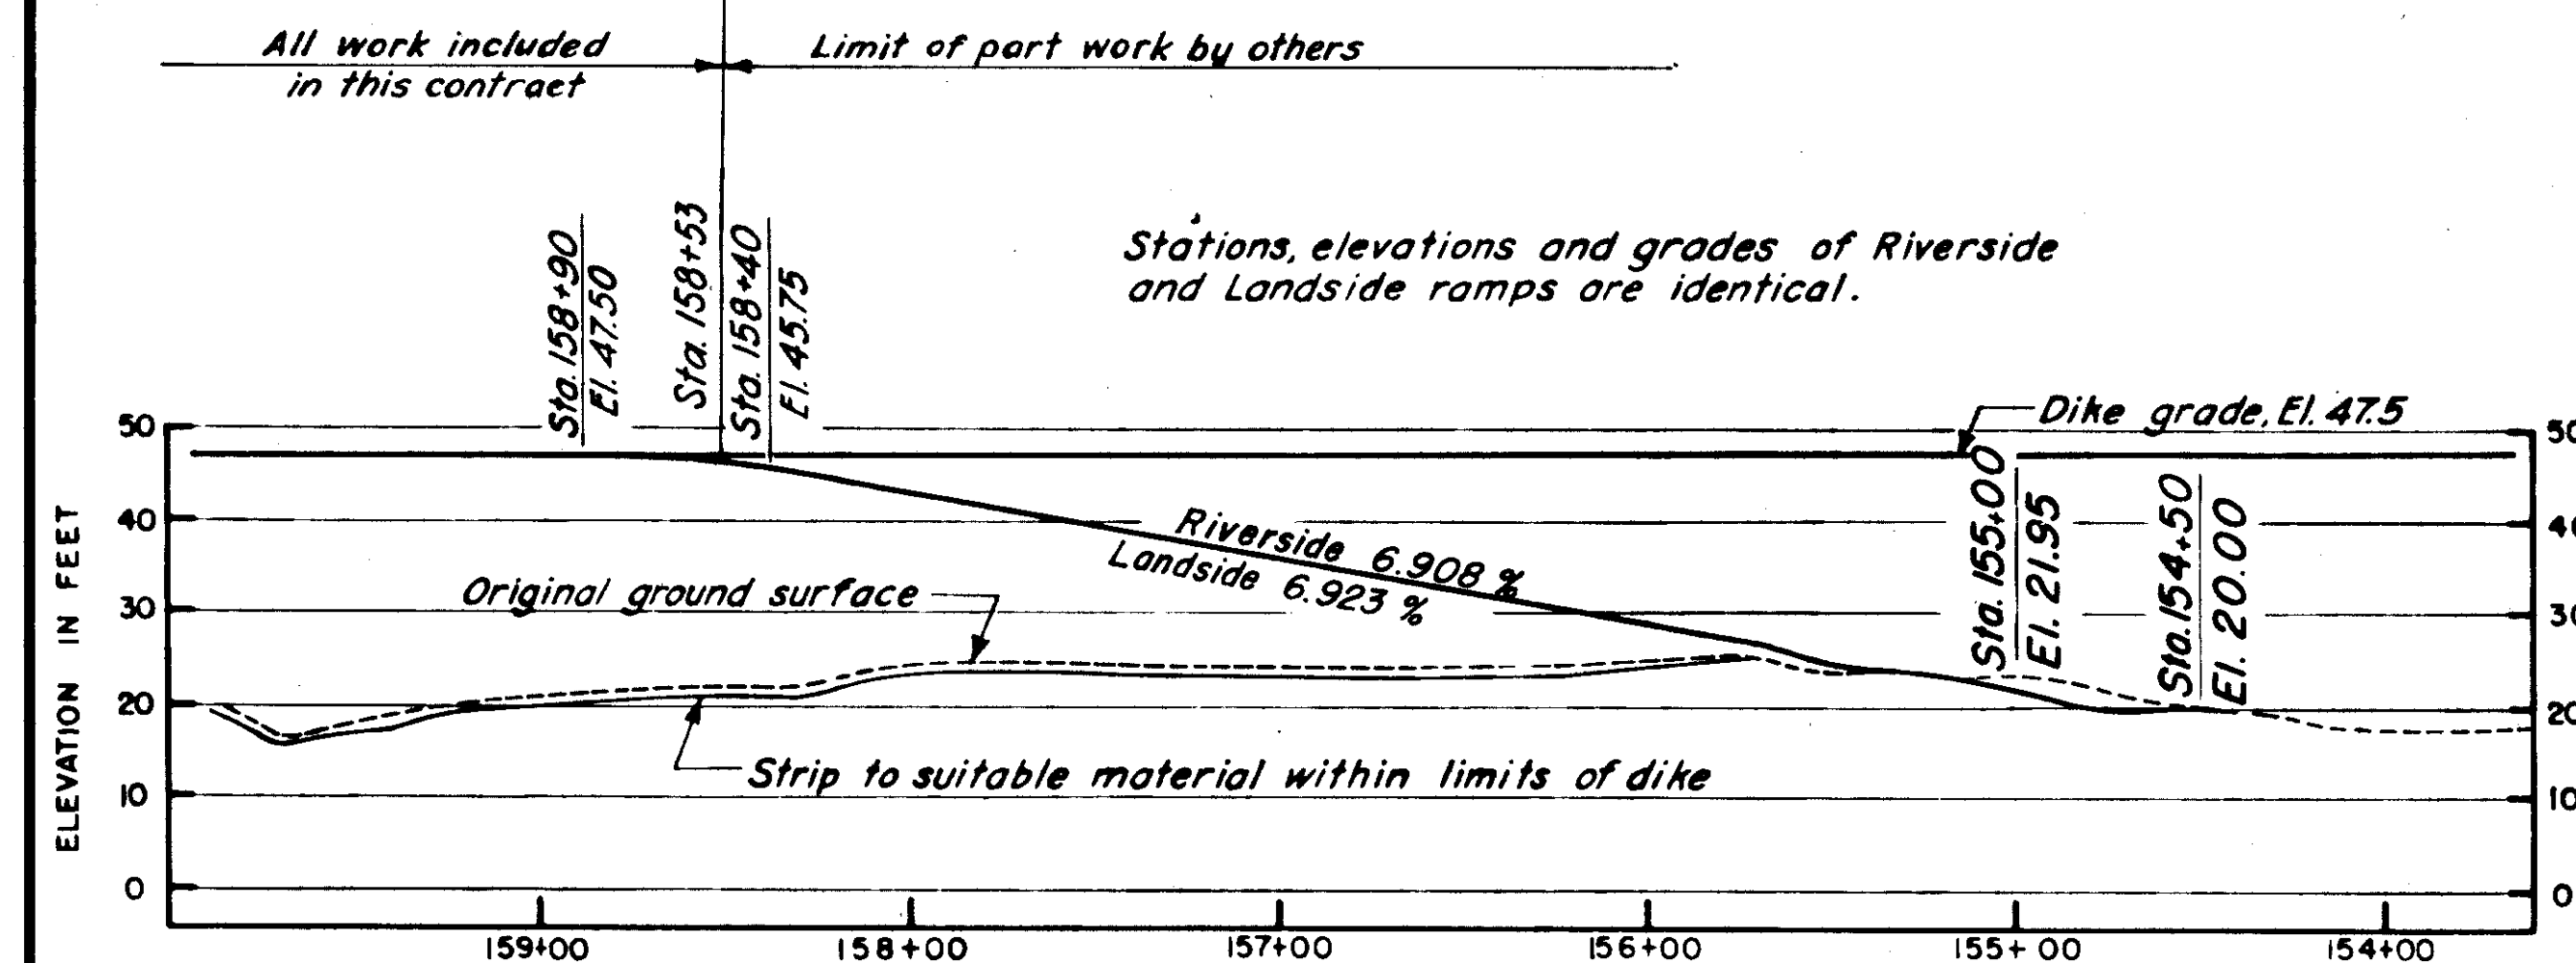


PROFILE ON RAMP

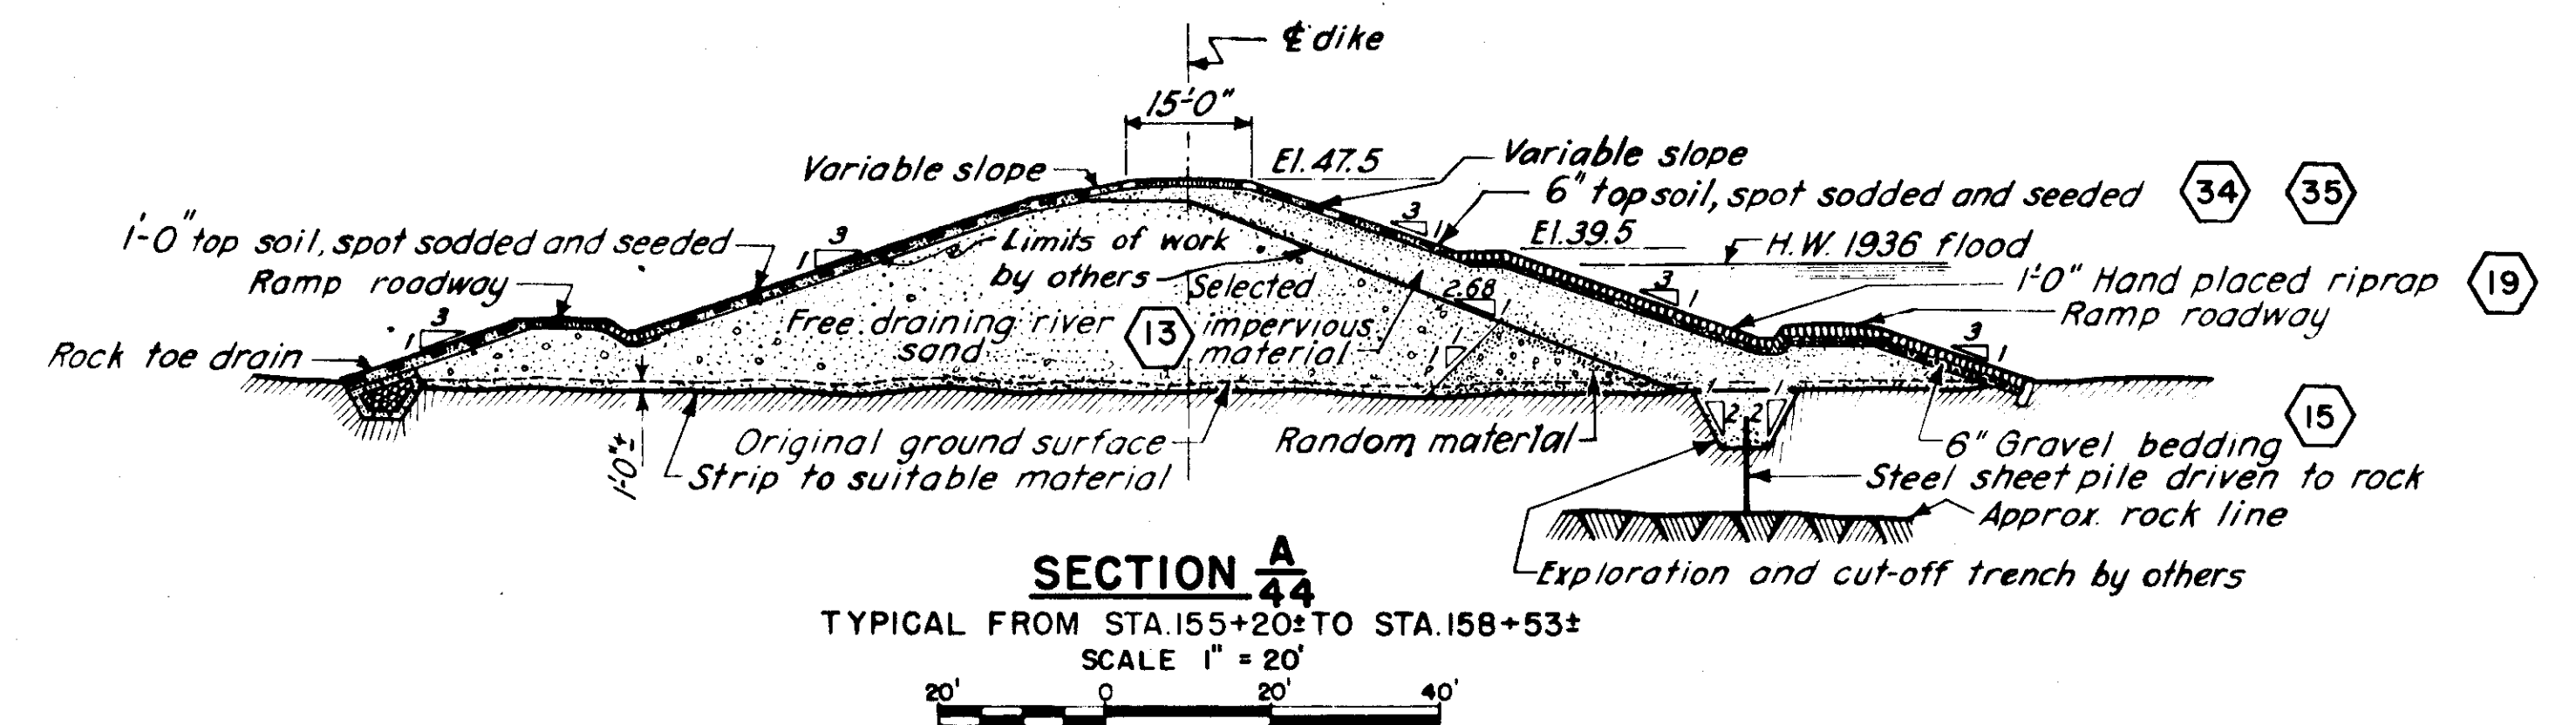HORIZONTAL SCALE: 1" = 50'
VERTICAL SCALE: 1" = 20'

SECTION A-A


TYPICAL FROM STA. 155+20 TO STA. 158+53

SCALE: 1" = 20'

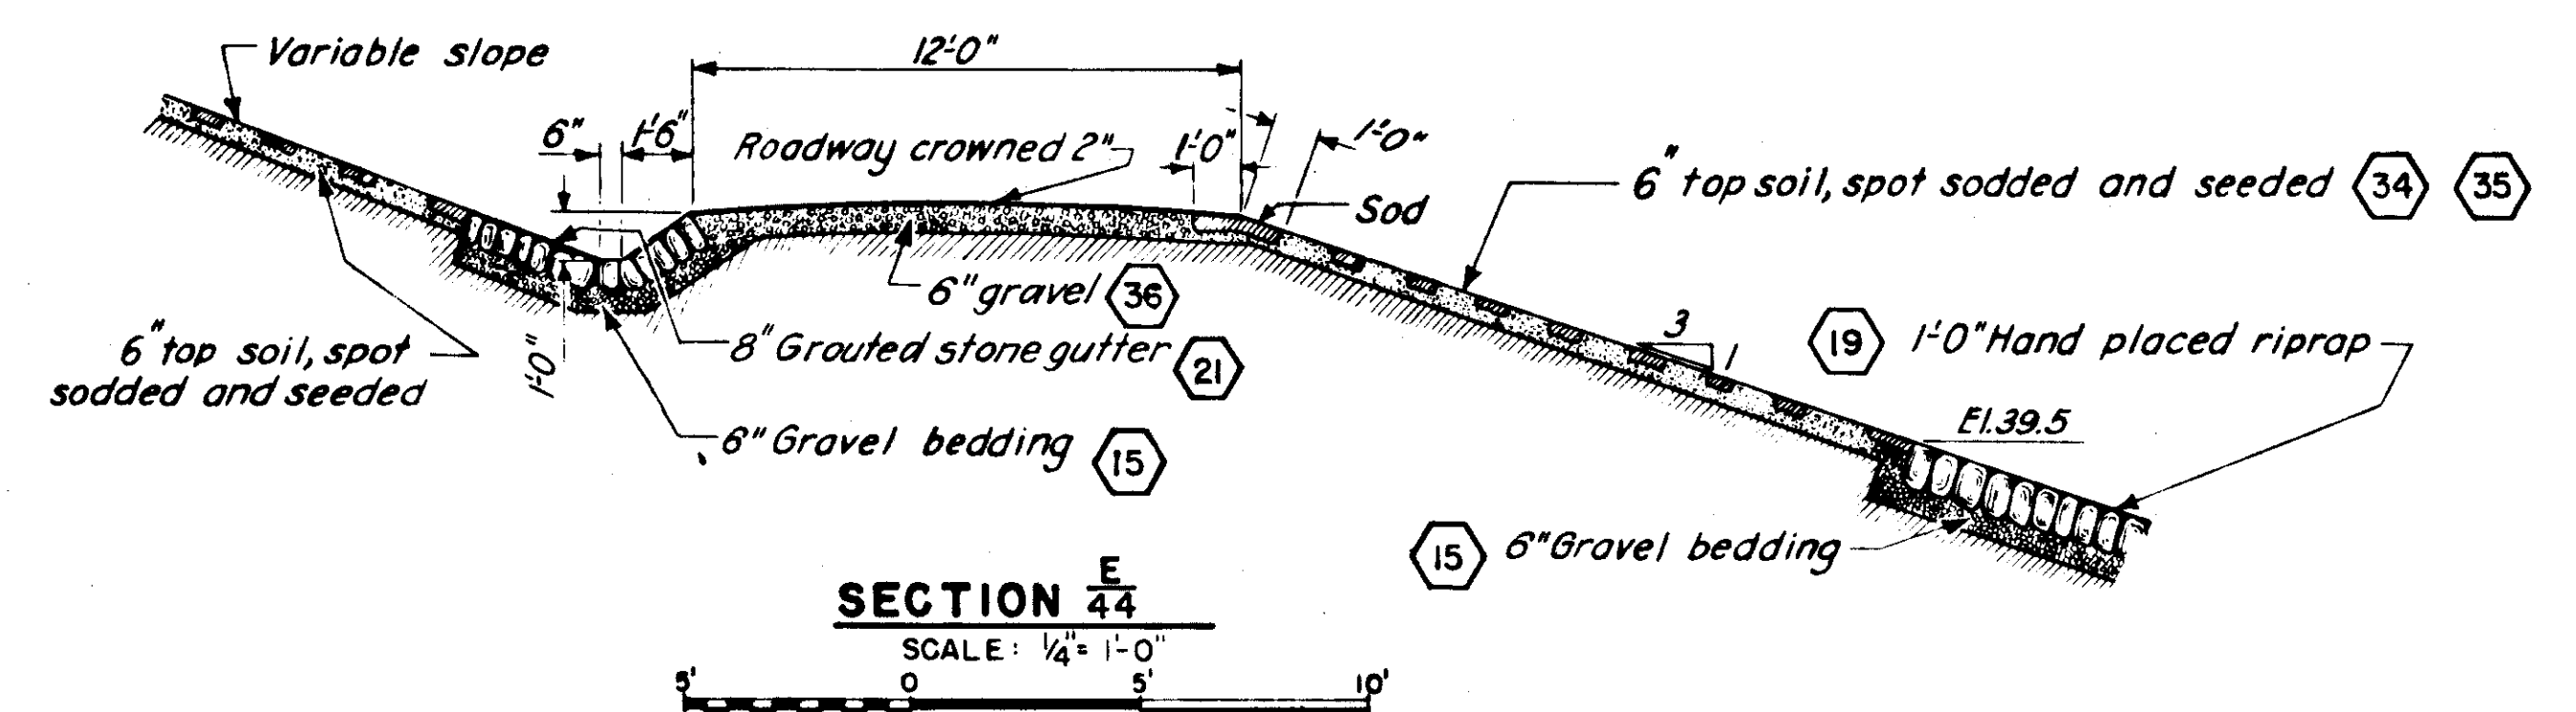

SECTION E-E

SCALE: 1/4" = 1'-0"

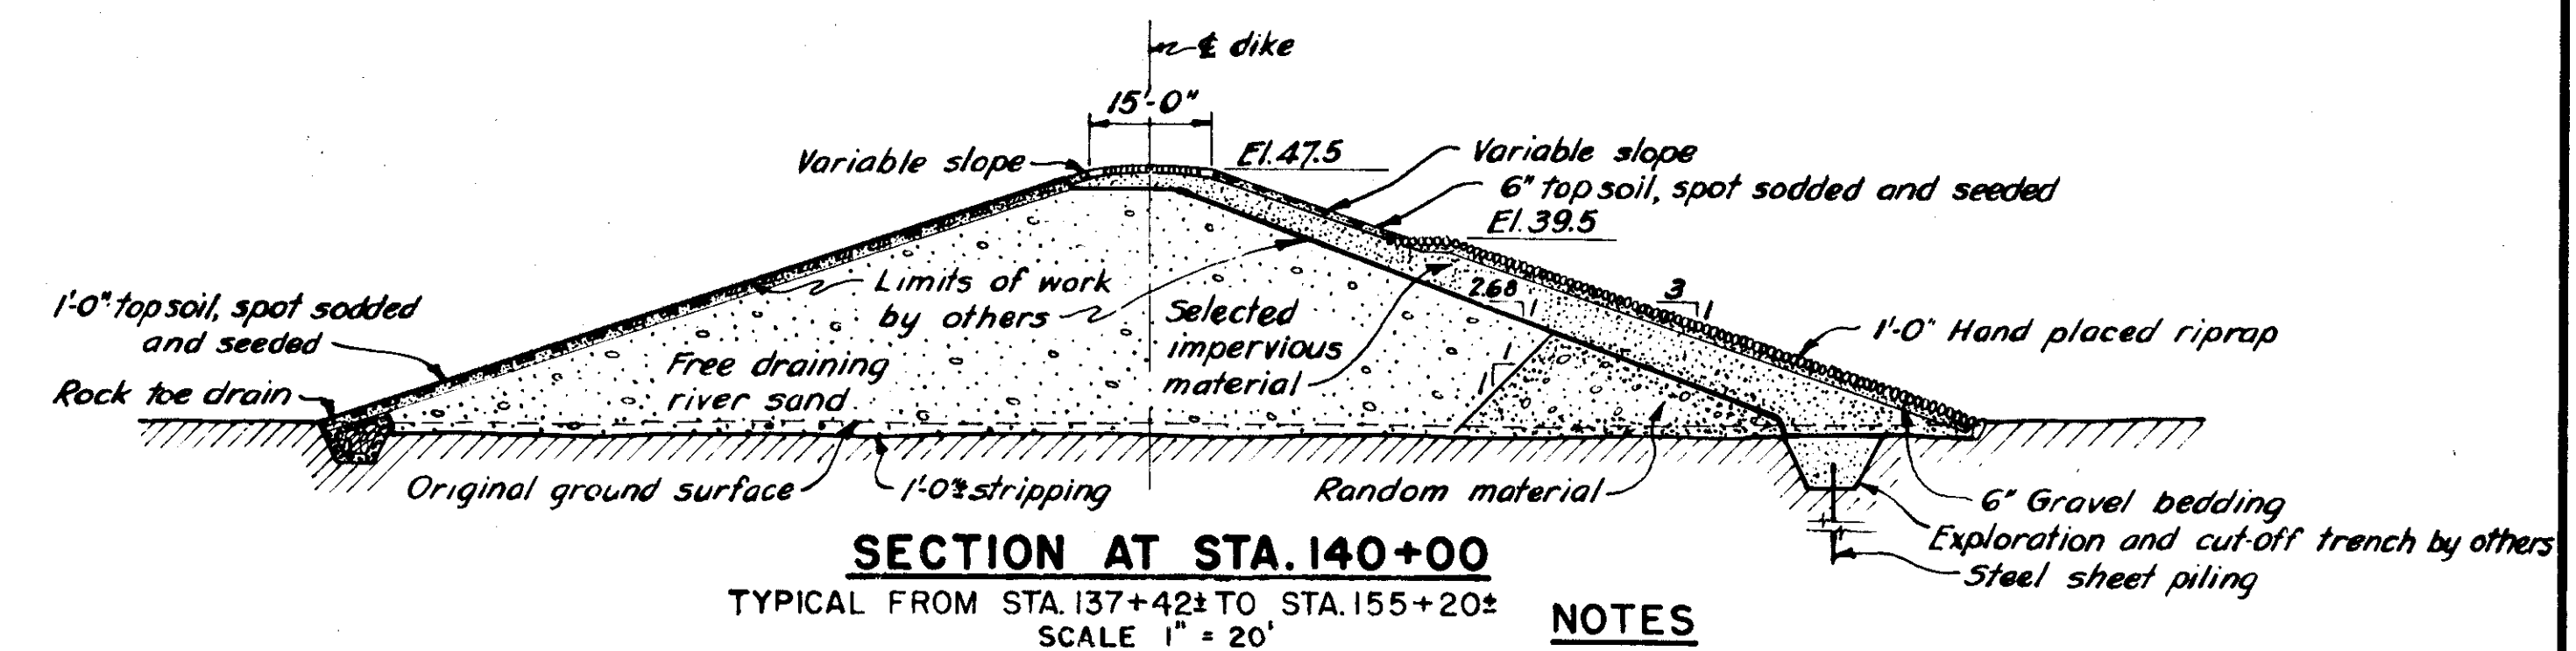

SECTION AT STA. 140+00

TYPICAL FROM STA. 137+42 TO STA. 155+20

SCALE: 1" = 20'

NOTES

Elevations refer to Mean Sea Level Datum

CONNECTICUT RIVER FLOOD CONTROL

NORTH MEADOWS DIKE

FISCAL YEAR 1939 SECTION

RAMP DETAILS NO. 3

STA. 154+00 TO STA. 160+00

HARTFORD, CONN.

CONNECTICUT RIVER CONNECTICUT

IN 66 SHEETS SCALE: 1 IN. = 50 FT. SHEET NO. 44

U.S. ENGINEER OFFICE, PROVIDENCE, R. I. APRIL 1939

SUBMITTED: APPROVED: RECOMMENDED:

HEAD, DESIGN SECTION SENIOR ENGINEER PRINCIPAL ENGINEER

DESIGNED: g. m. m. TRACED BY: G. F. B. FILE NO. CT-4-1473

ASSOC. ENGINEER CHECKED BY: W. G. G.

DATE	REVISION	REV. BY	CK. BY	AP. BY
12/31/45	As-Built Revisions			