
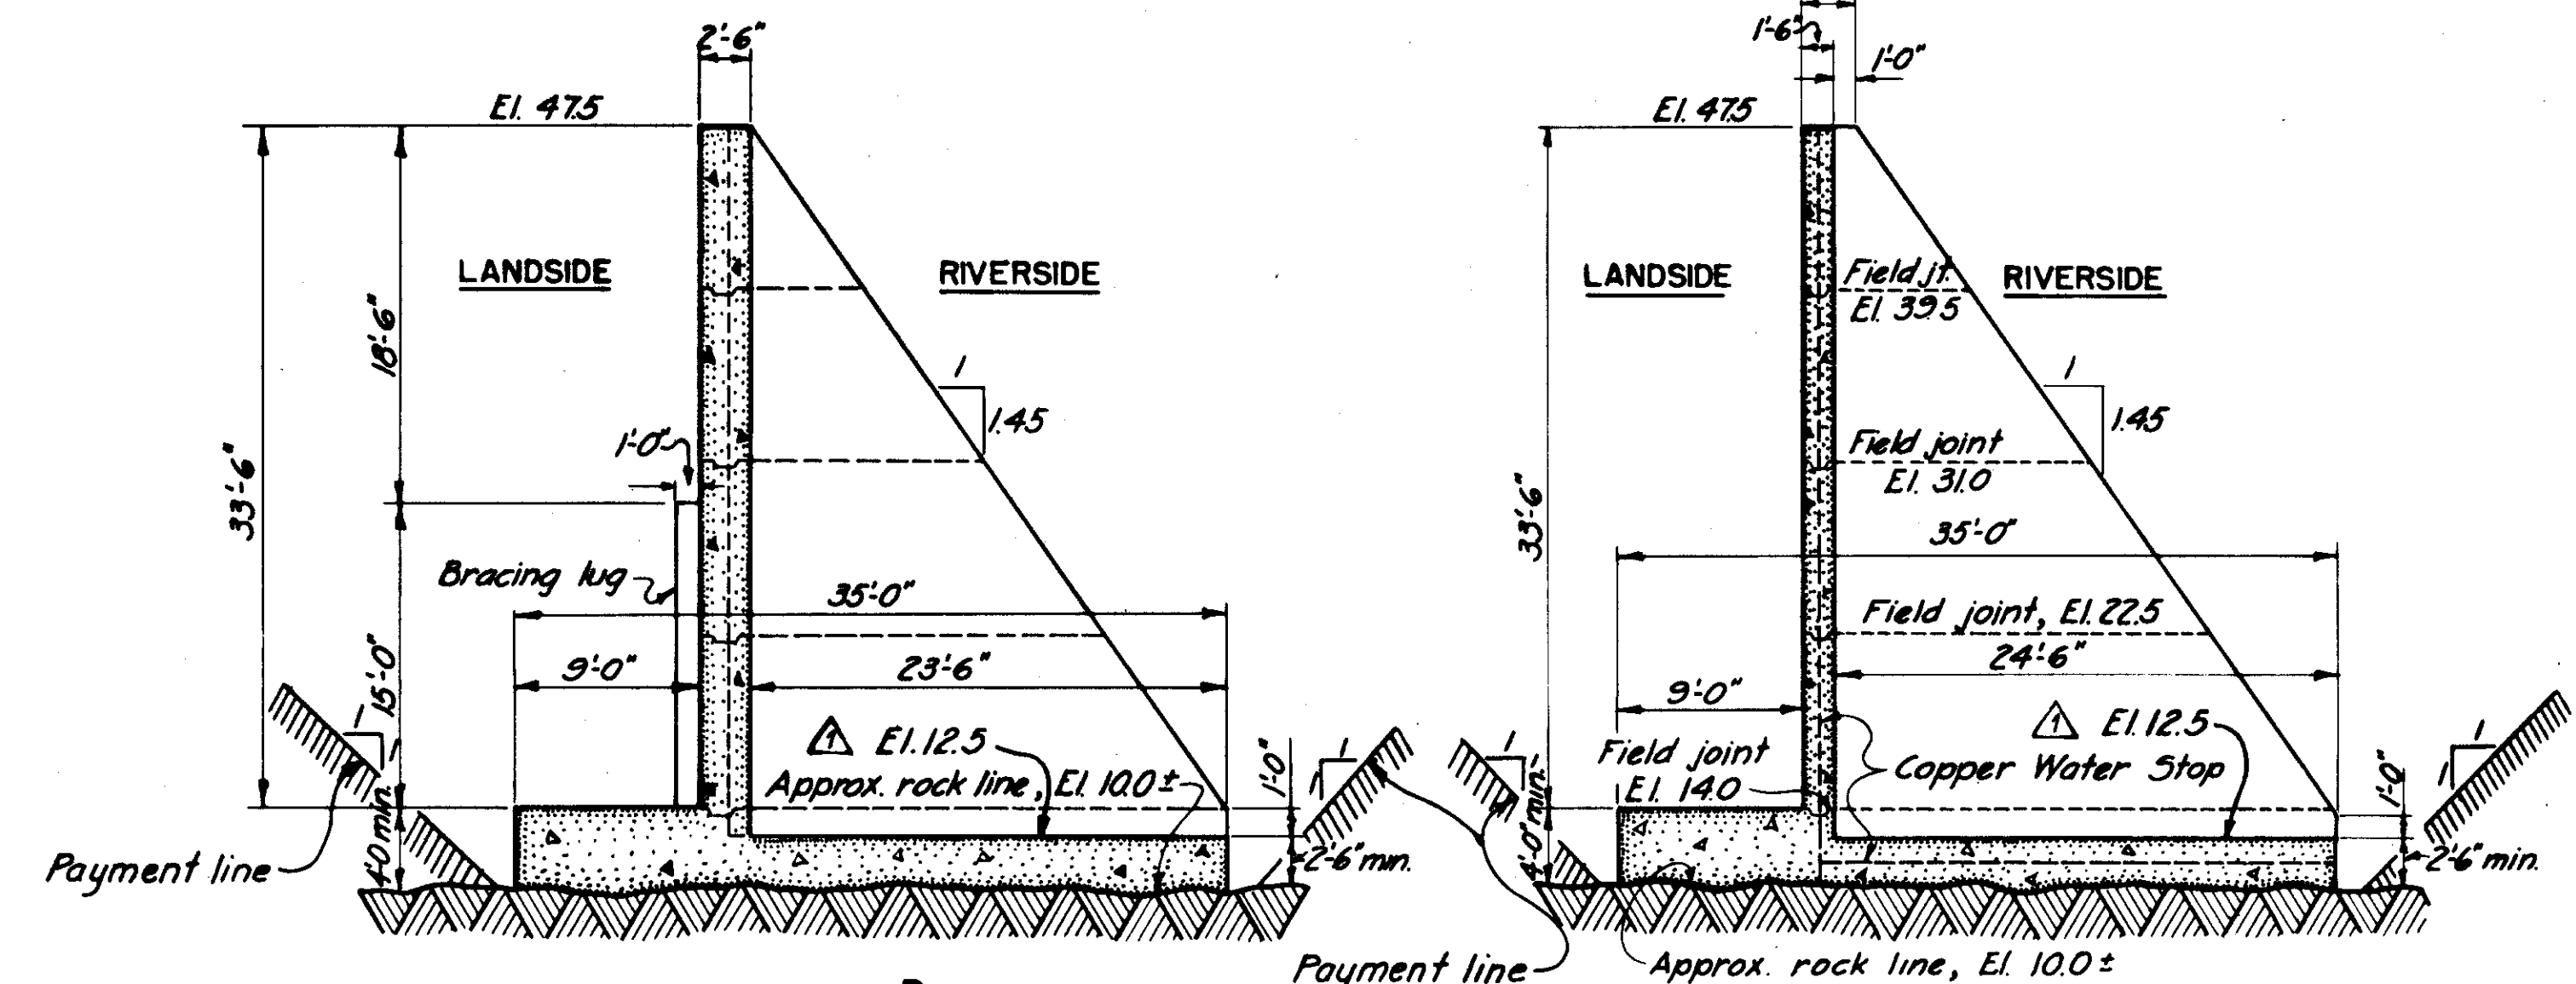
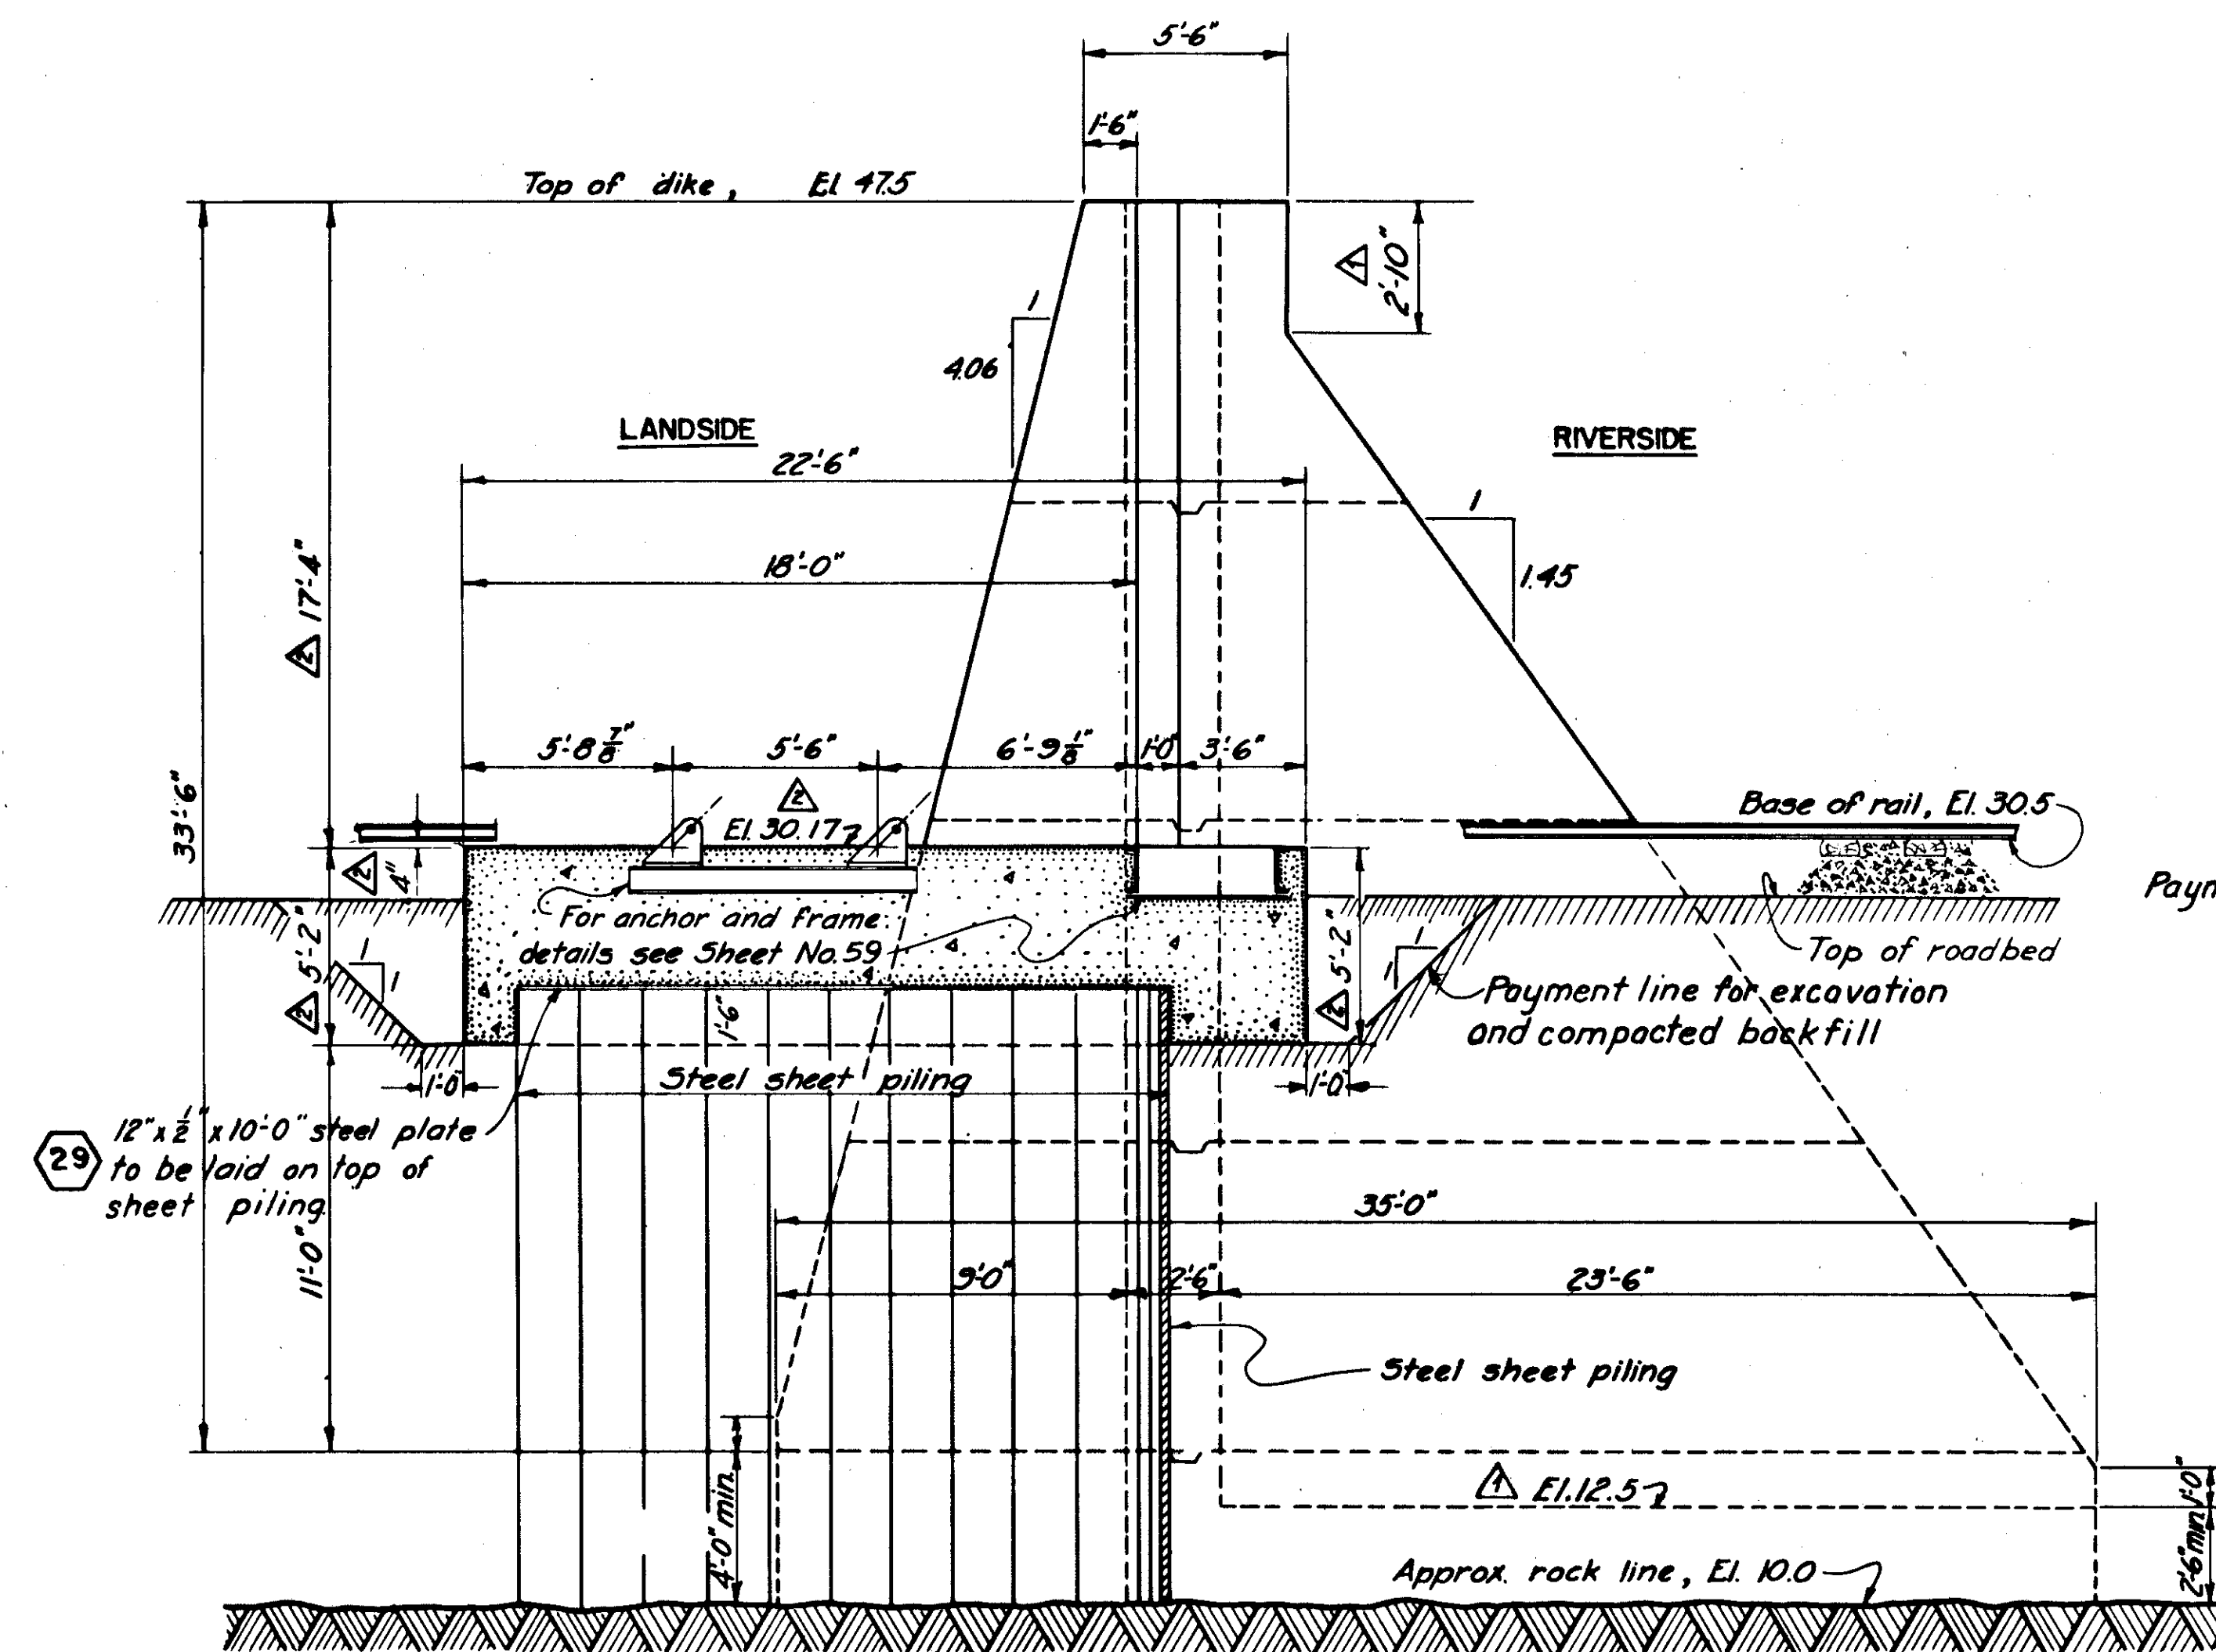
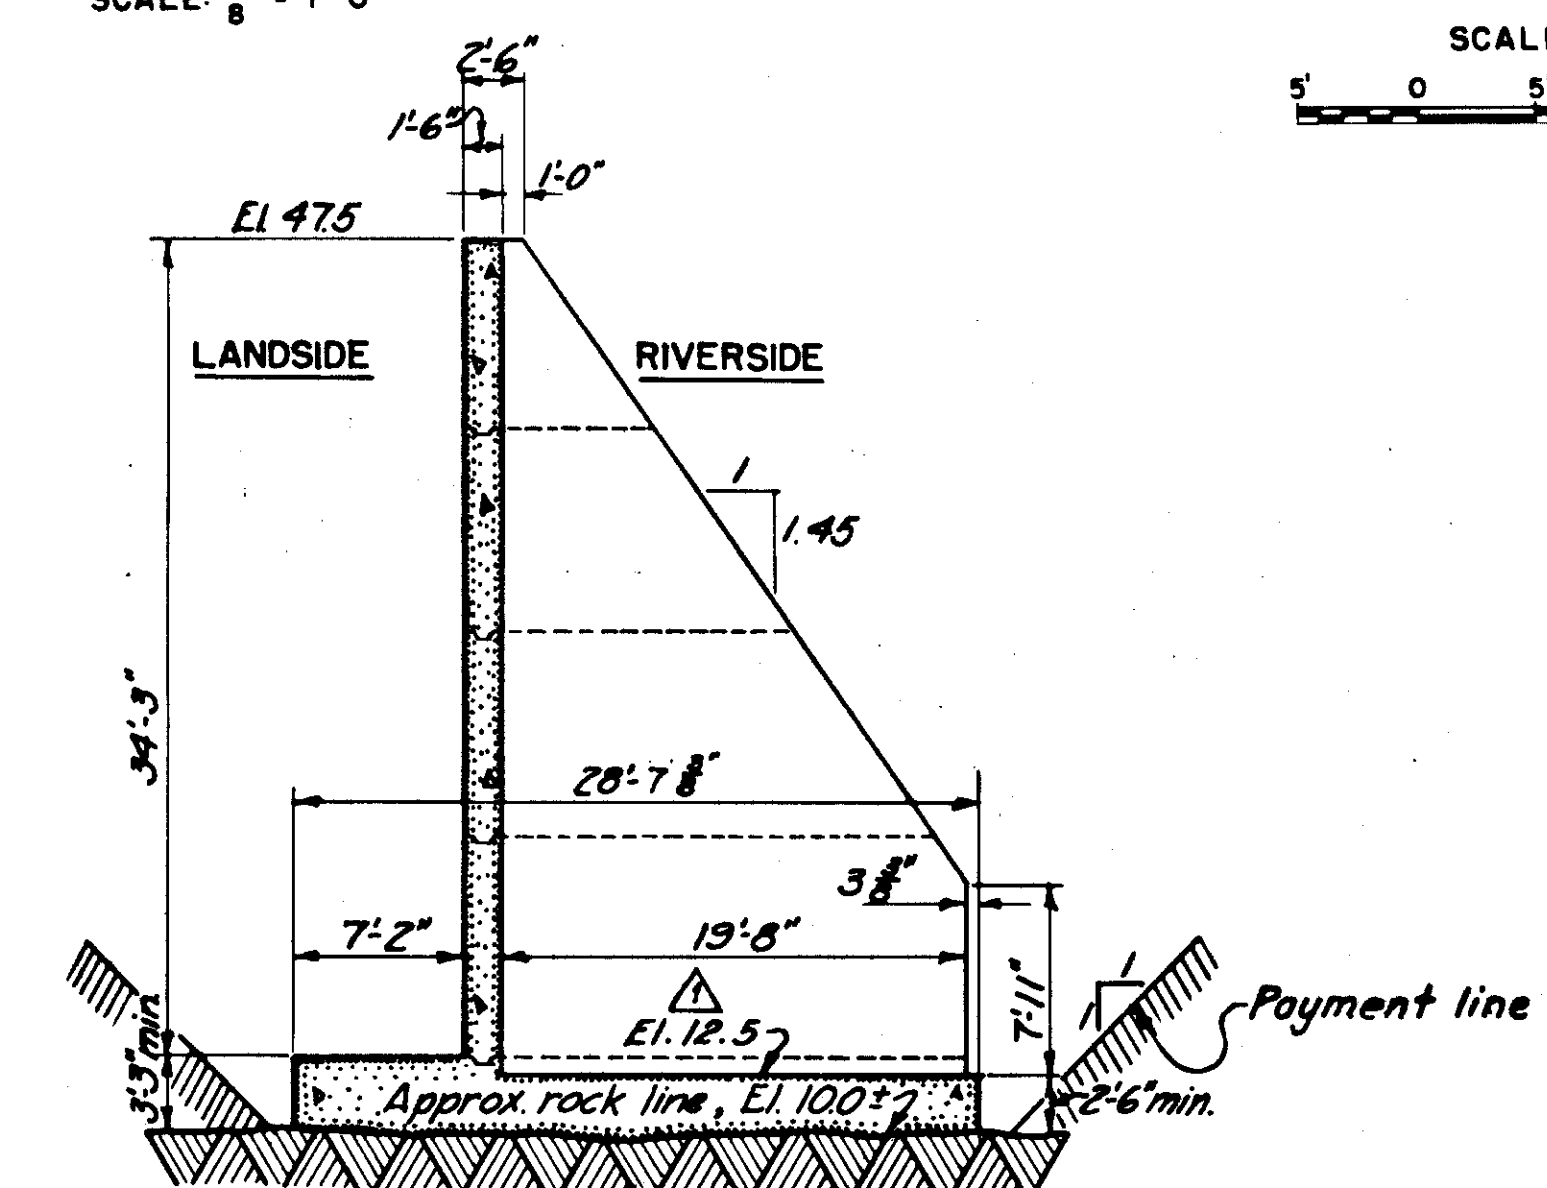


SECTION B 57
SCALE: $\frac{1}{8}'' = 1'-0''$ SECTION C 57
SCALE: $\frac{1}{8}'' = 1'-0''$ 

NOTES

For location of Sections see Sheet No. 57
For general notes see Sheet No. 57
All exterior corners shall be chamfered 1"

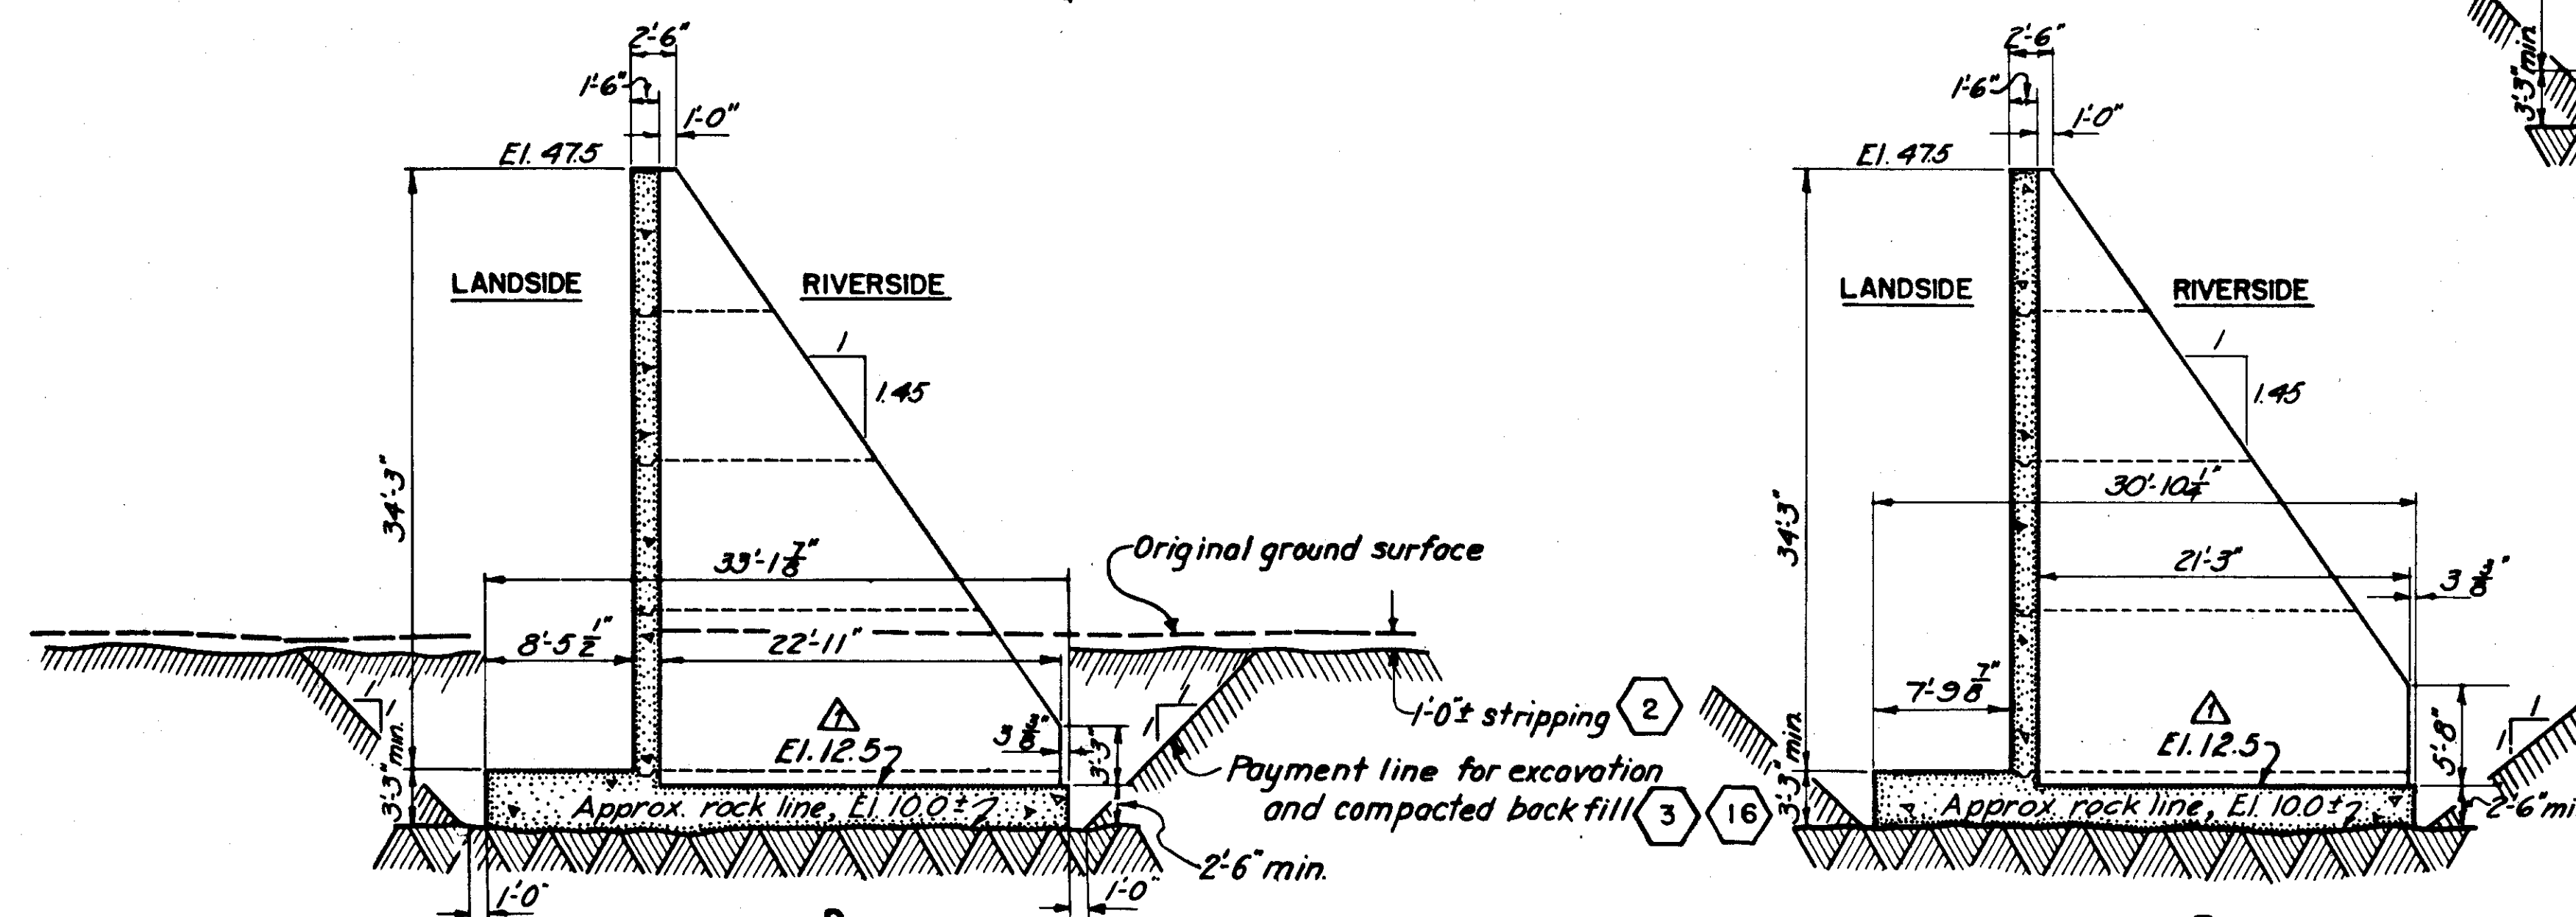

KEY	DATE	REVISION (Indicated by Δ)	REV. BY	CK. BY	AP. BY
Δ	12/31/45	As-Built Revisions			7h
Δ	8-20-39	Dimensions and elevation changed	J.C.D.	1/24	2413
Δ	7-7-39	Dimension changed-Elevation added	J.C.D.	1/24	2413

CONNECTICUT RIVER FLOOD CONTROL			
NORTH MEADOWS DIKE			
FISCAL YEAR 1939 SECTION			
R.R. STOP LOG STRUCTURE NO. 2			
CONCRETE DETAILS NO. 2			
HARTFORD, CONN.			
CONNECTICUT RIVER	CONNECTICUT	SHEET NO. 58	
IN 66 SHEETS		SCALE: 1/4 IN. = 1 FT.	
U. S. ENGINEER OFFICE, PROVIDENCE, R. I., APRIL 1939			
SUBMITTED:	APPROVAL RECOMMENDED:	APPROVED:	
HEAD, DESIGN SECTION	CHIEF, F. C. ENGINEERING DIV.	DISTRICT ENGINEER	
DESIGNED:	DRAWN: J. S. M.	FILE NO. CT-4-1487	
ASSOC. ENGINEER	CHECKED: M. S. J.		