


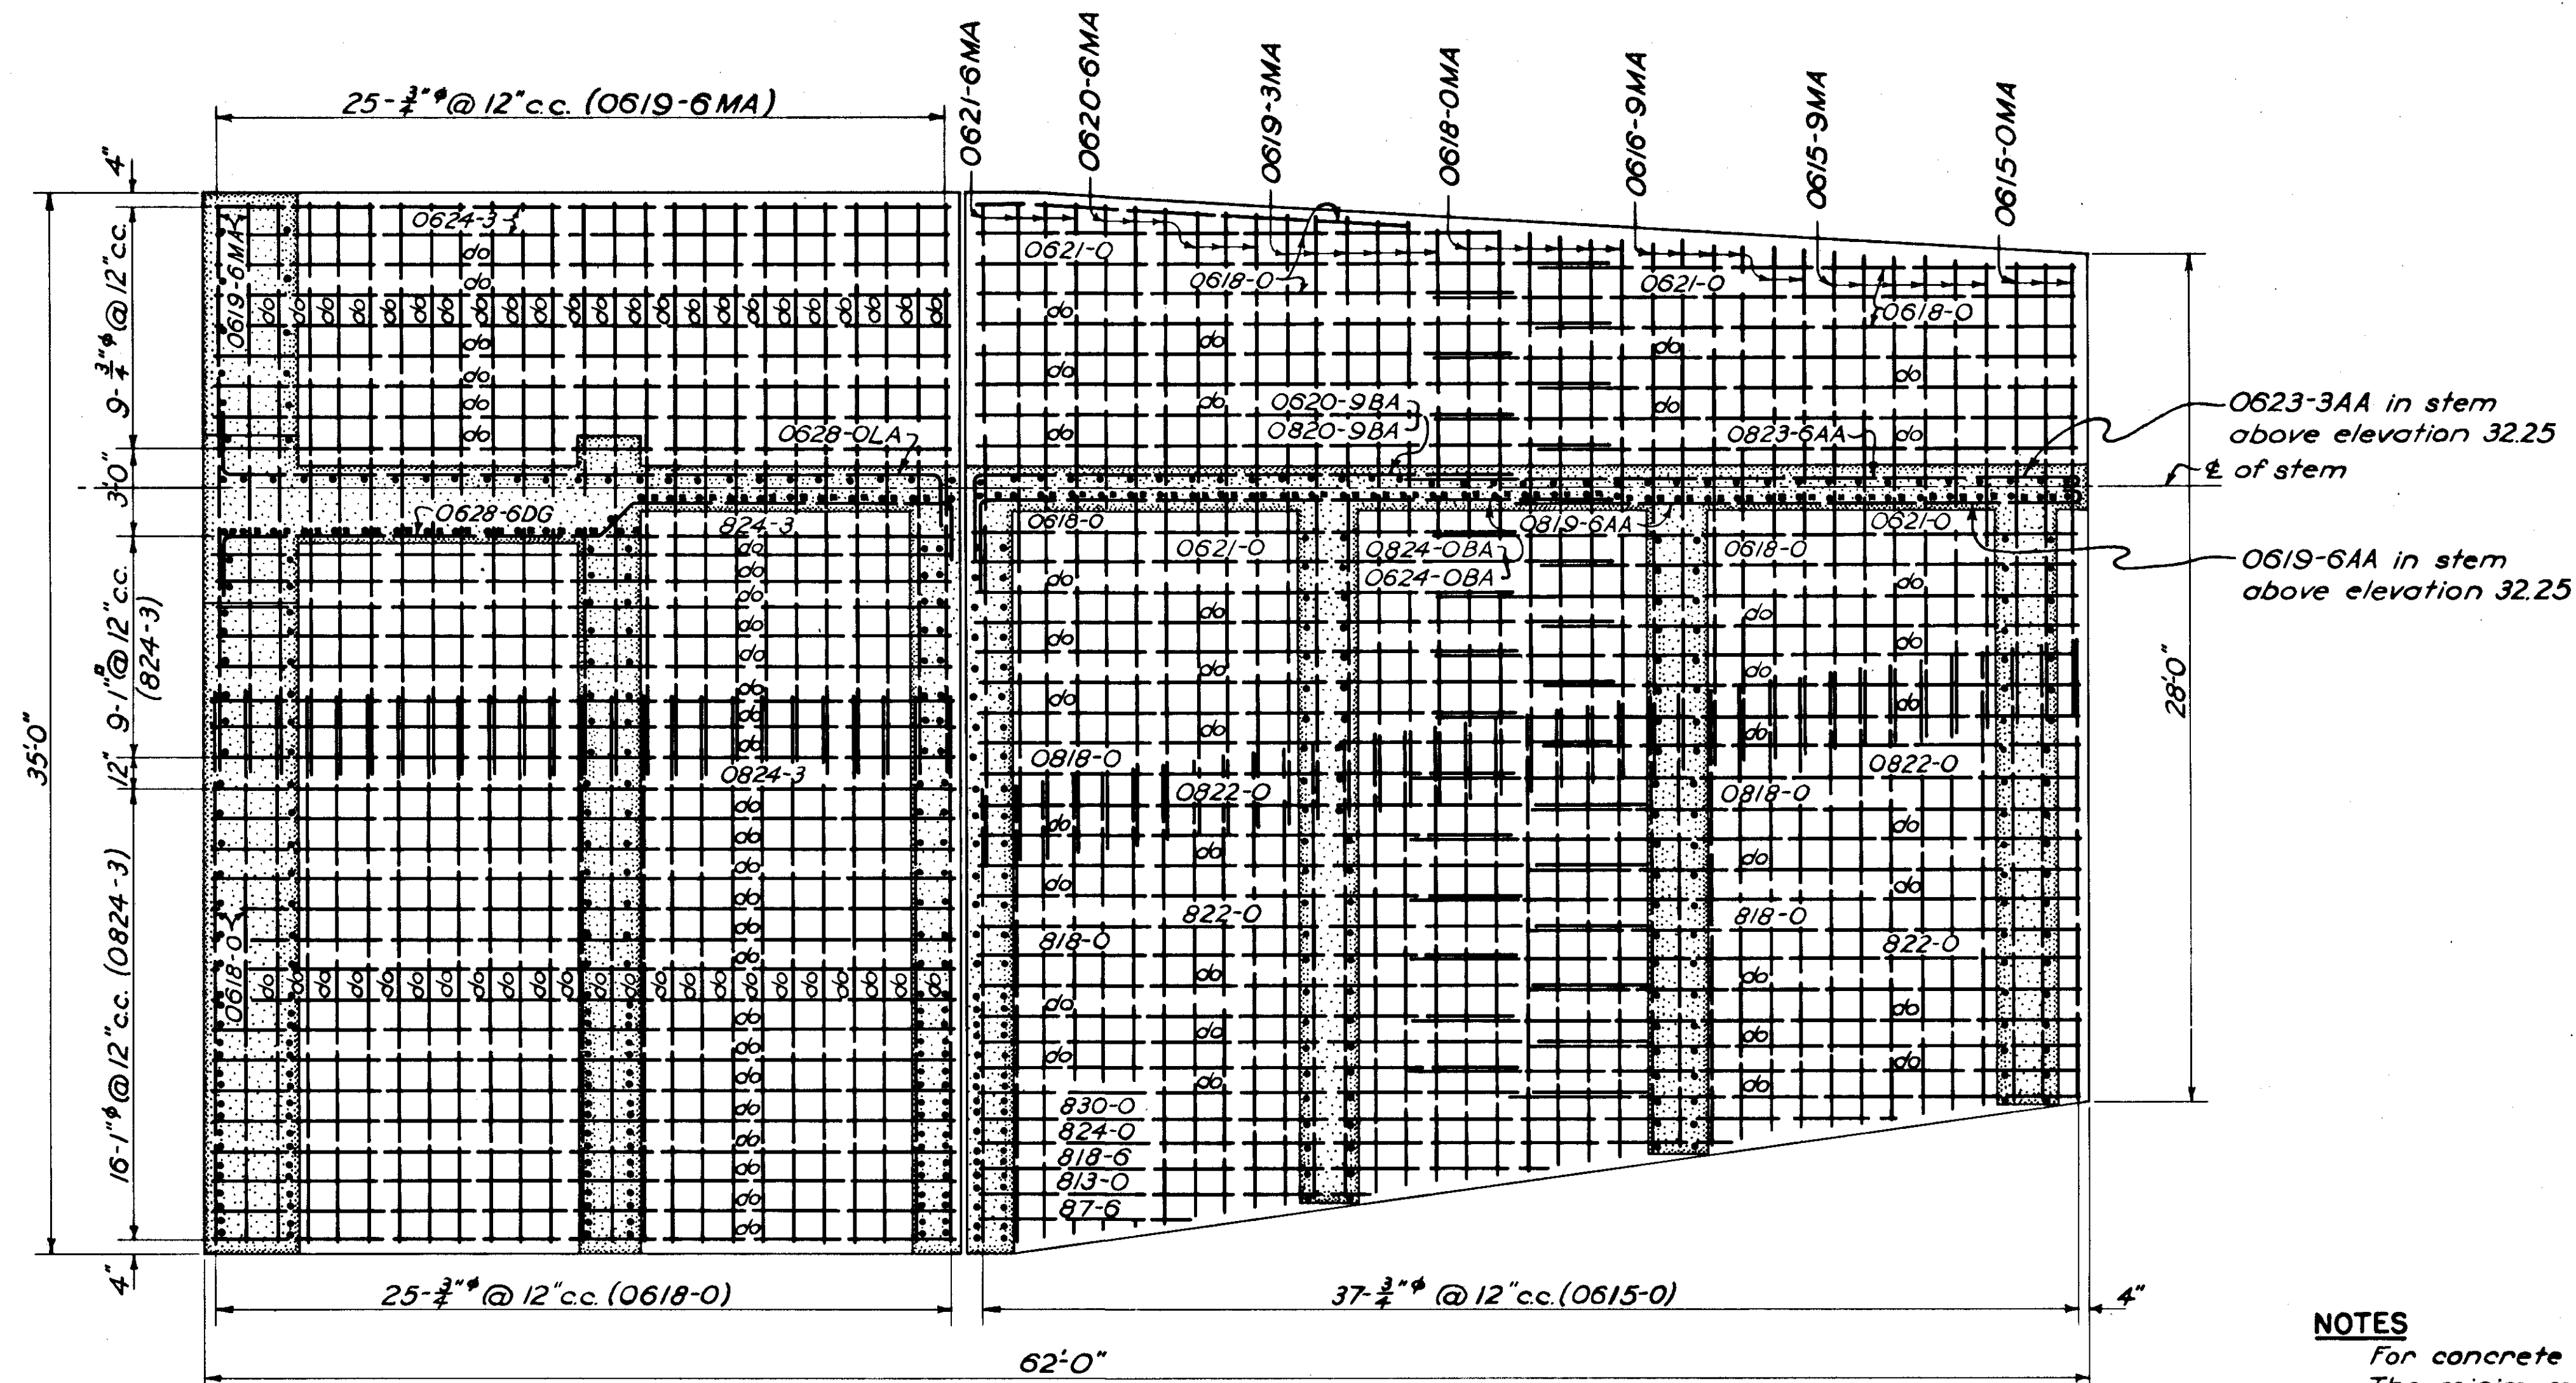

PLAN
STEEL IN TOP OF BASE SLAB

NOTES

For concrete details see Sheet No. 57 & 58

The minimum cover for steel reinforcement shall be 3" in the stem, counterforts and top of base and 4" in the bottom of base slab.

For reinforcement schedule see Sheets No. 65 & 66.

The horizontal and vertical steel in the counterforts is in each face of the counterforts.

Furnishing, bending and placing of steel reinforcement shall be paid for under Item No. 28

12/31/45	As-Built			
DATE	REVISION	REV. BY	CK. BY	AP. BY

CONNECTICUT RIVER FLOOD CONTROL		
NORTH MEADOWS DIKE		
FISCAL YEAR 1939 SECTION		
R.R. STOP-LOG STRUCTURE NO. 2		
STEEL REINFORCEMENT NO. 1		
HARTFORD, CONN.		
CONNECTICUT RIVER		CONNECTICUT
IN 66 SHEETS	SCALE: 1/4 IN. = 1 FT.	SHEET NO. 60
5	0 5 10	10
U. S. ENGINEER OFFICE, PROVIDENCE, R. I., APRIL 1939		
SUBMITTED:	APPROVAL RECOMMENDED:	APPROVED:
SENIOR ENGINEER	PRINCIPAL ENGINEER	CHIEF OF ENGINEERS
HEAD, DESIGN SECTION	CHIEF, F. C. ENGINEERING DIV.	DISTRICT ENGINEER
DESIGNED:	DRAWN: J. S. M.	FILE NO. CT-4-1489
TRACED: J. A. C.	CHECKED: W. S. J.	