


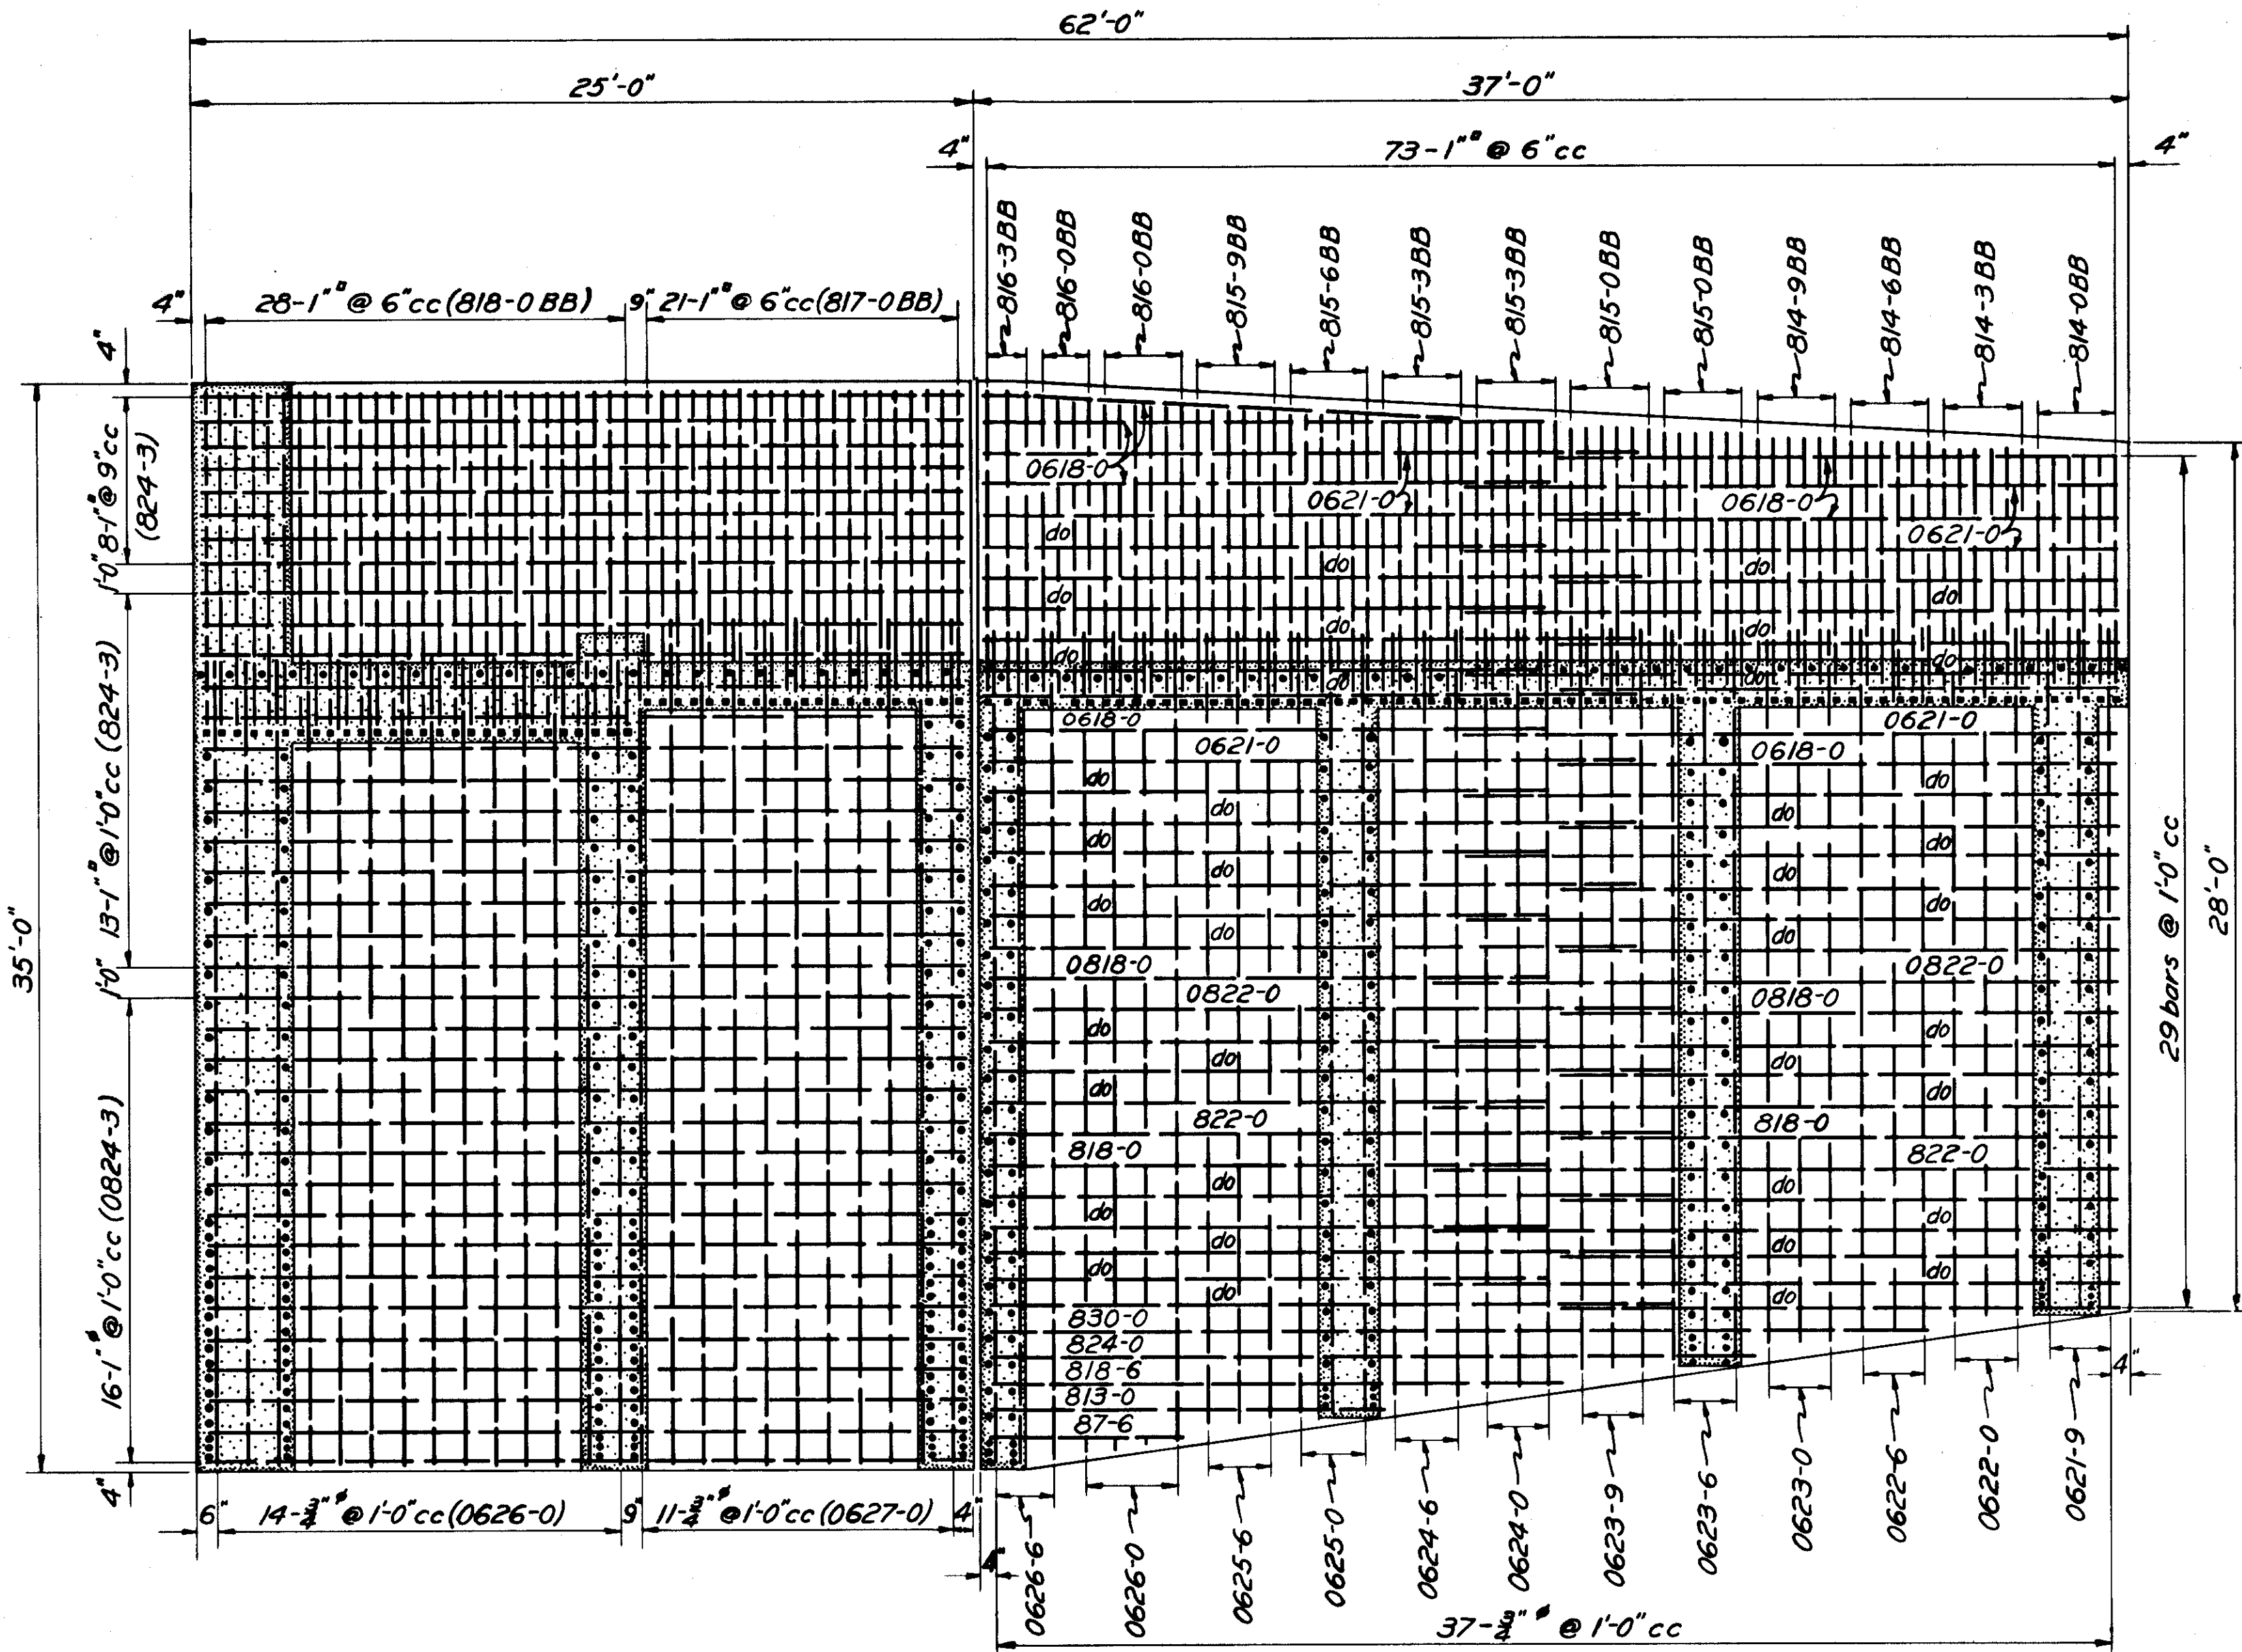

PLAN
STEEL IN BOTTOM OF BASE SLAB

NOTES
For general notes applying to this sheet see Sheet No. 60.

12/31/45	As-Built				
DATE	REVISION	REV.BY	CK.BY	AP.BY	

CONNECTICUT RIVER FLOOD CONTROL		
NORTH MEADOWS DIKE		
FISCAL YEAR 1939 SECTION		
R.R. STOP-LOG STRUCTURE NO. 2		
STEEL REINFORCEMENT NO. 2		
HARTFORD, CONN.		
CONNECTICUT RIVER	CONNECTICUT	
IN 66 SHEETS	SCALE: 1/4 IN. = 1 FT.	SHEET NO. 61
U. S. ENGINEER OFFICE, PROVIDENCE, R. I., APRIL 1939		
SUBMITTED:	APPROVAL RECOMMENDED:	APPROVED:
HEAD, DESIGN SECTION	PRINCIPAL ENGINEER	L.T. COL., CORP. OF ENGINEERS
DESIGNED:	DRAWN: J.S.M.	FILE NO. CT-4-1490
ASSOC. ENGINEER	CHECKED: M.S. Jr.	