

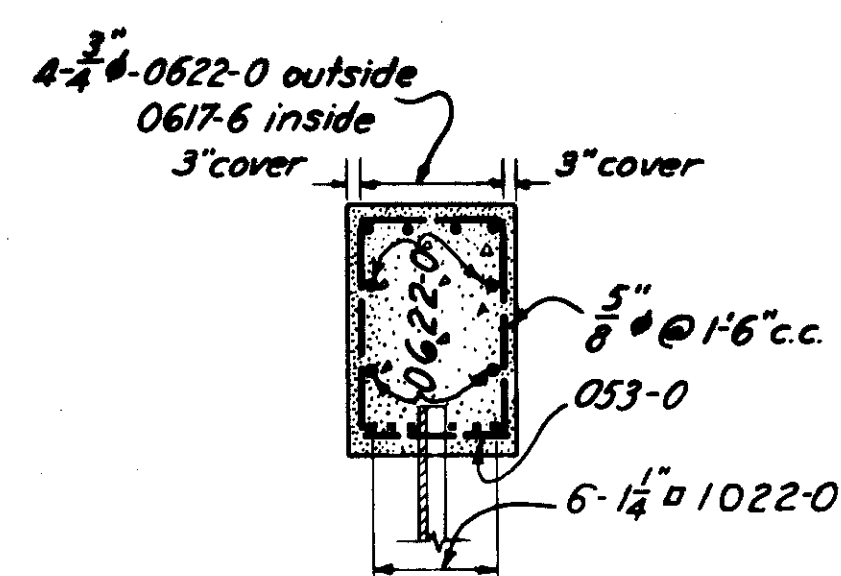
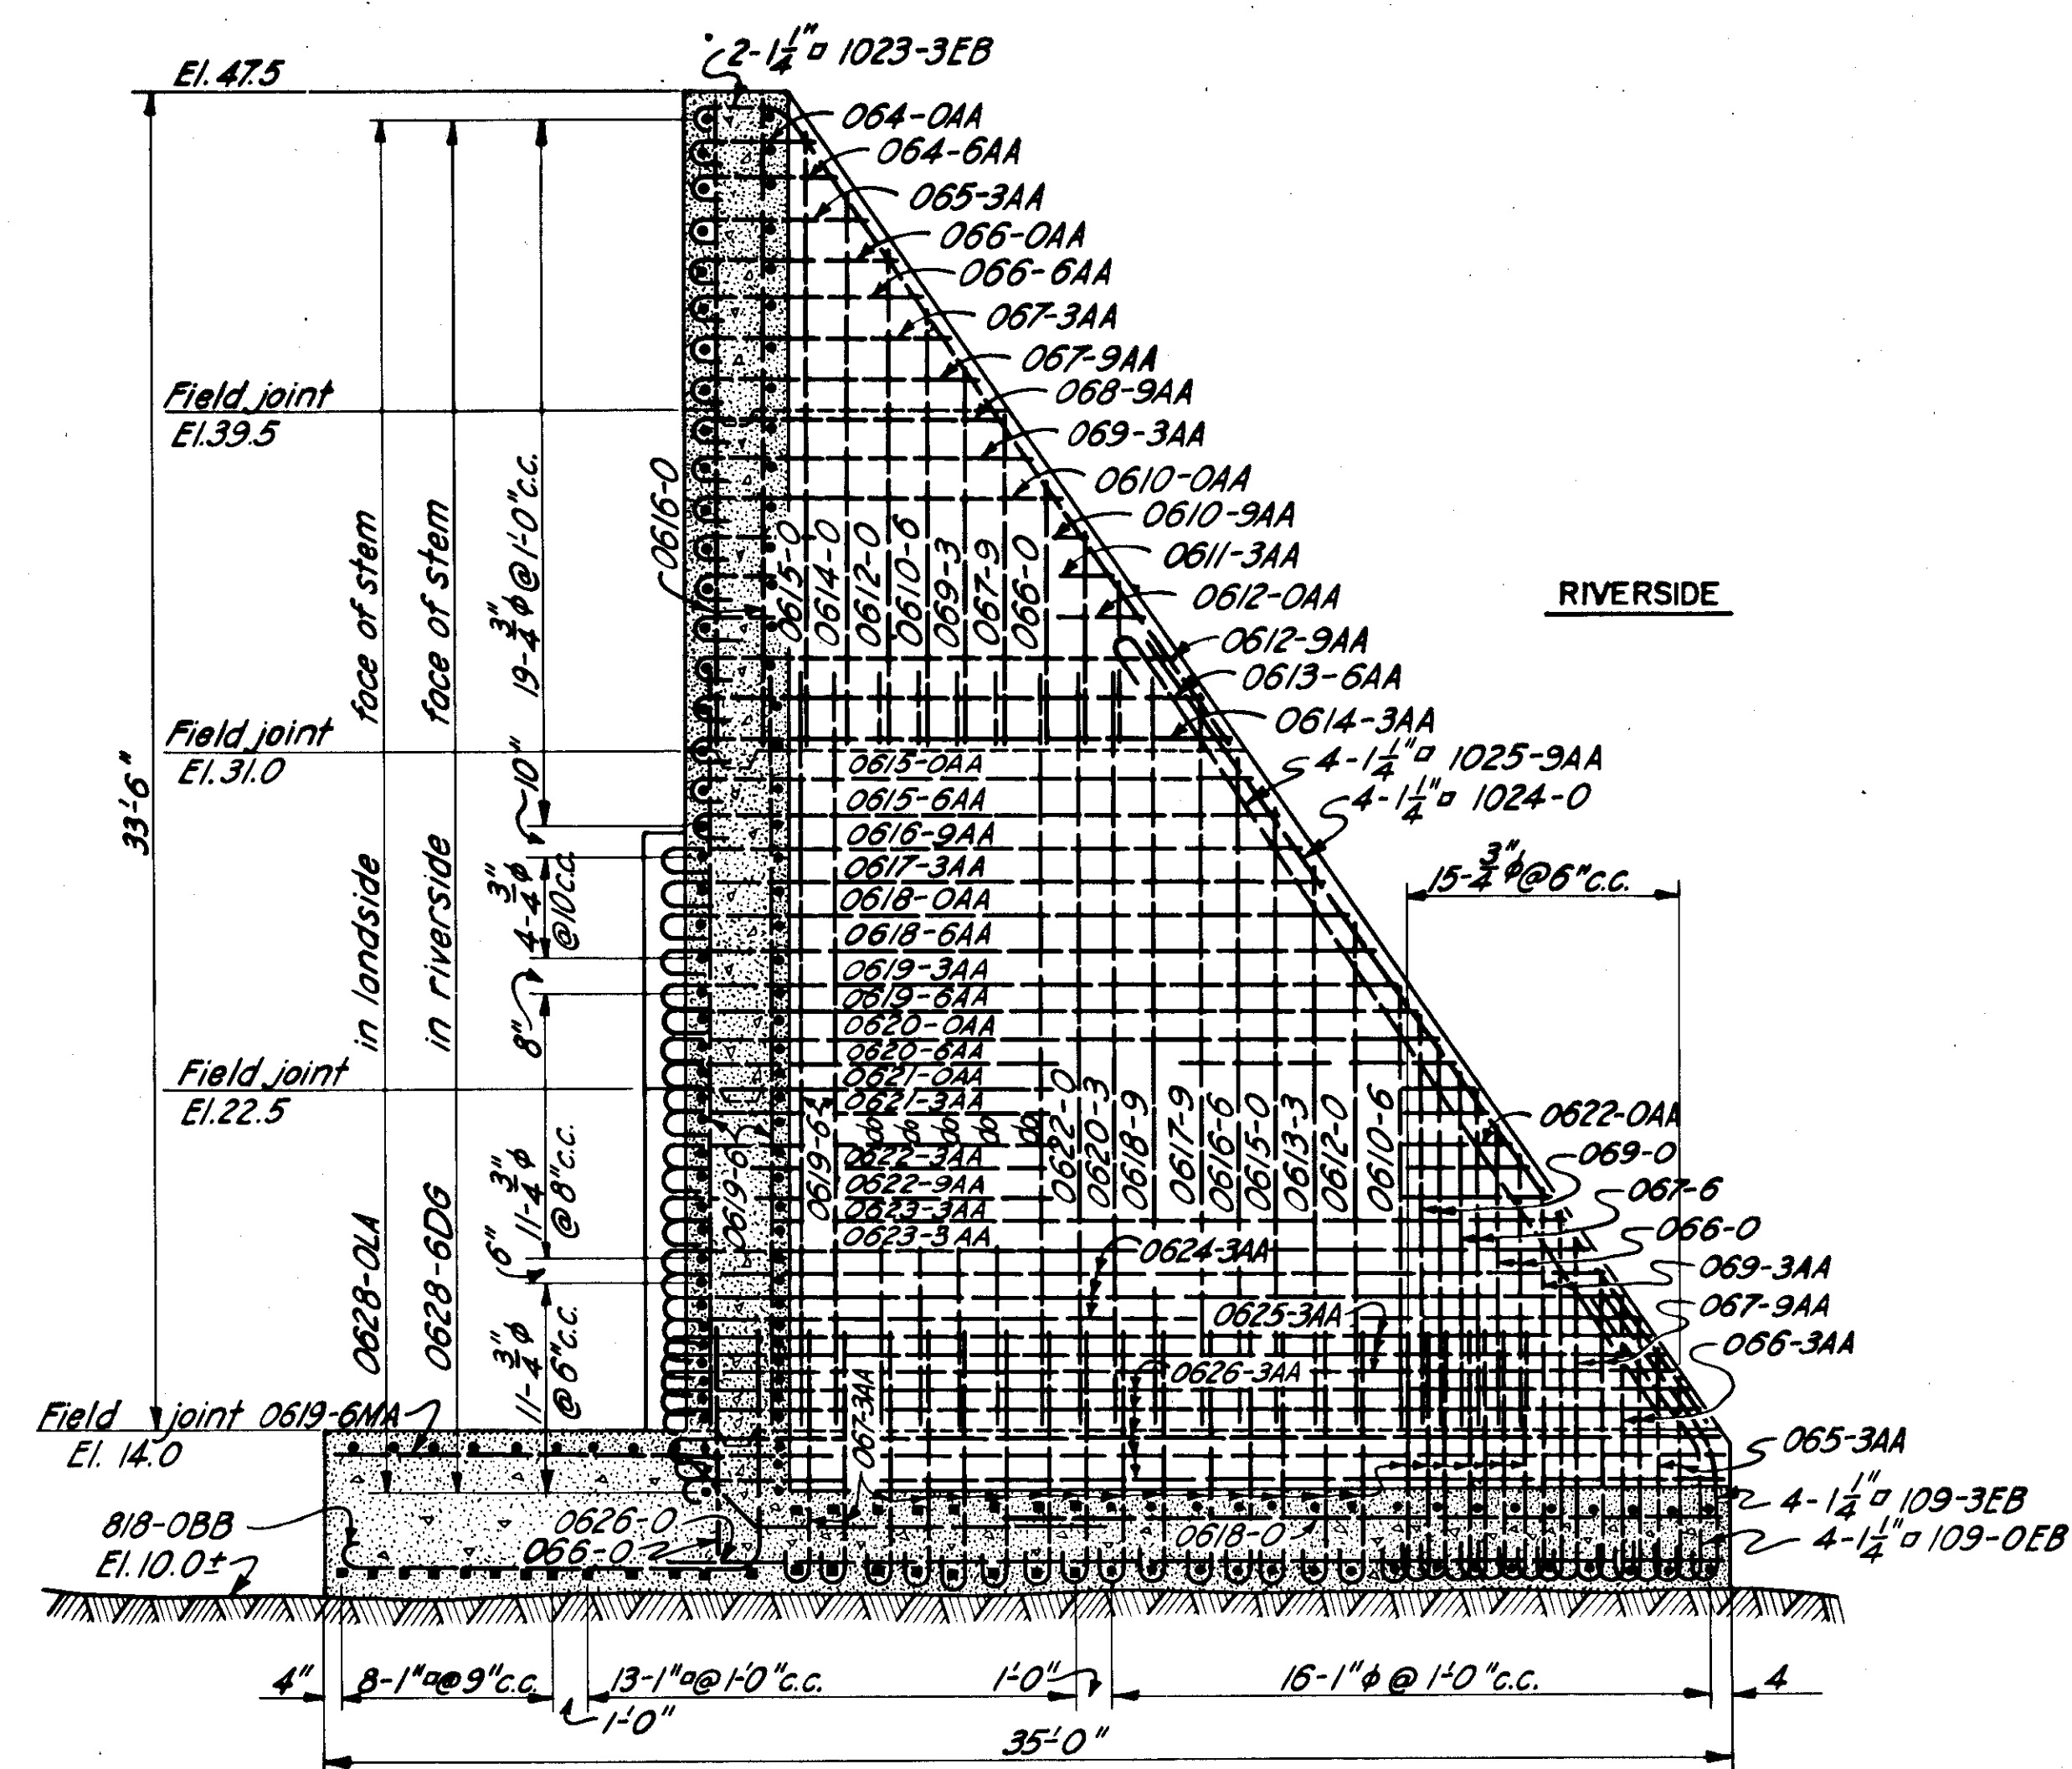
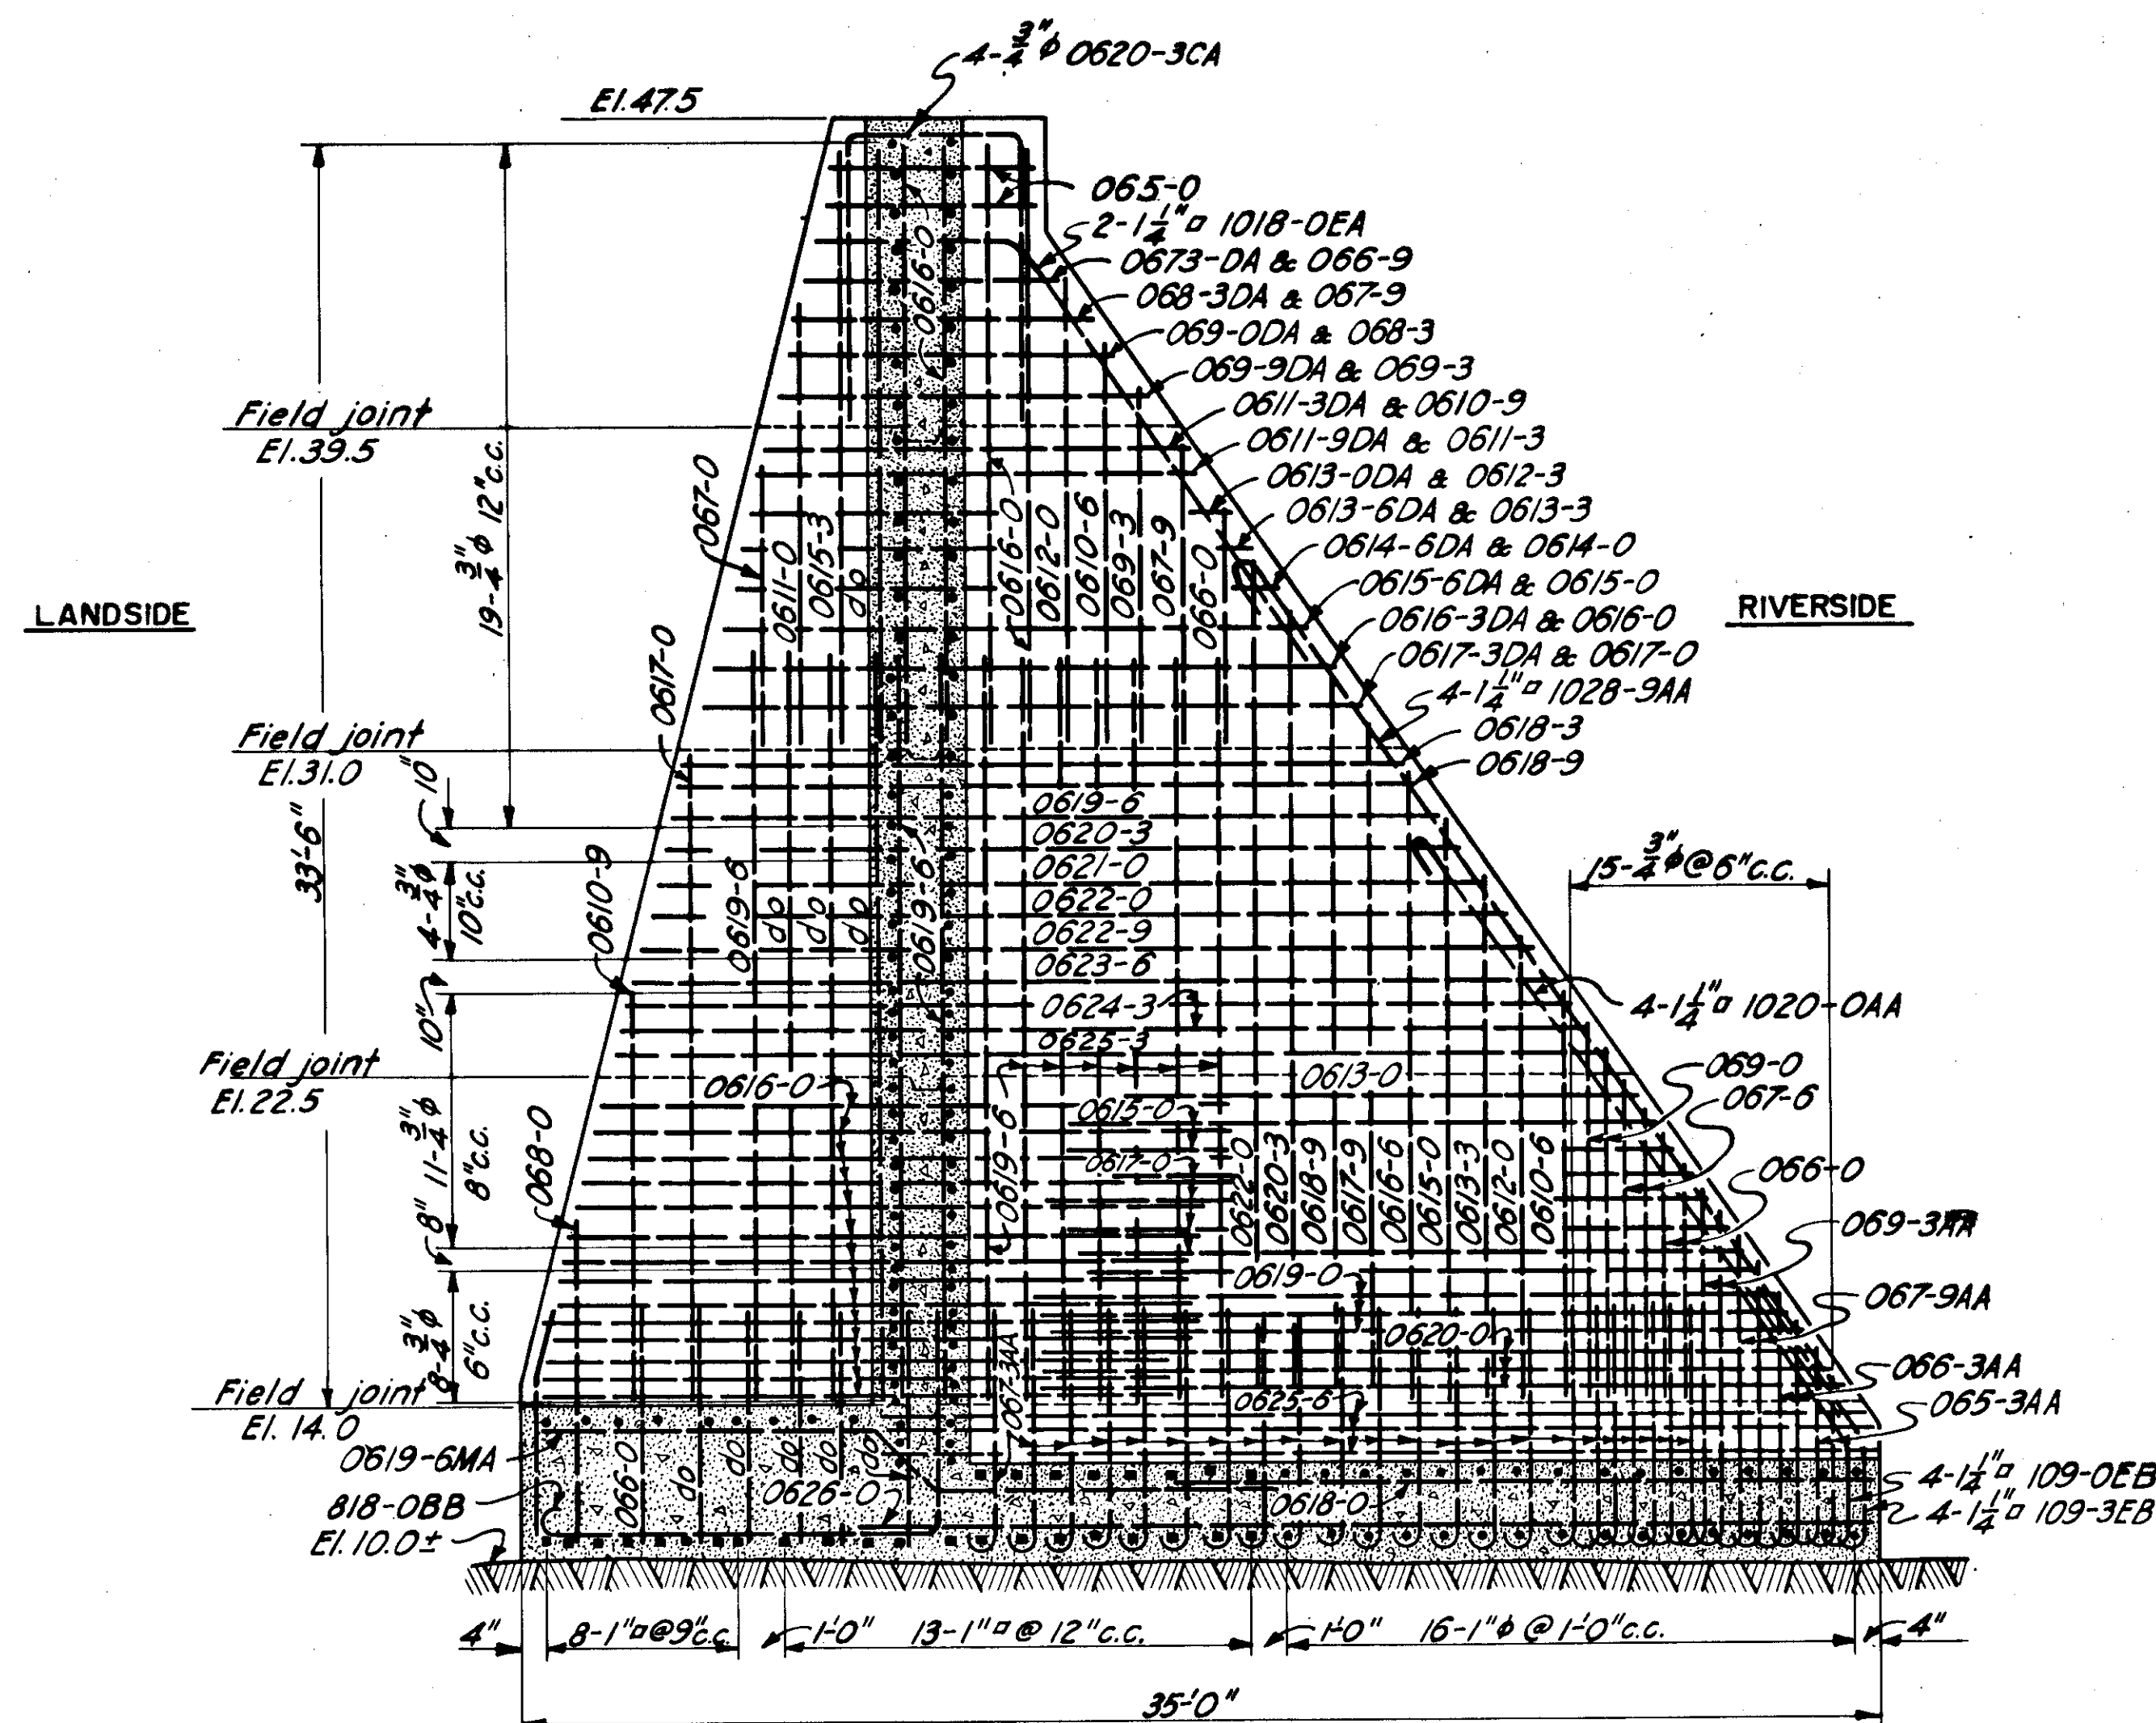
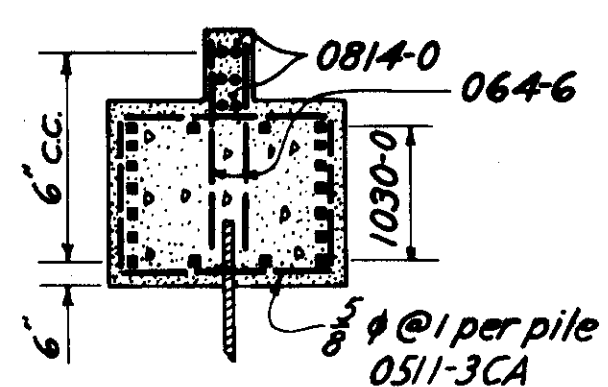


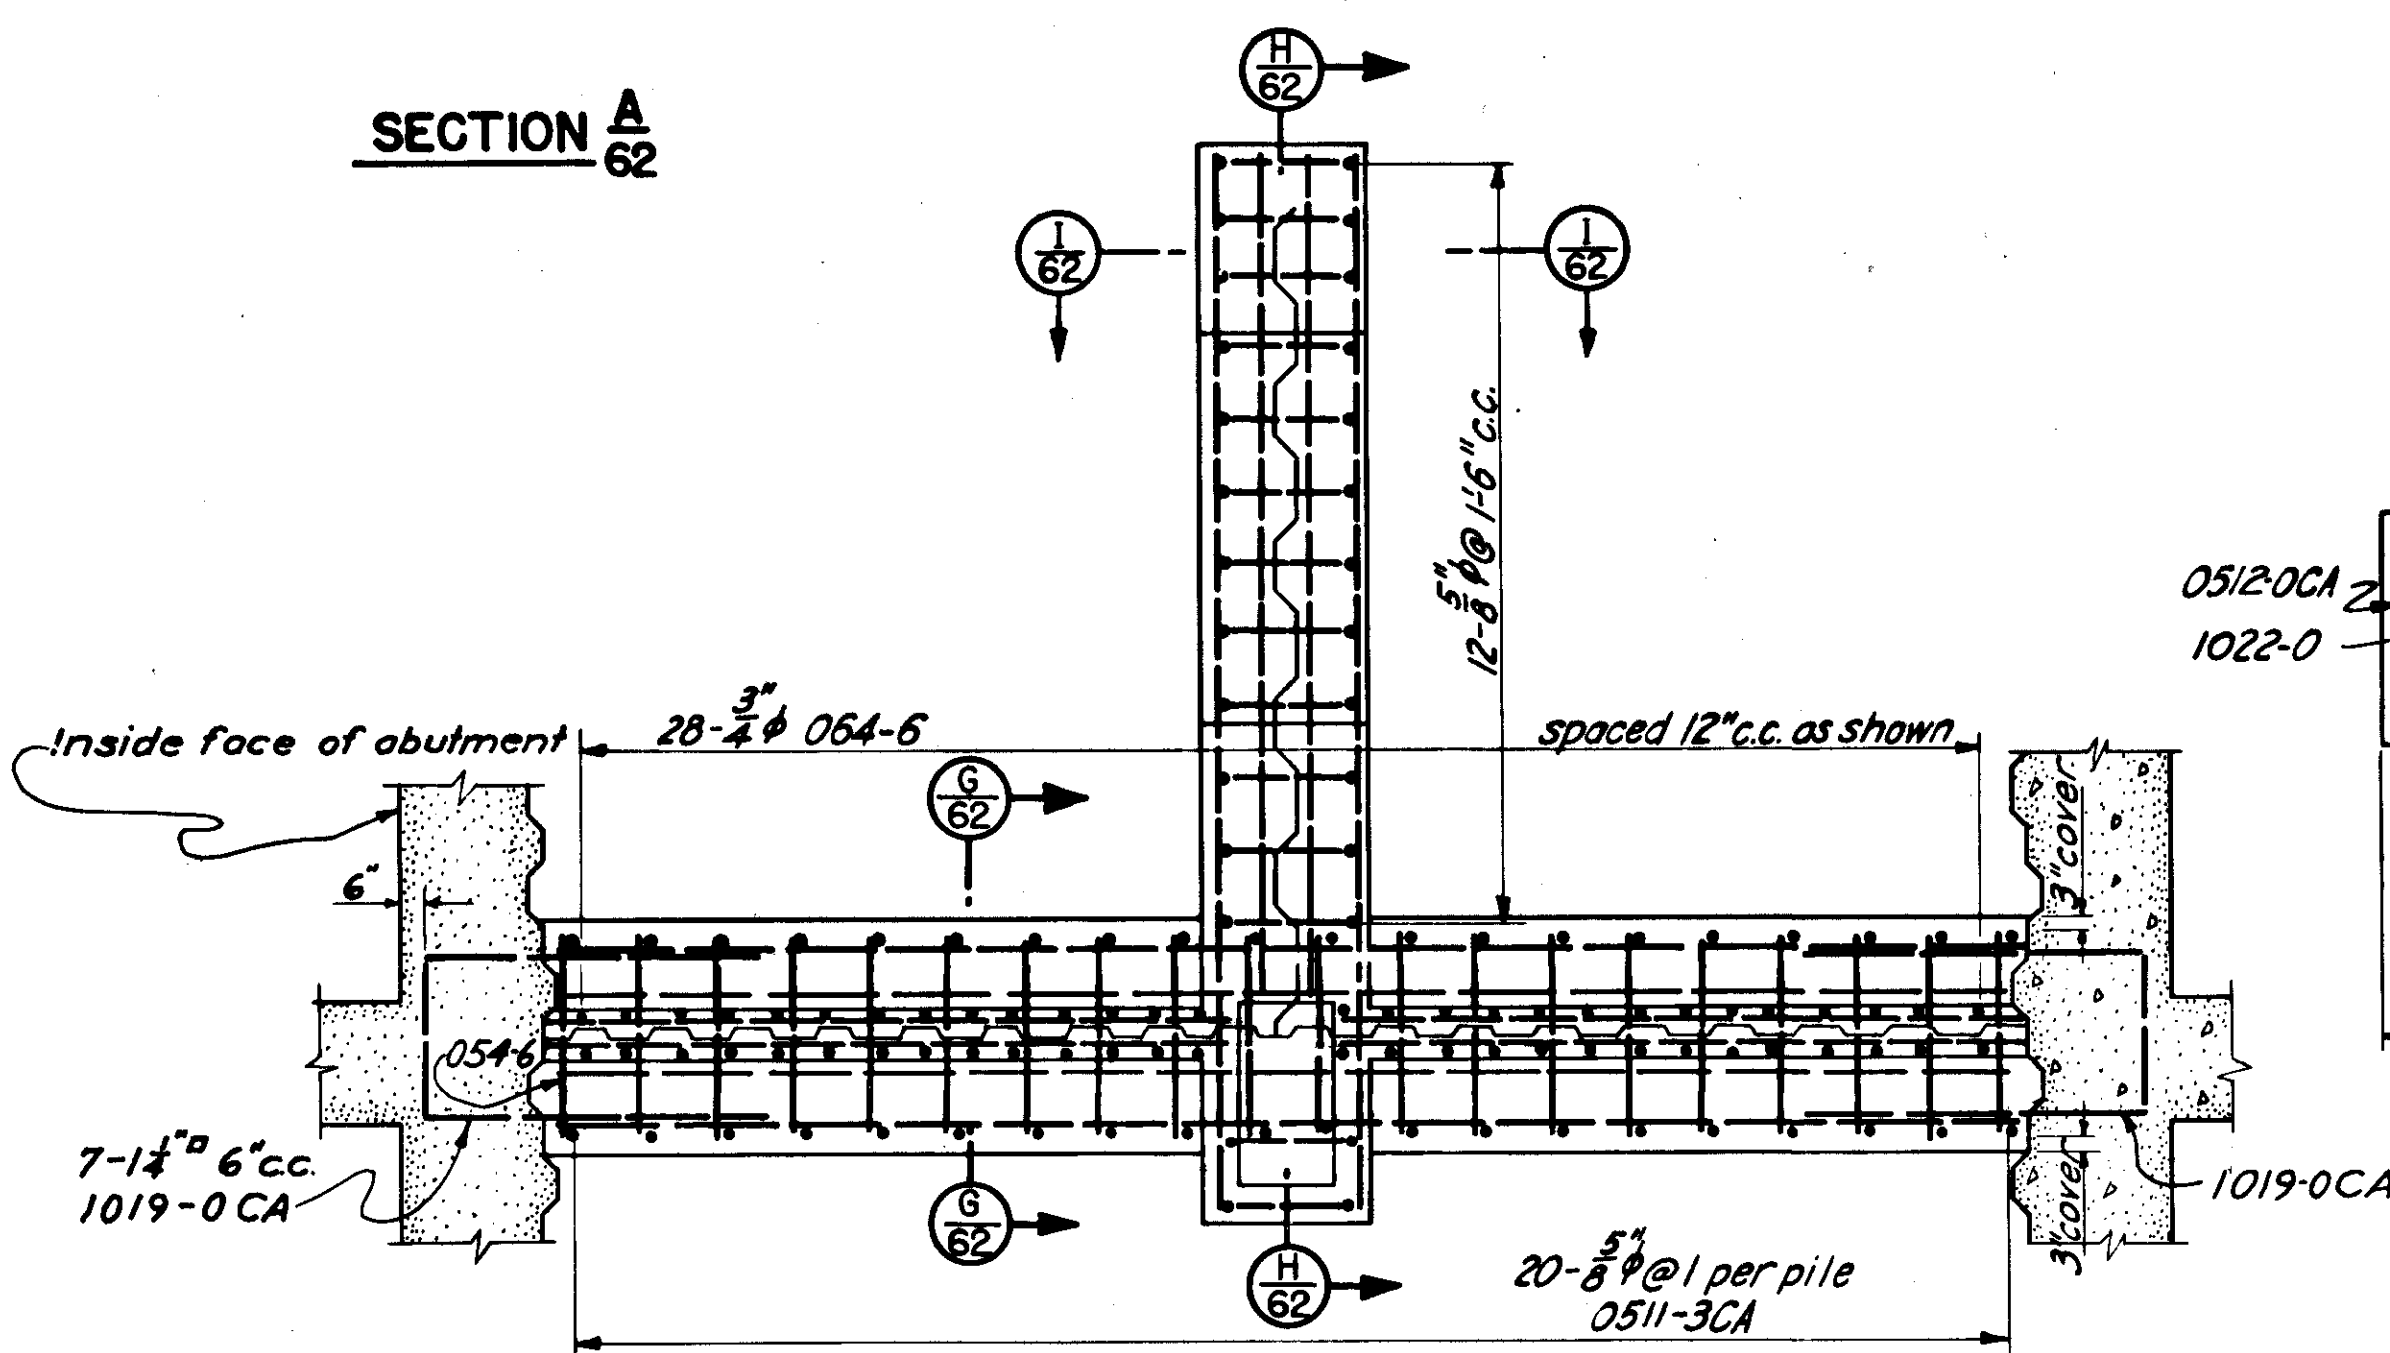

SECTION I 62

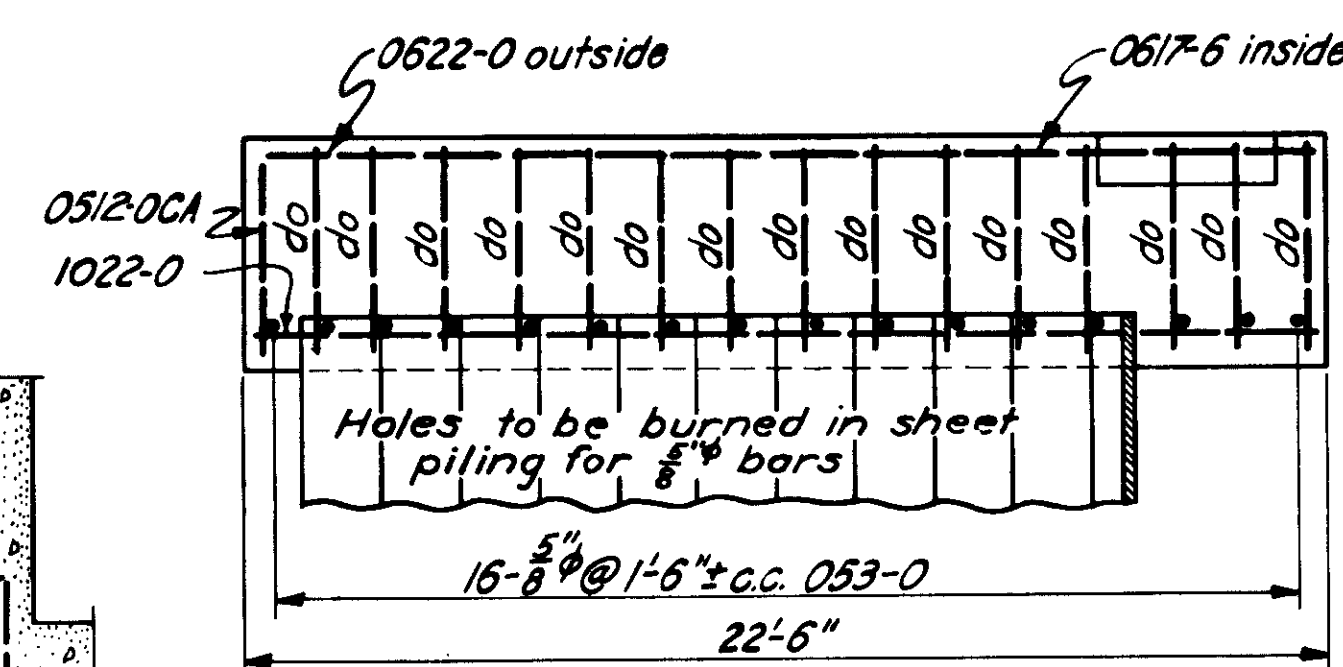

SECTION G 62

PLAN
STOP-LOG AND CENTER POST SUPPORT

SECTION H 62

NOTES

For general notes applying to this sheet
see Sheet No. 60.

DATE	REVISION	REV.	BY	CHK.	BY	AP.	BY
12/31/35	As-Built						

CONNECTICUT RIVER FLOOD CONTROL			
NORTH MEADOWS DIKE			
FISCAL YEAR 1939 SECTION			
R. R. STOP-LOG STRUCTURE NO. 2			
STEEL REINFORCEMENT NO. 3			
HARTFORD, CONN.			
CONNECTICUT RIVER		CONNECTICUT	
IN 66 SHEETS		SHEET NO. 62	
SCALE: 1/4" = 1'-0"		10'	
U. S. ENGINEER OFFICE, PROVIDENCE, R. I., APRIL 1939			
SUBMITTED:	APPROVAL RECOMMENDED:	APPROVED:	
THOMAS B. NIELSEN	J. S. OSBURN	J. S. OSBURN	
SENIOR ENGINEER	PRINCIPAL ENGINEER	DISTRICT ENGINEER	
HEAD, DESIGN SECTION	CHIEF, F. C. ENGINEERING DIV.		
DESIGNED:	DRAWN:	FILE NO. CT-4-1491	
J. C. SINGAR	J. S. OSBURN		
ASSOC. ENGINEER	CHECKED:		