



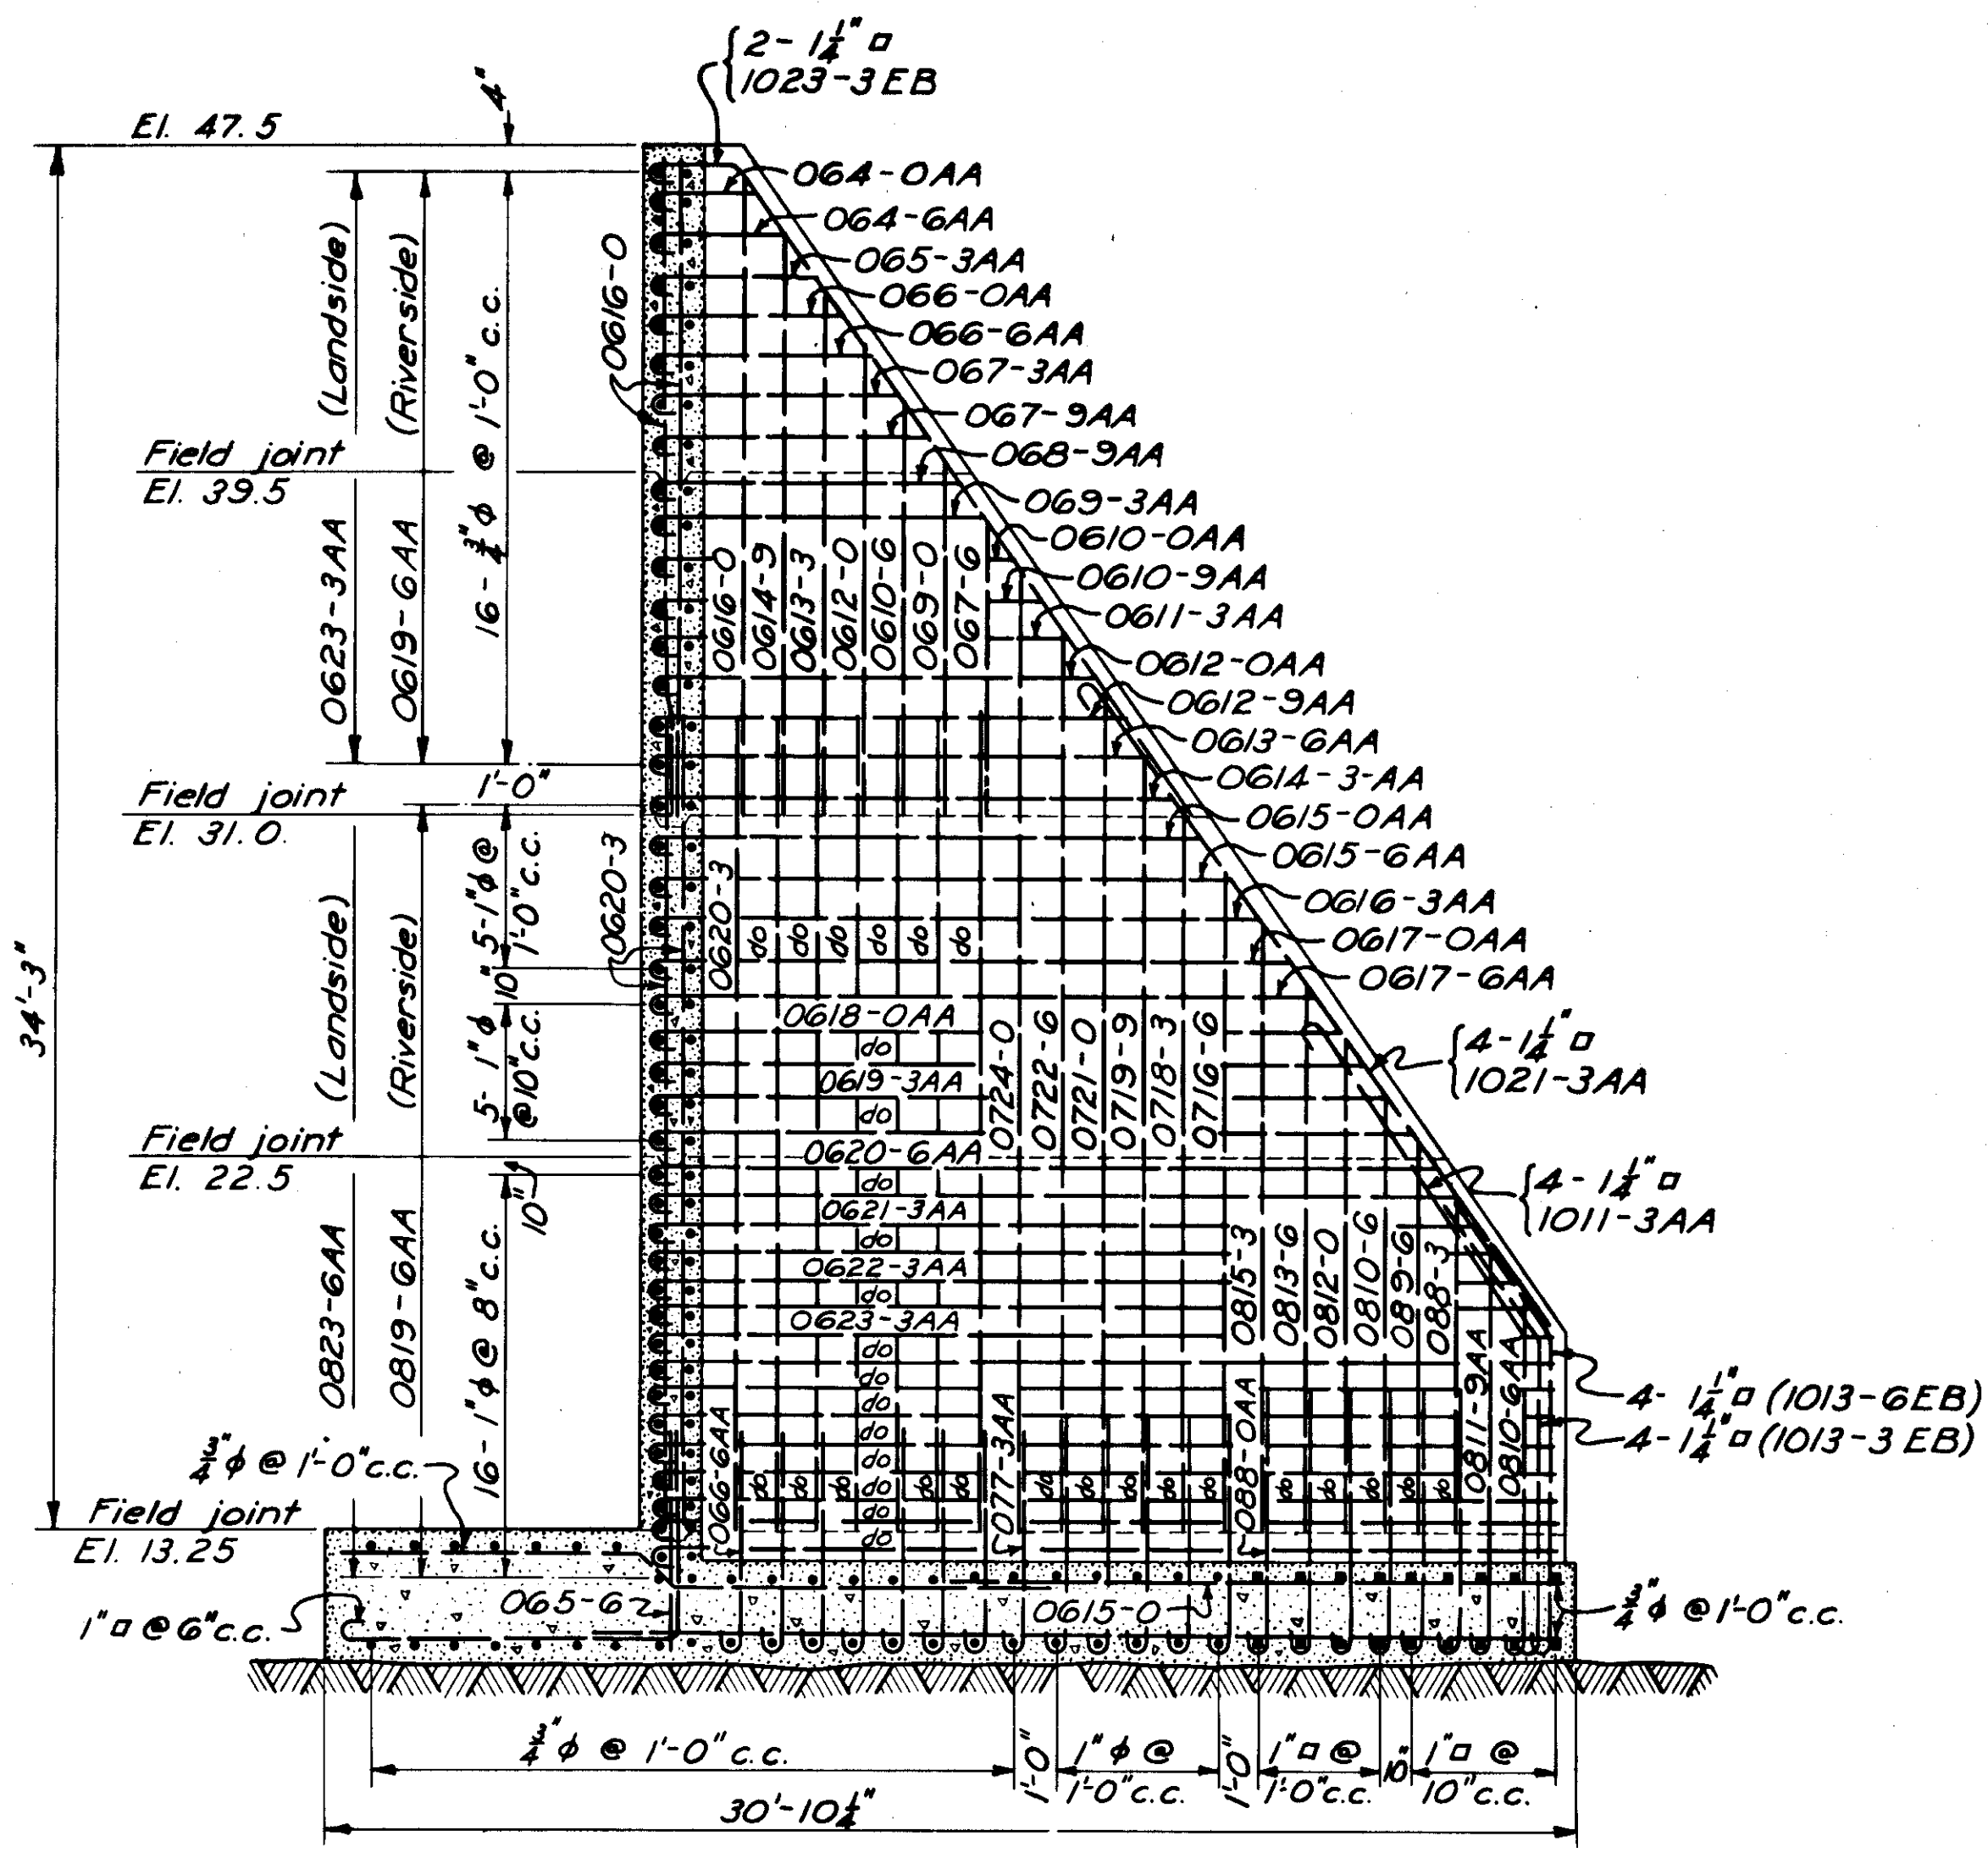

SECTION E 57

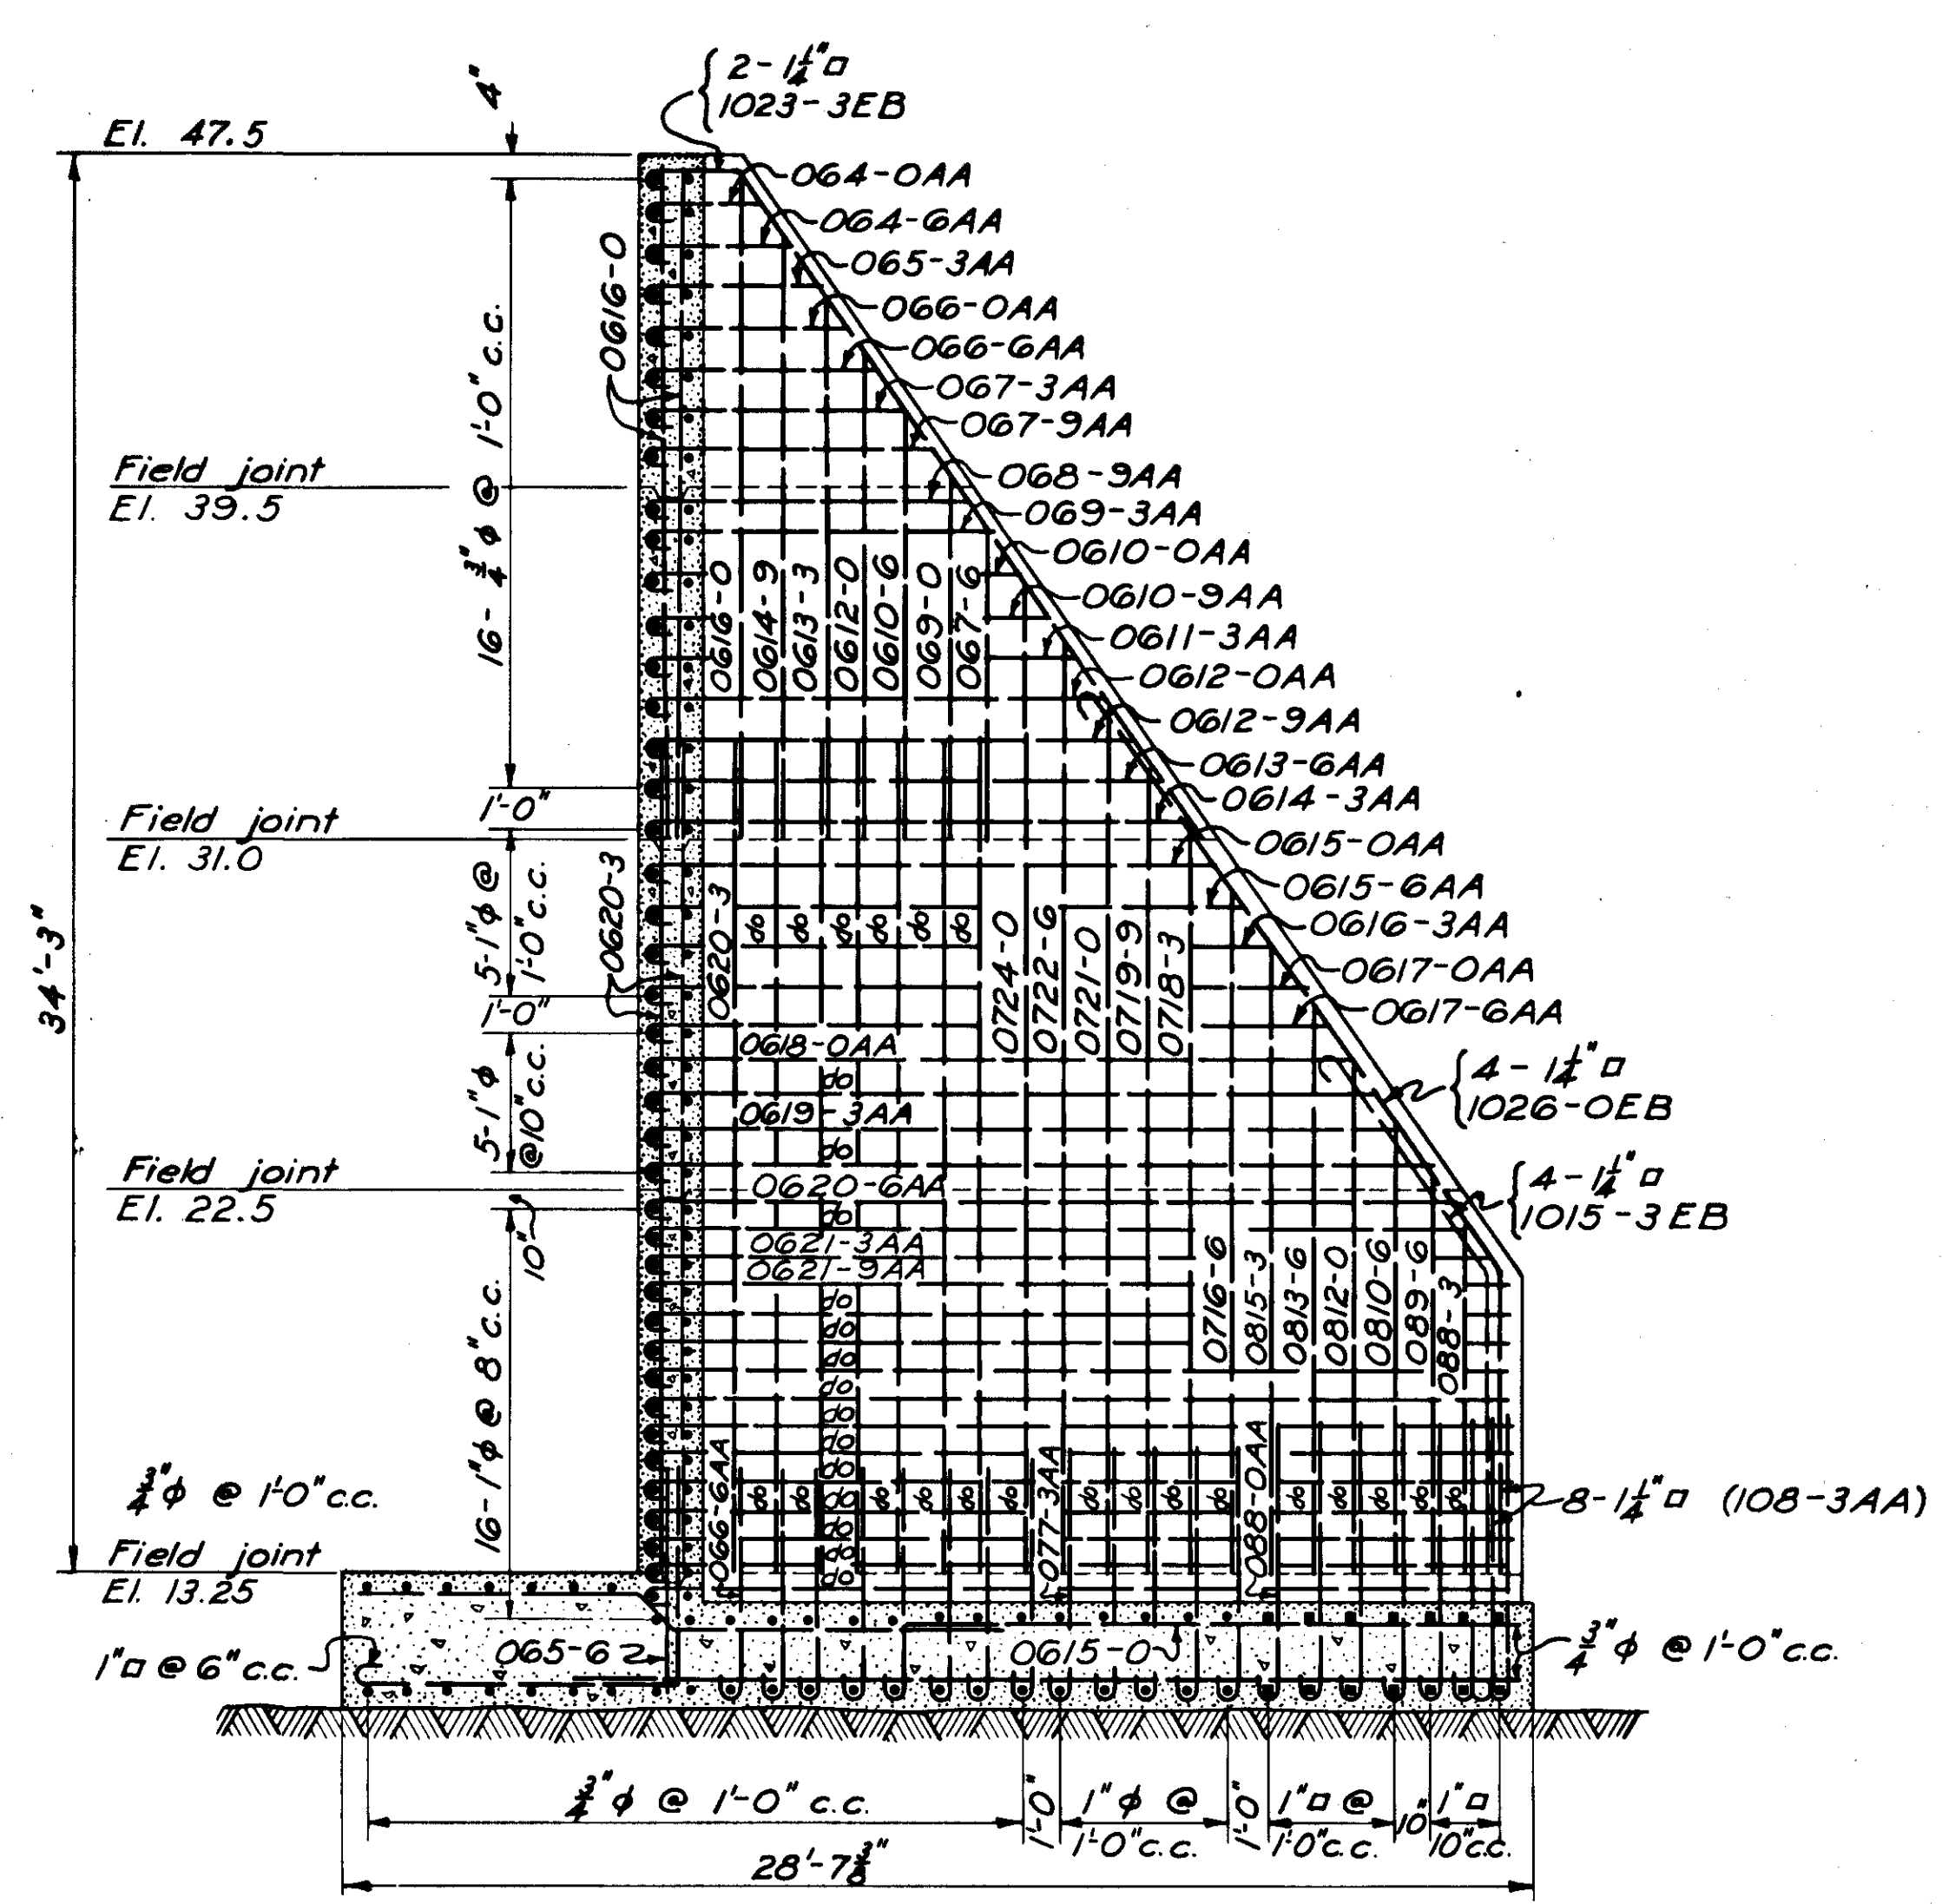

SECTION F 57

NOTES
For general notes applying to this sheet see Sheet No.60.

12/31/45	As-Built				
DATE	REVISION	REVBY	CK.BY	AP.BY	

CONNECTICUT RIVER FLOOD CONTROL
NORTH MEADOWS DIKE
FISCAL YEAR 1939 SECTION
R.R. STOP LOG STRUCTURE NO. 2
STEEL REINFORCEMENT NO. 5
HARTFORD, CONN.

CONNECTICUT RIVERCONNECTICUT
IN 66 SHEETSSCALE: 1/4 IN. = 1 FT.SHEET NO. 64

U. S. ENGINEER OFFICE, PROVIDENCE, R. I.,APRIL 1939

SUBMITTED:
Head, Design Section

APPROVAL RECOMMENDED:
Principal Engineer

APPROVED:
Lt. Col., Corps of Engineers
District Engineer

DESIGNED: J.C. Singall
ASSOC. ENGINEER

DRAWN: J.S.M.
TRACED: D.B.C.
CHECKED: W.S.J.

FILE NO. CT-4-1493