



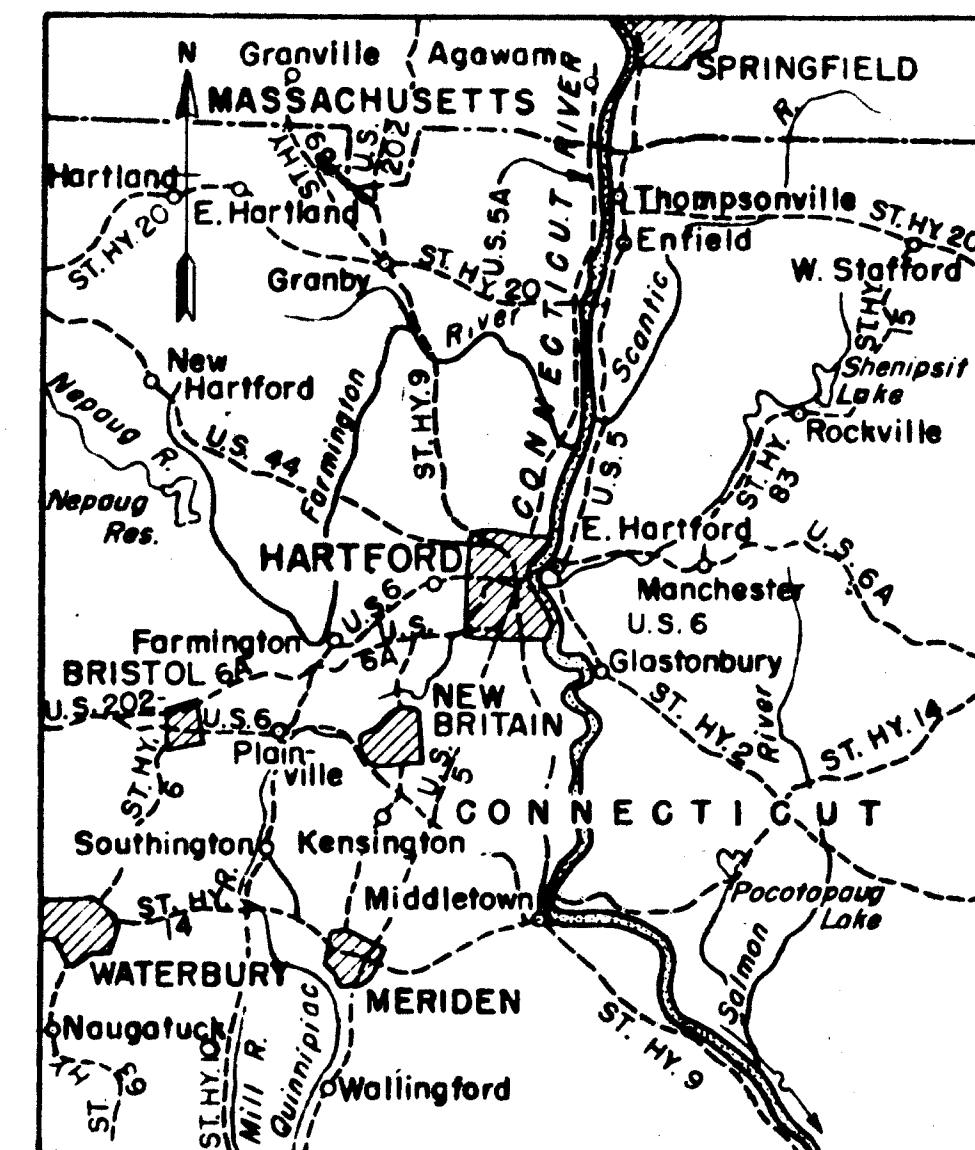

LOCATION MAP

SCALE 1 IN. = 8 Miles

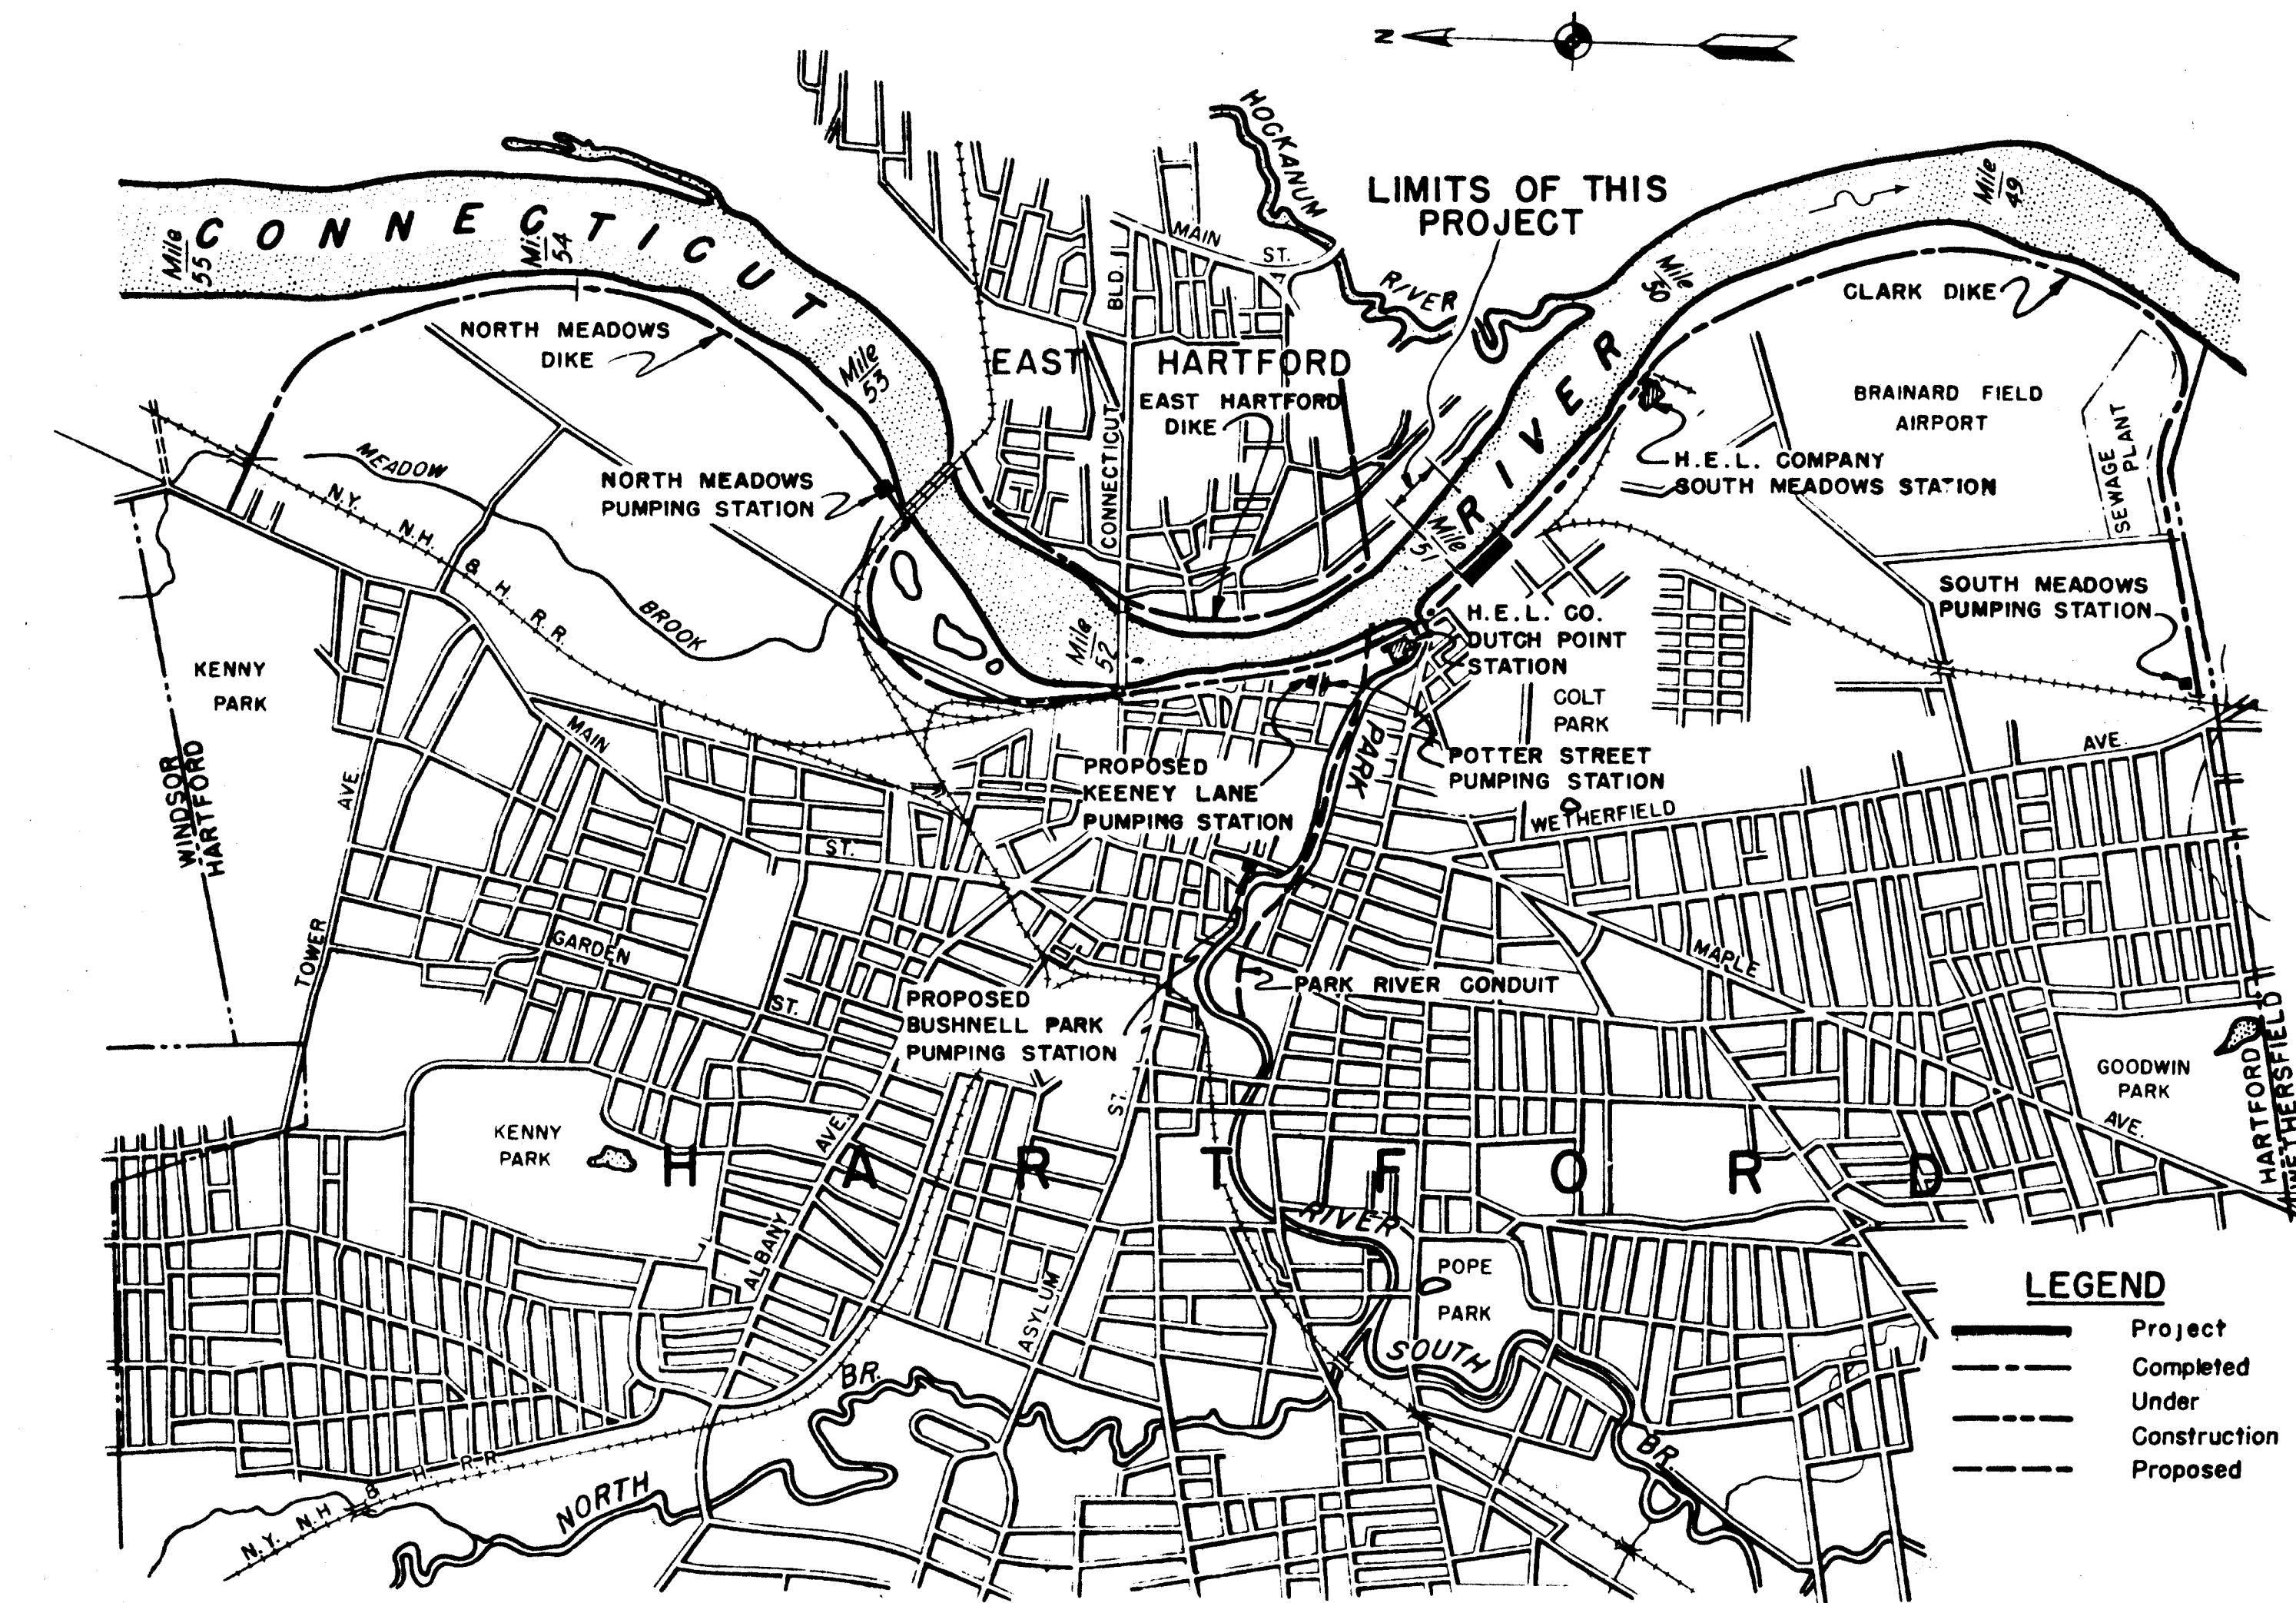

VICINITY MAP

LEGEND

- Project
- Completed
- Under Construction
- Proposed

INDEX TO DRAWINGS

SHEET NO.	DESCRIPTION	FILE NO.
1	PROJECT LOCATION AND INDEX	CT-4-3124
2	GENERAL PLAN	CT-4-3125
3	SECTIONS AND DETAILS	CT-4-3126
4	GEOLOGIC SECTION	CT-2-1336

KEY	DATE	REVISION	REV BY	CHK BY	AP BY
	12/31/45	As-Built			

CONNECTICUT RIVER FLOOD CONTROL
HARTFORD DIKE
RECONSTRUCTION AT SLIDE STA. 44+45.68 TO STA. 65+00
FOUNDATION DRAIN WELLS STA. 52+30± TO STA. 60+10±
(HIRED LABOR)
PROJECT LOCATION AND INDEX
CONNECTICUT RIVER
IN 4 SHEETS
SCALE 1 IN. = 2000 FT.
2000' 0 2000 4000
SHEET NO. 1
U.S. ENGINEER OFFICE, PROVIDENCE, R.I., JAN. 1942
SUBMITTED BY: J. C. S. [Signature] APPROVED: J. C. S. [Signature]
DESIGNED BY: J. C. S. [Signature] TRACED: M.L. [Signature]
CHECKED: M.L. [Signature] FILE NO. CT-4-3124