
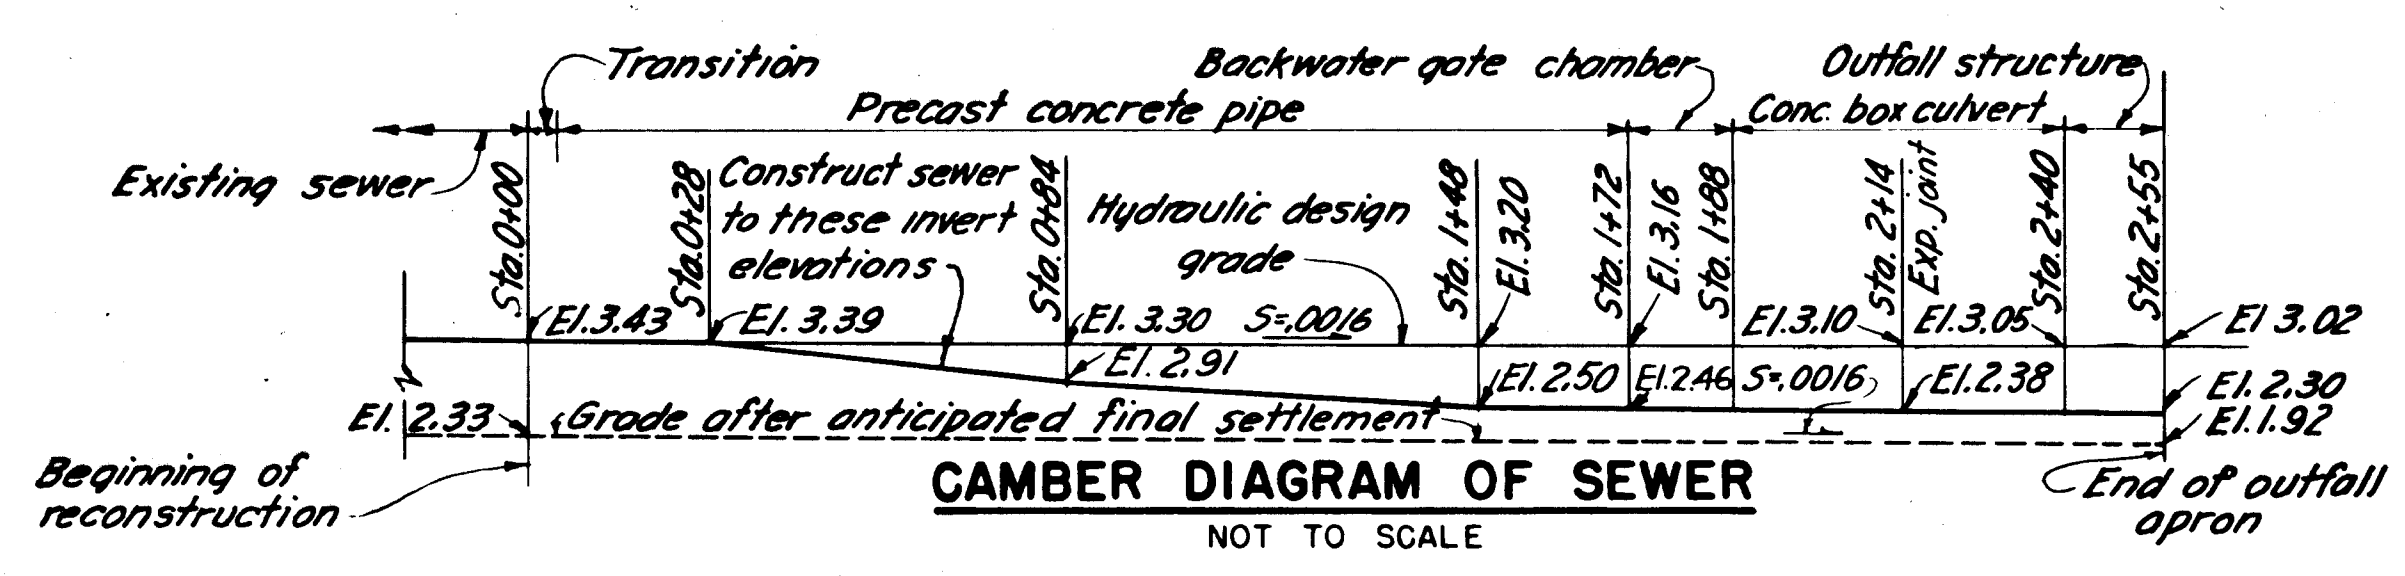
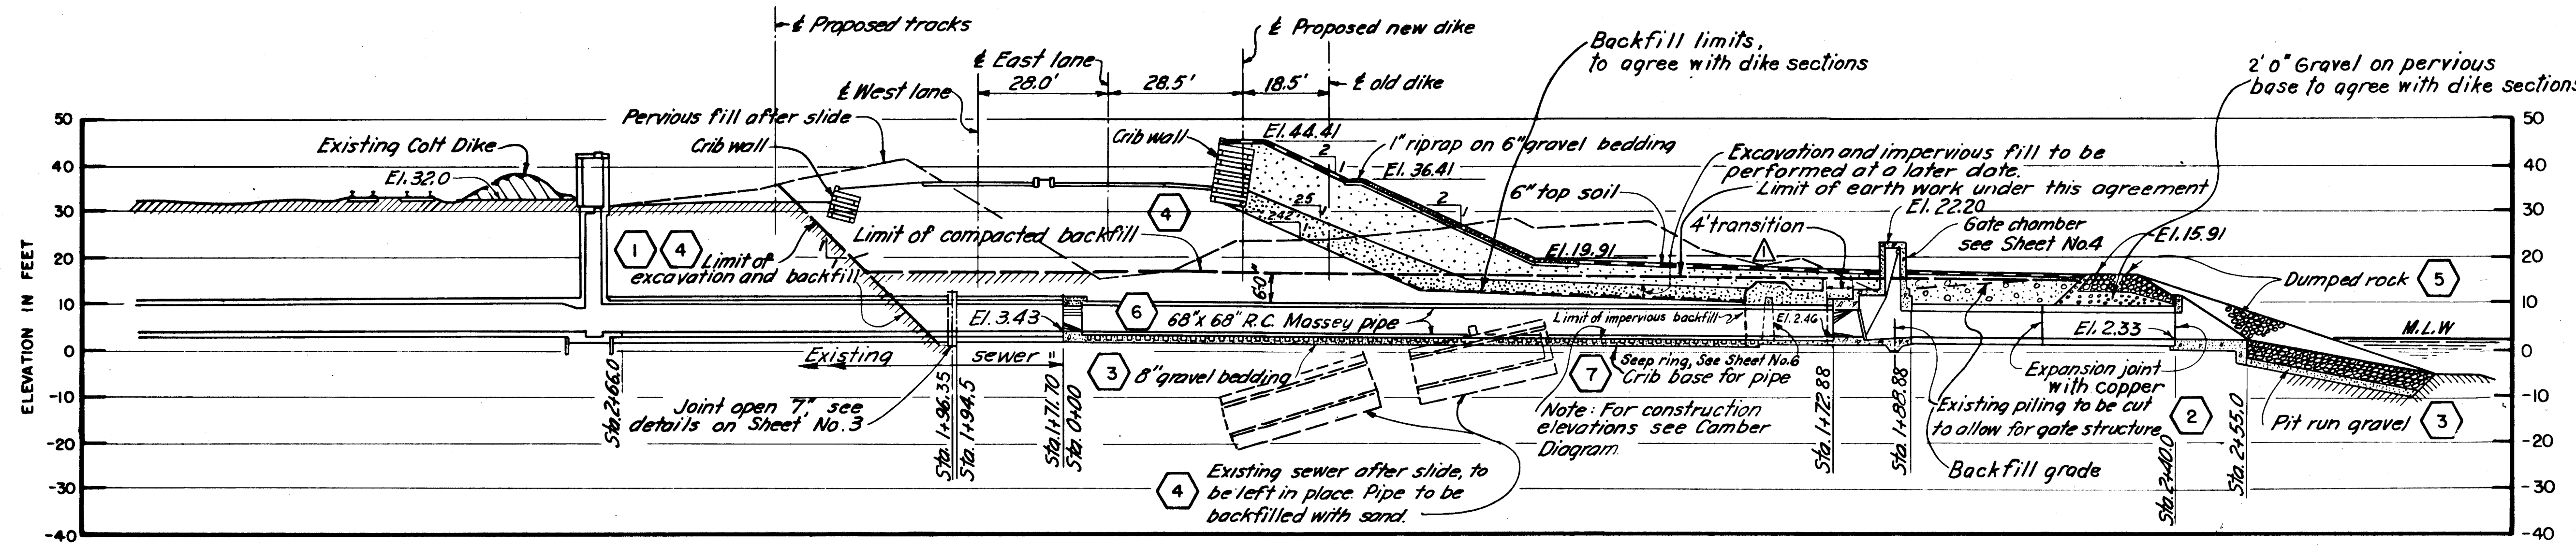


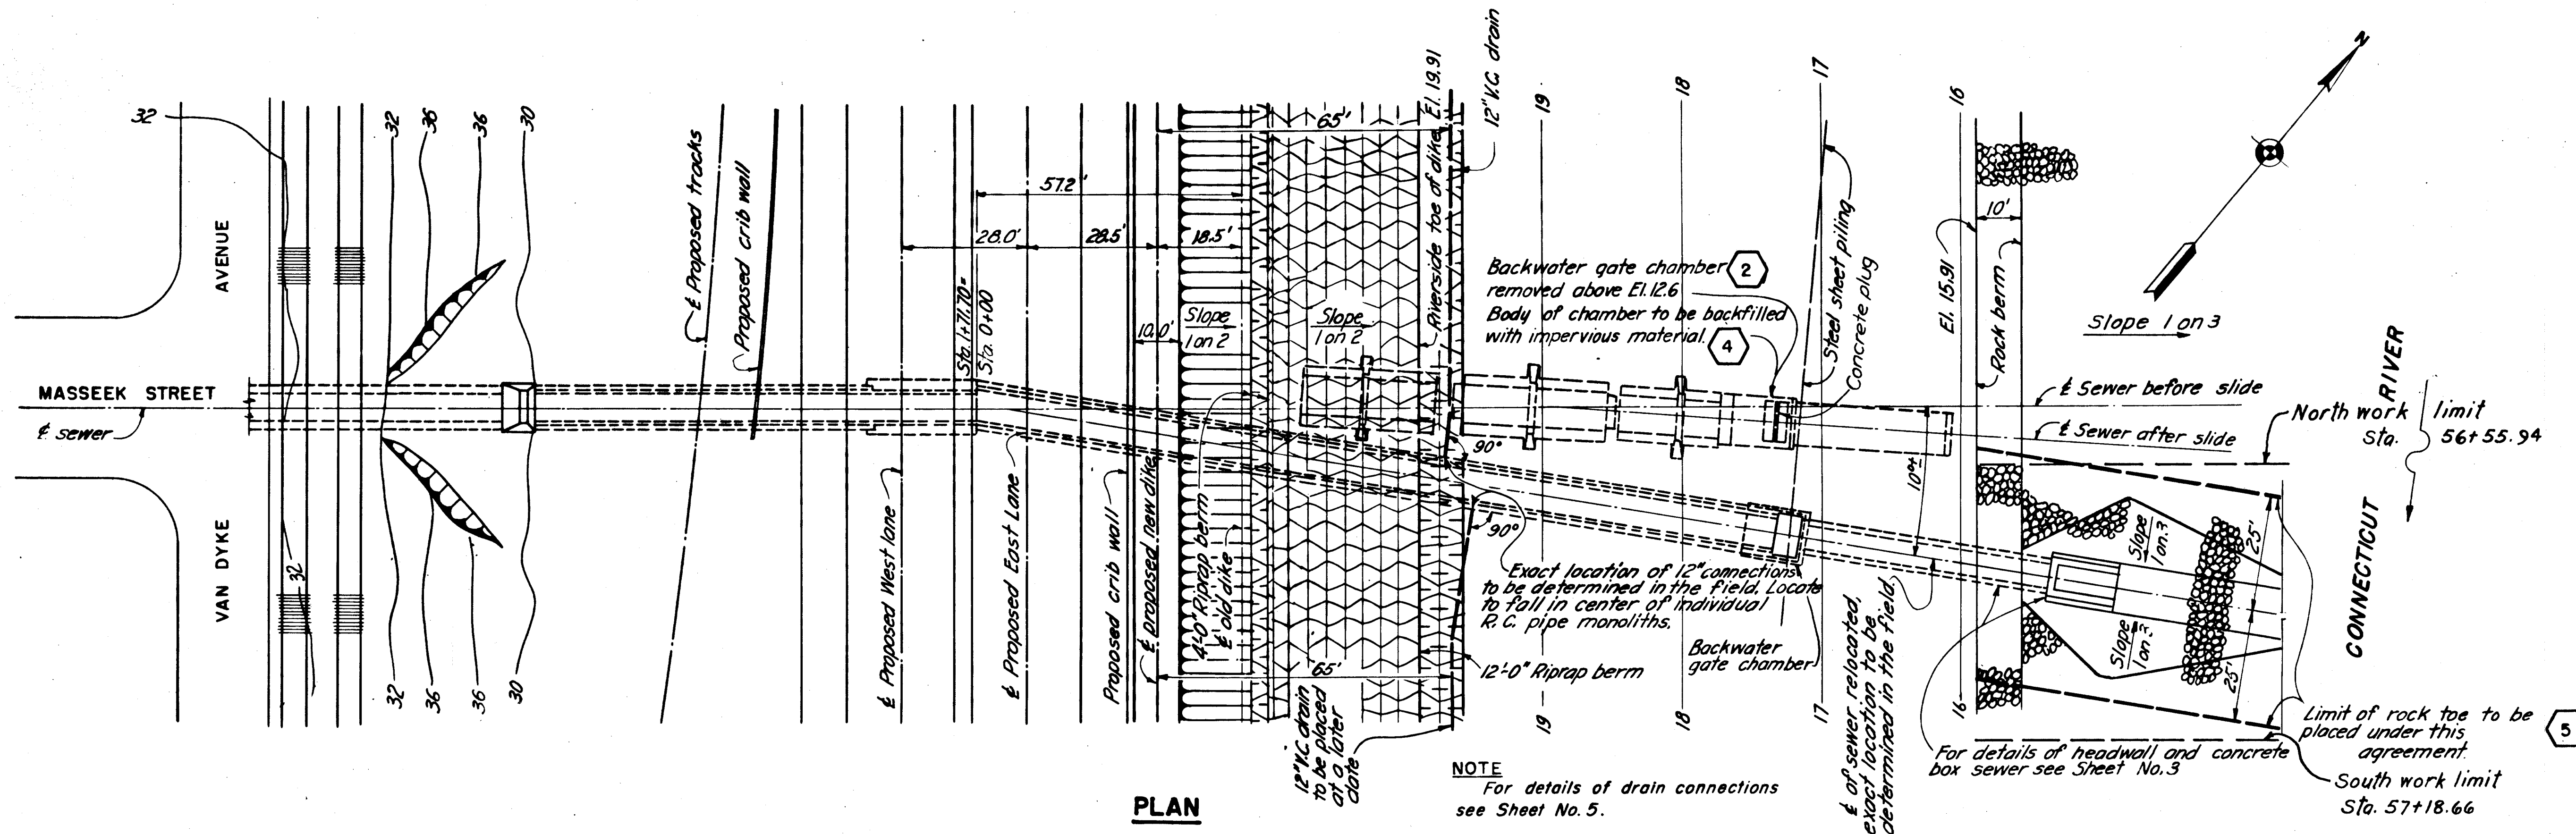

CONNECTICUT RIVER FLOOD CONTROL
HARTFORD DIKE
 SUPPLEMENTAL AGREEMENT
 RECONSTRUCTION OF MASSEK STREET SEWER
 PLAN AND PROFILE

CONNECTICUT RIVER
 IN 6 SHEETS
 SCALE 1 IN. = 20 FT.
 SHEET NO. 2

U.S. ENGINEER OFFICE, PROVIDENCE, R.I., DEC. 1941

APPROVED: *[Signature]*
 SENIOR ENGINEER
 HEAD DESIGN SECTION

RECOMMENDED: *[Signature]*
 PRINCIPAL ENGINEER
 CHIEF, ENGINEERING DIV.

DESIGN SECTION: *[Signature]*
 ASSOC. ENGINEER

DRAWN: C. W. H.
 TRACED: M. H. L.
 CHECKED: E. P. C.

FILE NO. CT-4-3062

KEY	DATE	REVISION (Indicated by Δ)	REV. BY	OK. BY	AP. BY
	12/5/41	As built revisions			
Δ	2/6/42	Seep ring added.	P.C.H.	M.S.	M.W.