
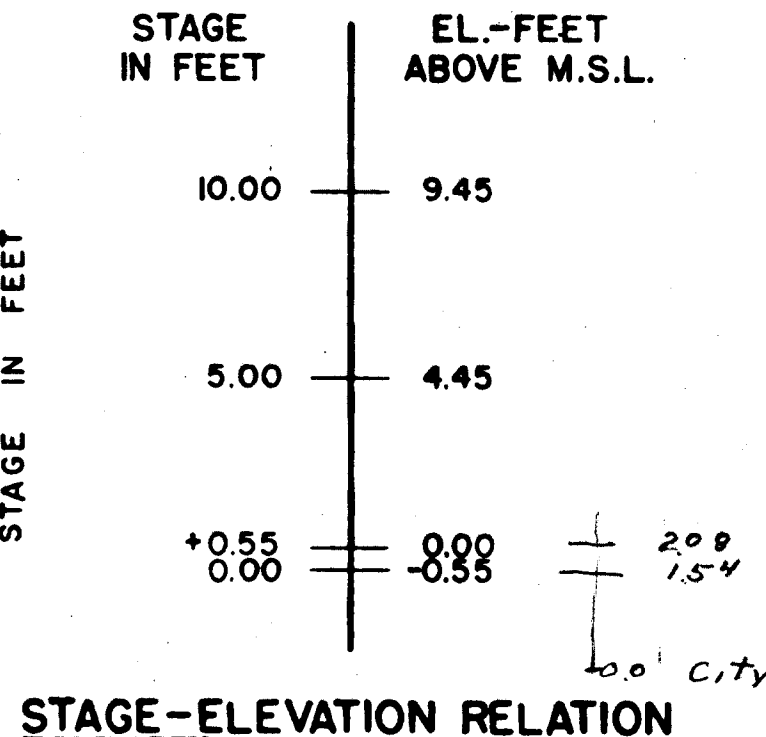
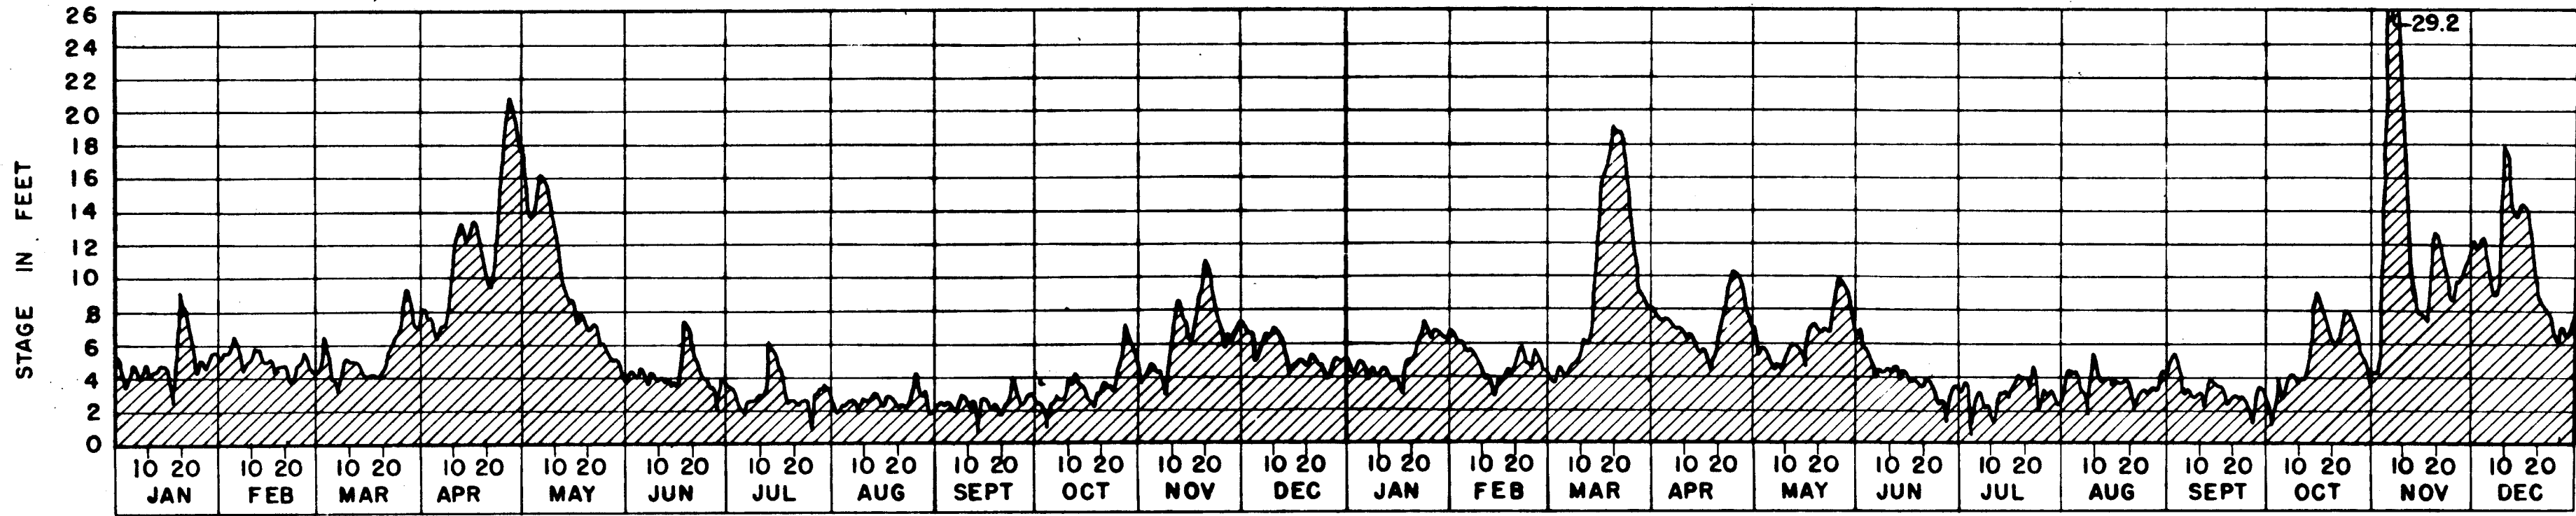
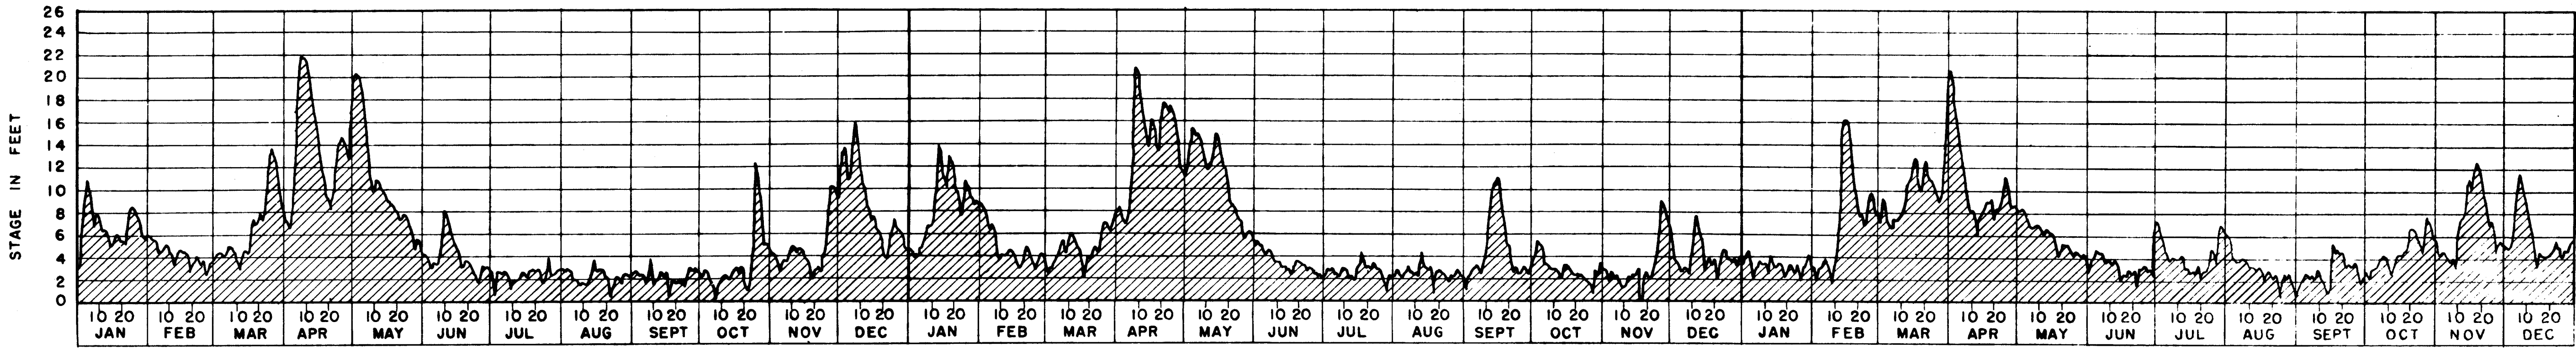
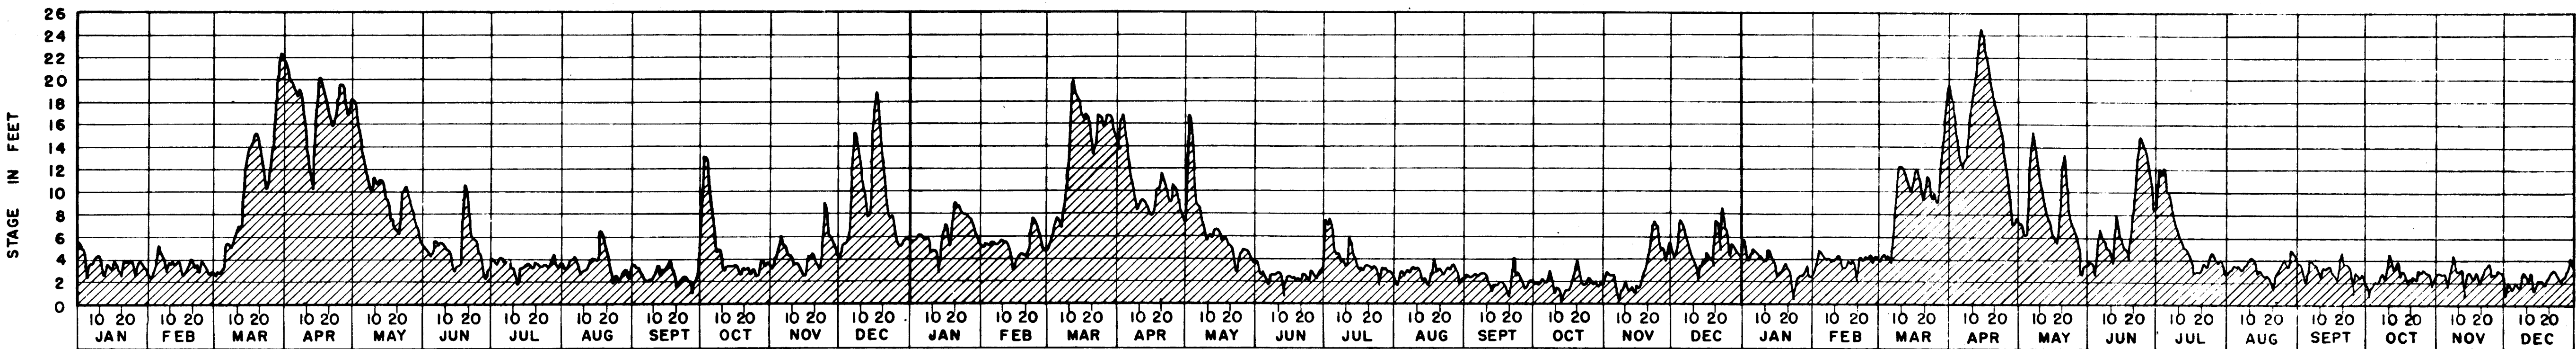


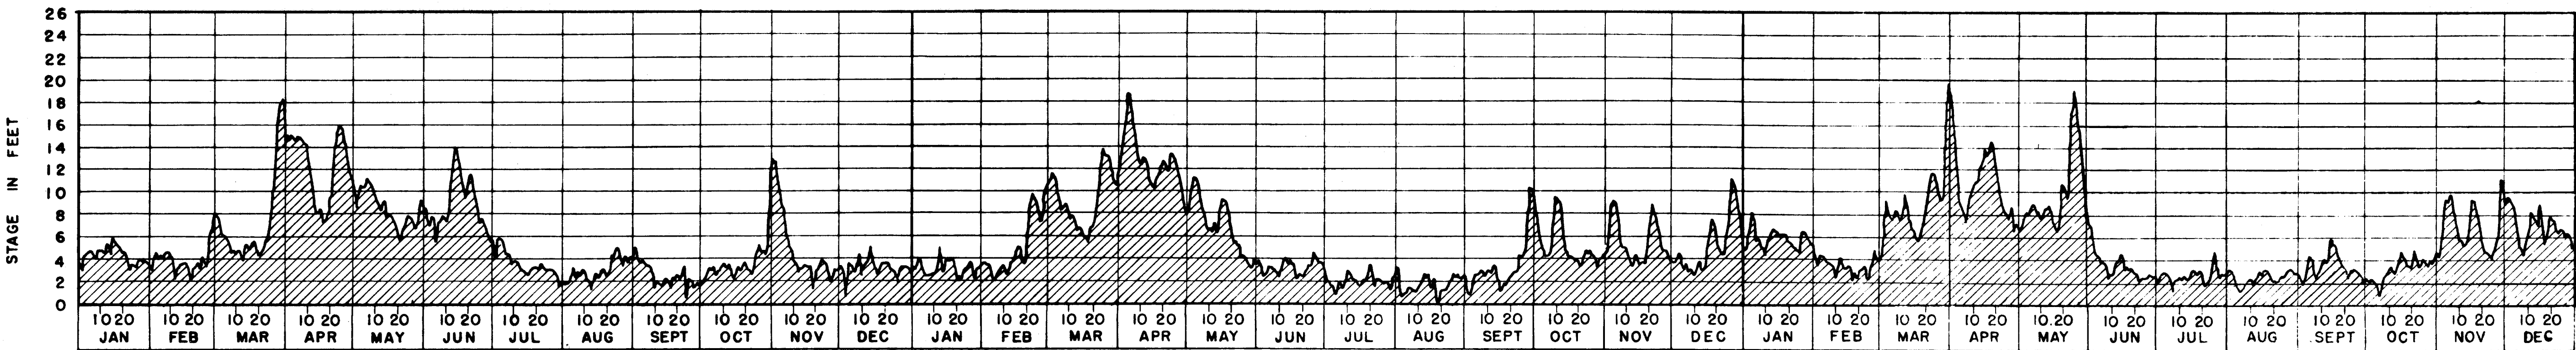

NOTES:  
Low stages are subject to tidal fluctuation which has a mean amplitude 0 at a stage of 7 feet and 1.5 feet at a stage of 2 feet.  
Stage readings on Hartford Gage, zero = -0.55 M.S.L.  
Data supplied by U. S. Weather Bureau.  
Gage located on downstream side of Memorial Bridge (Connecticut Boulevard).

|                                                   |                              |
|---------------------------------------------------|------------------------------|
| CONNECTICUT RIVER FLOOD CONTROL                   |                              |
| HARTFORD DIKE                                     |                              |
| RIVERFRONT, MORGAN ST. TO STA. 96+73              |                              |
| HYDROGRAPHS NO. 1                                 |                              |
| CONNECTICUT RIVER                                 | CONNECTICUT                  |
| IN 135 SHEETS                                     | SHEET NO. 3                  |
| U.S. ENGINEER OFFICE, PROVIDENCE, R. I., MAY 1940 |                              |
| SUBMITTED: <i>John P. Smith</i>                   | APPROVAL: <i>W. J. Smith</i> |
| HEAD, HYDRAULICS SECTION                          | PRINCIPAL ENGINEER           |
| COMPILED: <i>Charles H. Smith</i>                 | TRACED BY: P. J. G.          |
| ASSOC. ENGINEER                                   | CHECKED BY: <i>W. C. G.</i>  |
| FISCAL YEAR 1940                                  |                              |
| FILE NO. CT-3-1171                                |                              |

|          |          |         |        |        |  |
|----------|----------|---------|--------|--------|--|
| 12-31-45 | As Built |         |        |        |  |
| DATE     | REVISION | REV. BY | CK. BY | AP. BY |  |