



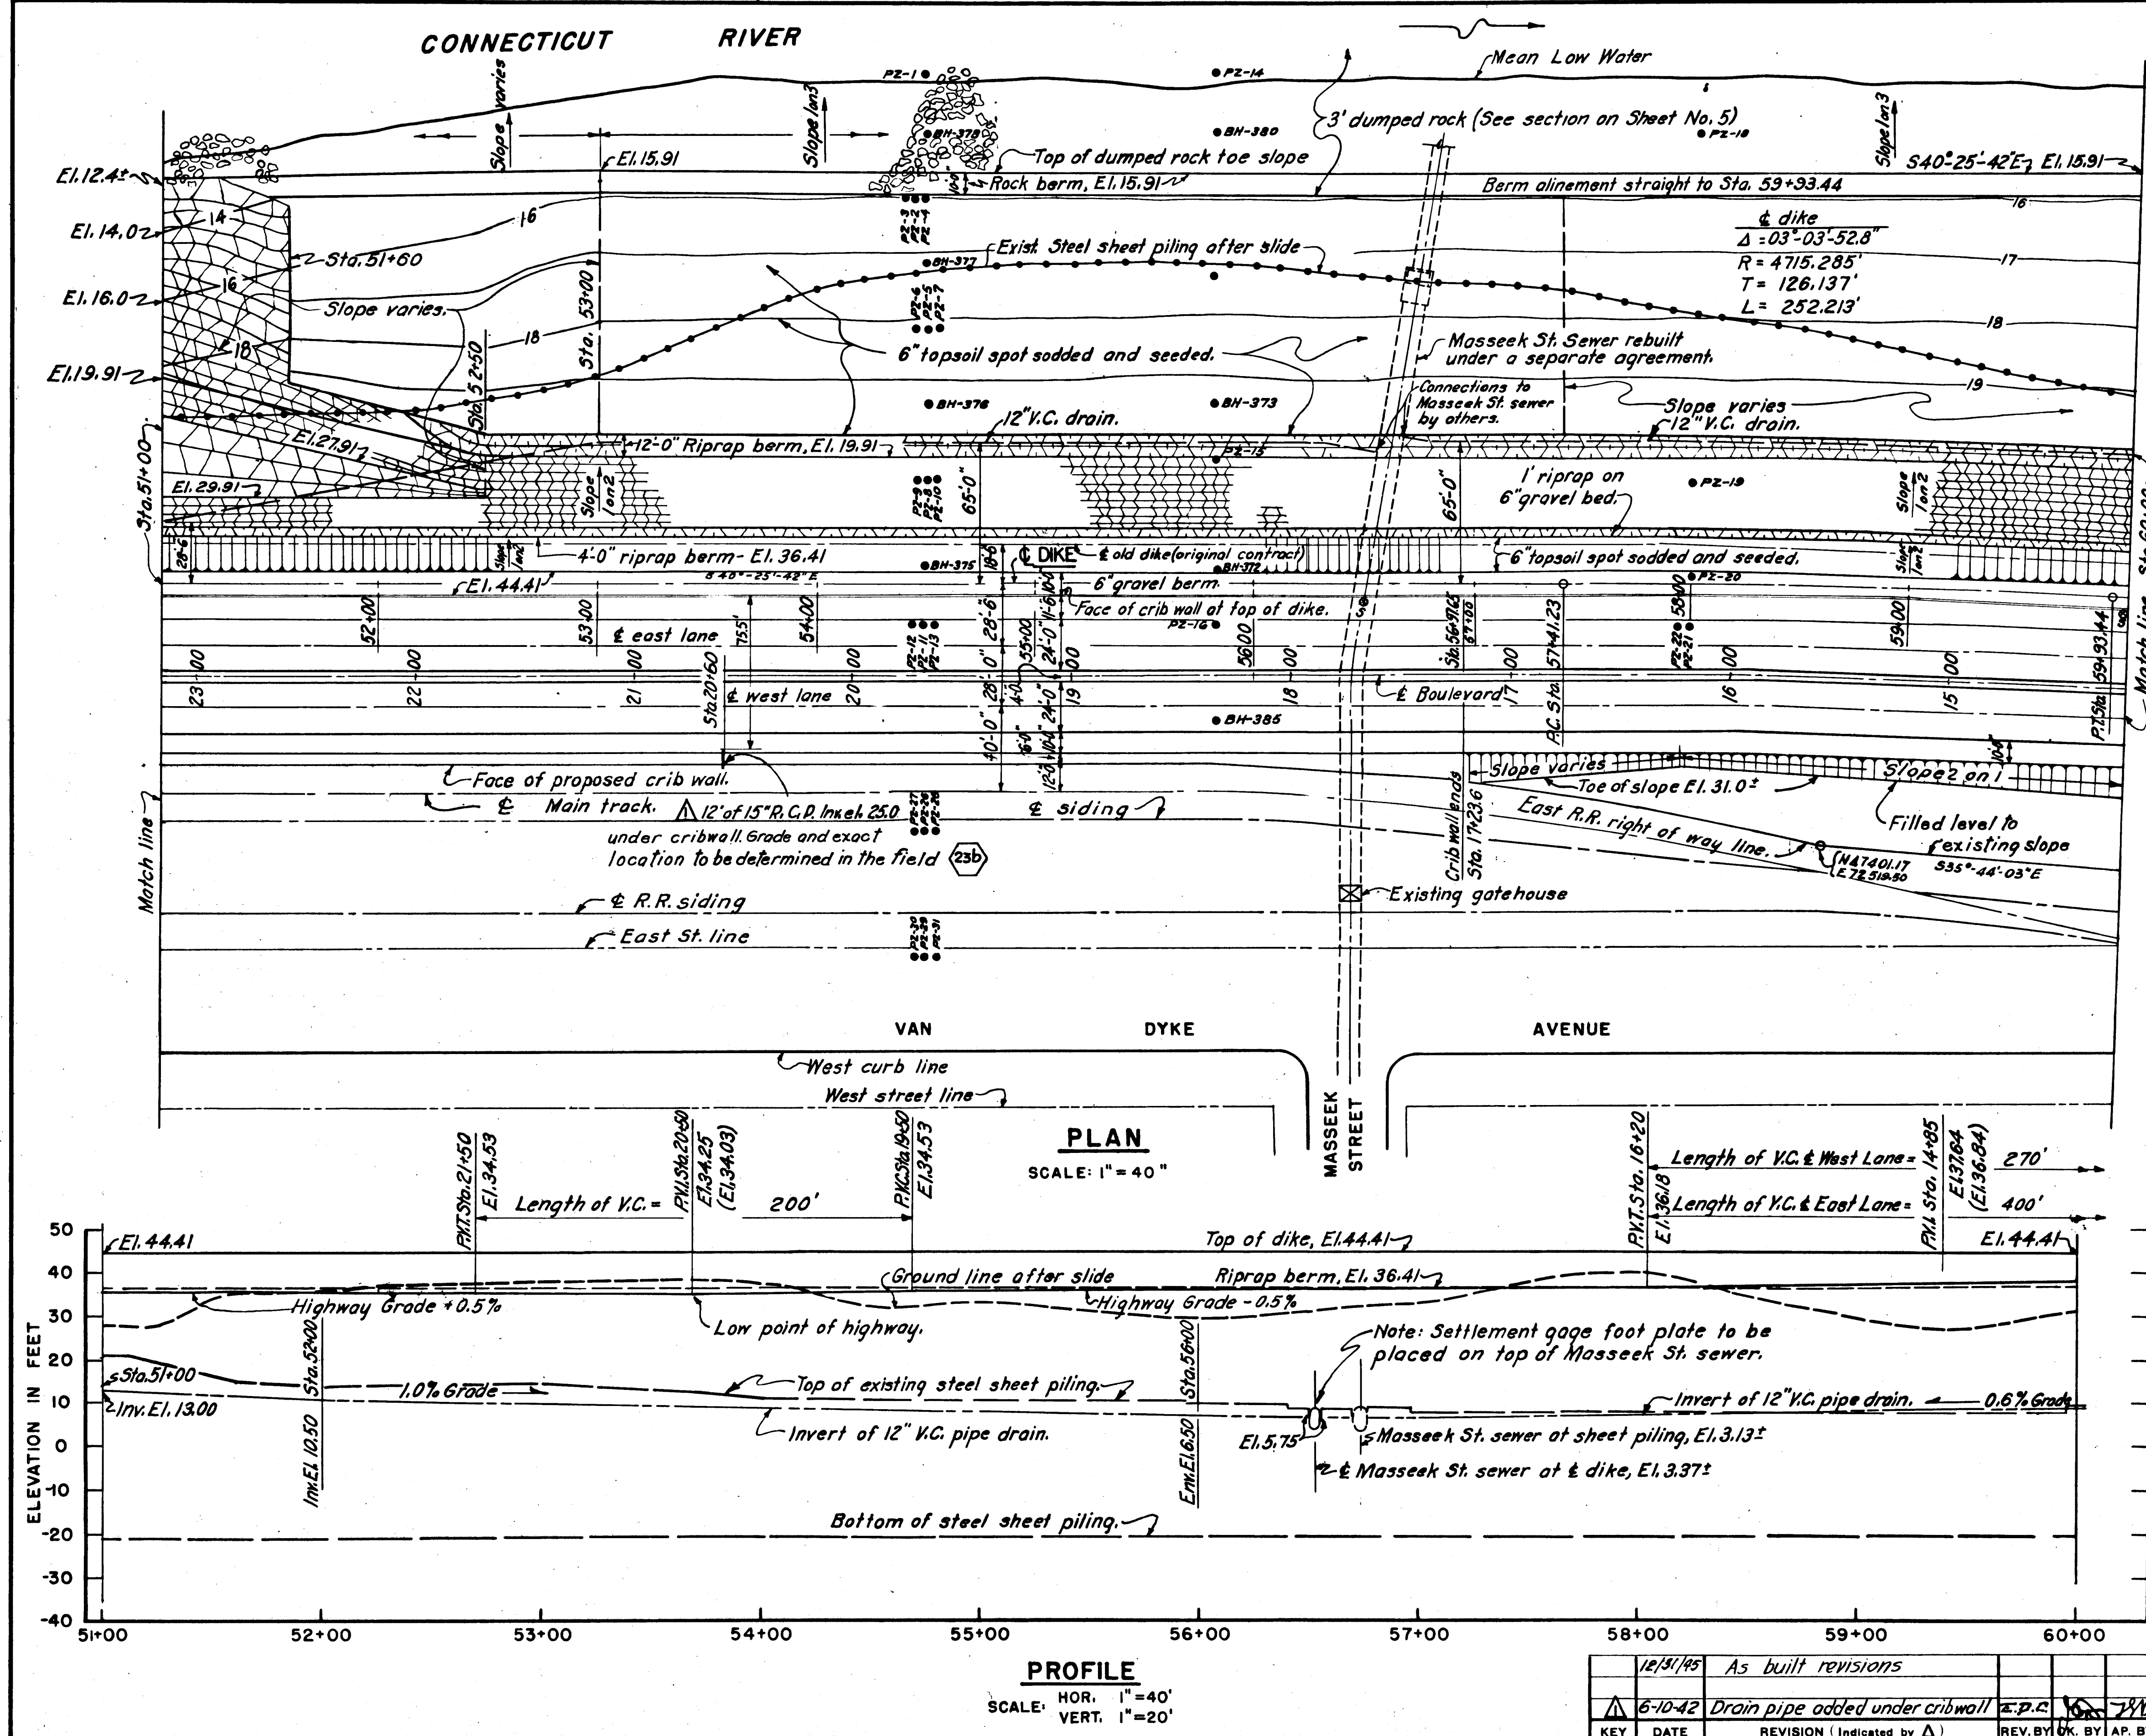

STATION COORDINATES		
STATION	NORTHINGS	EASTINGS
P.C. Sta. 57+41.23	N 47568.11	E 72537.27
P.T. Sta. 59+93.44	N 47371.84	E 72695.62

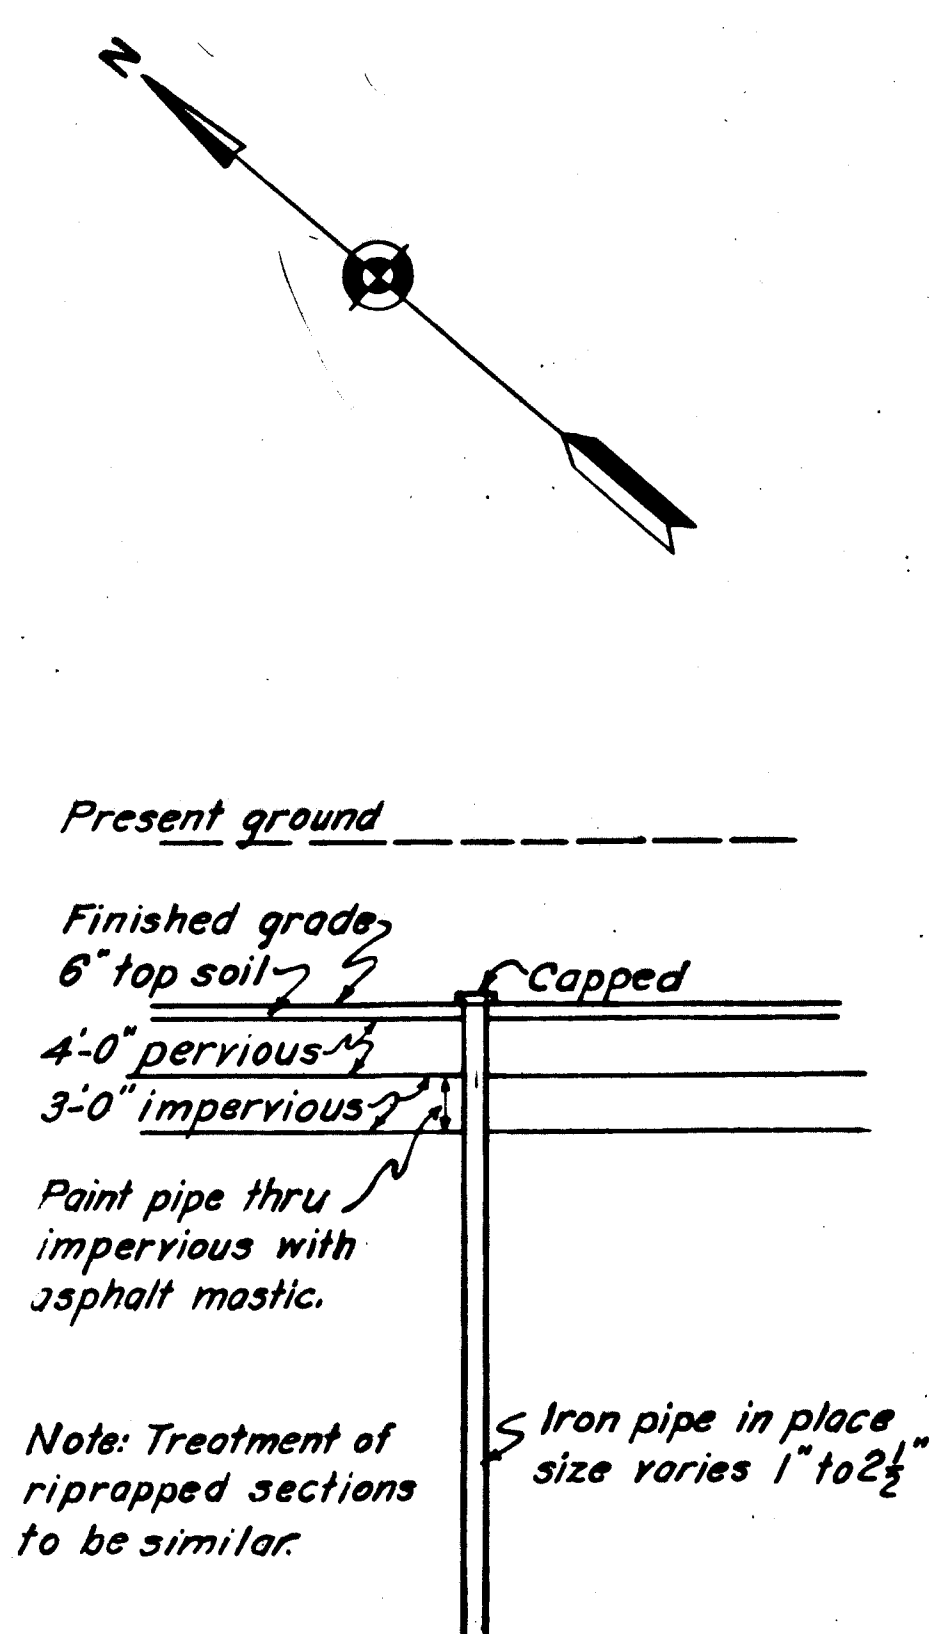

TYPICAL TREATMENT AT EXISTING PIEZOMETERS

NOT TO SCALE

NOTES:

For general notes see Sheet No. 2.

All elevations refer to Mean Sea Level Datum.

• (PZ) or • (BH) location of piezometers installed by the United States to be protected during operations. Necessary work around piezometers to be paid for under Item No. 21.

§ Settlement gage.

CONNECTICUT RIVER FLOOD CONTROL

HARTFORD DIKE

SUPPLEMENTAL AGREEMENT

RECONSTRUCTION AT SLIDE STA. 44+45.68 TO STA. 65.00

PLAN AND PROFILE NO. 2

CONNECTICUT RIVER

CONNECTICUT

IN 7 SHEETS SCALE: 1 IN. = 40 FT. SHEET NO. 3

U.S. ENGINEER OFFICE, PROVIDENCE, R.I., MARCH 1942

DESIGNED: P.C. Hameen, ASSOC. ENGINEER

DRAWN: L.A.O. - D.W.C.

TRACED: B.J.P.

CHECKED: S.P.C.

FILE NO. CT-4-3057

12/31/45 As built revisions

6-10-42 Drain pipe added under cribwall

REVISION (Indicated by Δ)

REV. BY

OK BY

AP. BY