

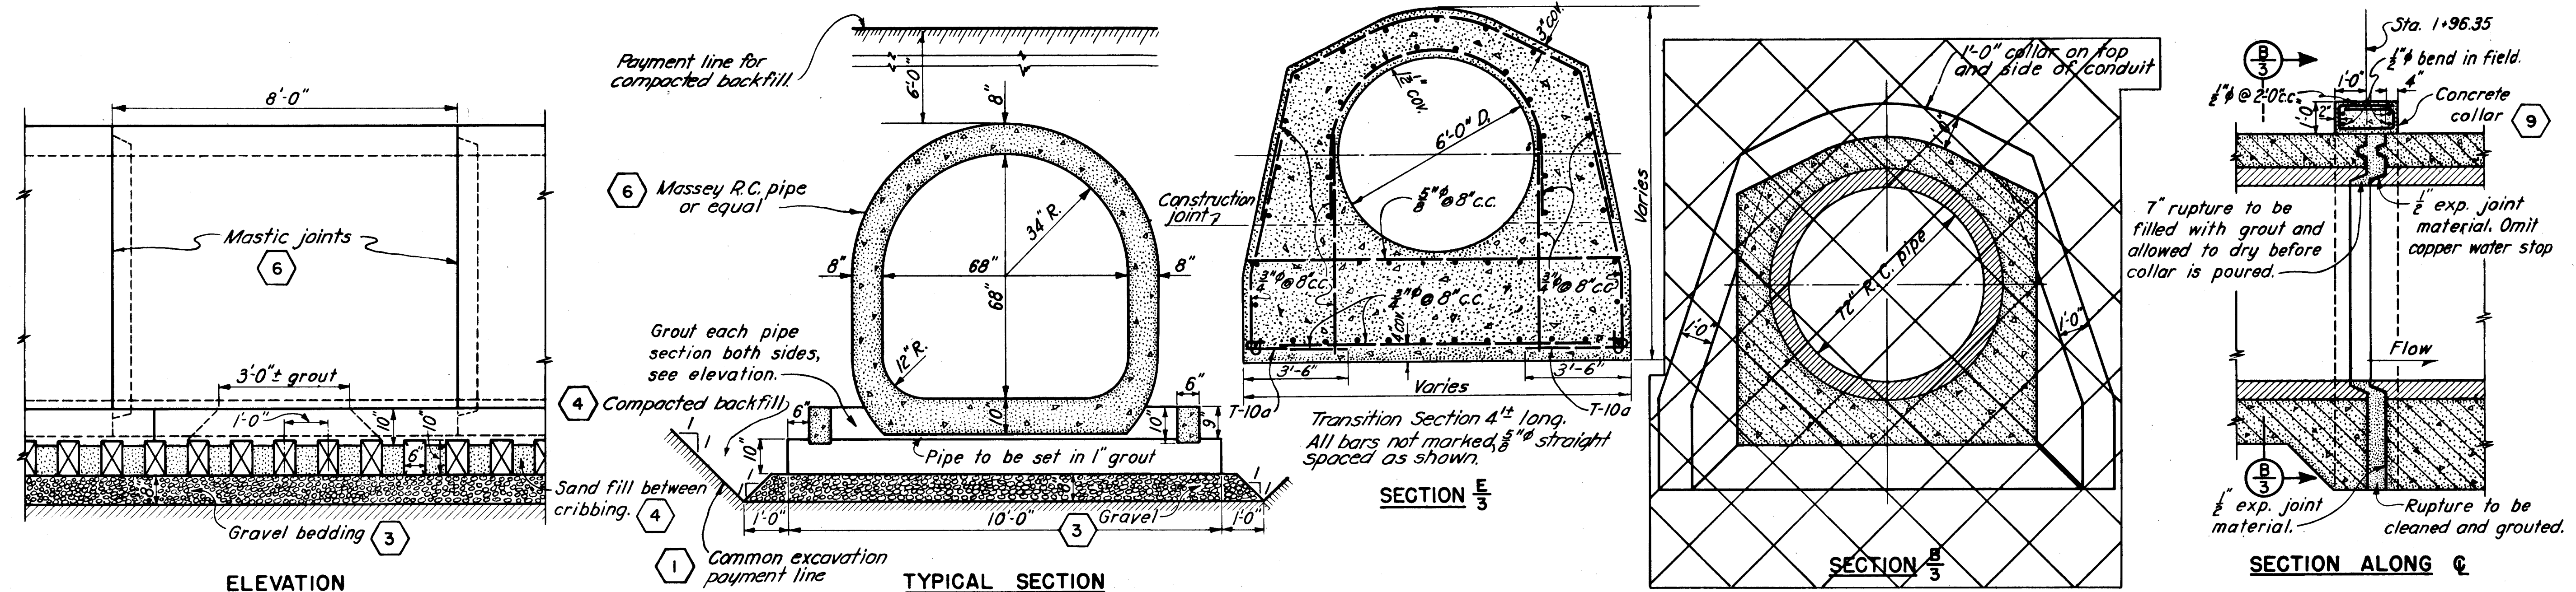
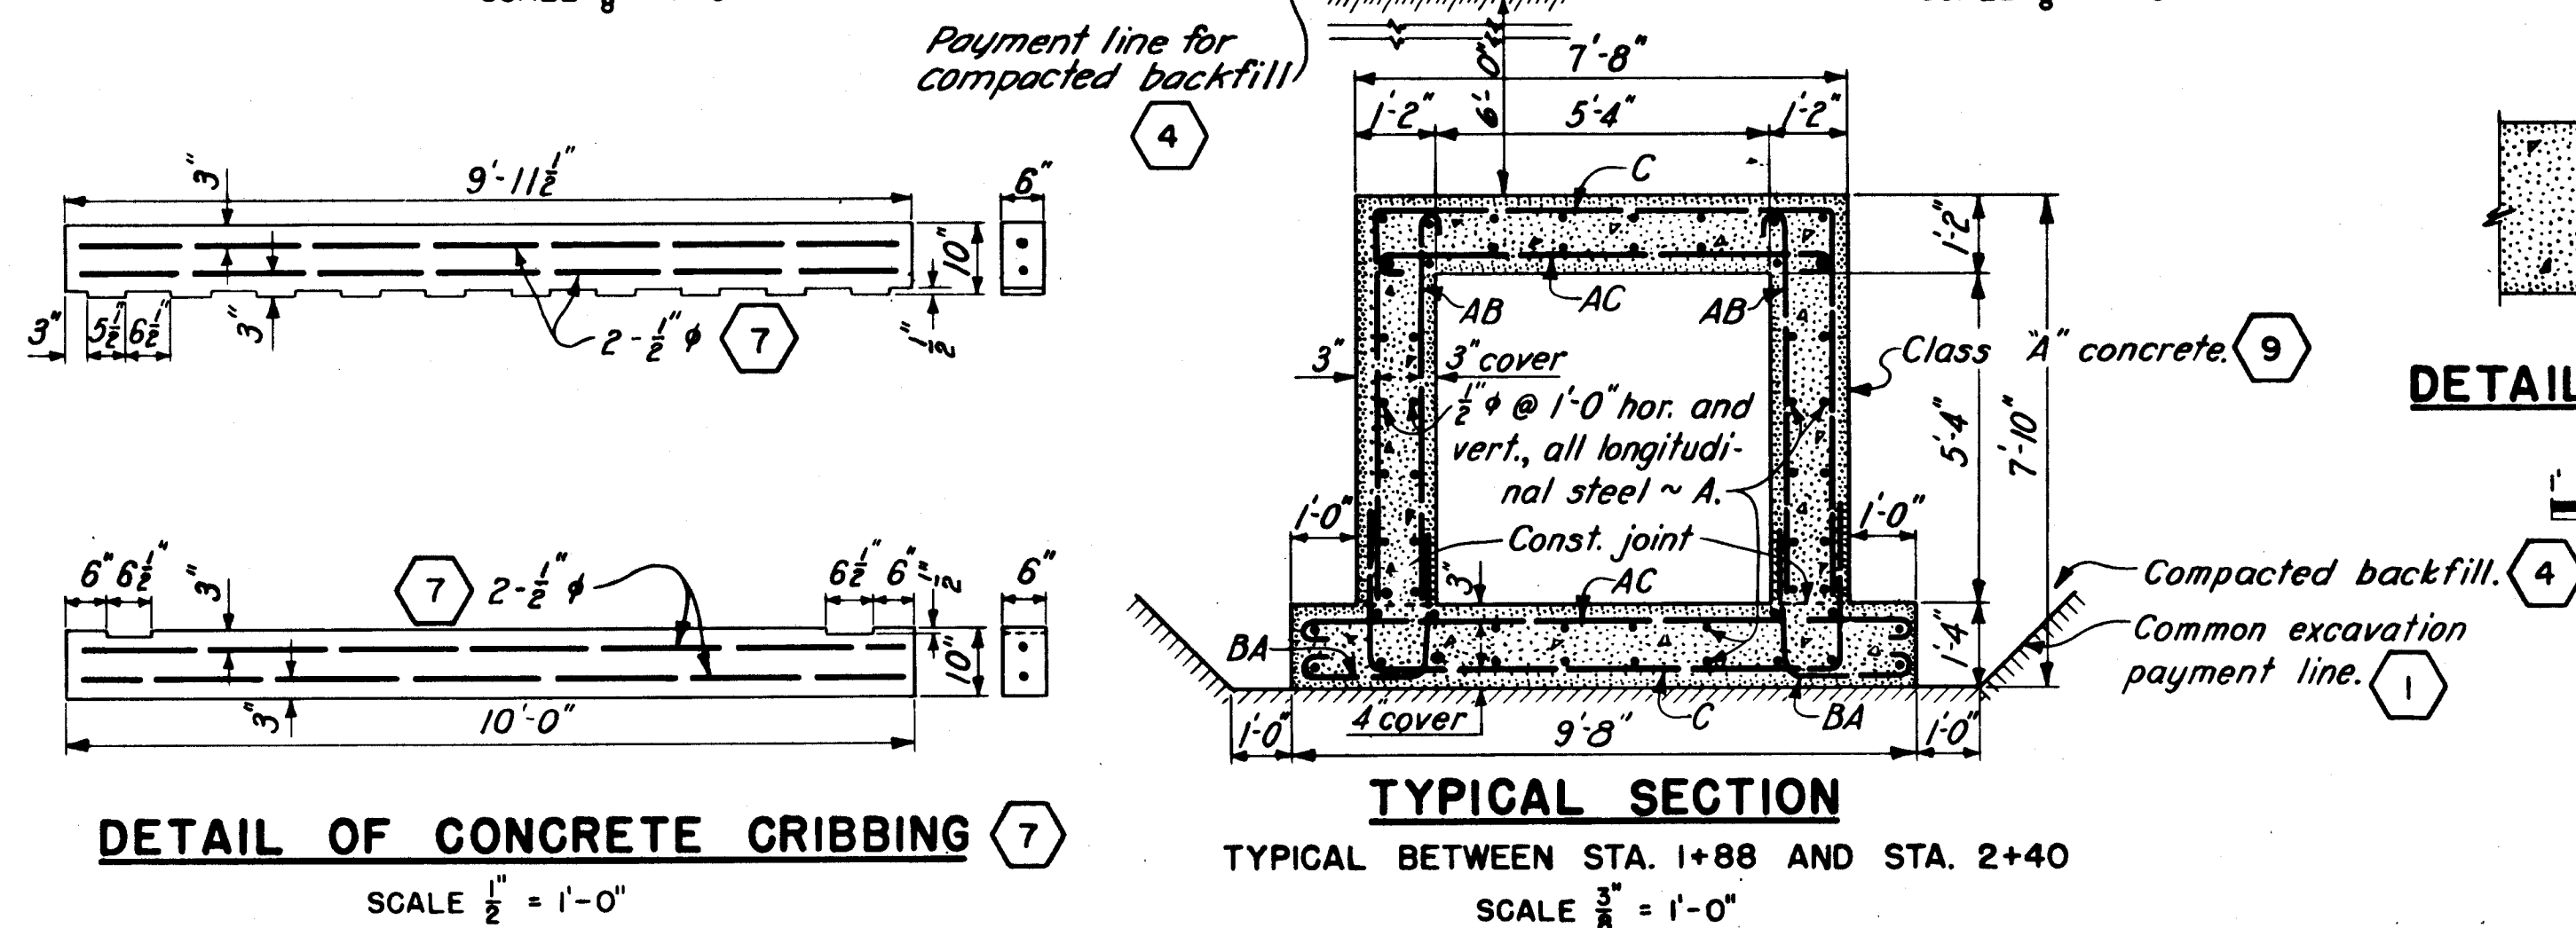


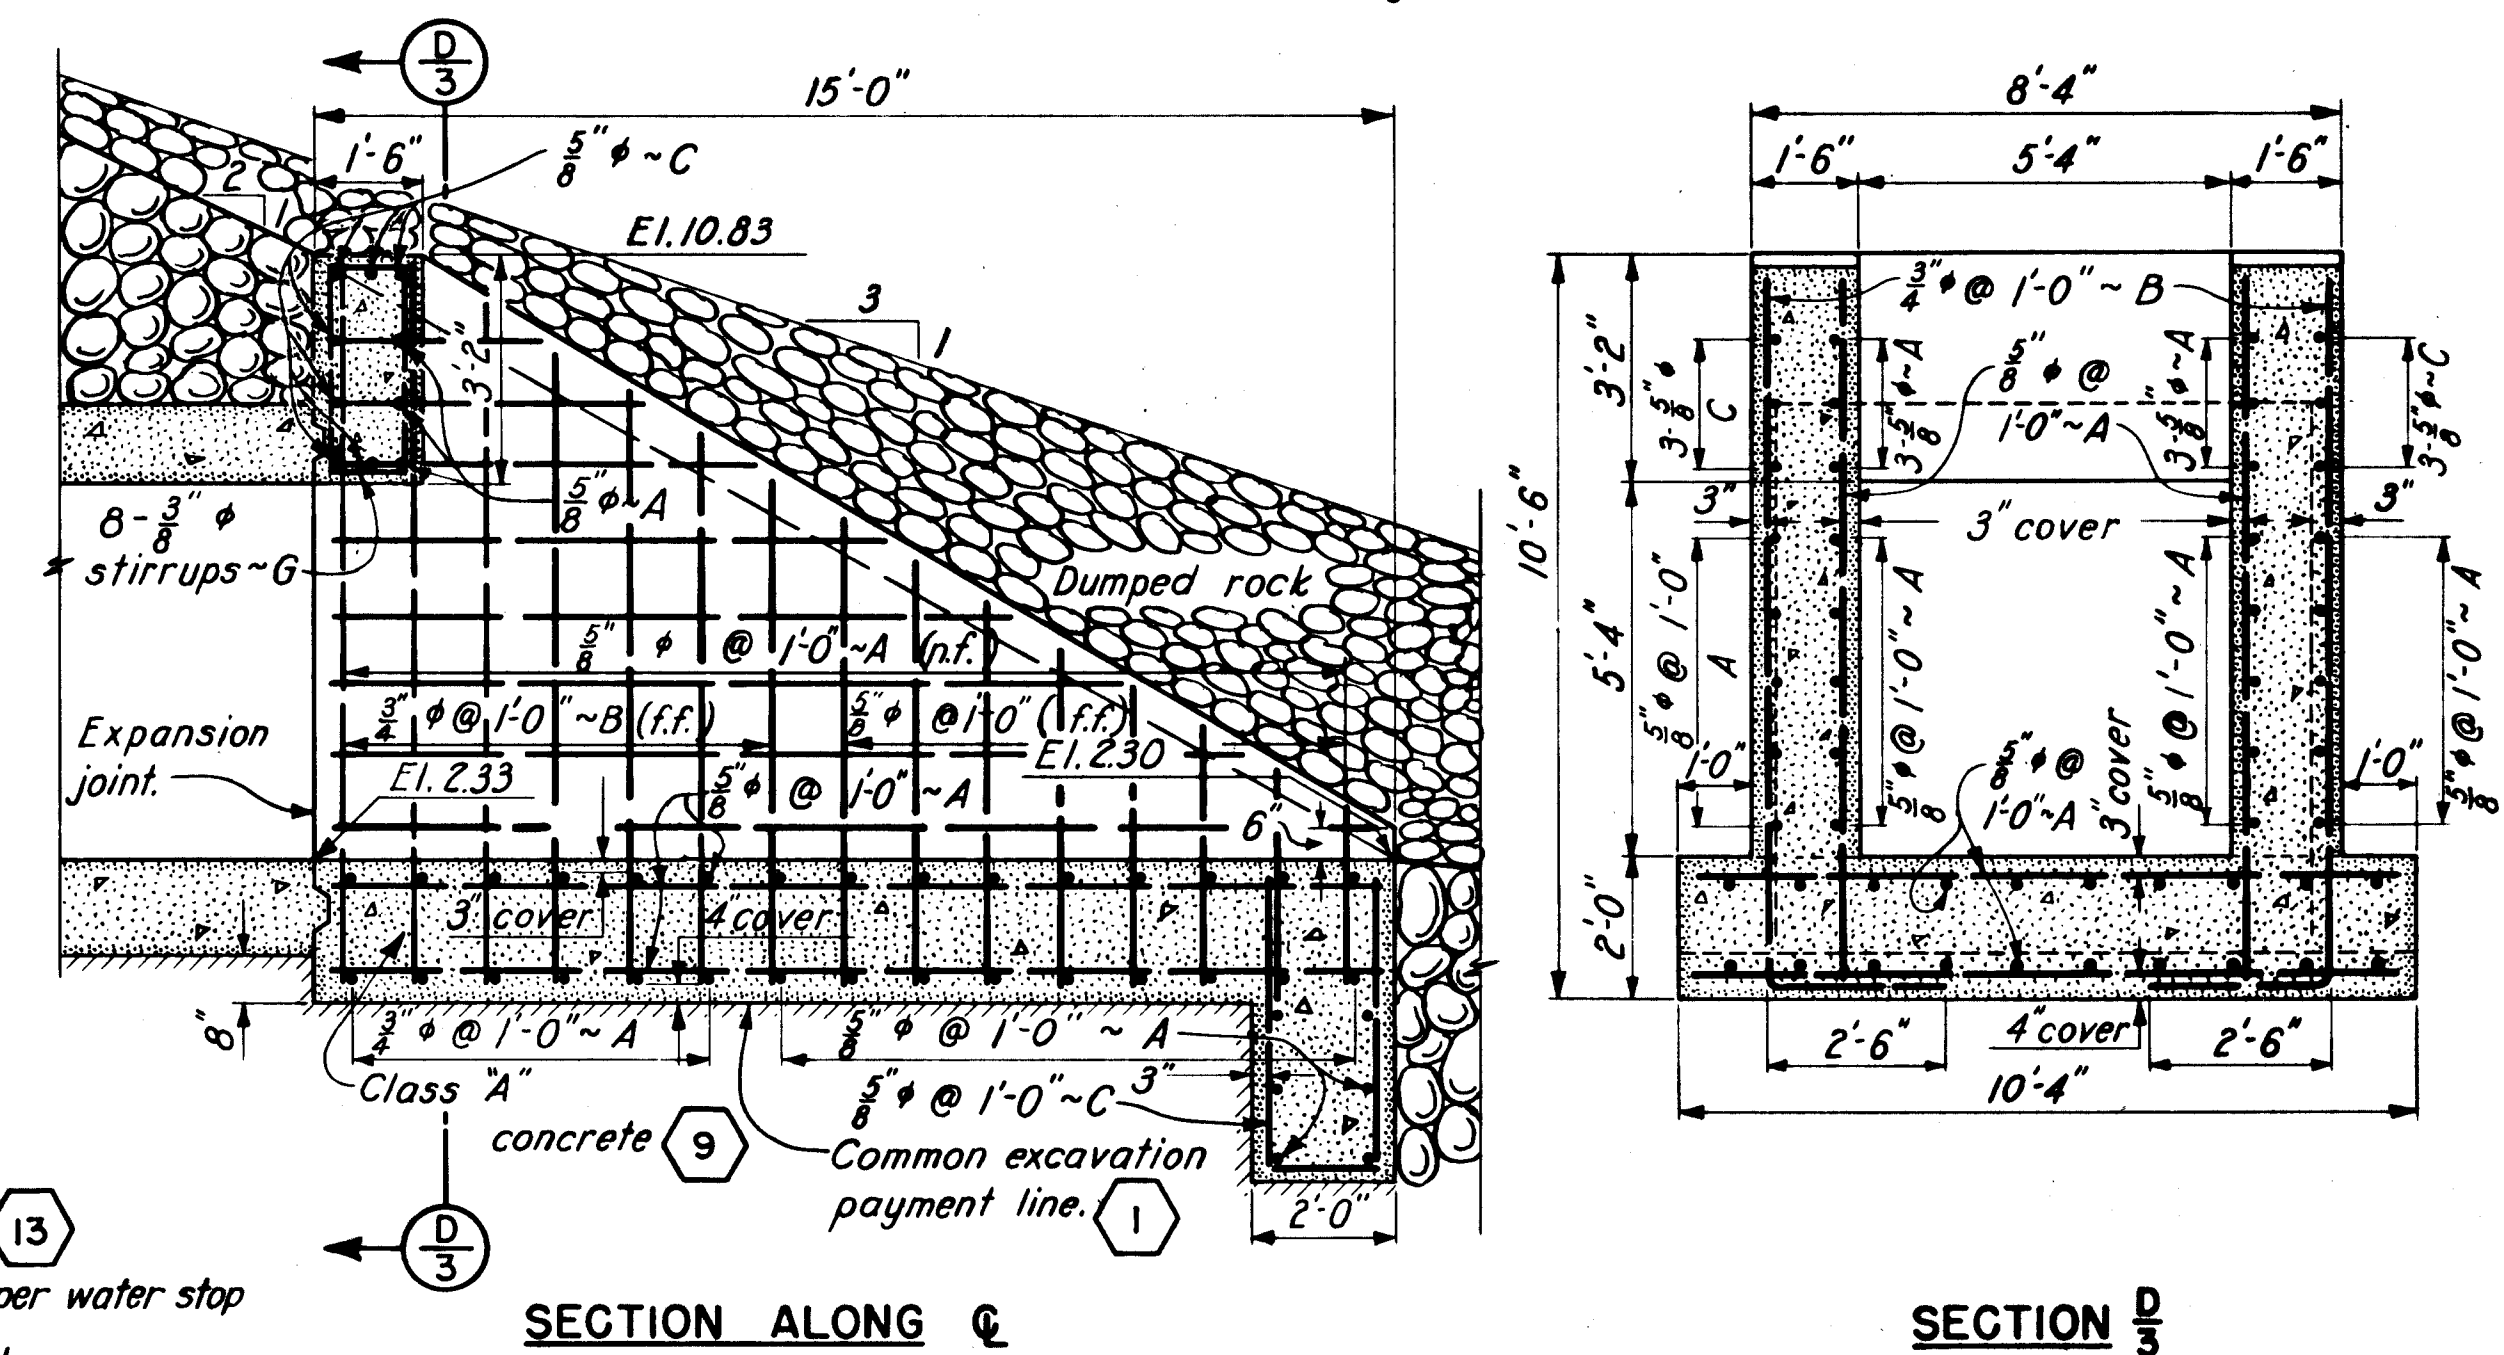

DETAIL OF MASSEY CONDUIT
 TYPICAL BETWEEN STA. 0+04 AND STA. 1+72
 SCALE 1/2" = 1'-0"

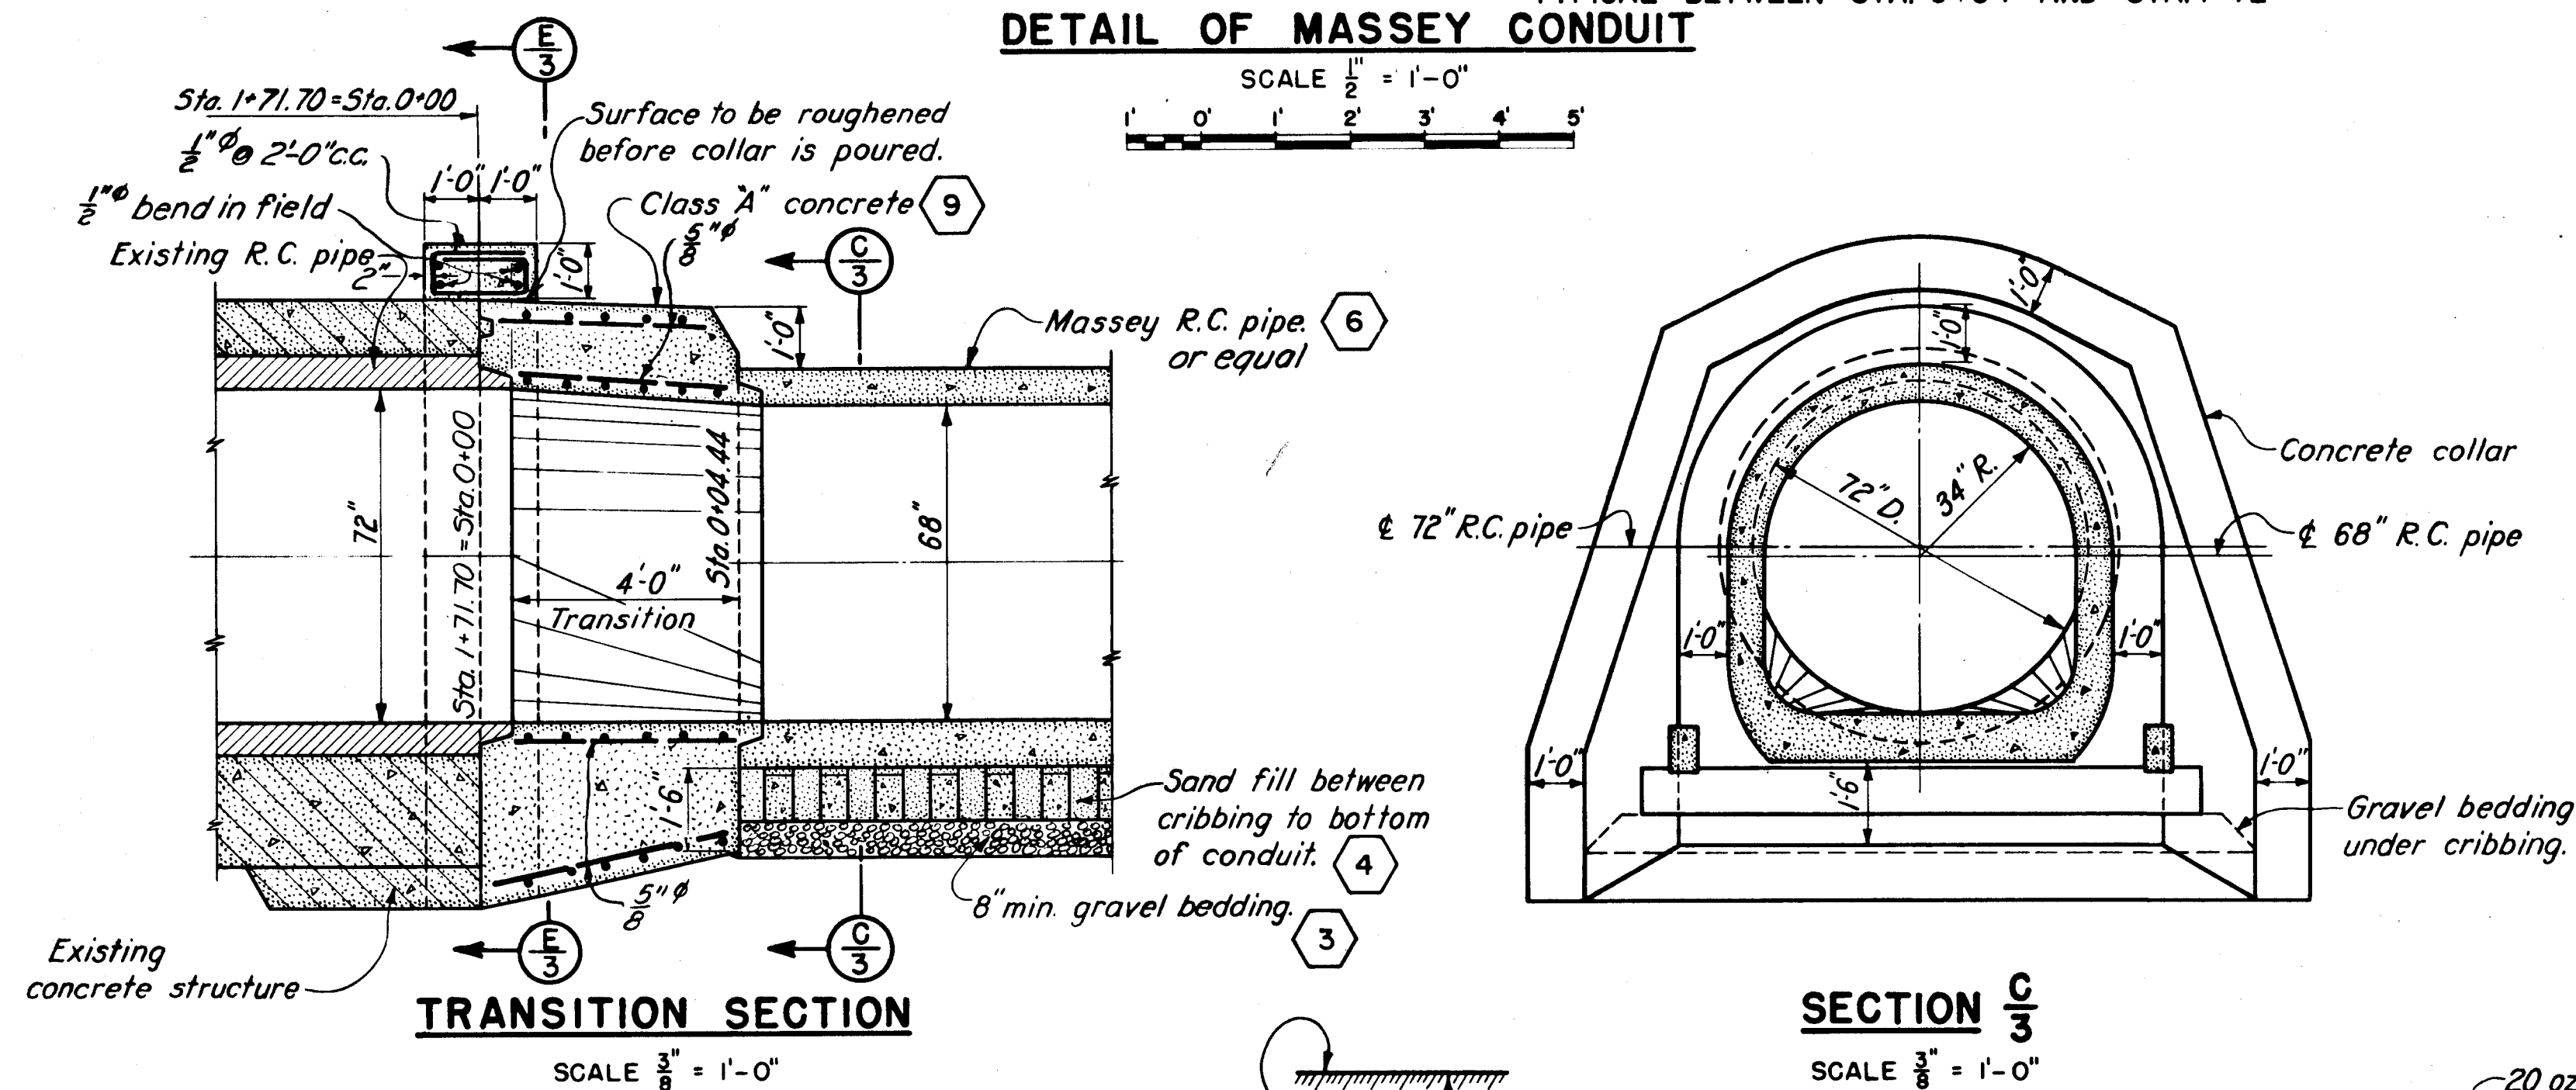

STEEL REINFORCEMENT BENDING KEY			
TYPE	DIAGRAM	TYPE	DIAGRAM
A		C	
AB		G	
AC			
B			
BA			

NOTES:
 Elevations shown are construction grades, see Camber Diagram on Sheet No. 2.

CONNECTICUT RIVER FLOOD CONTROL			
HARTFORD DIKE			
SUPPLEMENTAL AGREEMENT			
RECONSTRUCTION OF MASSEK ST. SEWER			
DETAILS			
CONNECTICUT RIVER		CONNECTICUT	
IN 6 SHEETS		SCALE 3/8" IN. = 1 FT.	
U.S. ENGINEER OFFICE, PROVIDENCE, R.I.		DEC. 1941	
SUBMITTED: J. P. Gammell		APPROVED: J. P. Gammell	
SENIOR ENGINEER		PRINCIPAL ENGINEER	
HEAD DESIGN SECTION		CHIEF, ENGINEERING DIV.	
DESIGNED: J. C. Hanscomb		DRAWN: T. C. M.	
ASSOC. ENGINEER		CHECKED: H. R. F.	
		FILE NO. CT-4-3063	

KEY	DATE	REVISION (Indicated by Δ)	REV. BY	CK. BY	AP. BY
	12/31/45	As built revisions			