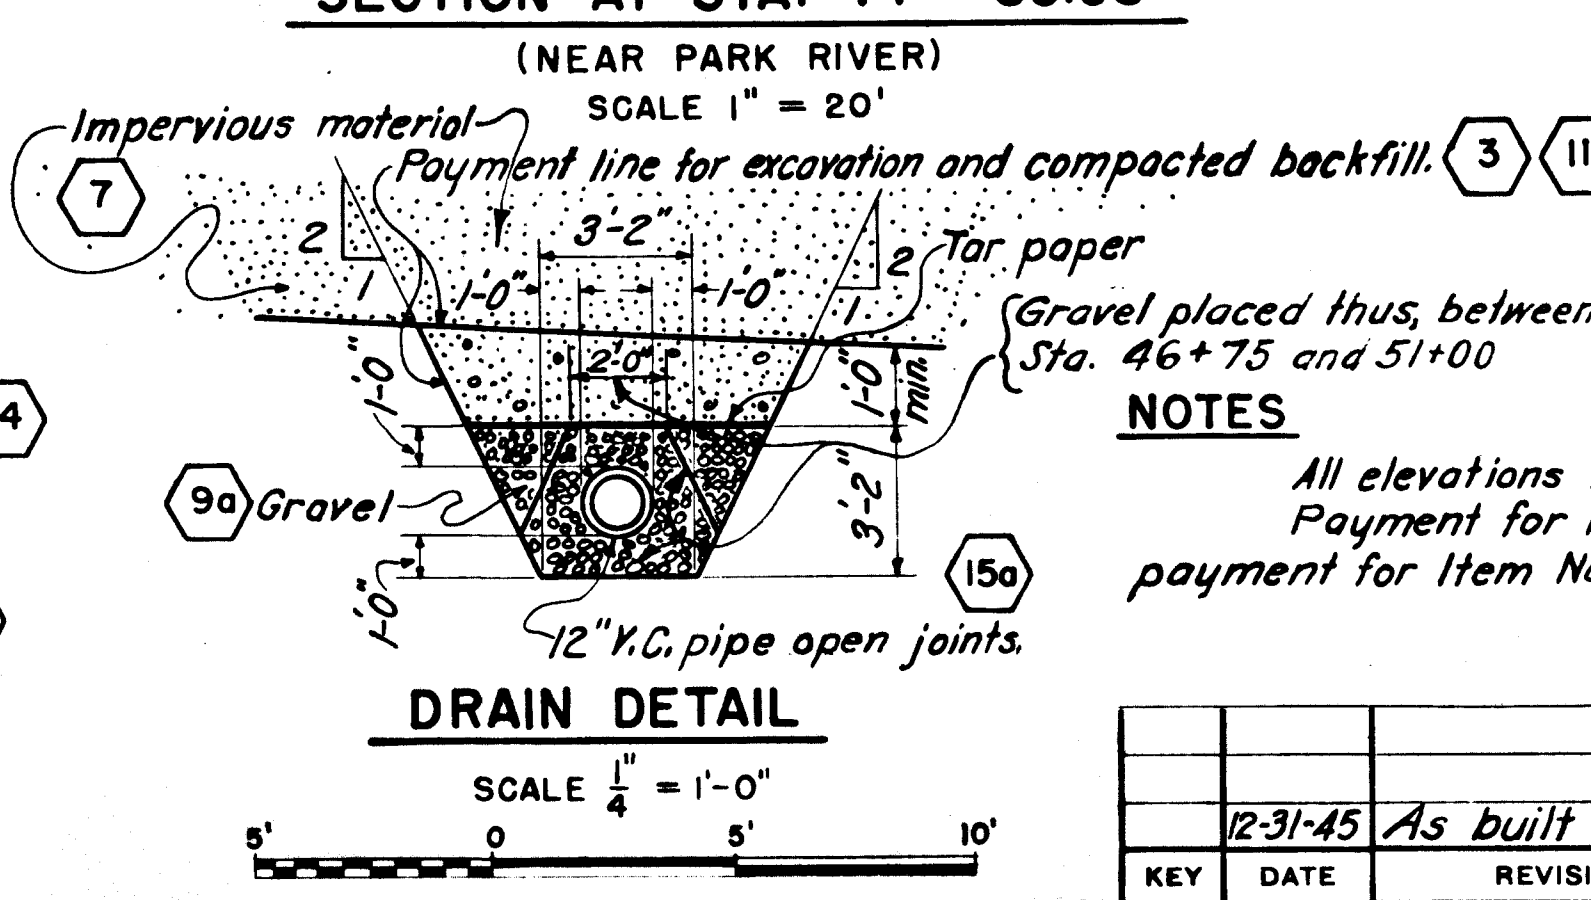
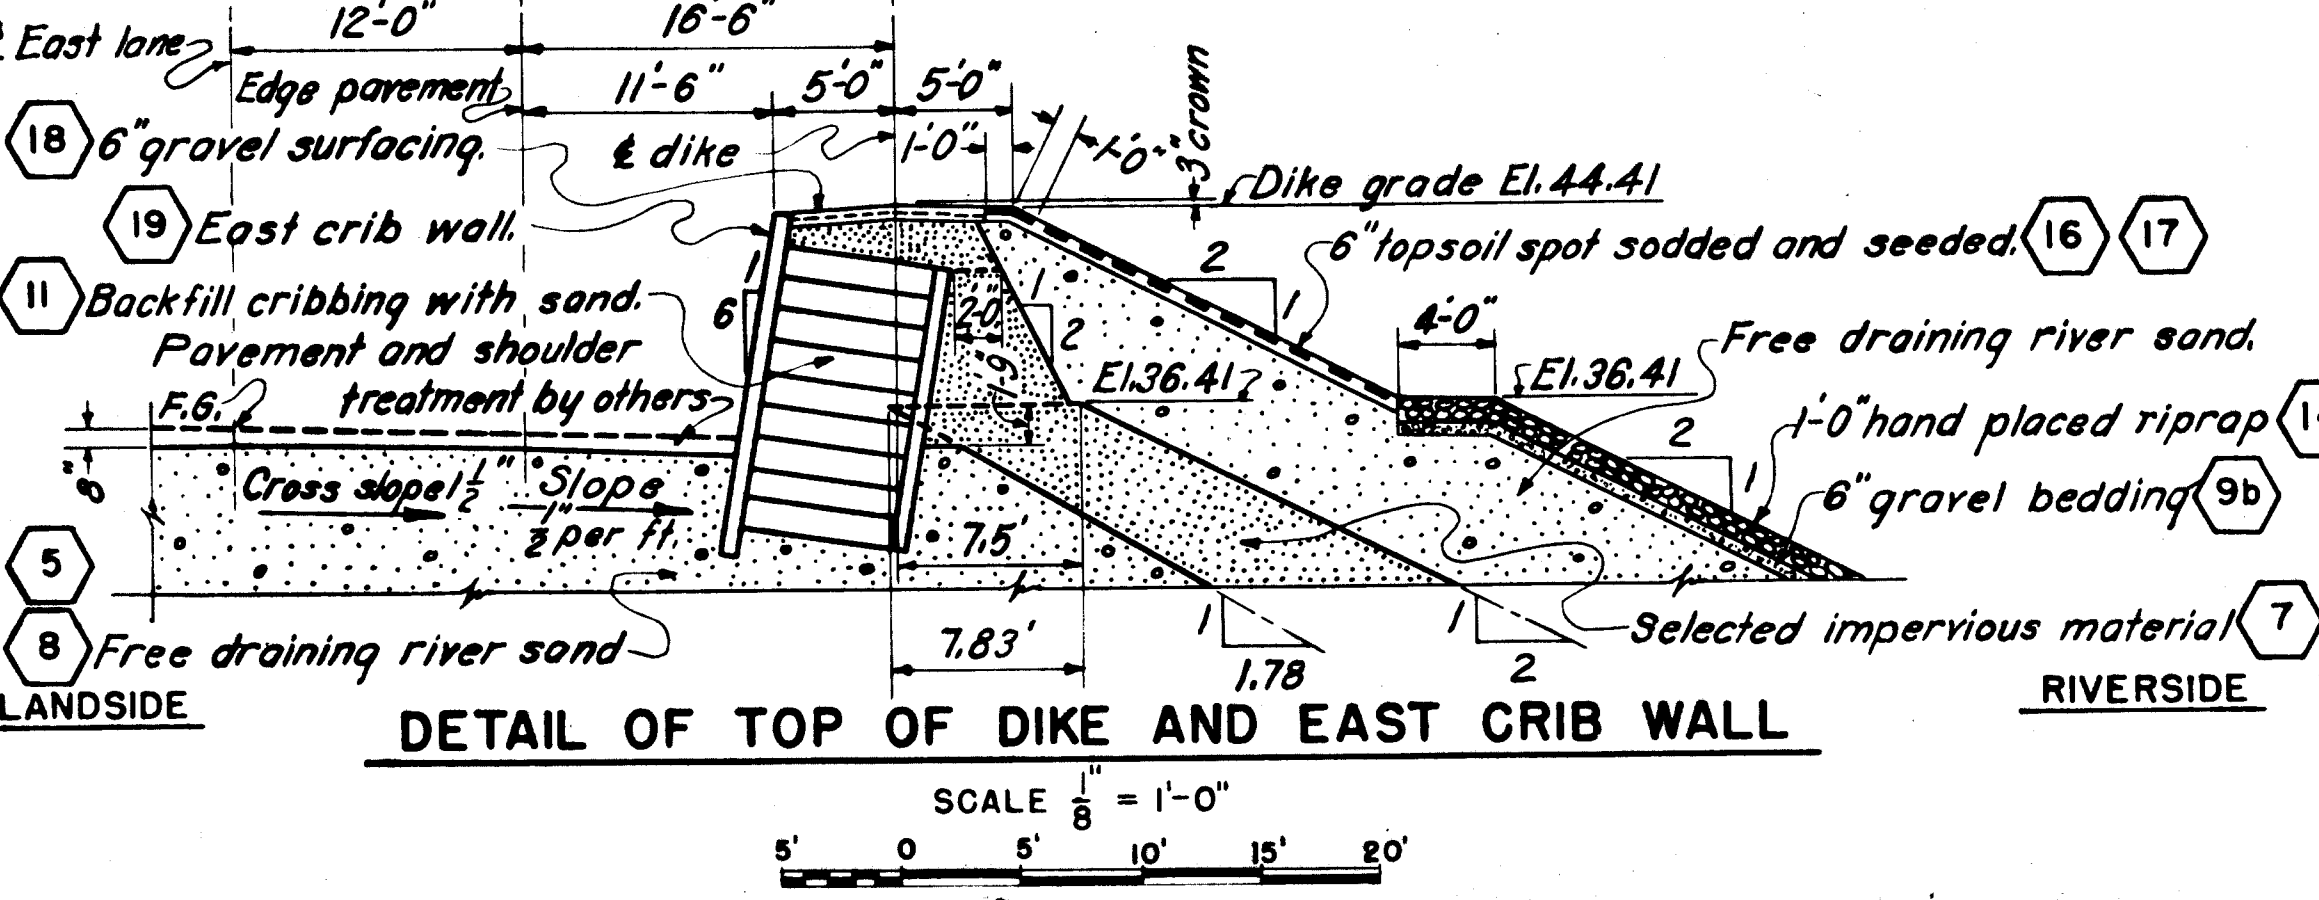
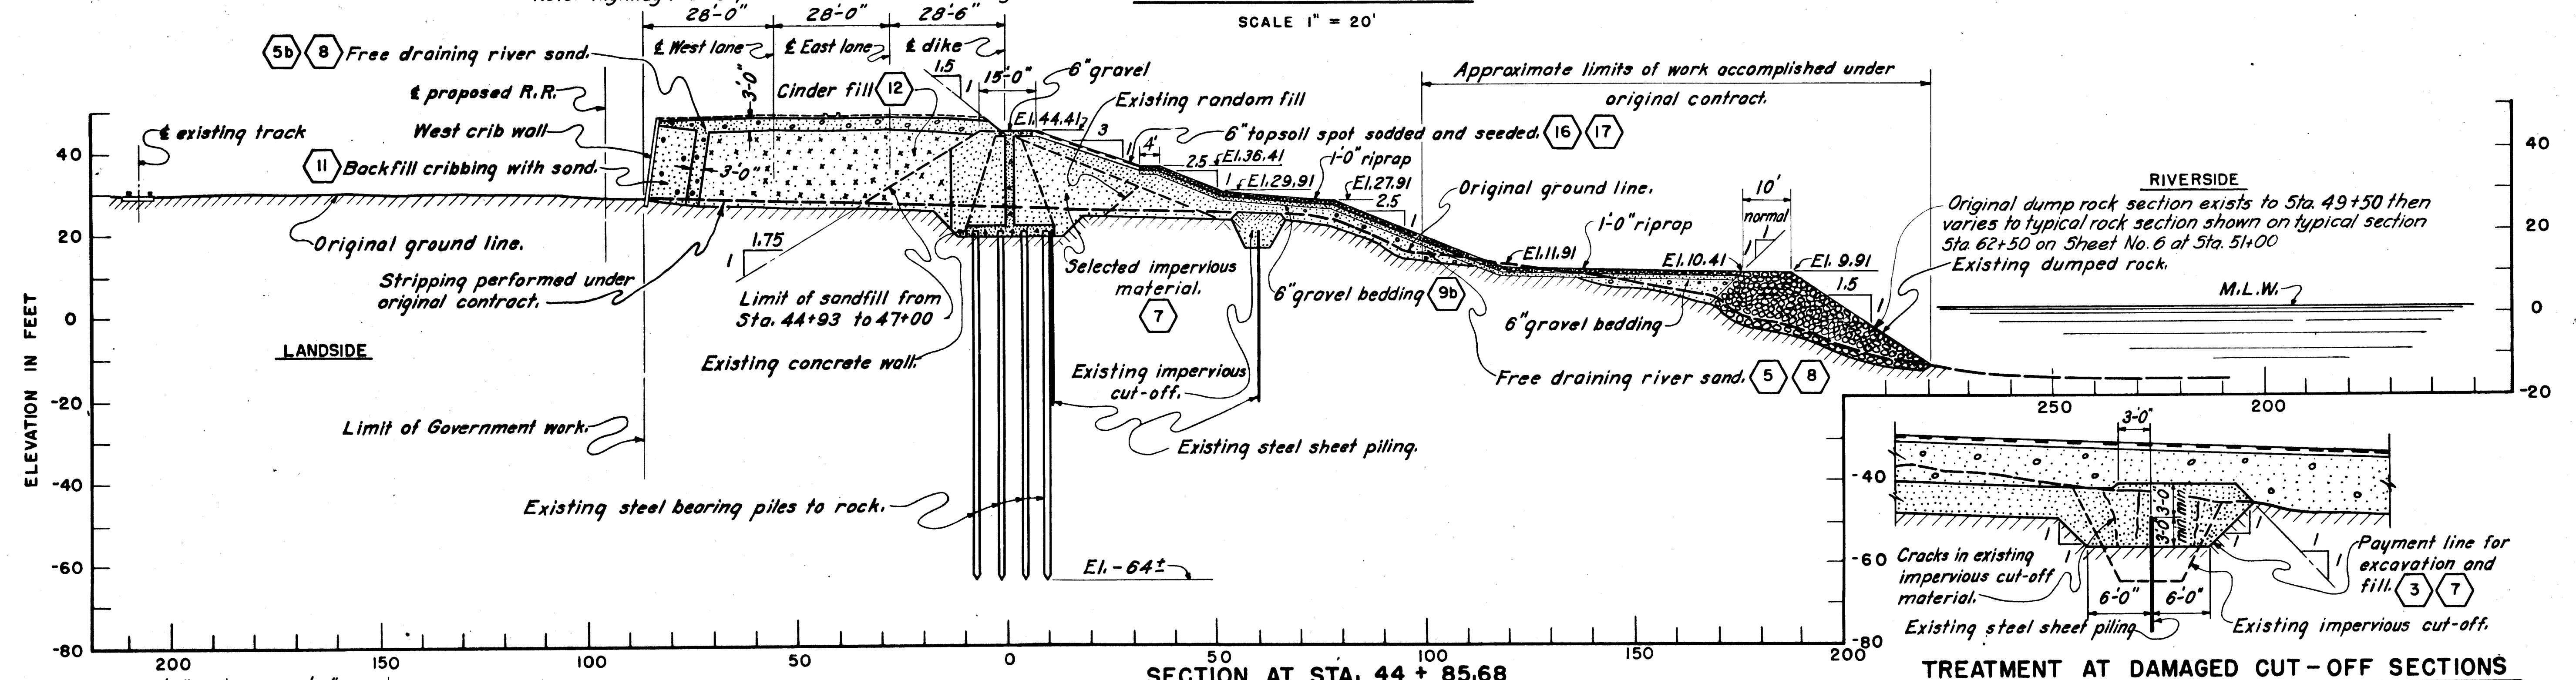
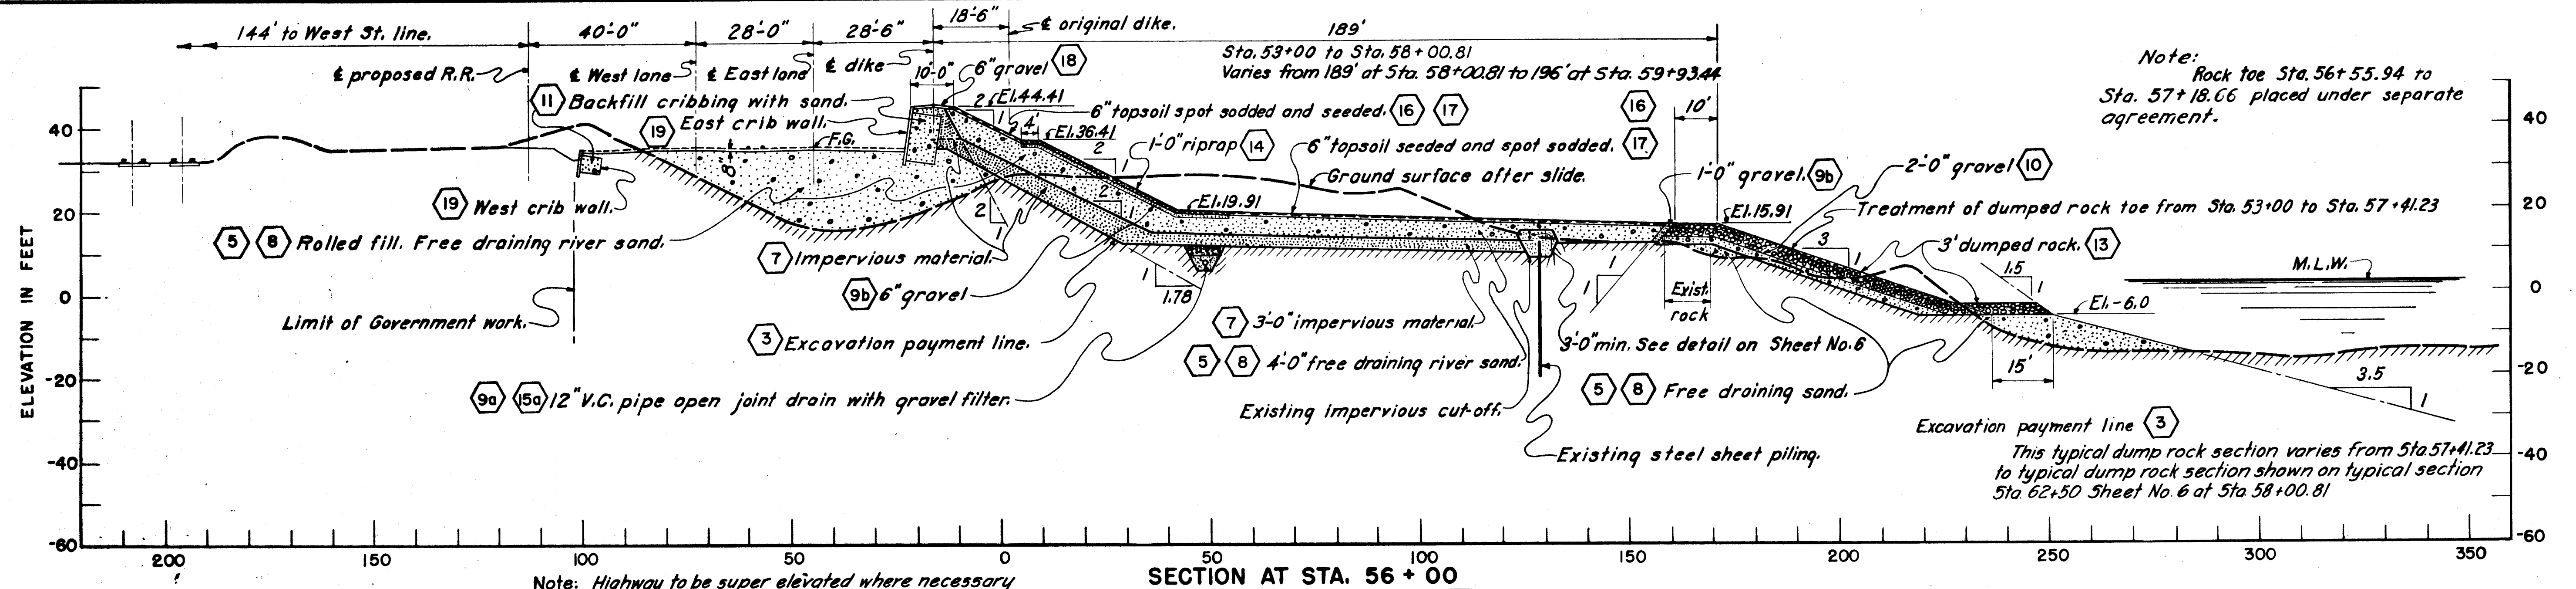


NOTES

All elevations refer to Mean Sea Level Datum.

Payment for Item No. 5 shall not begin until payment for Item No. 8 is complete at any section.

KEY	DATE	REVISION (Indicated by Δ)	REV. BY	CK. BY	AP. BY
	12-31-45	As built revisions			

CONNECTICUT RIVER FLOOD CONTROL
HARTFORD DIKE
SUPPLEMENTAL AGREEMENT
RECONSTRUCTION AT SLIDE STA. 44+85.68 TO STA. 65.00
TYPICAL CROSS-SECTIONS NO. 1

CONNECTICUT RIVER IN 7 SHEETS SCALE: 1 IN. = 20 FT. SHEET NO. 5

U.S. ENGINEER OFFICE, PROVIDENCE, R.I., MARCH 1942

SUBMITTED: [Signature] APPROVED: [Signature]
SENIOR ENGINEER PRINCIPAL ENGINEER
HEAD, DESIGN SECTION CHIEF, ENGINEERING DIV.

DESIGNED: [Signature] DRAWN: L.V.P.
ASSOC. ENGINEER TRACED: B.J.P.
CHECKED: [Signature]

FILE NO. CT-4-3059