
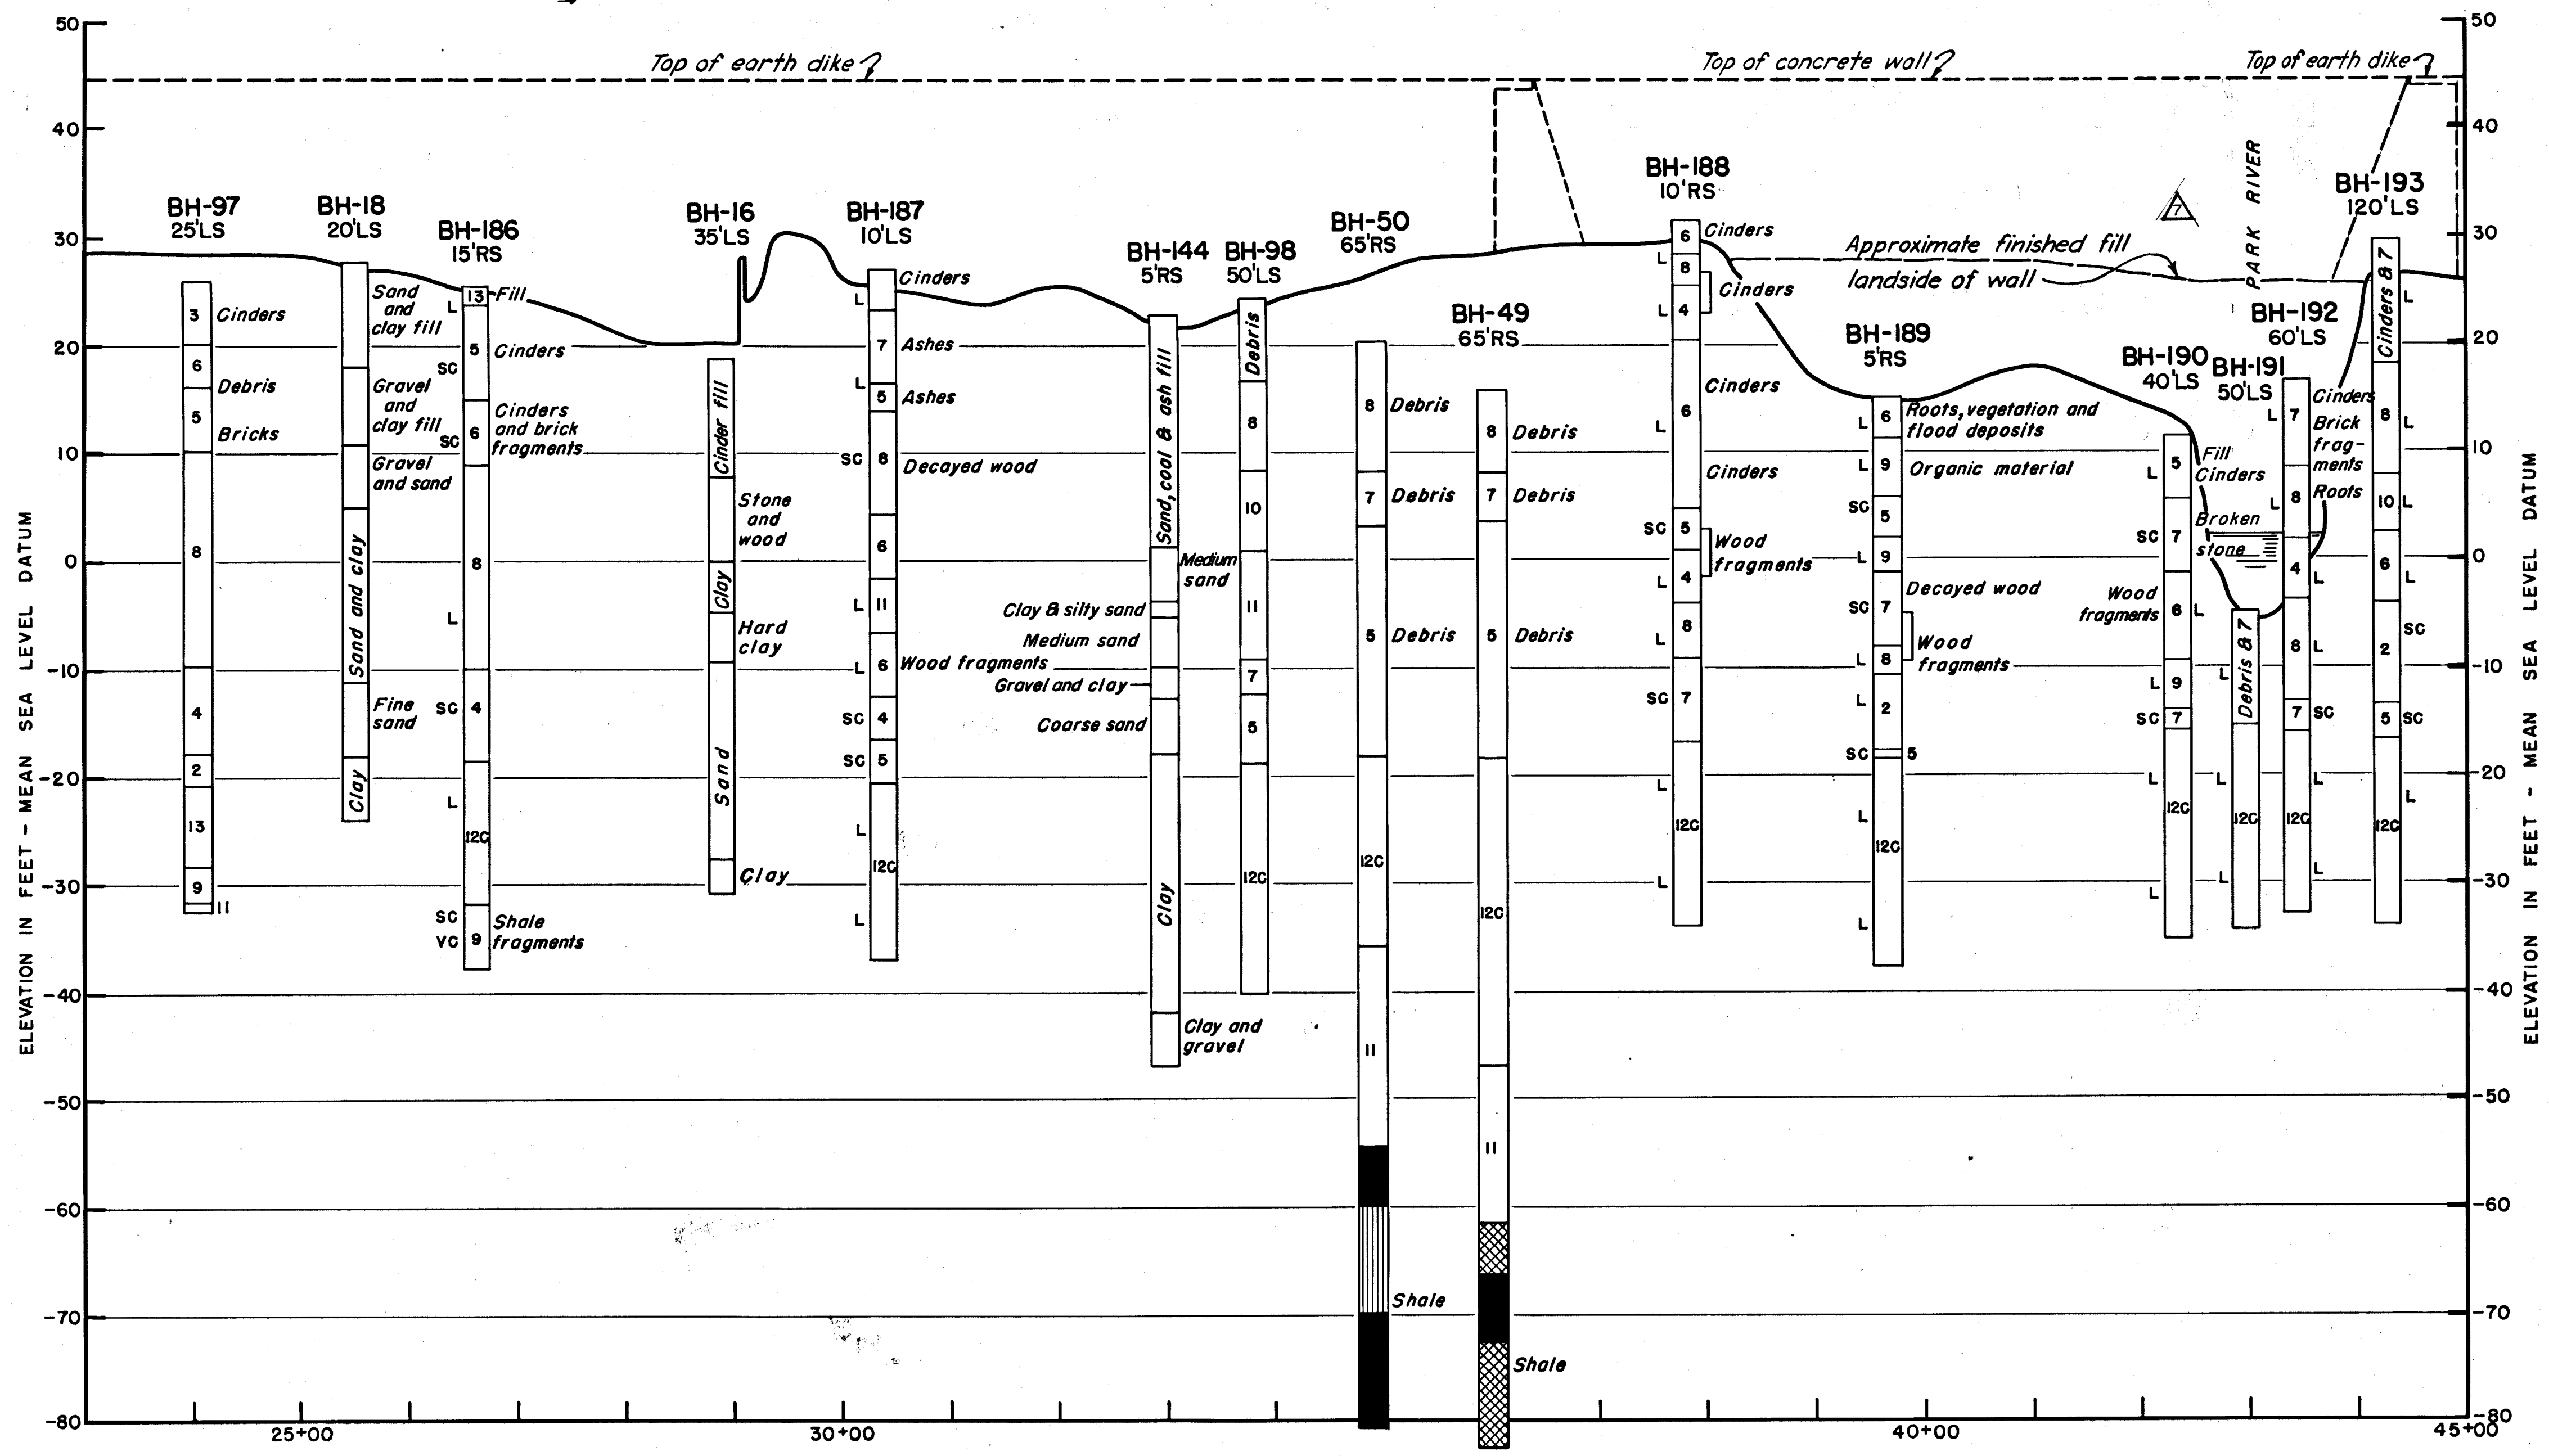


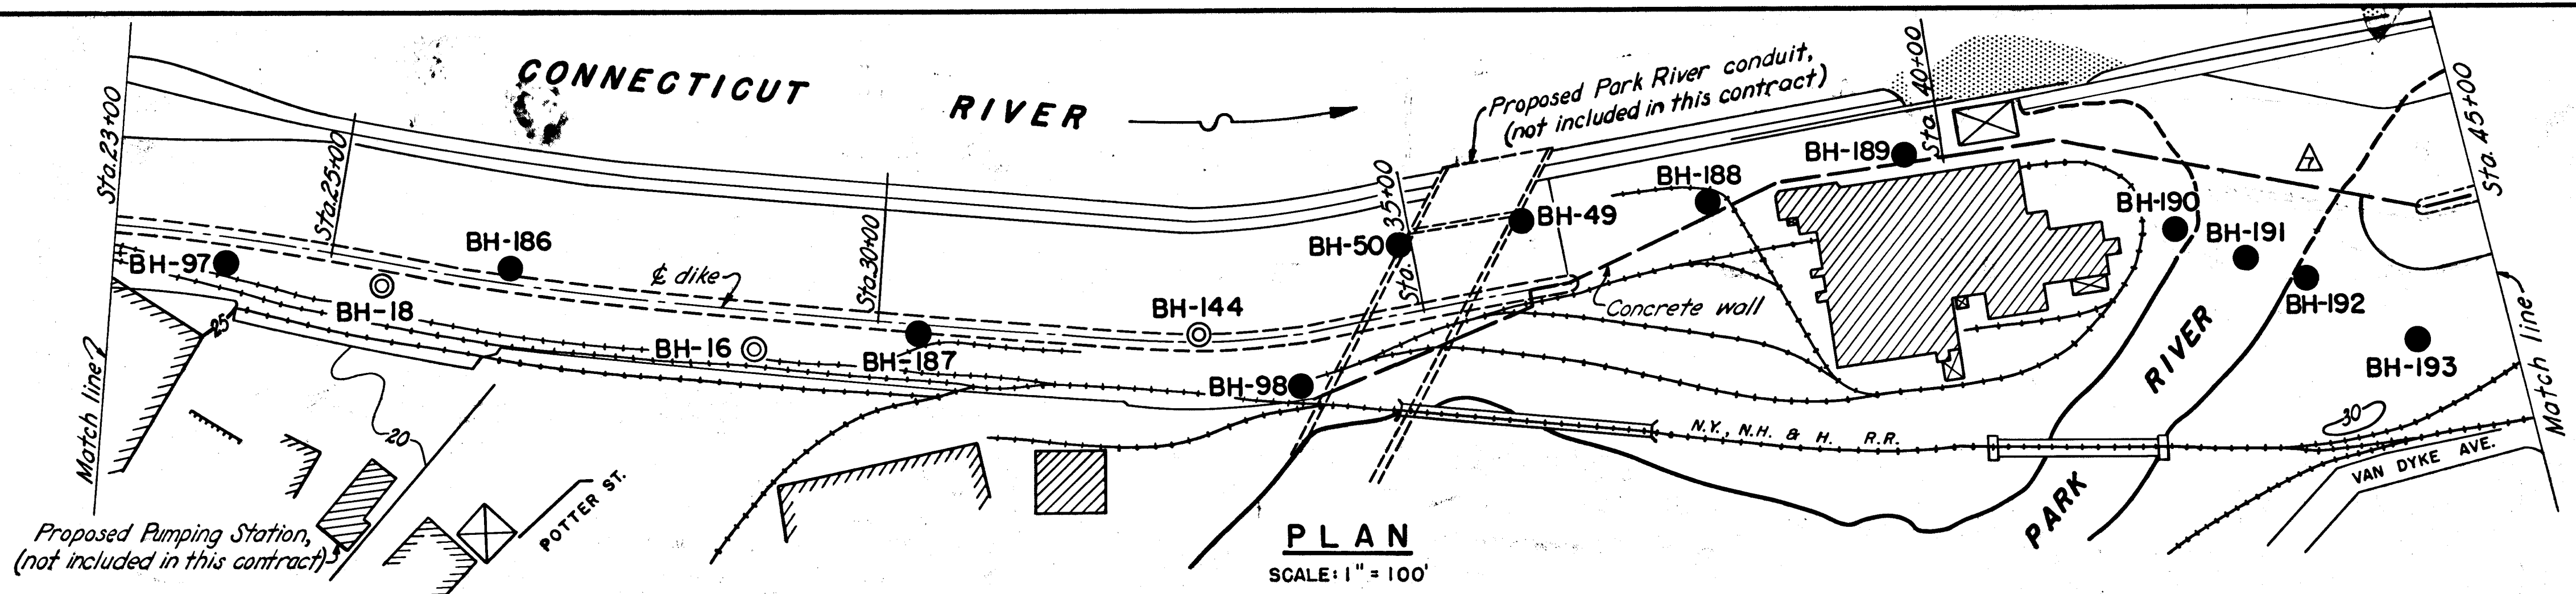

NOTE
For general notes, legend and description of soil classes, see Sheet No. 7.

PROFILE ALONG DIKE

SCALE: HOR. 1" = 100'
VERT. 1" = 10'

KEY	DATE	REVISION (Indicated by Δ)	REV. BY	CK. BY	AP. BY
Δ	12-31-45	As Built			
Δ	3/10/41	Wall extended.	WQS	ISA	2816

CONNECTICUT RIVER FLOOD CONTROL		
HARTFORD DIKE		
RIVERFRONT, MORGAN ST. TO STA. 96+73		
SUBSURFACE EXPLORATIONS NO.2		
CONNECTICUT RIVER		CONNECTICUT
IN 135 SHEETS	SCALE: 1 IN. = 100 FT.	SHEET NO. 6
U.S. ENGINEER OFFICE, PROVIDENCE, R.I., MAY 1940		
SUBMITTED:	APPROVAL RECOMMENDED:	APPROVED:
SENIOR GEOLOGIST	PRINCIPAL ENGINEER	CHIEF OF ENGINEERS
HEAD, GEOLOGY SECTION	CHIEF, F.C. ENGINEERING DIV.	DISTRICT ENGINEER
COMPILED:	DRAWN:	FISCAL YEAR 1940
ASST. ENGINEER	R.R.L.	FILE NO. CT-2-1275
	TRACED: P.V.S.	
	CHECKED: WQS	

Ht587b

File 11-14-3