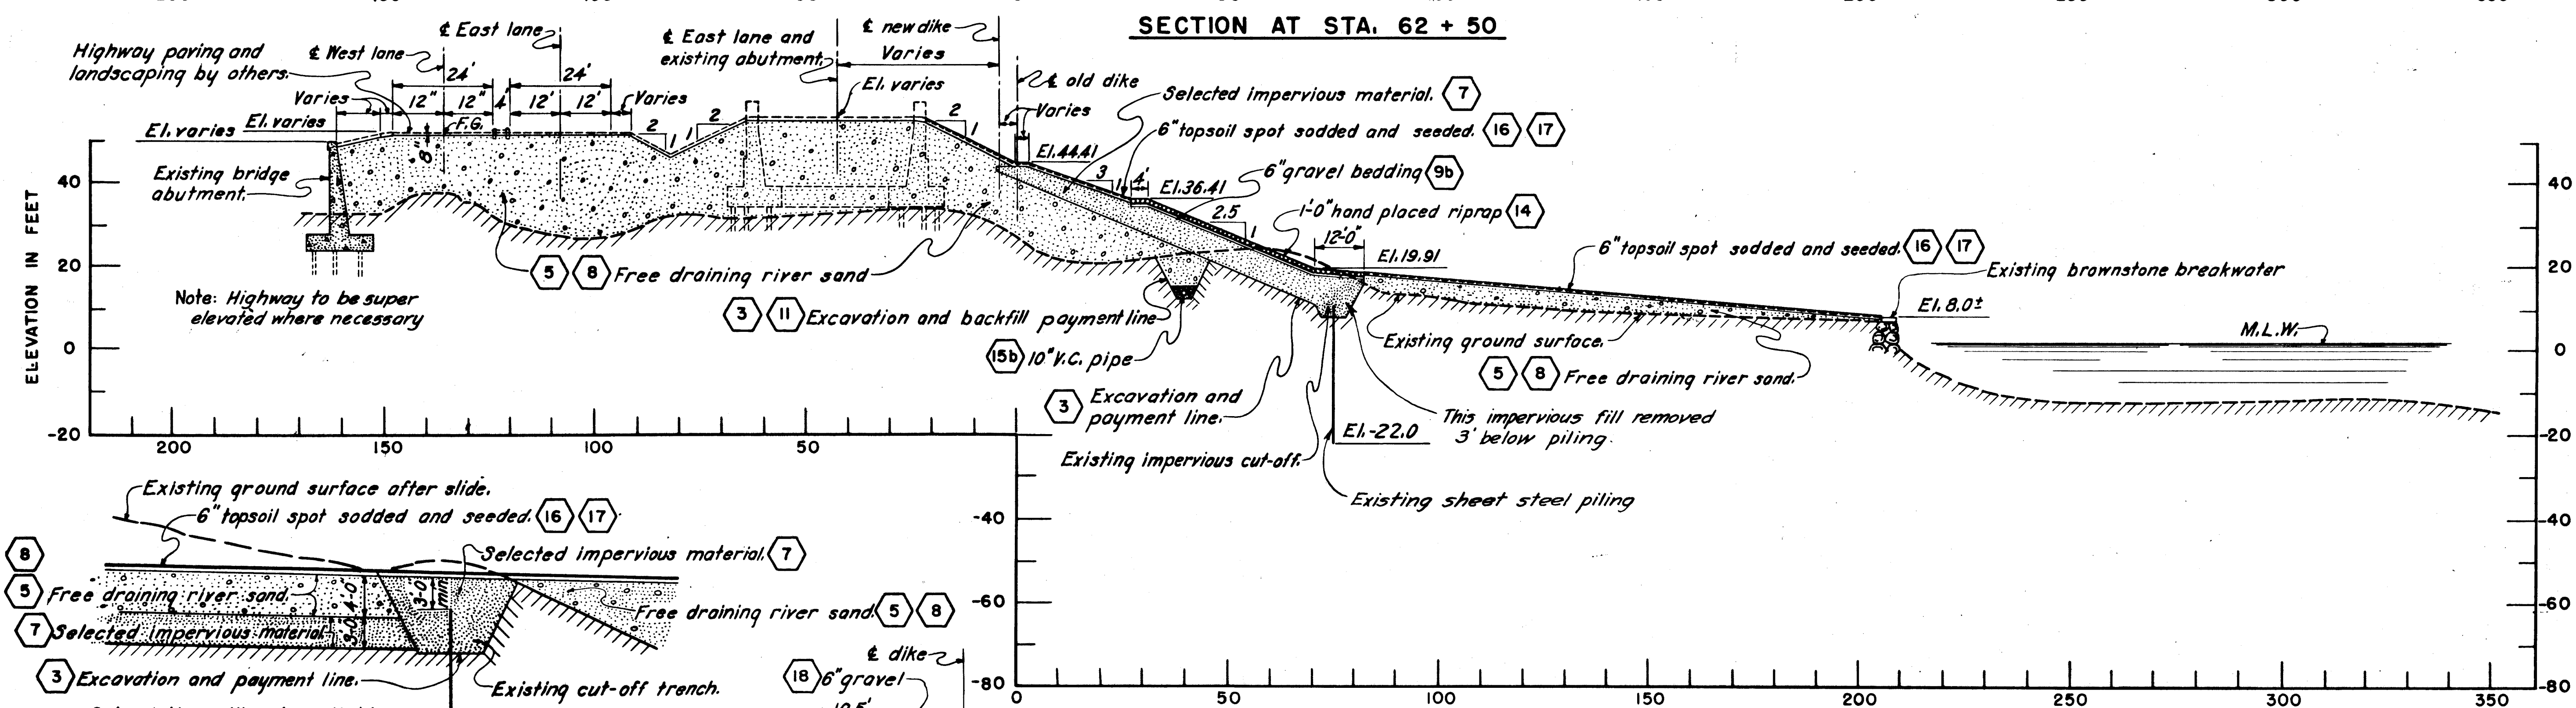
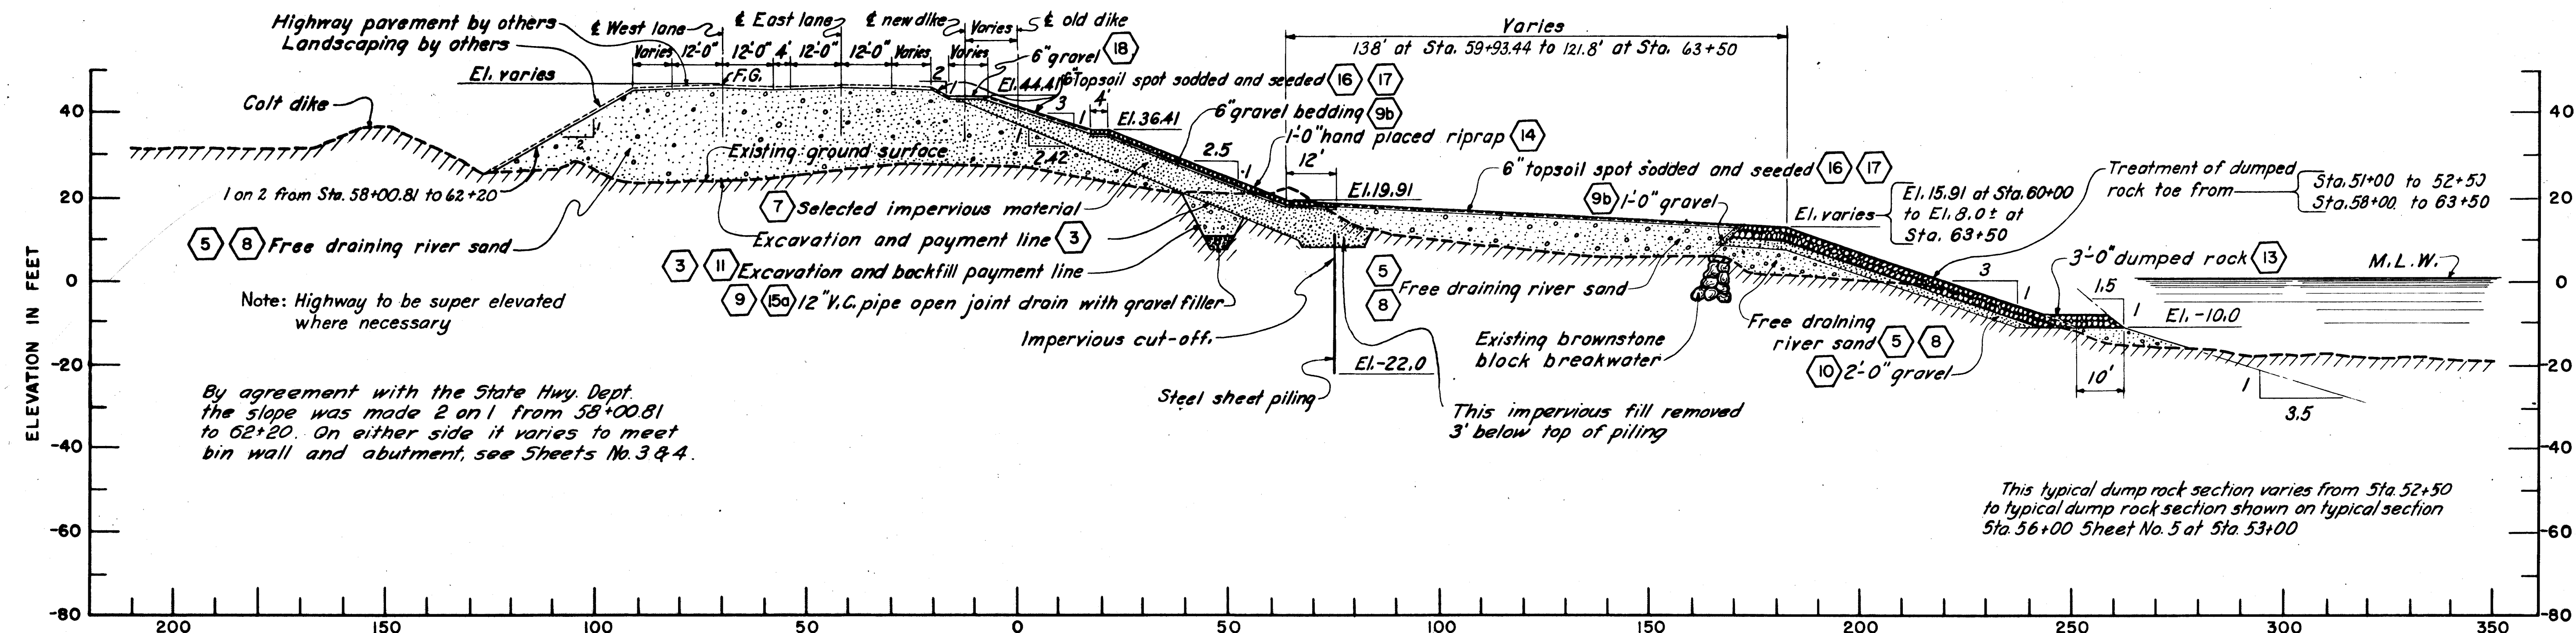


REMOVAL OF EXISTING PILING

SCALE 1" = 1'-0"

0 5 10 15 20'

DETAIL OF TOP OF DIKE

(TYPICAL FROM STA. 45+00 TO STA. 47+00)

SCALE 1" = 1'-0"

NOTES:

Elevations refer to Mean Sea Level Datum.
For general notes see Sheet No. 2 & Sheet No. 5.

KEY	DATE	REVISION (Indicated by Δ)	REV. BY	CK. BY	AP. BY
	12/31/45	As built revisions			

CONNECTICUT RIVER FLOOD CONTROL		
HARTFORD DIKE		
SUPPLEMENTAL AGREEMENT		
RECONSTRUCTION AT SLIDE STA. 44+45.68 TO STA. 65.00		
TYPICAL CROSS-SECTIONS NO. 2		
CONNECTICUT RIVER	CONNECTICUT	
IN 7 SHEETS	SCALE: 1 IN. = 20 FT.	SHEET NO. 6
U.S. ENGINEER OFFICE, PROVIDENCE, R.I., MARCH 1942		
SUBMITTED:	APPROVED:	RECOMMENDED:
J.C. Dineen	H. E. B.	H. E. B.
SENIOR ENGINEER	PRINCIPAL ENGINEER	COL. CORPS OF ENGINEERS
HEAD, DESIGN SECTION	CHIEF, ENGINEERING DIV.	DISTRICT ENGINEER
DESIGNED:	DRAWN:	FILE NO.
H. E. B.	H. E. B.	CT-4-3060
ASSOC. ENGINEER	CHECKED:	
	FILED:	