
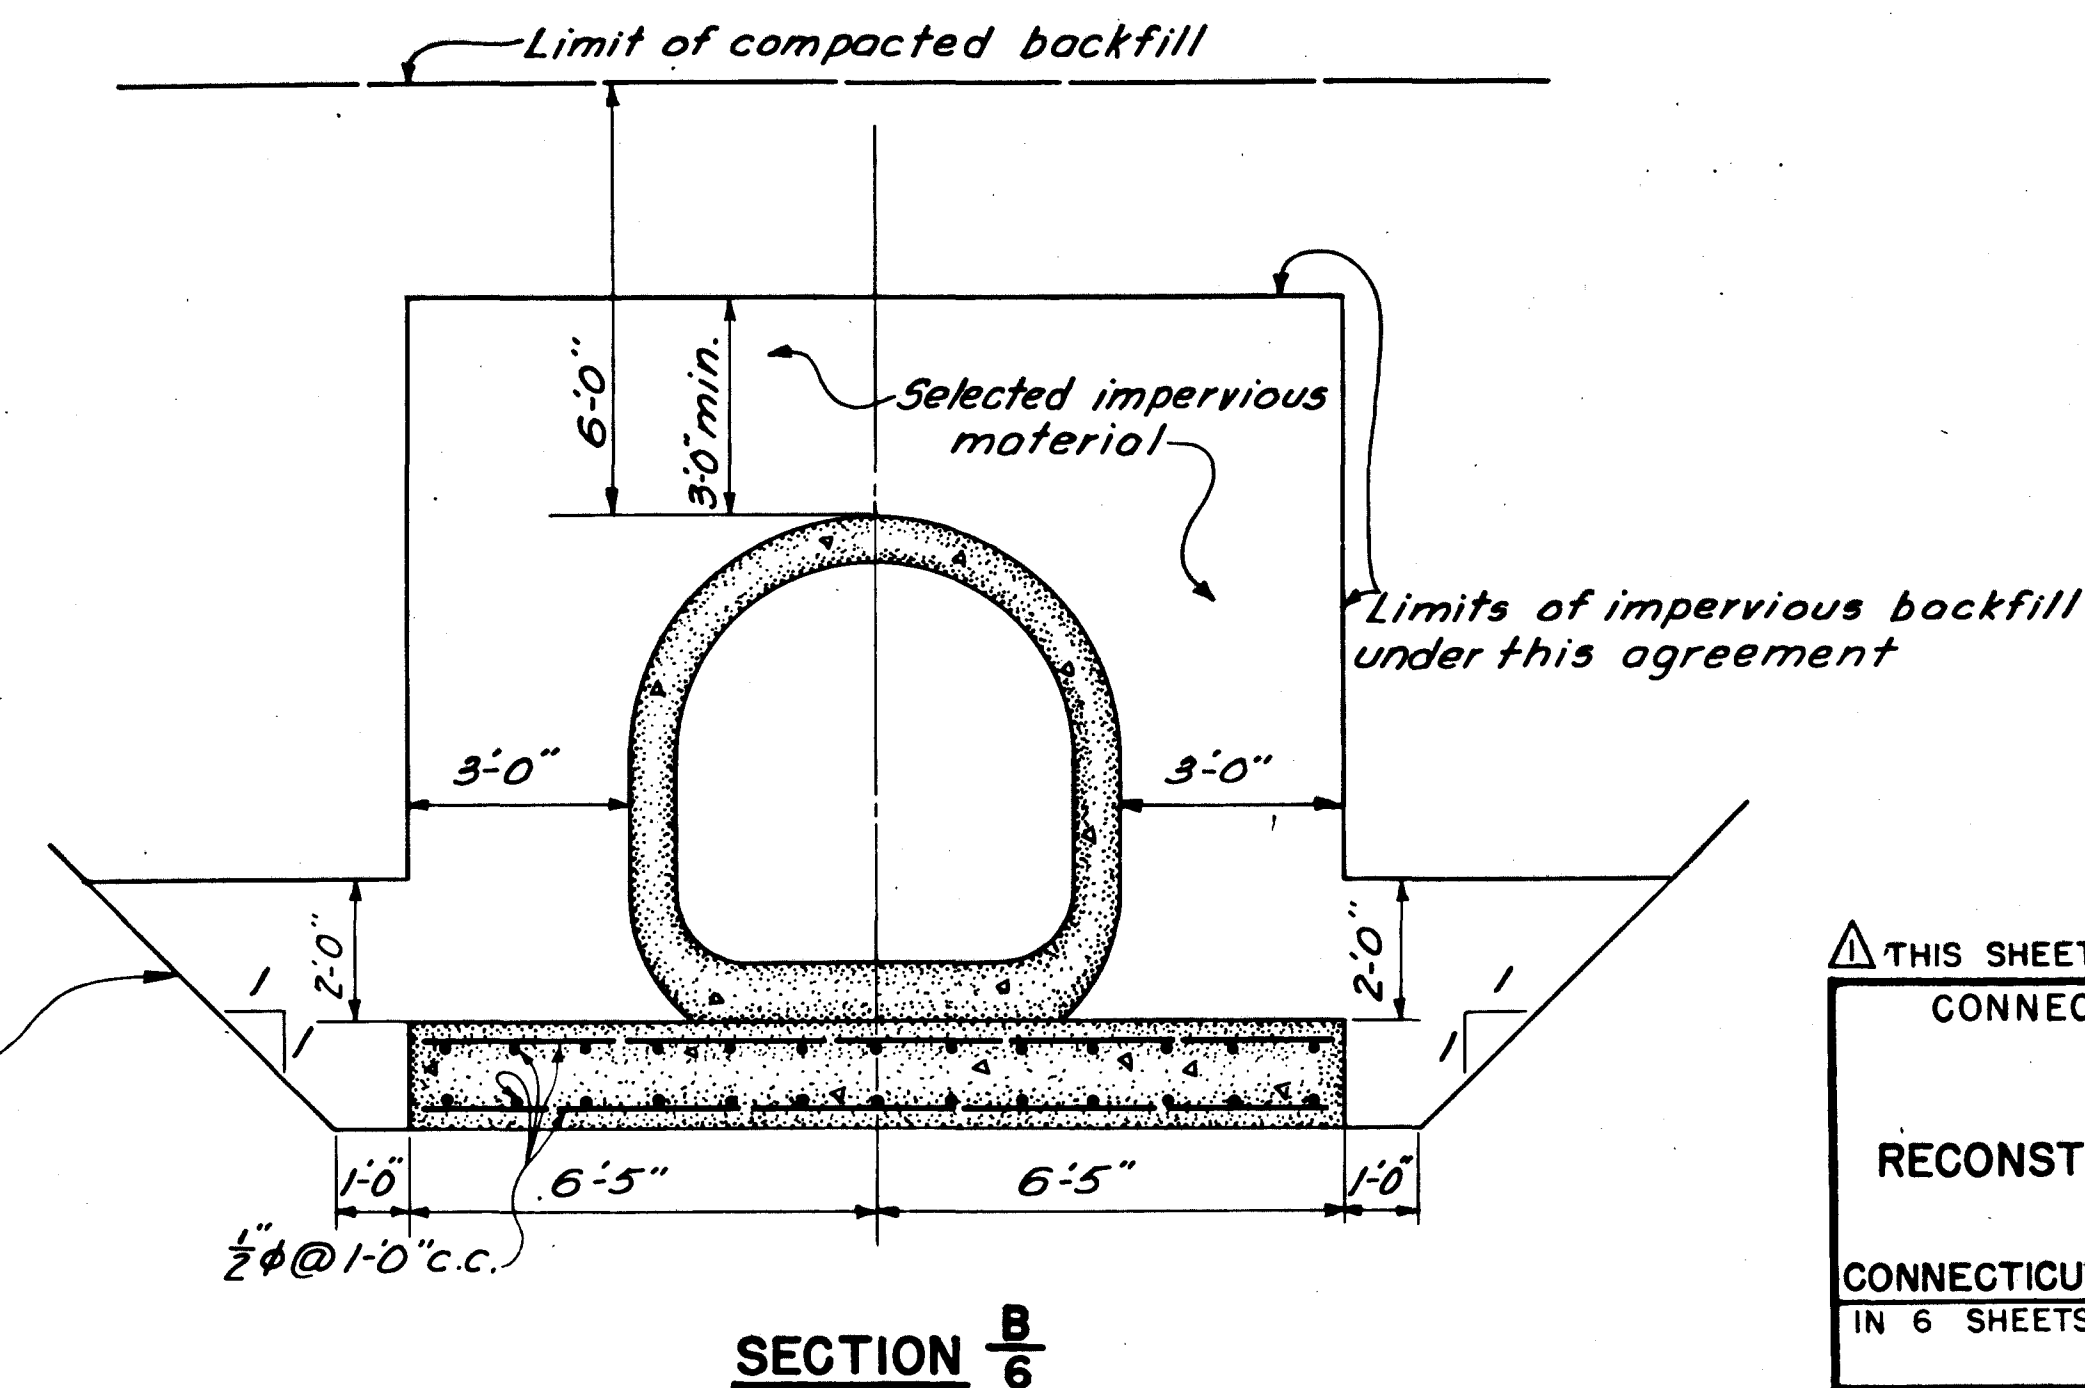


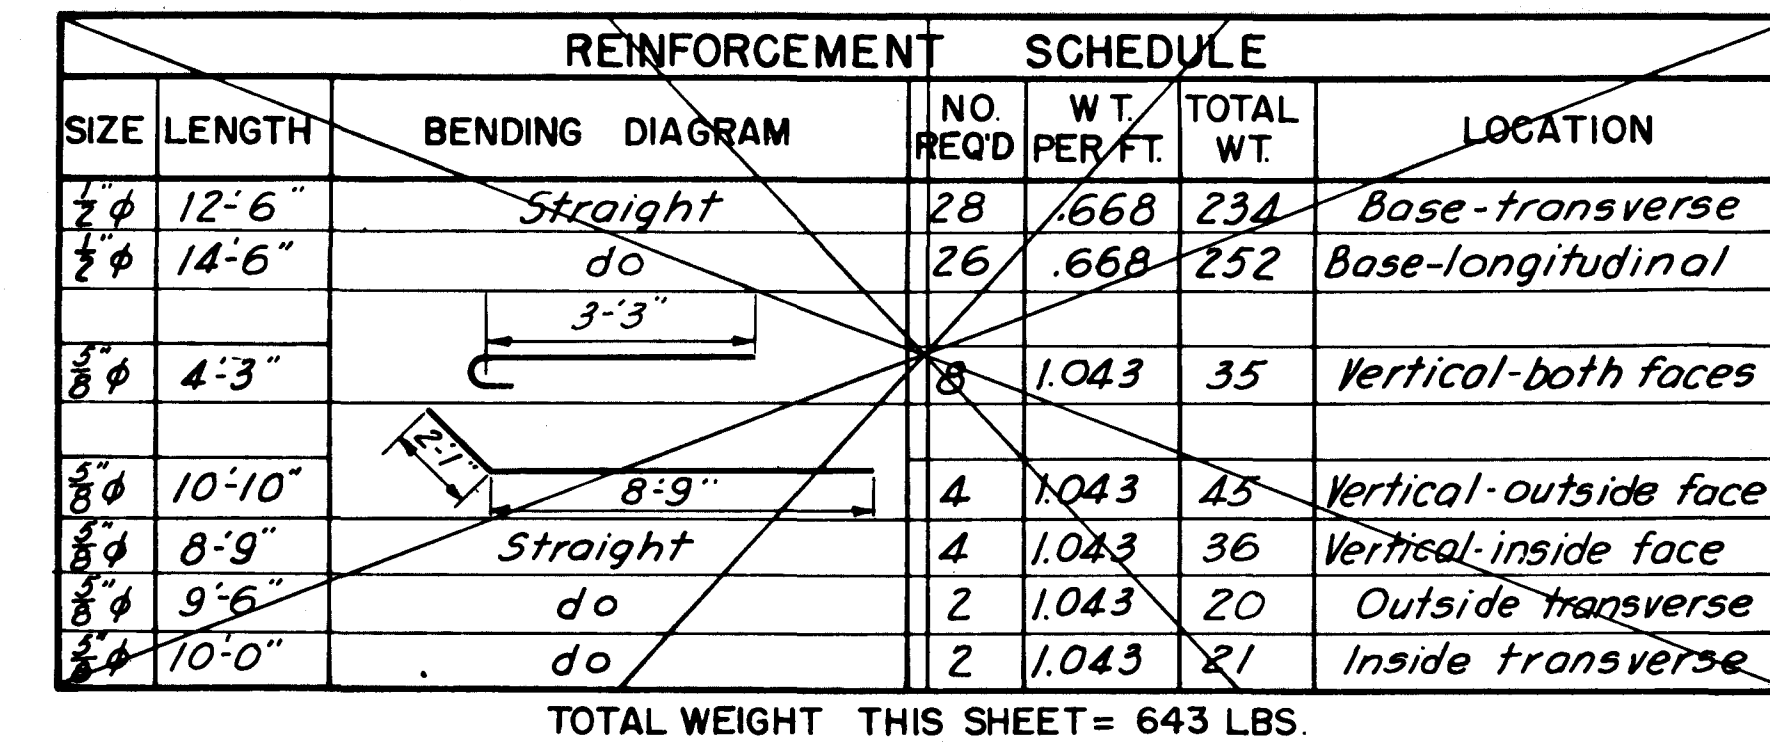

	12/31/45	As built revisions			
KEY	DATE	REVISION (Indicated by Δ)	REV. BY	CK. BY	AP. BY

THIS SHEET ADDED TO SET		
CONNECTICUT RIVER FLOOD CONTROL		
HARTFORD DIKE		
SUPPLEMENTAL AGREEMENT		
RECONSTRUCTION OF MASKEP ST. SEWER		
SEEP RING DETAILS		
CONNECTICUT RIVER		CONNECTICUT
IN 6 SHEETS	SCALE: 3/8" IN. = 1 FT.	SHEET NO. 6
U. S. ENGINEER OFFICE, PROVIDENCE, R.I.,		FEB. 1942
SUBMITTED BY: <i>J. C. Mansueti</i> SENIOR ENGINEER HEAD, DESIGN SECTION	APPROVED AND RECOMMENDED: <i>J. S. Sumner</i> PRINCIPAL ENGINEER CHIEF, ENGINEERING DIV.	
DESIGN BY: <i>P. C. Mansueti</i> ASSOC. ENGINEER	DRAWN: D.W.C. TRACED: A.J.H. CHECKED: <i>W. D. C.</i>	APPROVED: <i>W. S. Griffith</i> LT. COL., CORPS OF ENGINEERS DISTRICT ENGINEER
		FILE NO. CT-4-3130