

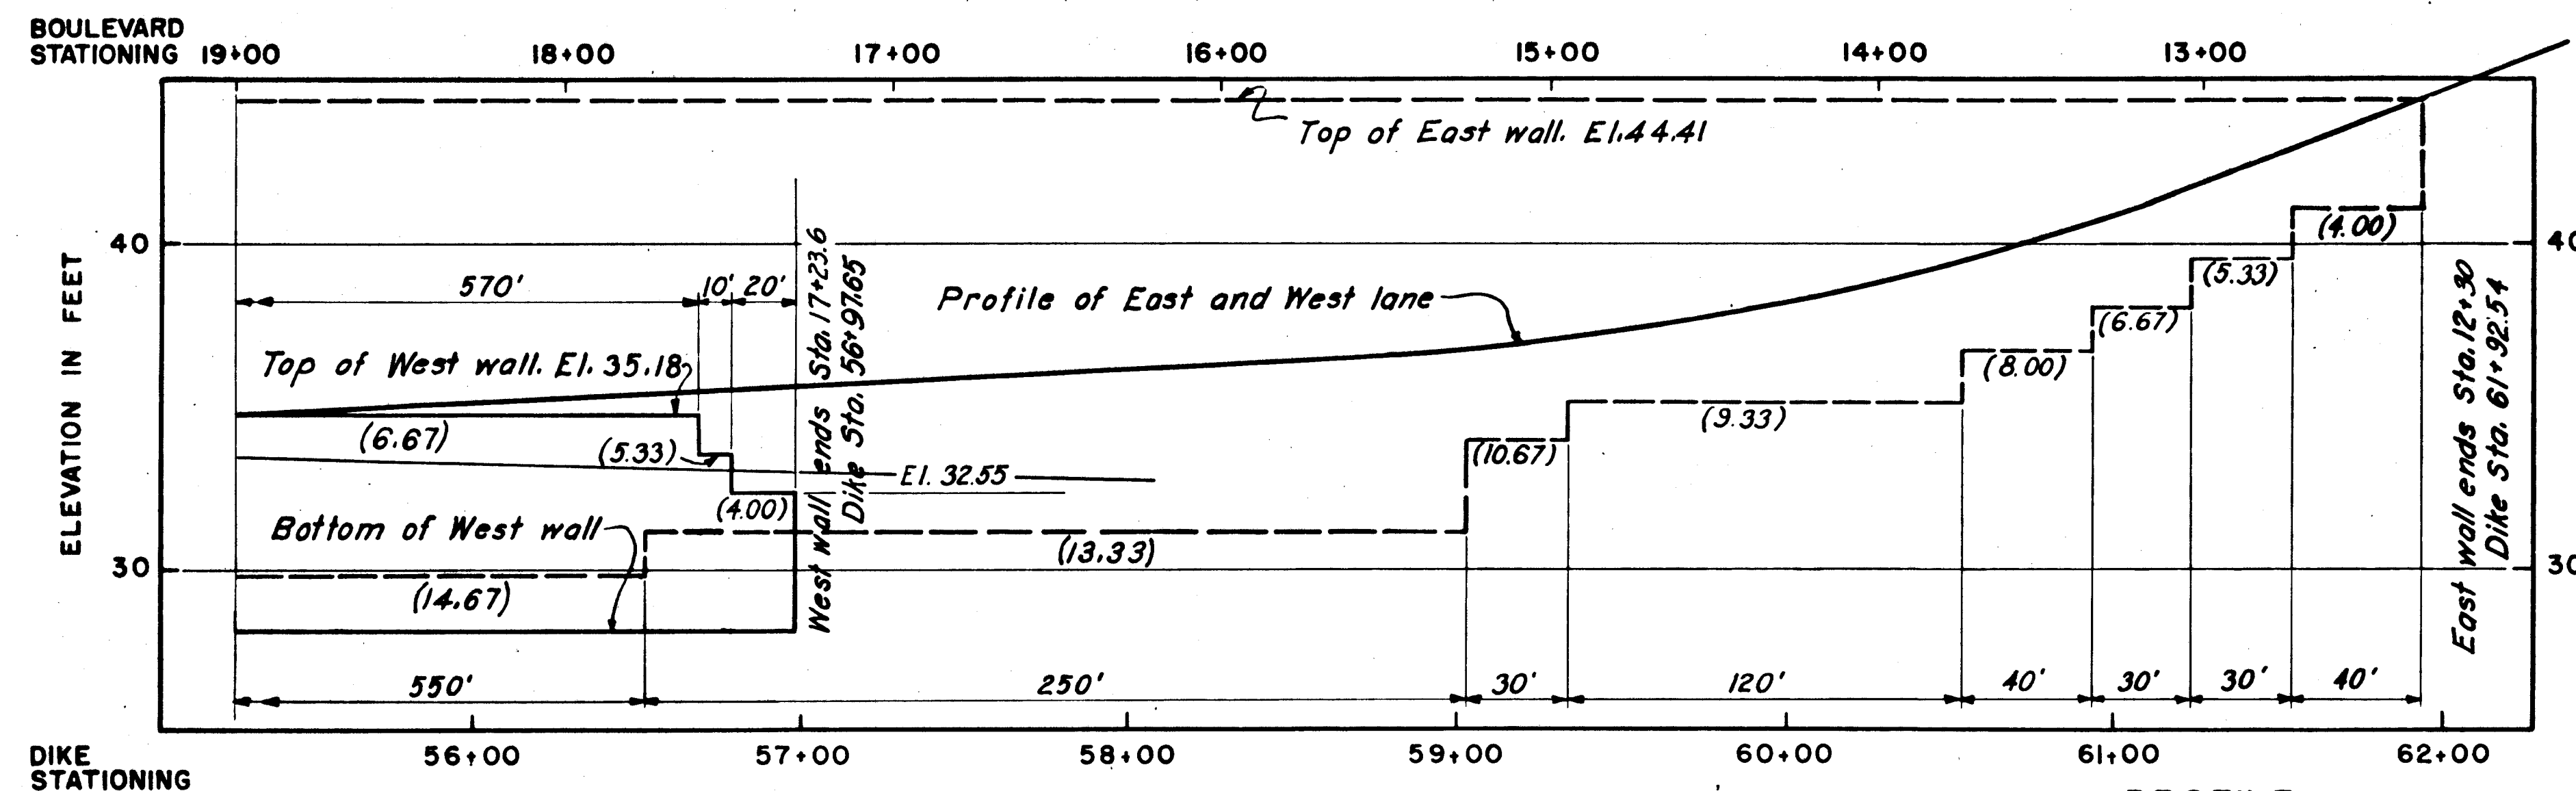


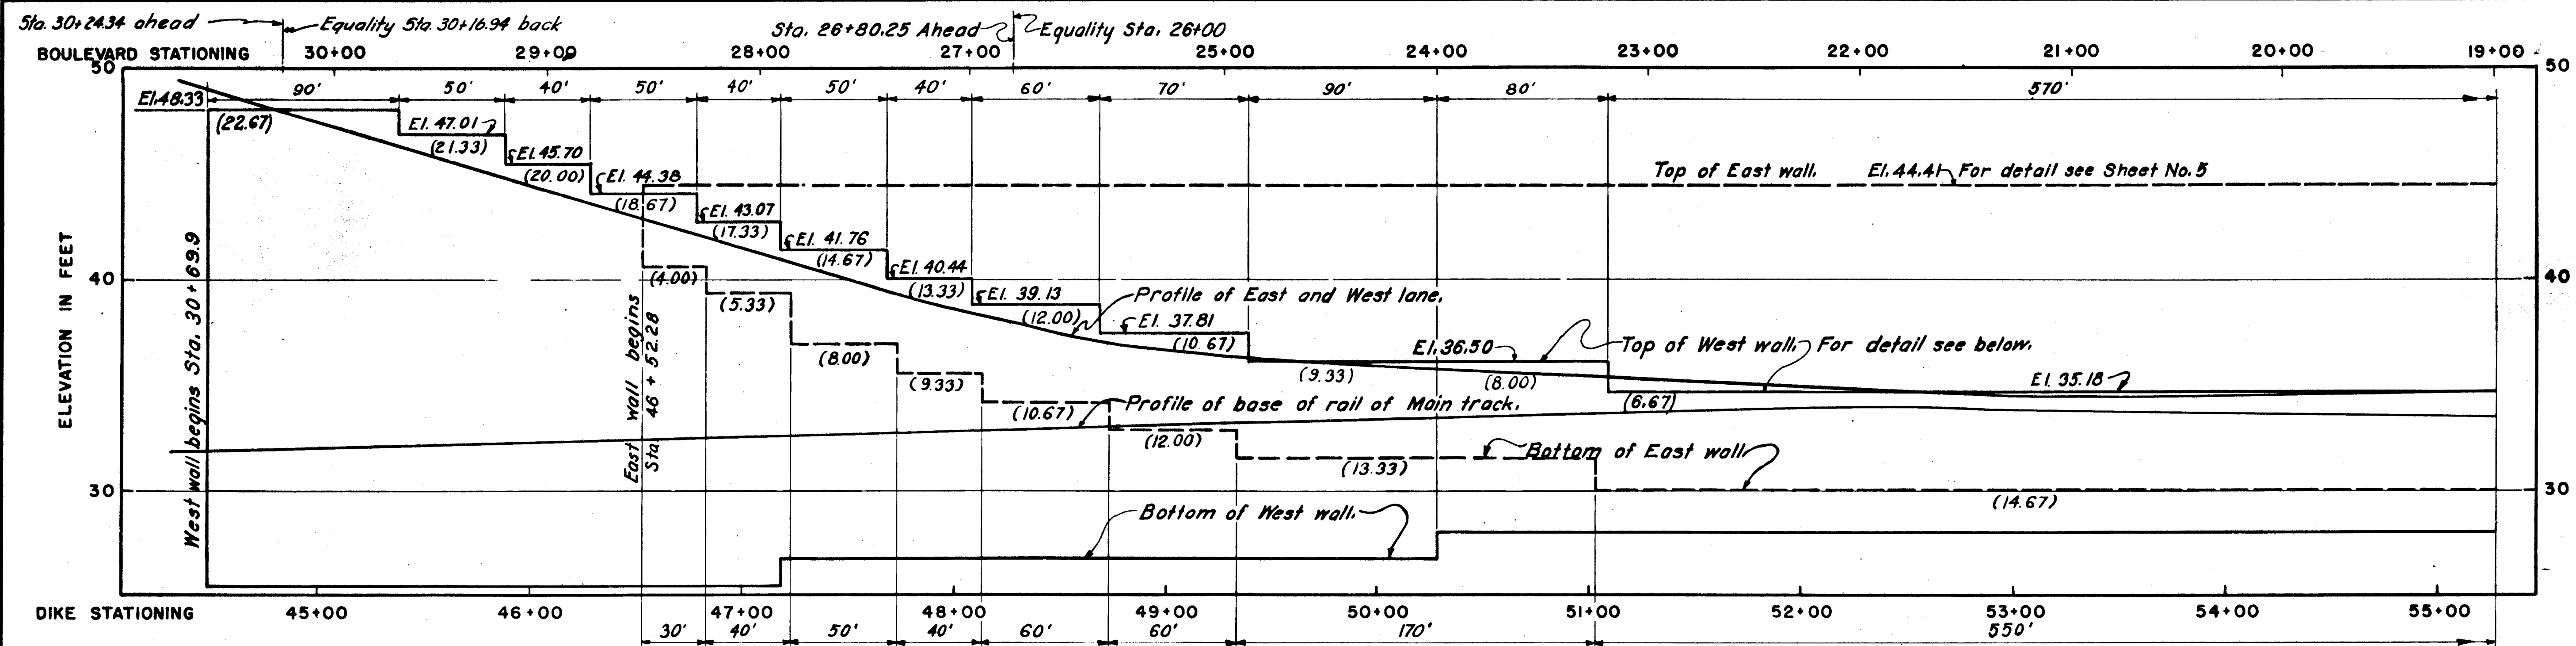

PROFILE

SCALE: HOR. 1" = 40'
VERT. 1" = 4'-0"

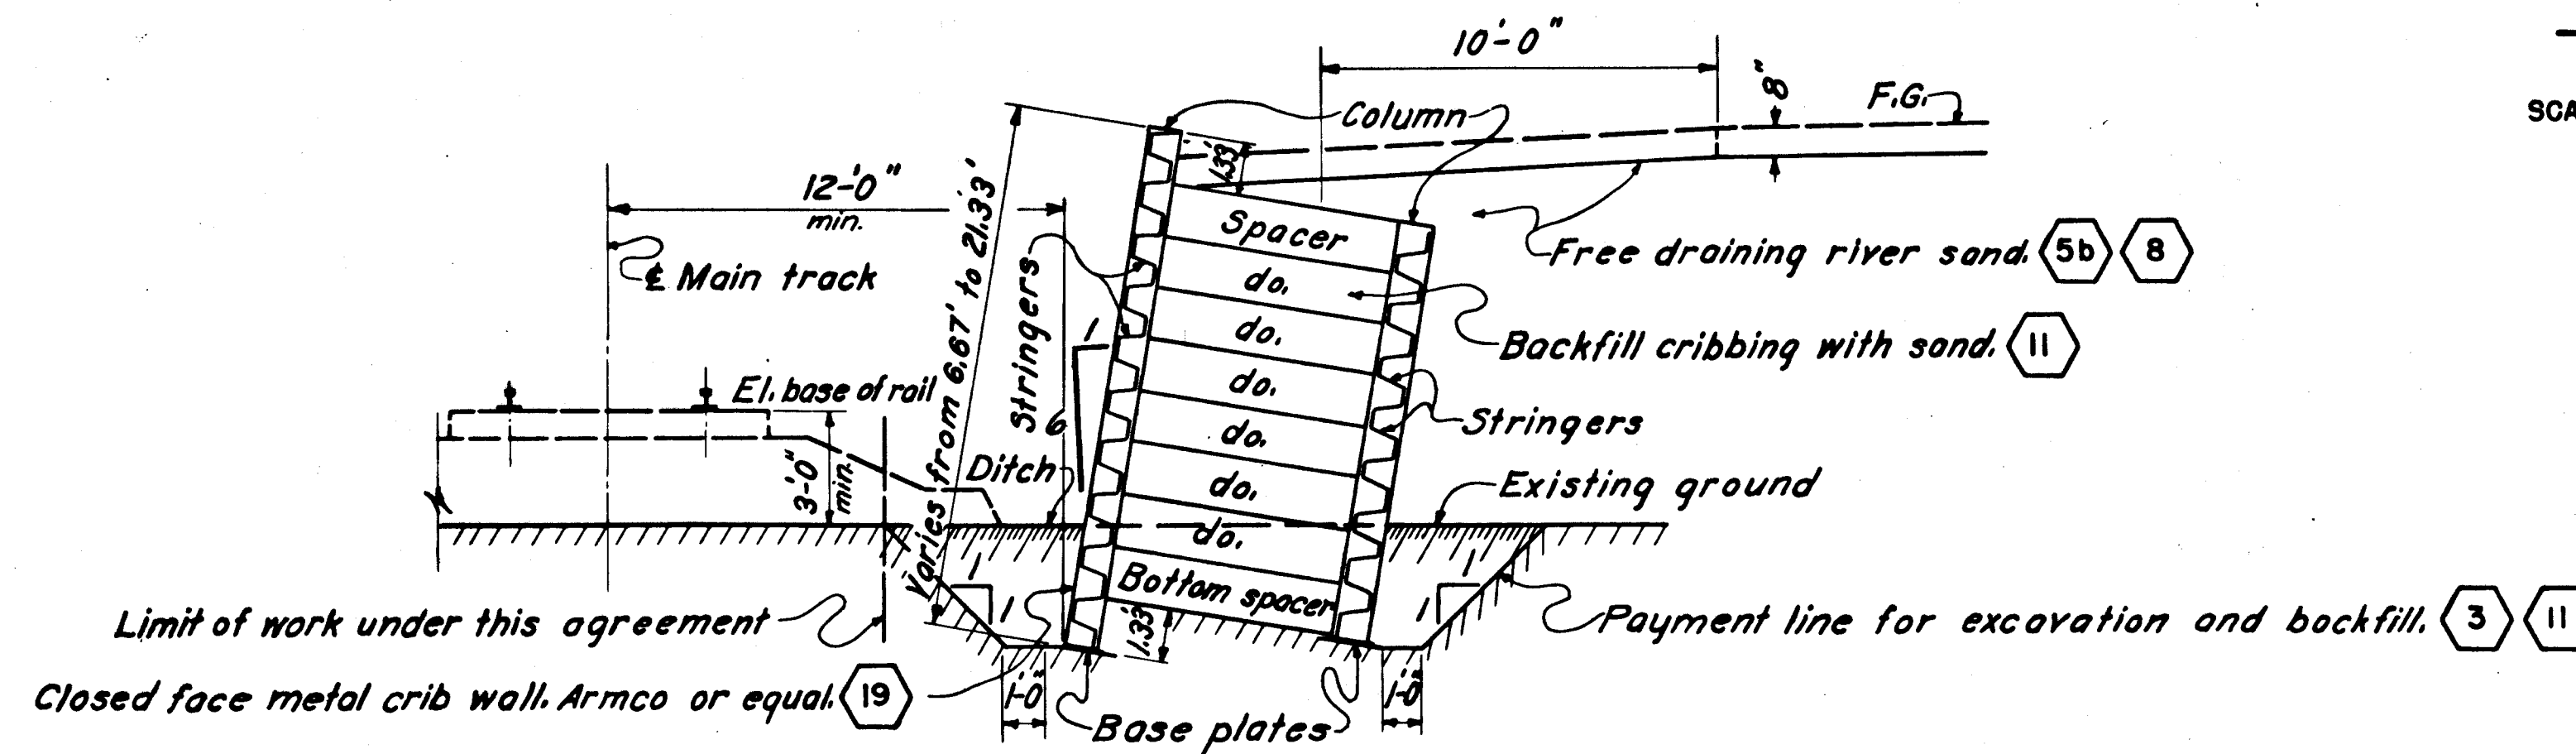

DETAIL OF WEST WALL

NOTES

All elevations refer to Mean Sea Level Datum.

Dimensions in () denote height of wall measured along the face.

CONNECTICUT RIVER FLOOD CONTROL			
HARTFORD DIKE			
SUPPLEMENTAL AGREEMENT			
RECONSTRUCTION AT SLIDE STA. 44+45.68 TO STA. 65.00			
PROFILE AND DETAILS OF CRIB WALLS			
CONNECTICUT RIVER		CONNECTICUT	
IN 7 SHEETS		SHEET NO. 7	
U.S. ENGINEER OFFICE, PROVIDENCE, R.I., MARCH 1942			
SUBMITTED	APPROVAL	RECOMMENDED	APPROVED
J. C. Dineen	J. C. Dineen	J. C. Dineen	J. C. Dineen
SENIOR ENGINEER	PRINCIPAL ENGINEER	CHIEF, ENGINEERING DIV.	CORPS OF ENGINEERS
DESIGNED BY	DRAWN BY	TRACED BY	CHECKED BY
P. C. Henscomb	D. W. C.	S. J. P.	FILE NO. CT-4-3127
ASSOC. ENGINEER	CHECKED	FILE NO.	

KEY	DATE	REVISION (Indicated by Δ)	REV. BY	CK. BY	AP. BY
	12-31-45	As built revisions			