
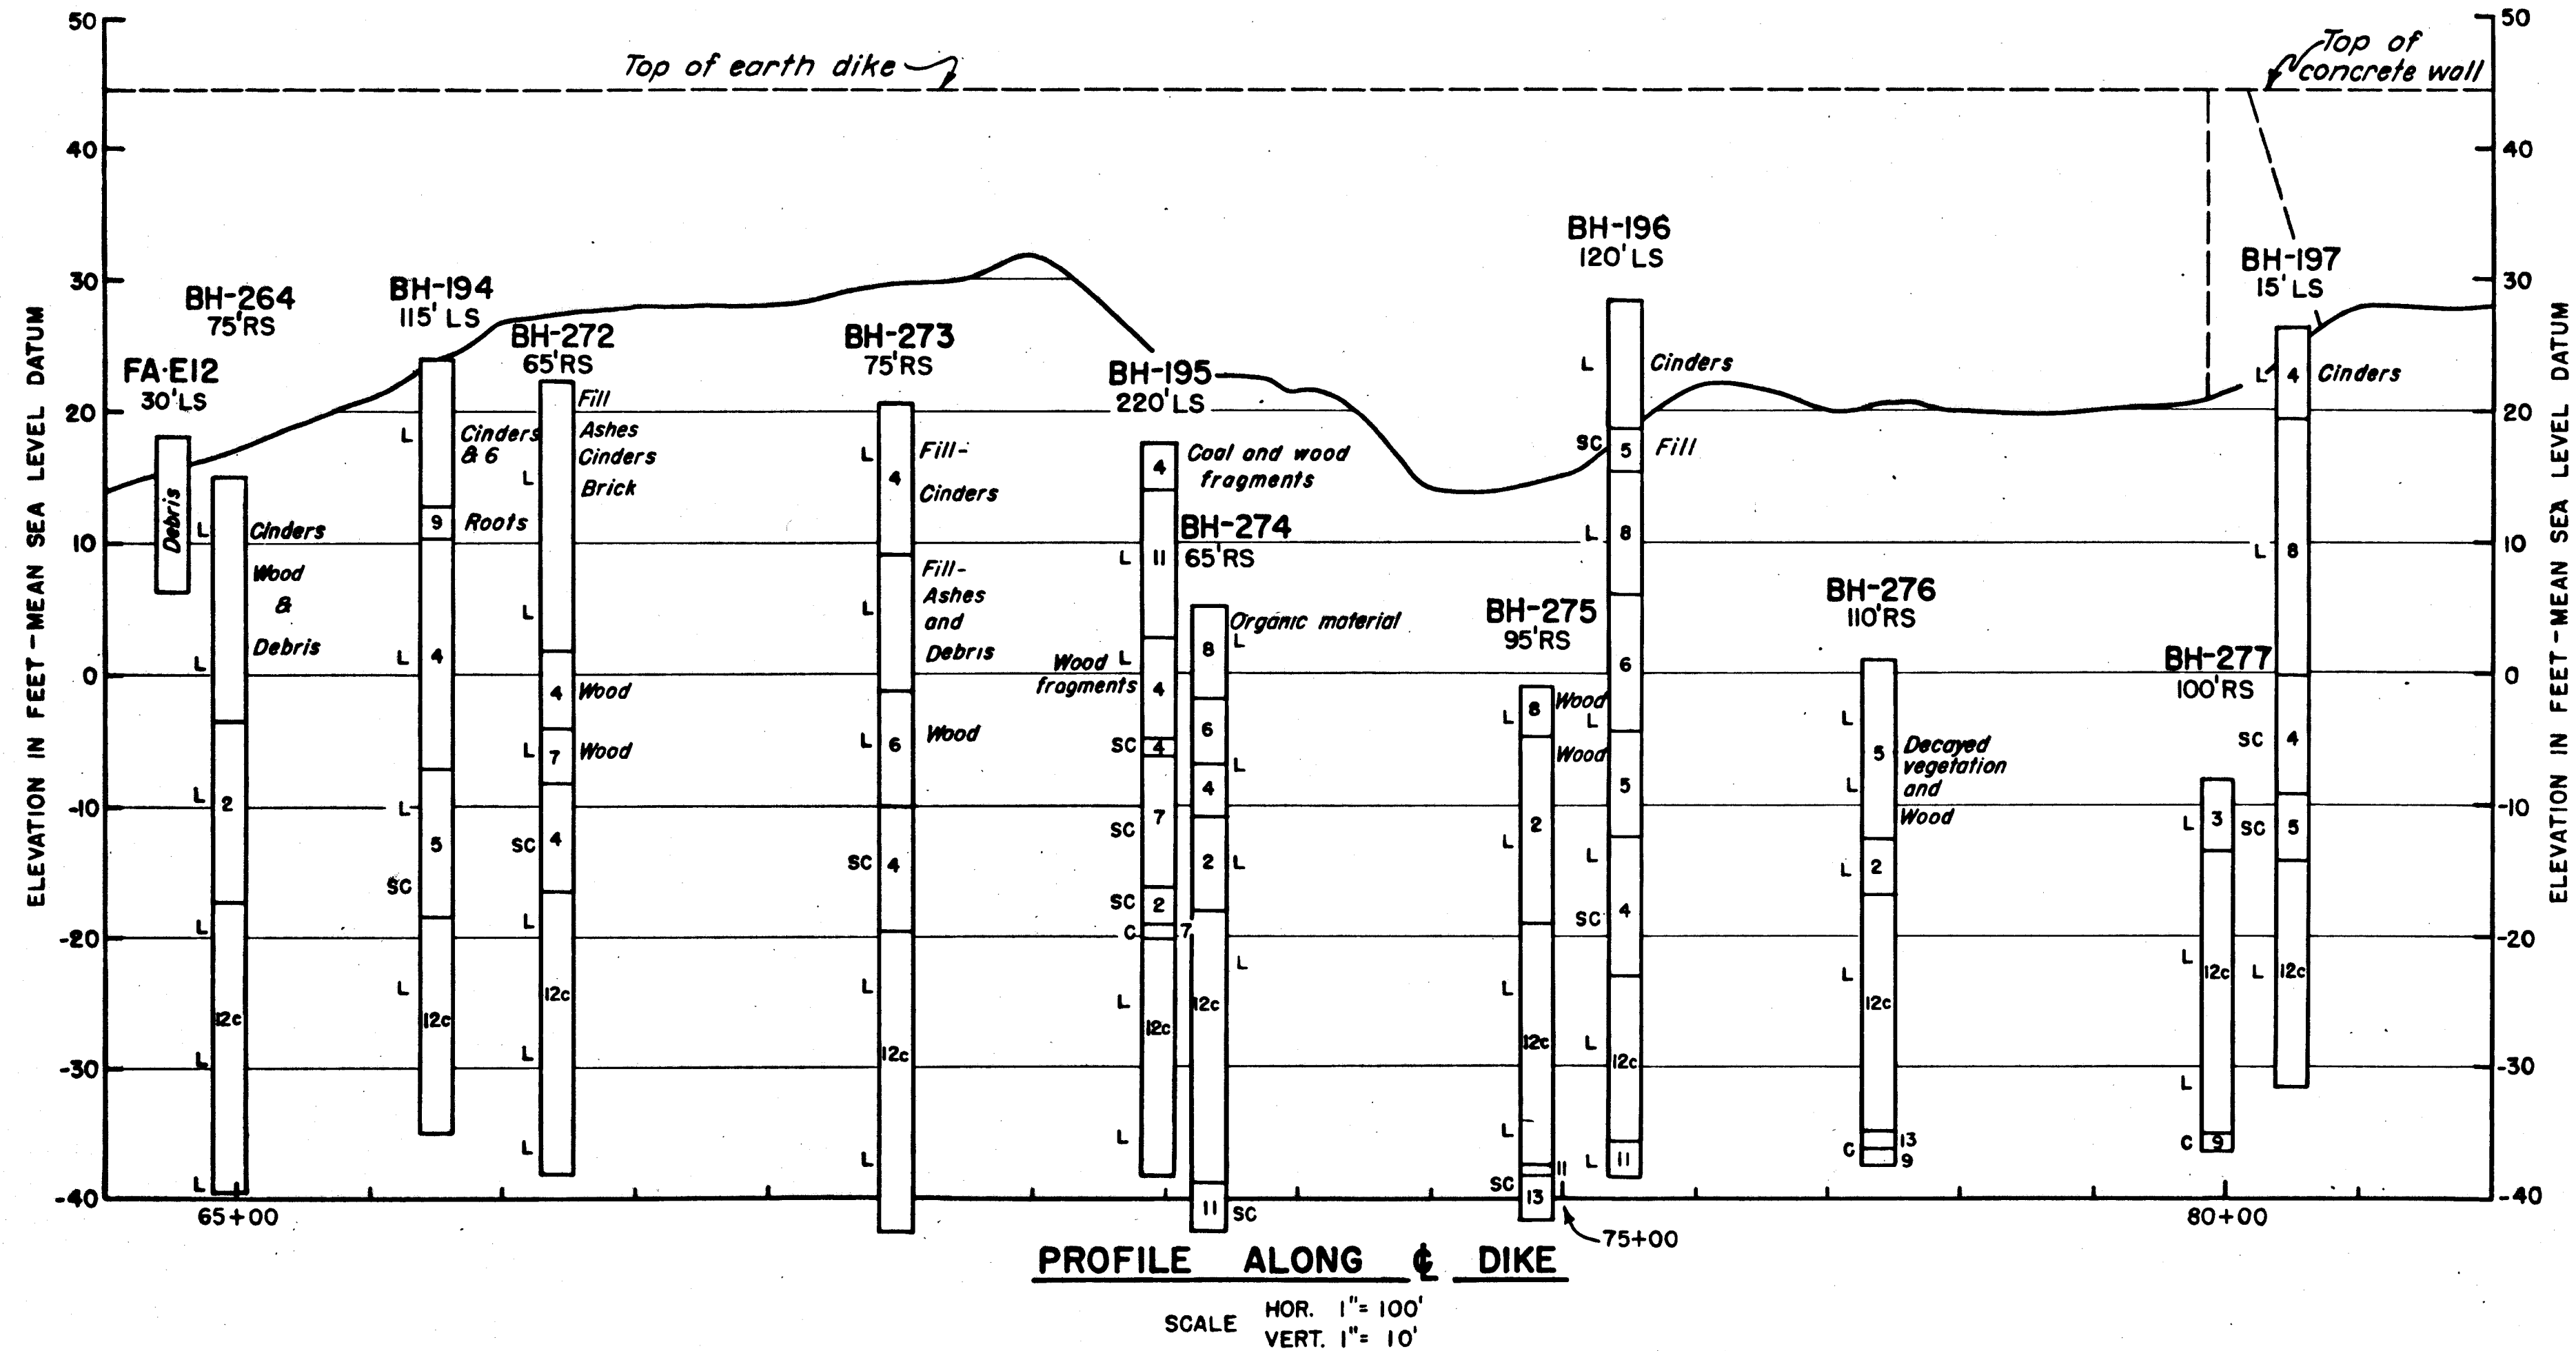


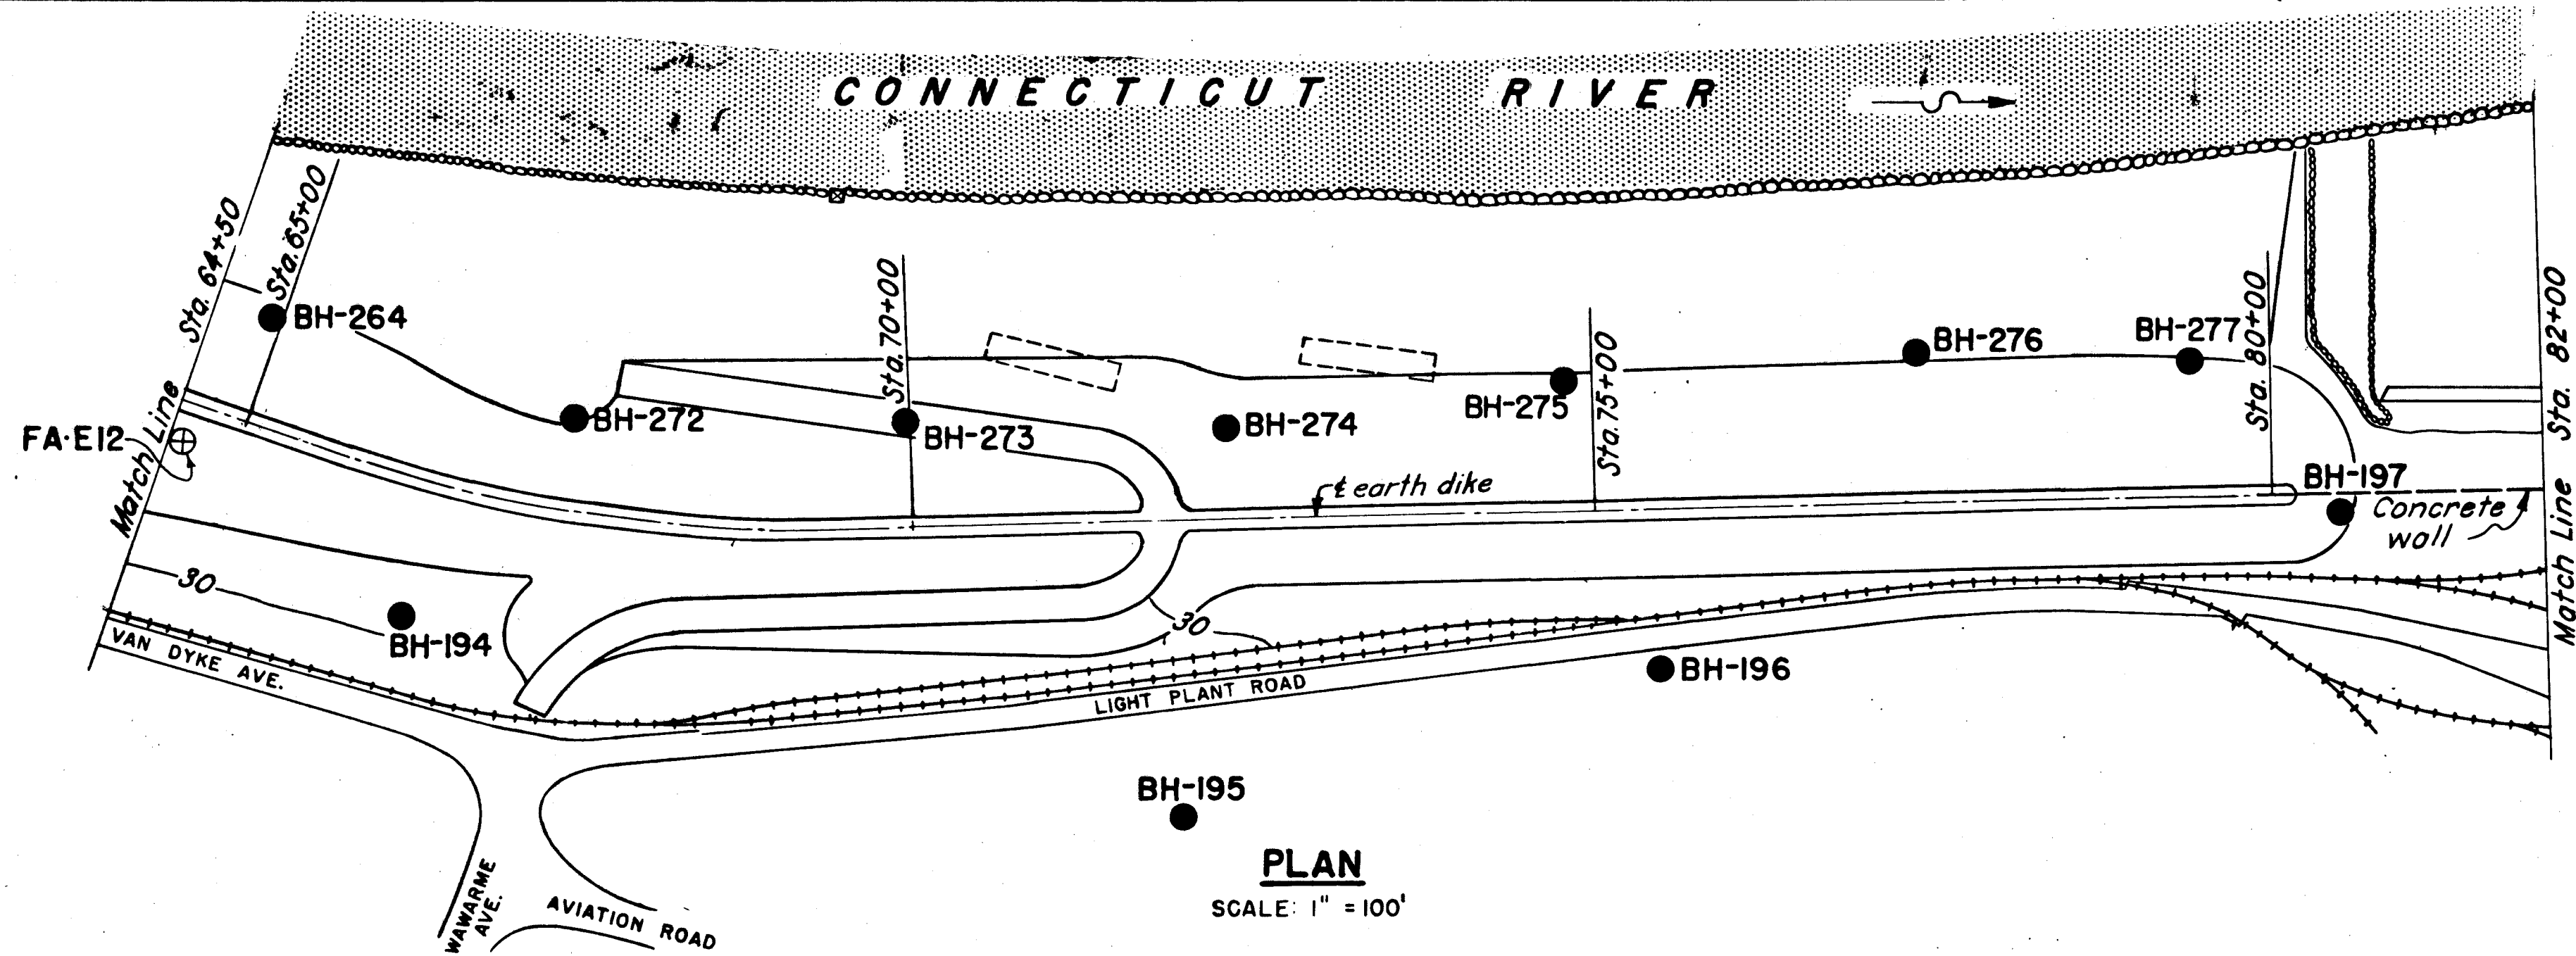

NOTE
For general notes, legend, and description of soil classes see Sheet No. 7.

CONNECTICUT RIVER FLOOD CONTROL			
HARTFORD DIKE			
RIVERFRONT, MORGAN ST. TO STA. 96+73			
SUBSURFACE EXPLORATIONS NO. 4			
CONNECTICUT RIVER		CONNECTICUT	
1 IN 135 SHEETS	SCALE: 1 IN. = 100 FT.	SHEET NO. 8	
U. S. ENGINEER OFFICE, PROVIDENCE, R. I., MAY 1940			
SUBMITTED: <i>Frank J. Felt</i>		APPROVED: <i>W. J. Surma</i>	
HEAD, GEOLOGY SECTION		CHIEF, F. O. ENGINEERING DIV.	
COMPILED: <i>W. J. Surma</i>		DRAWN: R. R. L.	
ASST. ENGINEER		CHECKED: <i>W. J. Surma</i>	
FISCAL YEAR 1940		FILE NO. CT-2-1277	

KEY	DATE	REVISION (Indicated by Δ)	REV. BY	CK. BY	AP. BY
	12-31-45	As Built			