



RECORD OF BORE HOLES IN BORROW AREA H

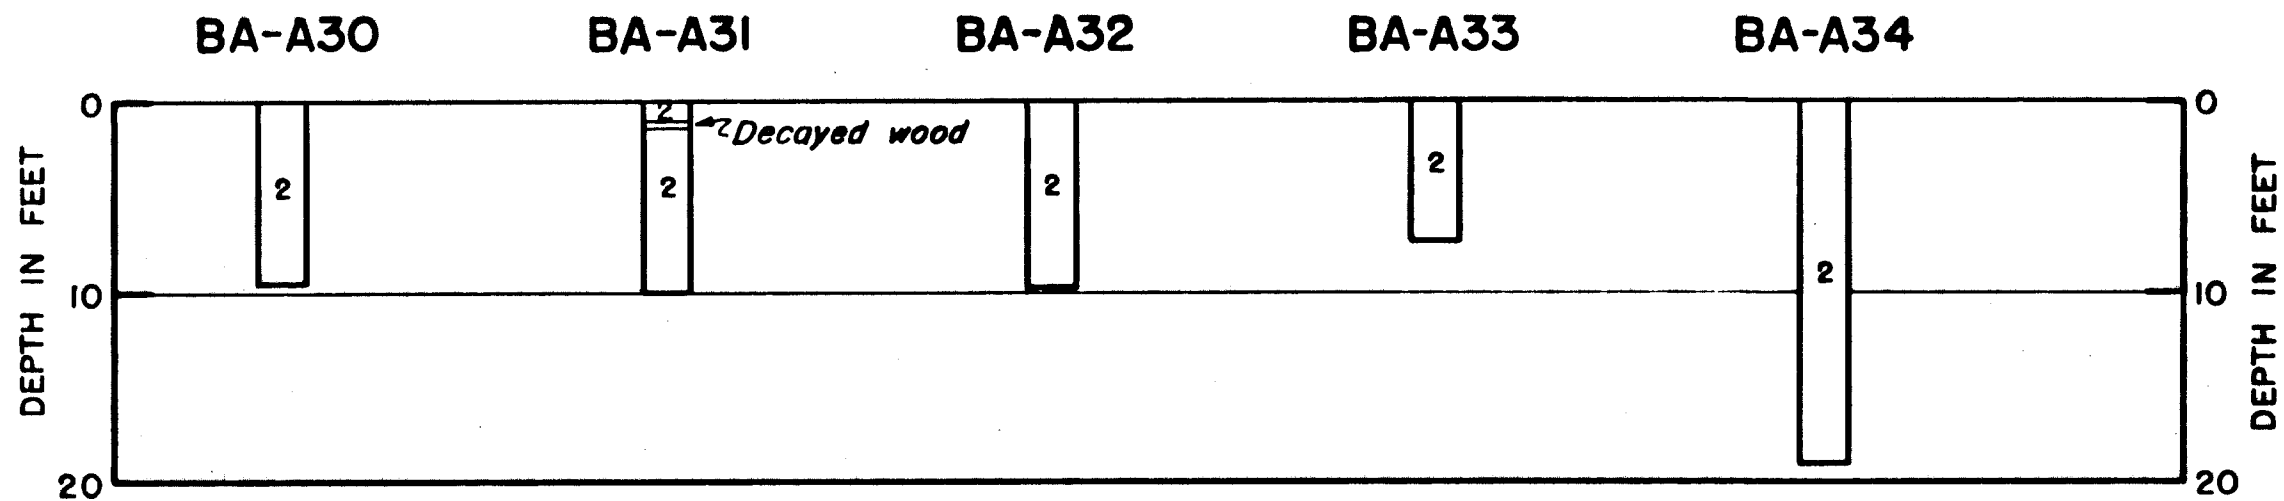

RECORD OF AUGER BORINGS IN BORROW AREA A4

NOTES

For general notes, legend, and description of soil classes see Sheet No. 7.
For locations of explorations see Sheet No. 10.
Shaded areas show limits of suitable borrow.
Elevations refer to Mean Sea Level Datum.
For additional cross-sections in the river, see Sheet No. 11A.

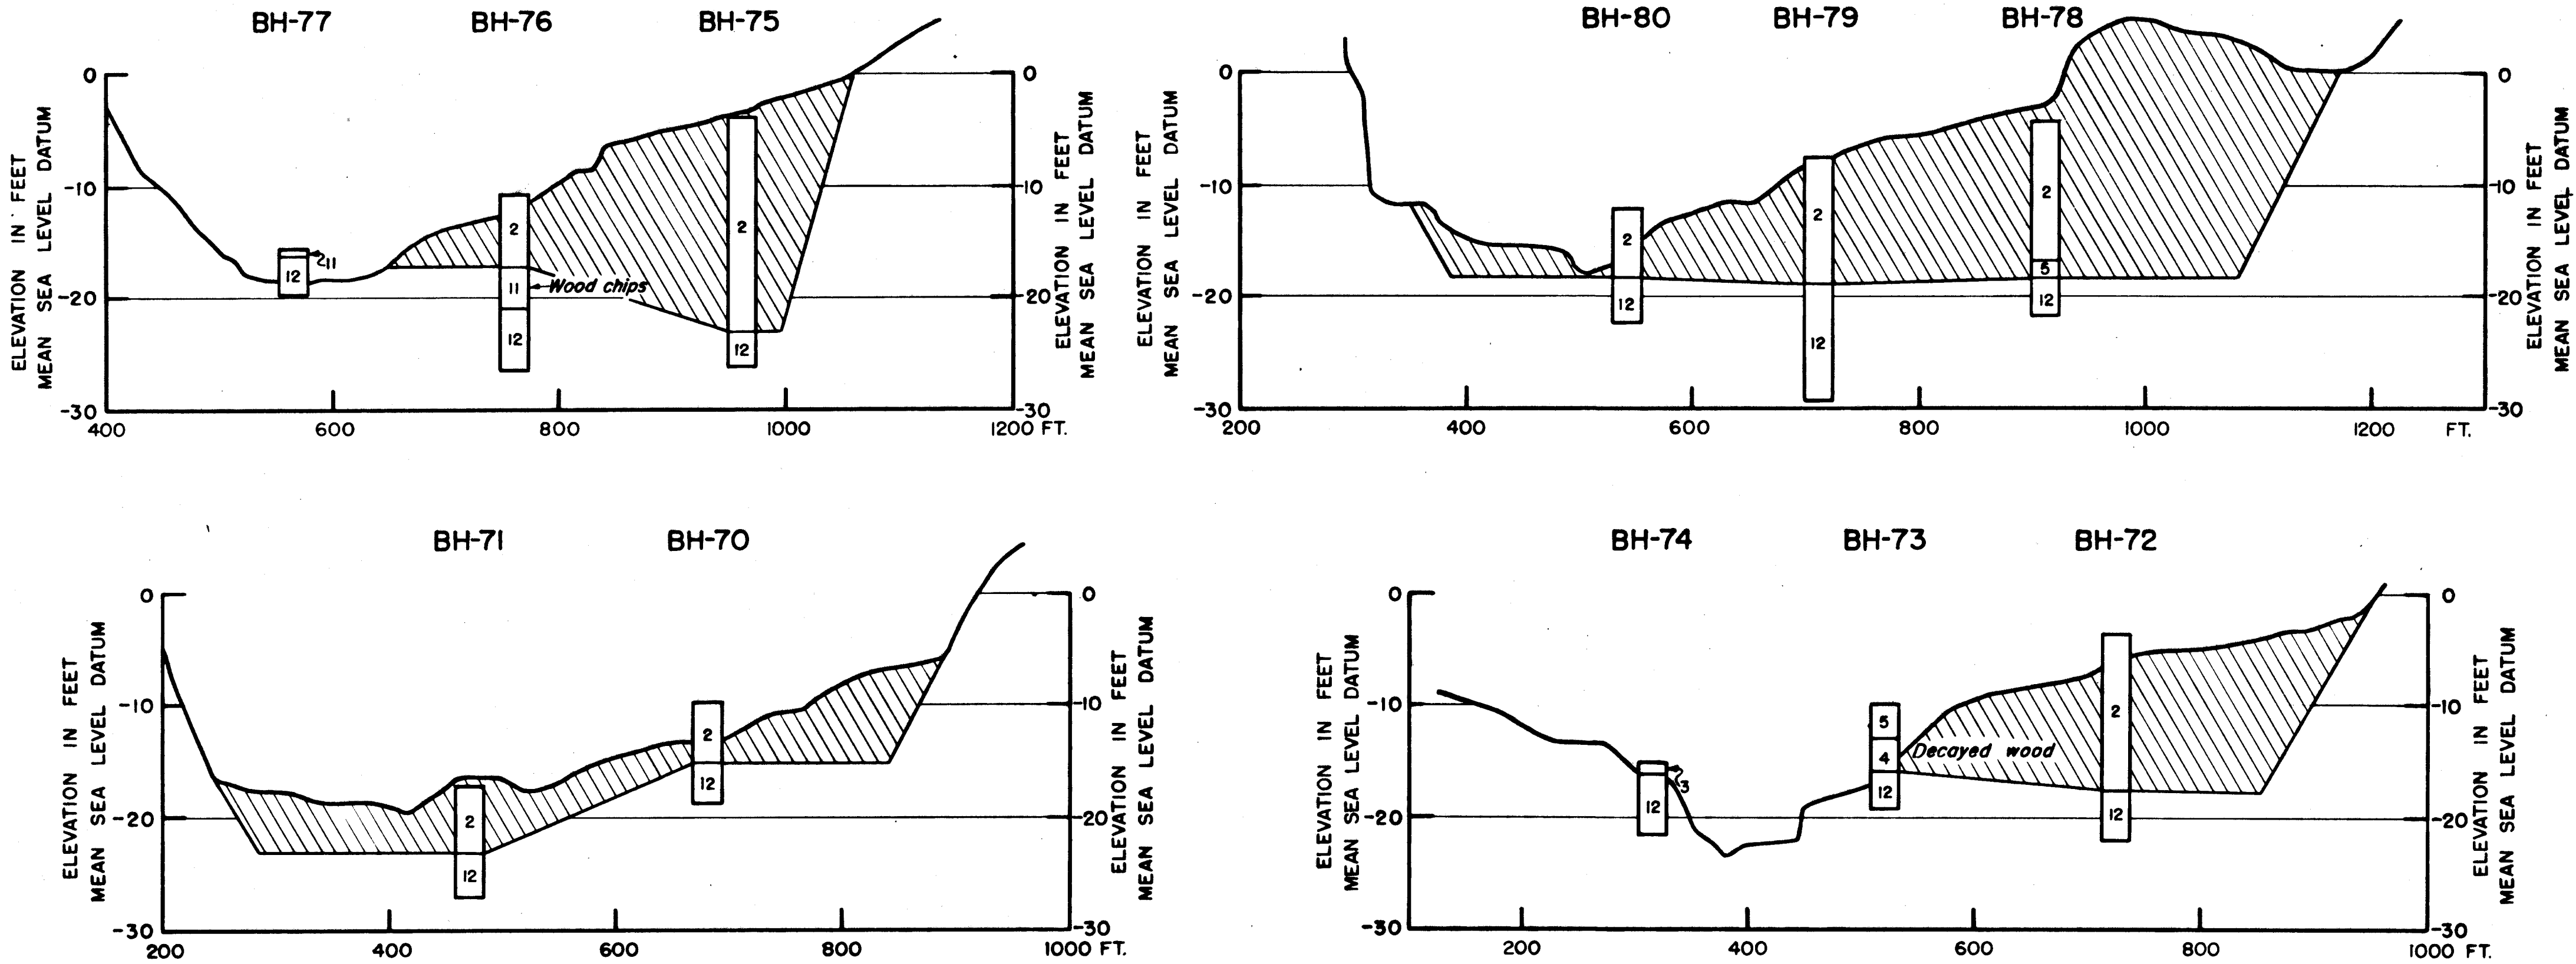

CROSS-SECTIONS IN RIVER - LOOKING UPSTREAM

KEY	DATE	REVISION (Indicated by Δ)	REV. BY	CK. BY	AP. BY
	12-31-45	As Built			

CONNECTICUT RIVER FLOOD CONTROL		
HARTFORD DIKE		
RIVERFRONT, MORGAN ST. TO STA. 96+73		
RECORD OF BORROW EXPLORATIONS		
CONNECTICUT RIVER	CONNECTICUT	
1135 SHEETS	SHEET NO. 11	
U.S. ENGINEER OFFICE, PROVIDENCE, R.I., MAY 1940		
SUBMITTED: <i>Frank J. Johnson</i>	APPROVAL RECOMMENDED: <i>W. B. Burns</i>	APPROVED: <i>W. B. Burns</i>
SENIOR GEOLOGIST	PRINCIPAL ENGINEER	CHIEF, F.O. ENGINEERING DIV.
HEAD, GEOLOGY SECTION	CHIEF, F.O. ENGINEERING DIV.	DISTRICT ENGINEER
COMPILED: <i>W. B. Burns</i>	DRAWN: J. NCL - P.H.S.	FISCAL YEAR 1940
ASST. ENGINEER	CHECKED: <i>W. B. Burns</i>	FILE NO. CT-2-1280