



CONNECTICUT RIVER

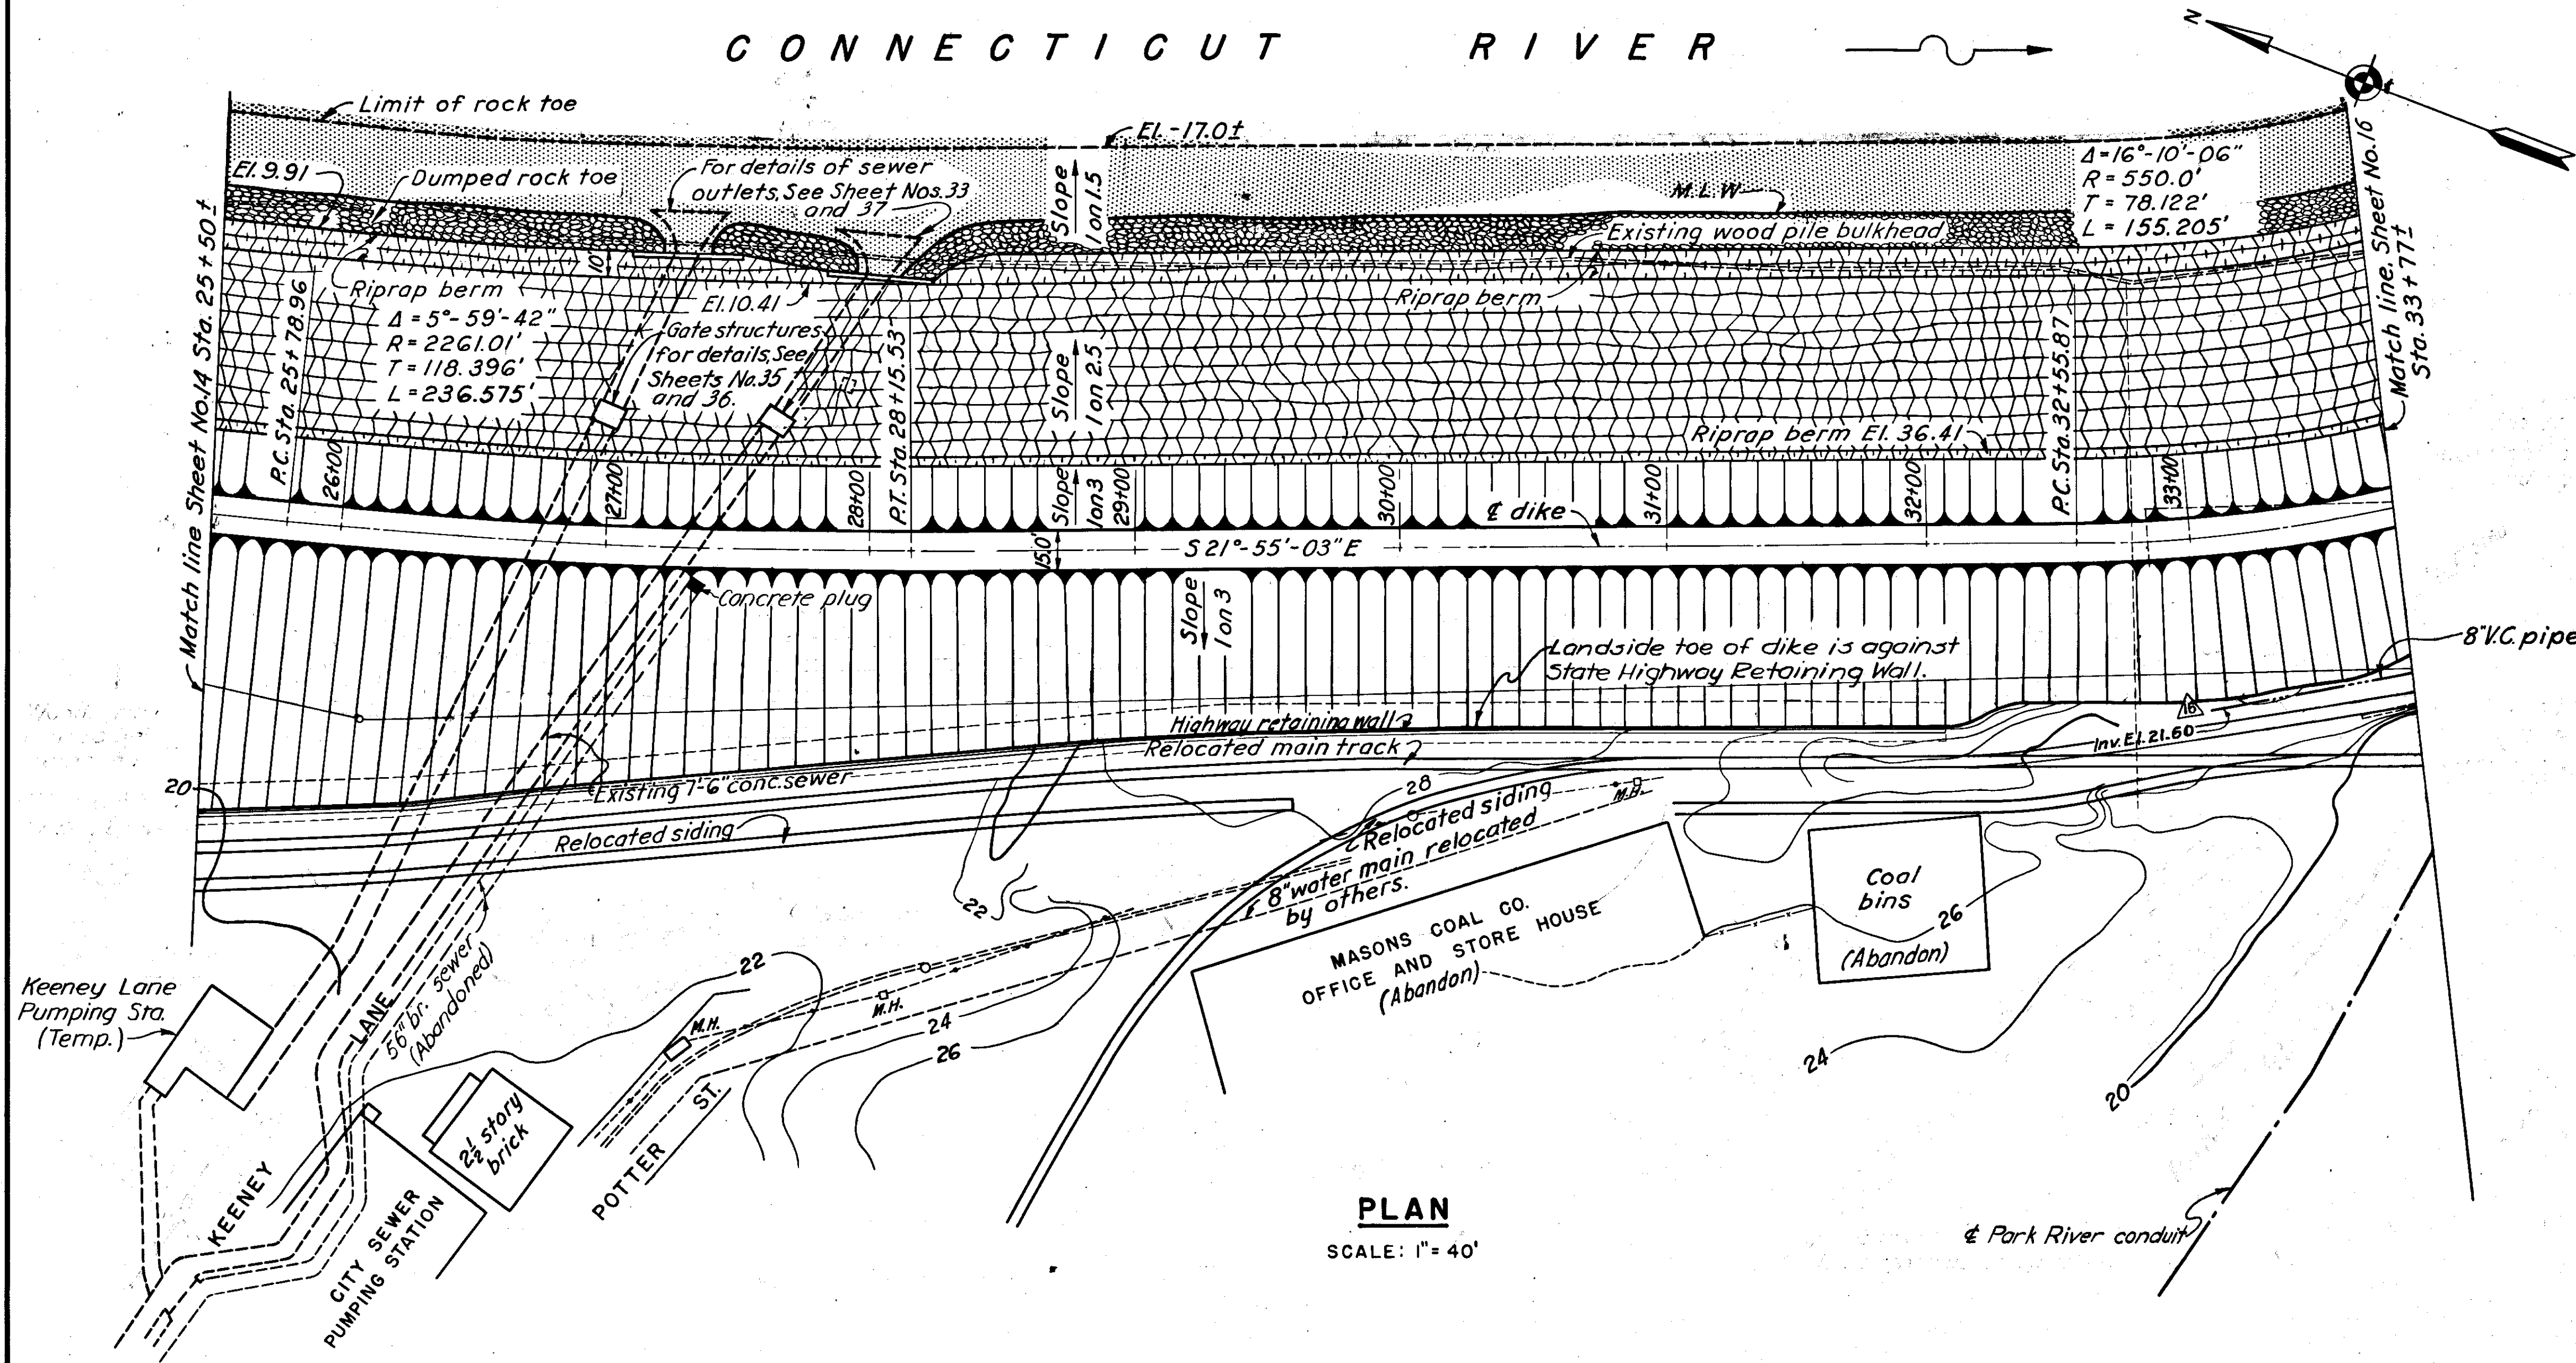

PLAN

SCALE: 1" = 40'

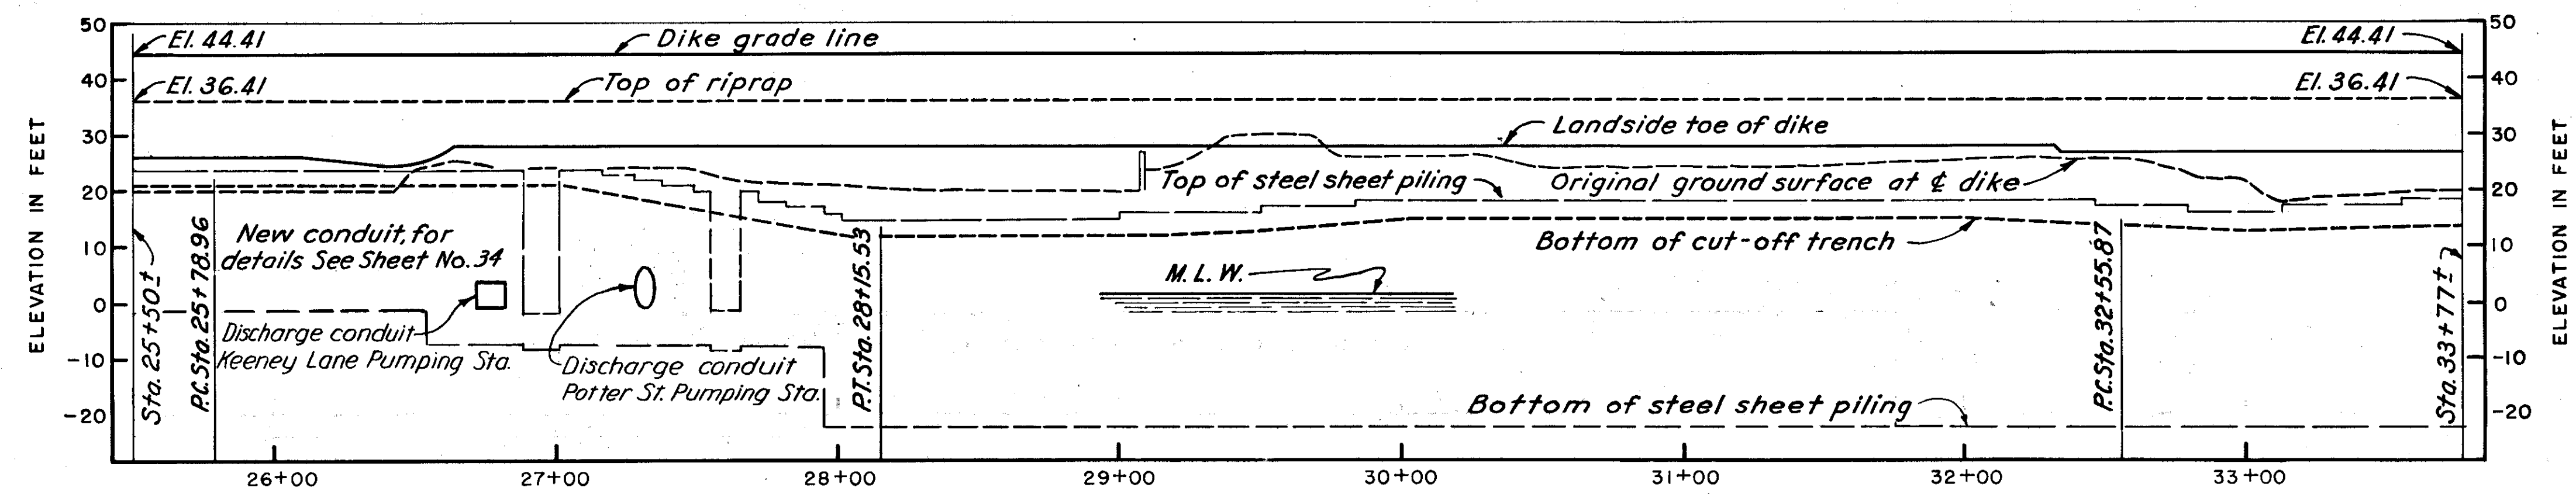

PROFILE

SCALE: HOR., 1" = 40'
VERT., 1" = 20'

STATION COORDINATES		
STATION	NORTHINGS	EASTINGS
PC Sta. 25+78.96	N 50169.95	E 70842.42
PT Sta. 28+15.53	N 49946.25	E 70919.09
PC Sta. 32+55.87	N 49537.75	E 71083.46

NOTES
56" brick sewer, and 18" brick sewer filled with sand and plugged as directed by the contracting officer.
For general notes applying to this sheet, see Sheet No. 12.

CONNECTICUT RIVER FLOOD CONTROL		
HARTFORD DIKE		
RIVERFRONT, MORGAN ST. TO STA. 97+05		
PLAN AND PROFILE NO. 4		
CONNECTICUT RIVER	SCALE: 1" = 40 FT.	CONNECTICUT
IN 135 SHEETS	40' 0' 40'	SHEET NO. 15
U.S. ENGINEER OFFICE, PROVIDENCE, R.I., MAY 1940		
SUBMITTED: <i>Wm. B. S. Sew</i>	APPROVAL RECOMMENDED: <i>W. B. S. Sew</i>	APPROVED: <i>W. B. S. Sew</i>
SENIOR ENGINEER	PRINCIPAL ENGINEER	LOCAL CORPS OF ENGINEERS
HEAD, DESIGN SECTION	CHIEF, F.C. ENGINEERING DIV.	DISTRICT ENGINEER
DESIGNED: <i>J. Hasler</i>	DRAWN: D.W.C.	FISCAL YEAR 1940
ASSOC. ENGINEER	CHECKED: W.O.G.	FILE NO. CT-4-2475

KEY	DATE	REVISION (Indicated by Δ)	REV. BY	CK. BY	AP. BY
Δ	12-31-45	As built revisions			
Δ	9-9-42	Install toe drain			