



CONNECTICUT RIVER

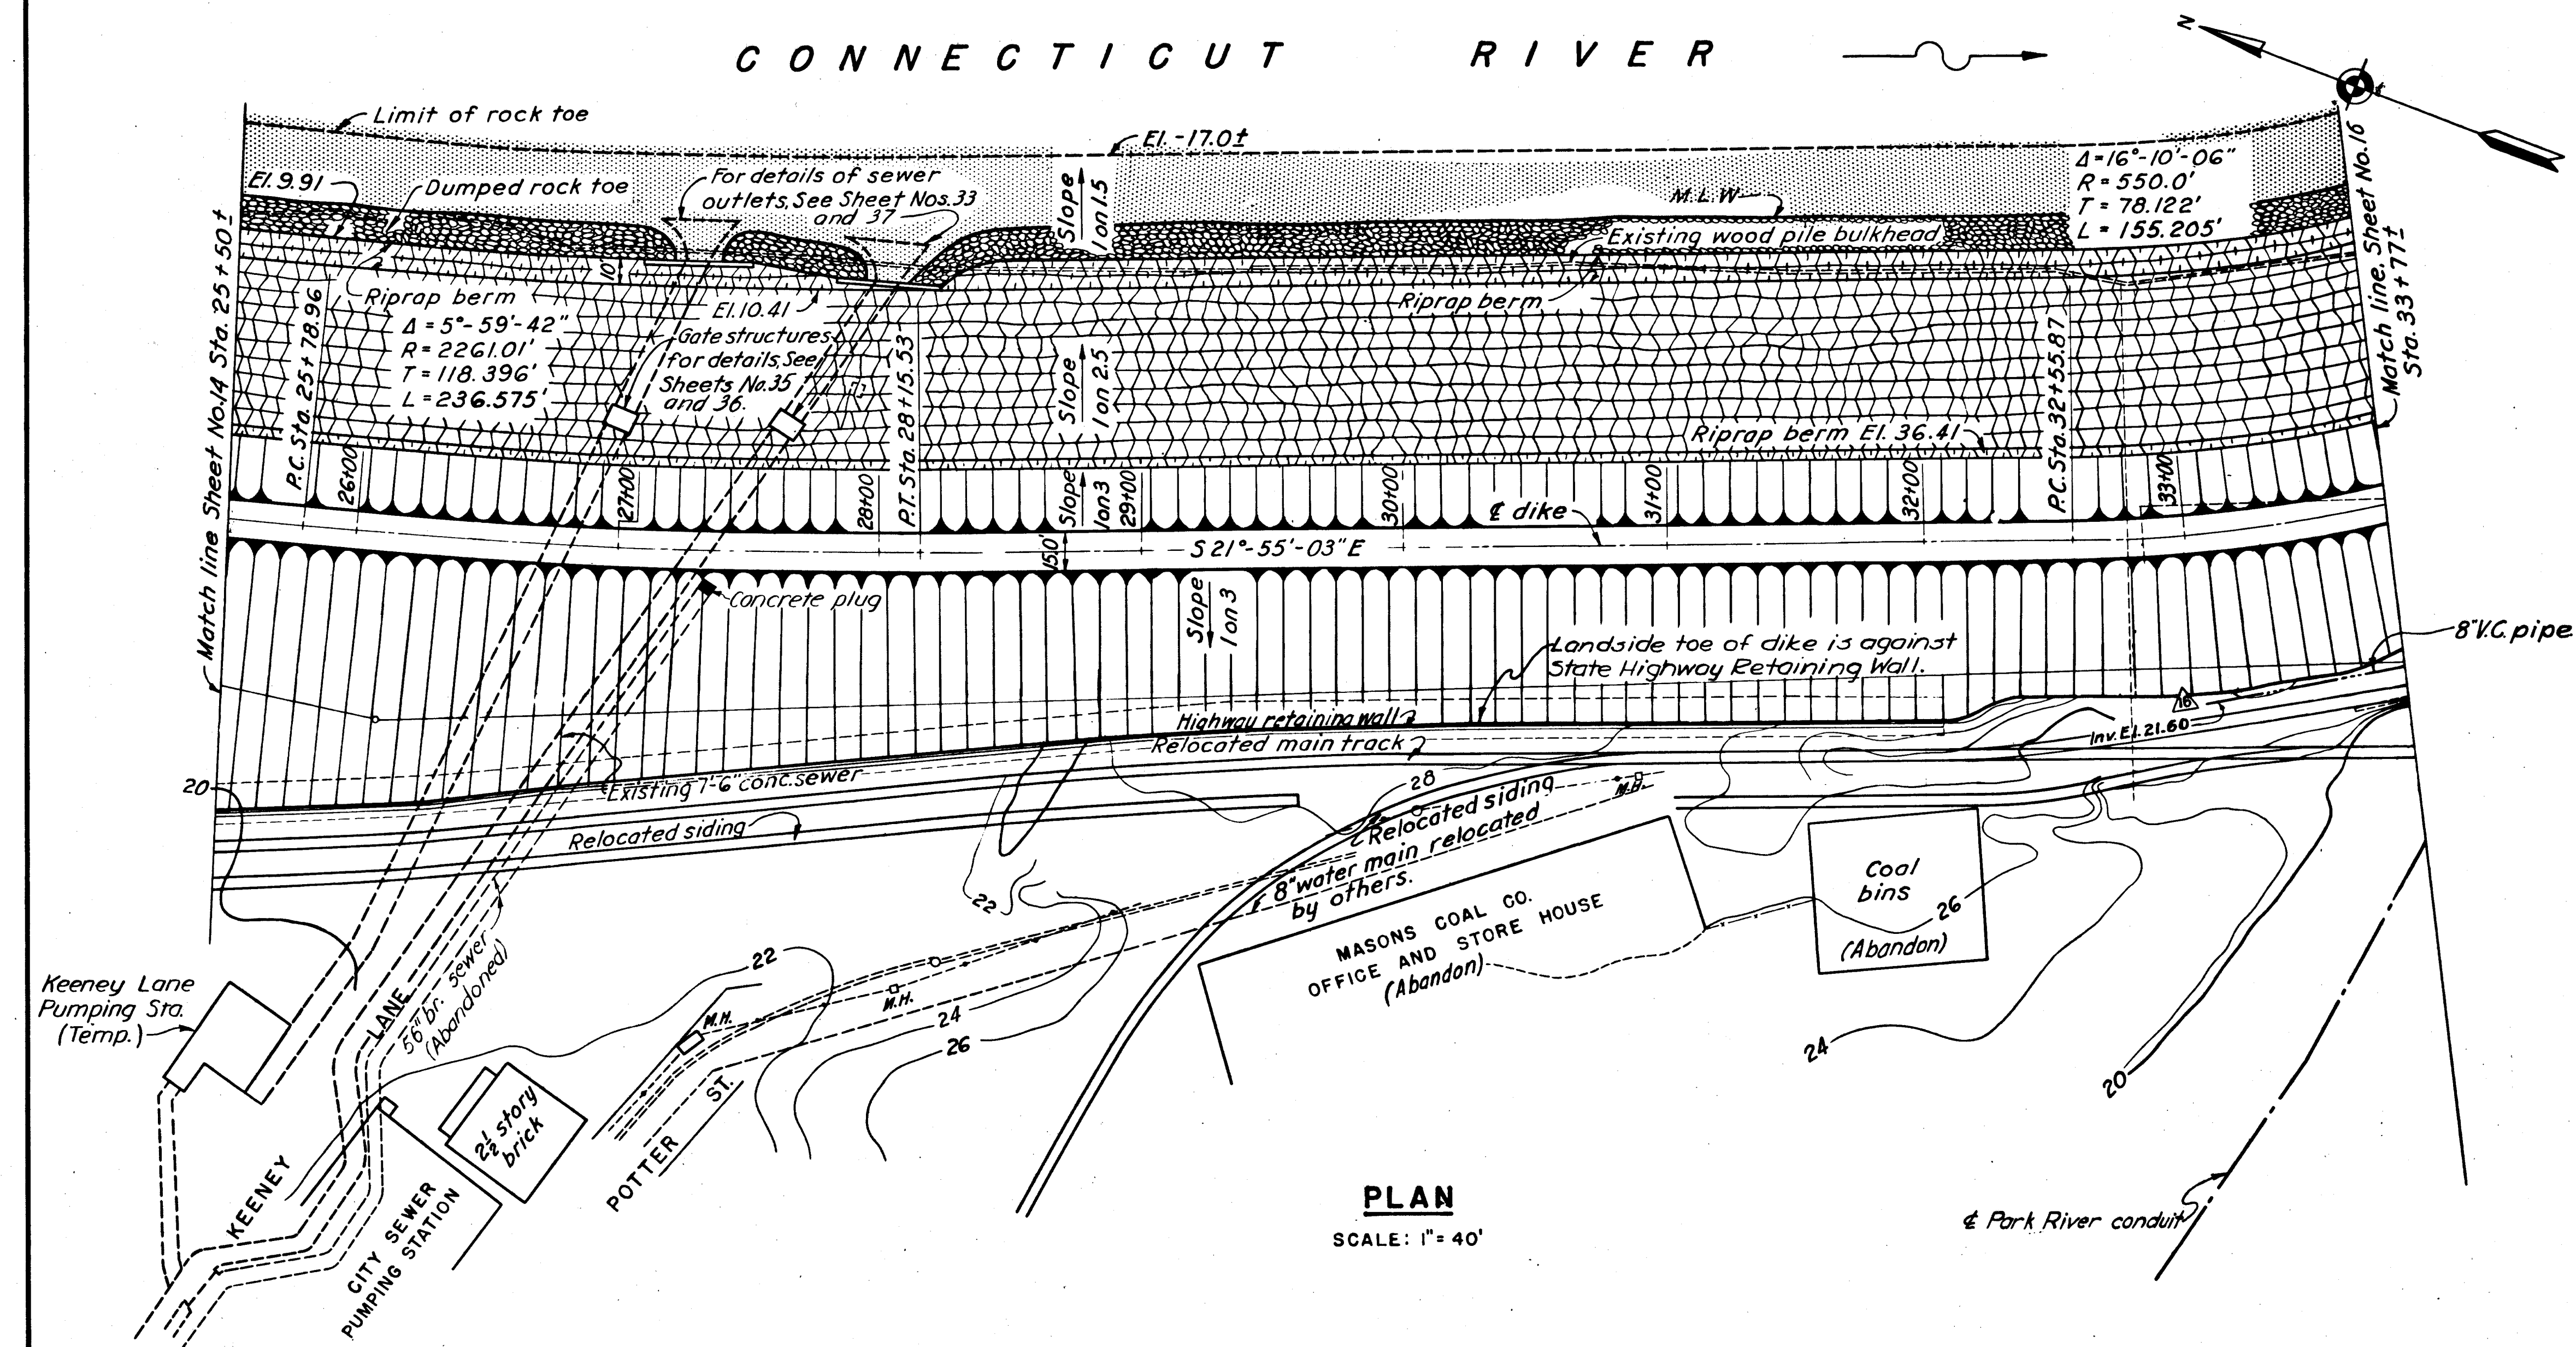

STATION COORDINATES		
STATION	NORTHINGS	EASTINGS
PC Sta. 25+78.96	N50169.95	E 70842.42
PT Sta. 28+15.53	N49946.25	E 70919.09
PC Sta. 32+55.87	N49537.75	E 71083.46

NOTE
 Railroad, sidings and highway retaining wall located approximately only.
 For details see City of Hartford drawings 543/B for R.R.R.O.W. 276/1 to 10 for wall and Highway plans 63-24 for wall.

NOTES
 56" brick sewer, and 18" brick sewer filled with sand and plugged as directed by the contracting officer.
 For general notes applying to this sheet, see Sheet No. 12.

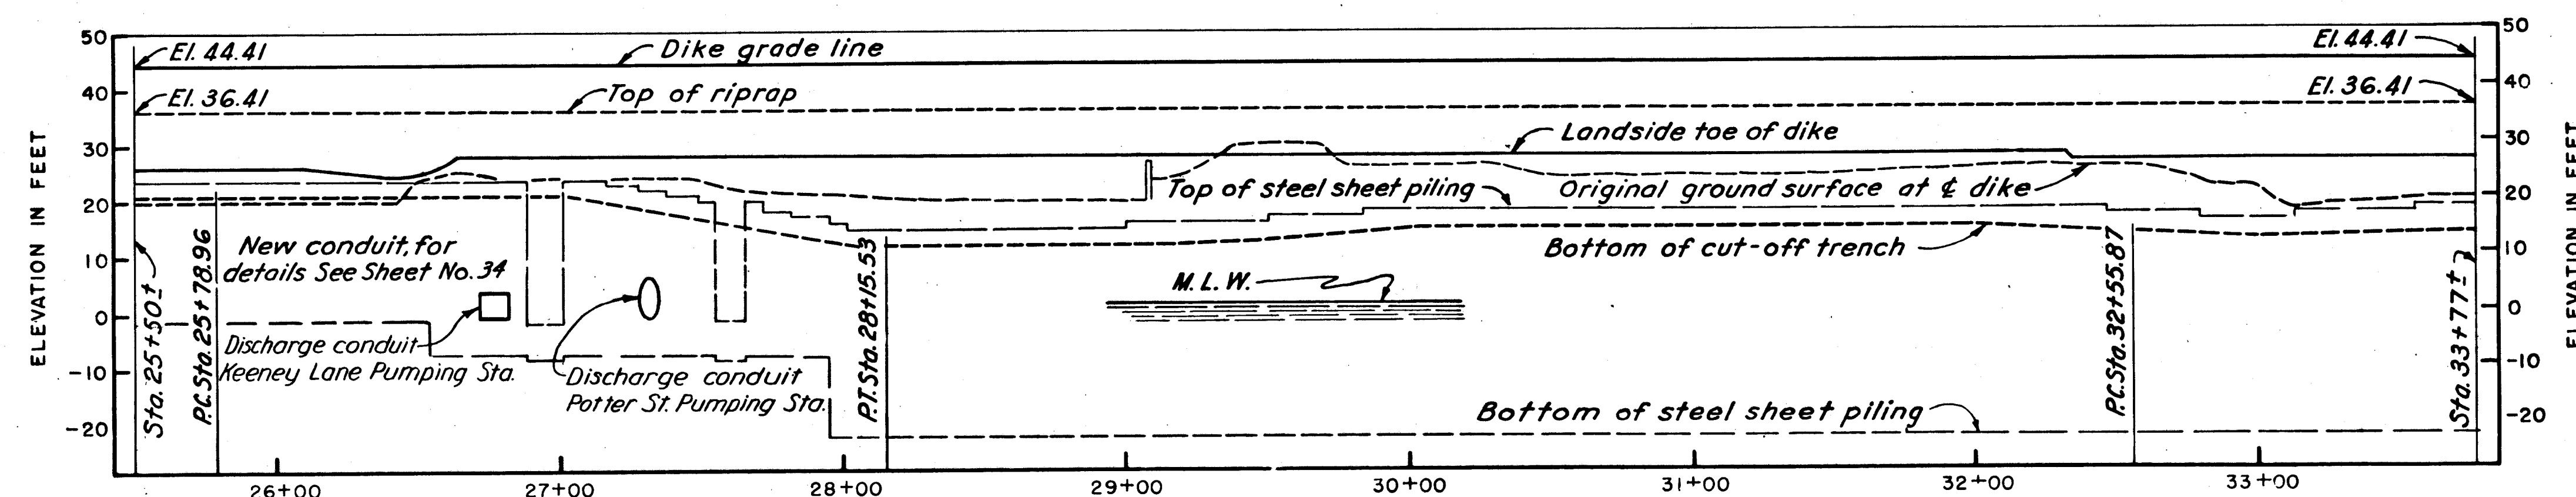

12-31-45	As built revisions				
9-9-42	Install toe drain				
KEY	DATE	REVISION (Indicated by Δ)	REV. BY	CK. BY	AP. BY

CONNECTICUT RIVER FLOOD CONTROL			
HARTFORD DIKE			
RIVERFRONT, MORGAN ST. TO STA. 97+05			
PLAN AND PROFILE NO. 4			
CONNECTICUT RIVER		CONNECTICUT	
IN 135 SHEETS		SHEET NO. 15	
SCALE: 1" = 40'			
U.S. ENGINEER OFFICE, PROVIDENCE, R.I., MAY 1940			
SUBMITTED:	APPROVAL RECOMMENDED:	APPROVED:	
HEAD, DESIGN SECTION	PRINCIPAL ENGINEER	DISTRICT ENGINEER	
DESIGNED:	DRAWN: D.W.C.	FISCAL YEAR 1940	
ASSOC. ENGINEER	CHECKED: LJOE	FILE NO. CT-4-2475	