



CONNECTICUT RIVER

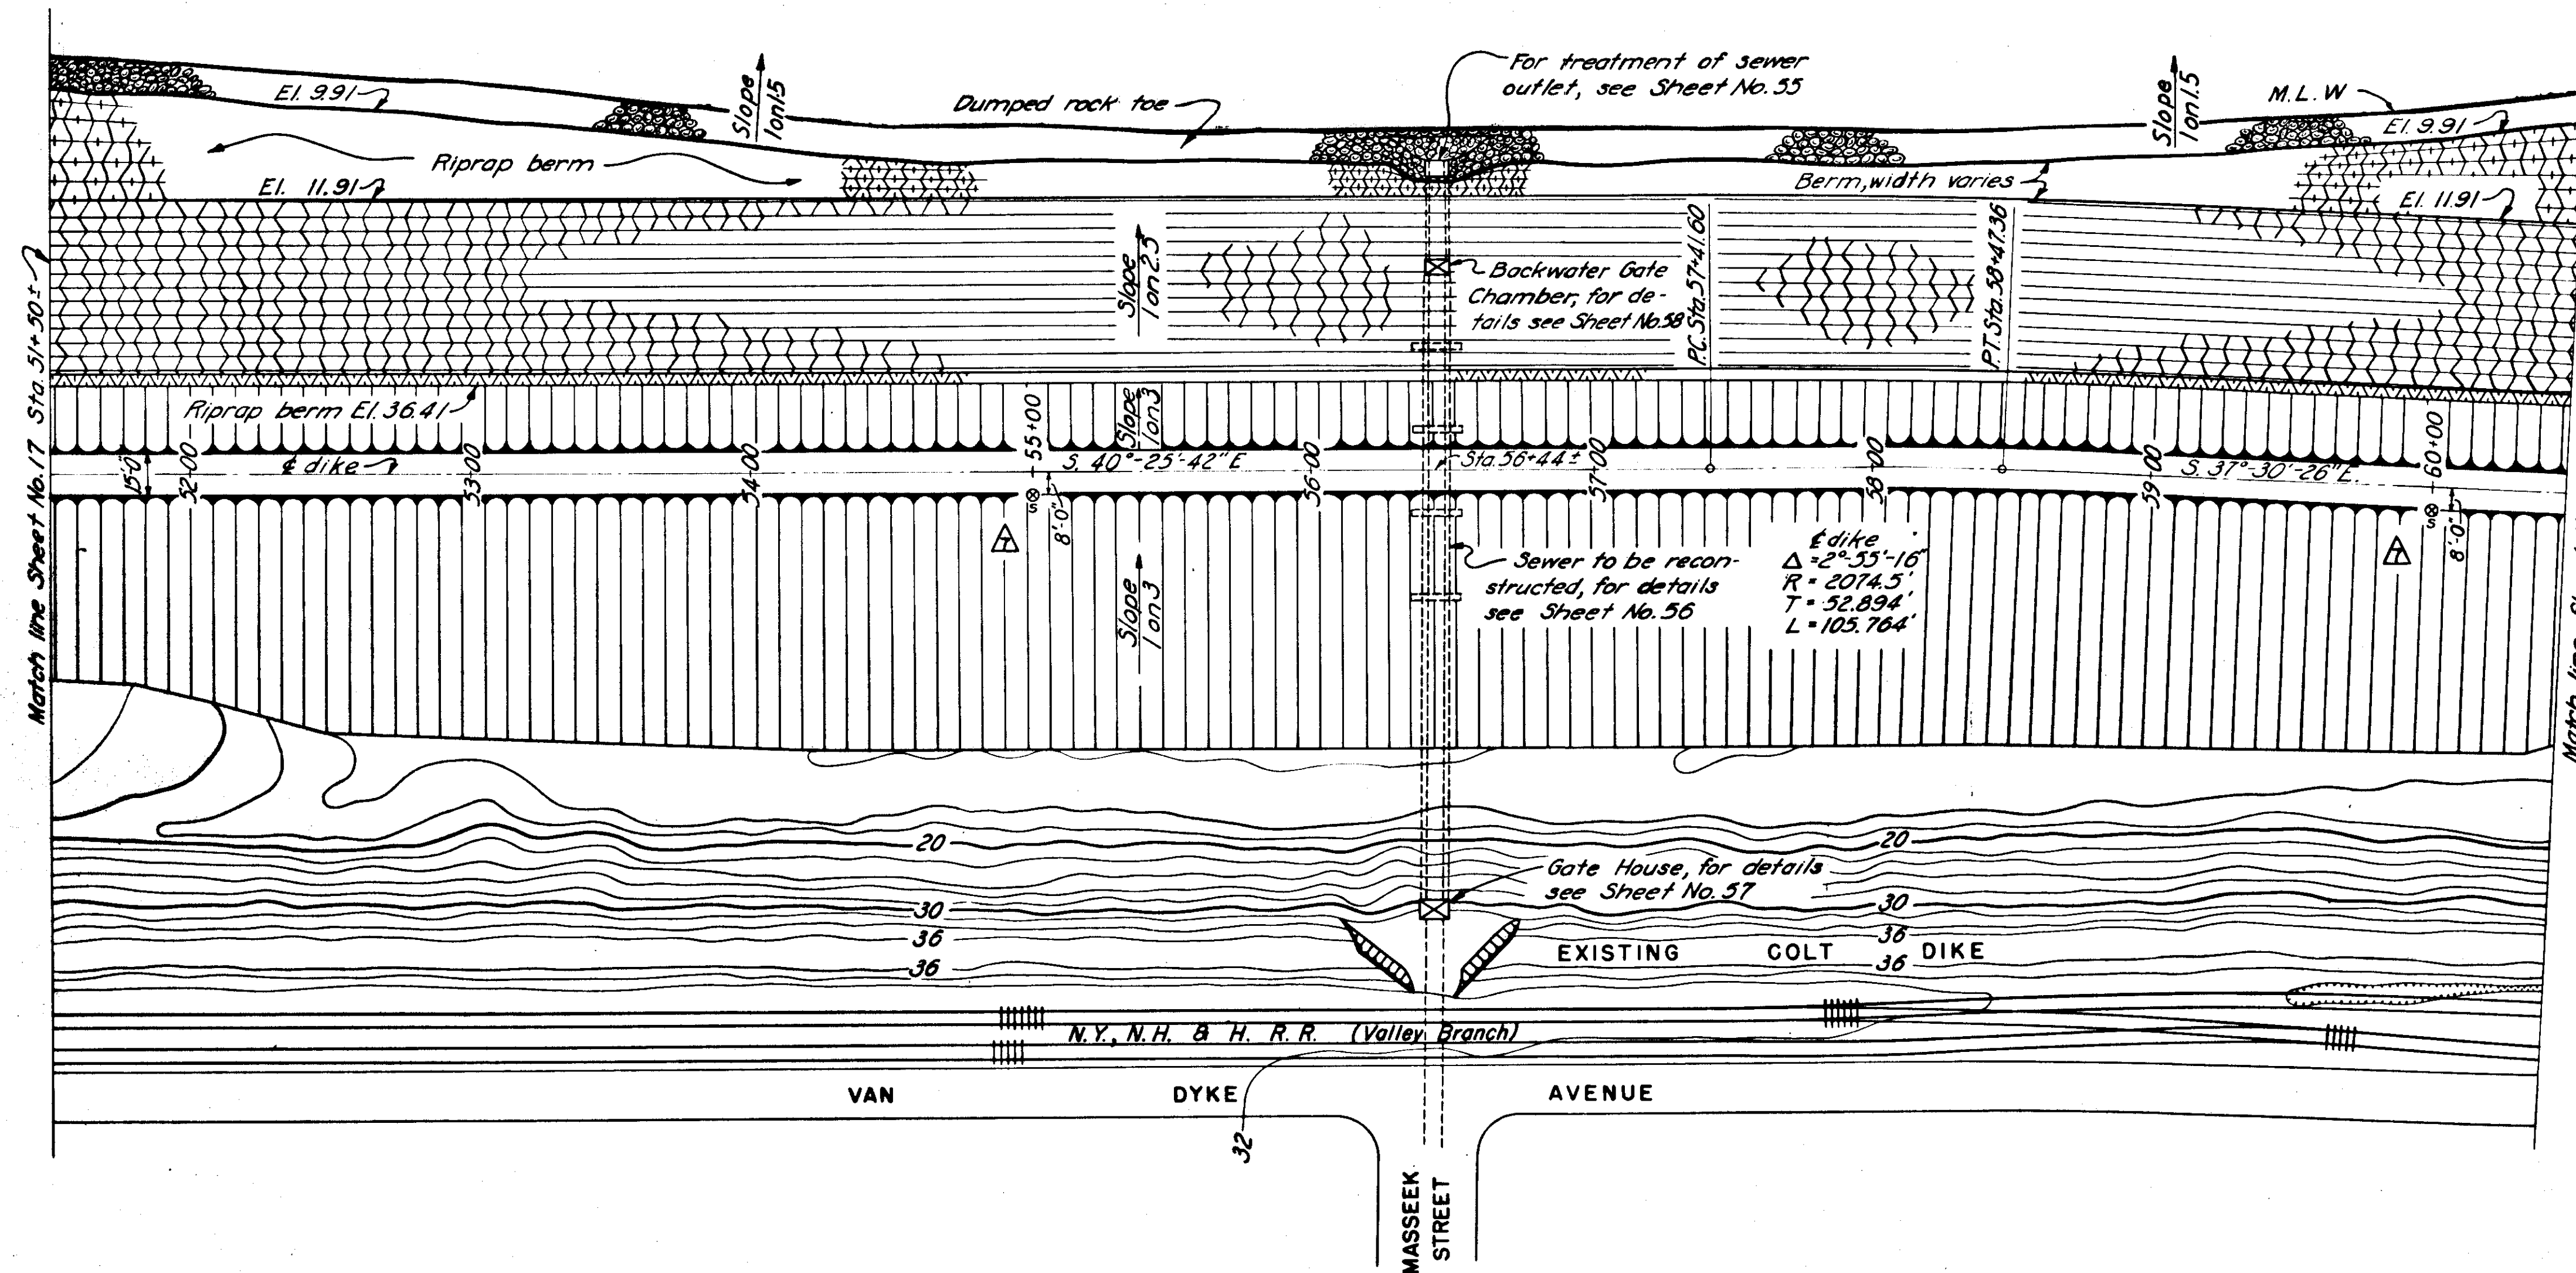

PLAN

SCALE: 1" = 40'

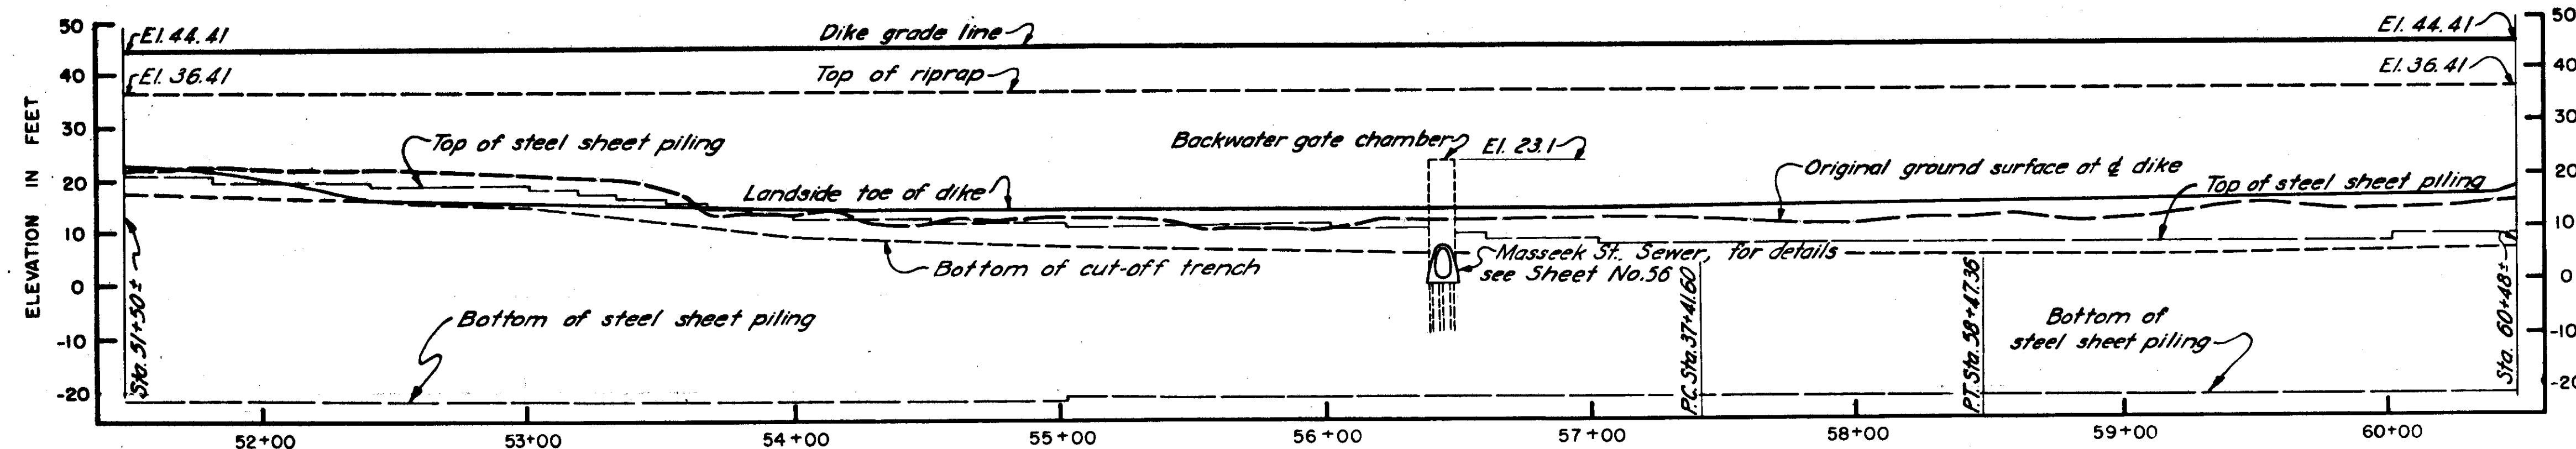

PROFILE

SCALE: HOR. 1" = 40'
VERT. 1" = 20'

STATION COORDINATES		
STATION	NORTHINGS	EASTINGS
P.C. 57+41.60	47580.11	72551.35
P.T. 58+47.36	47497.89	72617.86

NOTE:

Due to slide on 24 July 1941, information shown on this sheet is not applicable.
For "as built" information in this area see Sheets No. 1 thru 7 incl. Reconstruction at slide, Sta. 44+45.68 to Sta. 65+00 1 tem Ht 5 & 7 br.

NOTE

For general notes applying to this sheet see Sheet No. 12.
Locations of settlement gages marked Δ
For detail see Sheets No. 52 and 53.

CONNECTICUT RIVER FLOOD CONTROL			
HARTFORD DIKE			
RIVERFRONT, MORGAN ST. TO STA. 96+73			
PLAN AND PROFILE NO. 7			
CONNECTICUT RIVER		CONNECTICUT	
IN 135 SHEETS		SHEET NO. 18	
U.S. ENGINEER OFFICE, PROVIDENCE, R.I., MAY 1940			
SUBMITTED: <i>Wm. B. Fisher</i>		APPROVED: <i>Wm. B. Fisher</i>	
SENIOR ENGINEER		PRINCIPAL ENGINEER	
HEAD, DESIGN SECTION		CHIEF, F.C. ENGINEERING DIV.	
DESIGNED: <i>Wm. B. Fisher</i>		DRAWN: D.W.C.	
ASSOC. ENGINEER		TRACED: L.V.P.	
		CHECKED: W.D.C.	
		FISCAL YEAR 1940	
		FILE NO. CT-4-2478	

KEY	DATE	REVISION (Indicated by Δ)	REV. BY	CK. BY	AP. BY
Δ	3/10/41	Settlement gages added	Wm. B. Fisher	W.D.C.	W.D.C.