



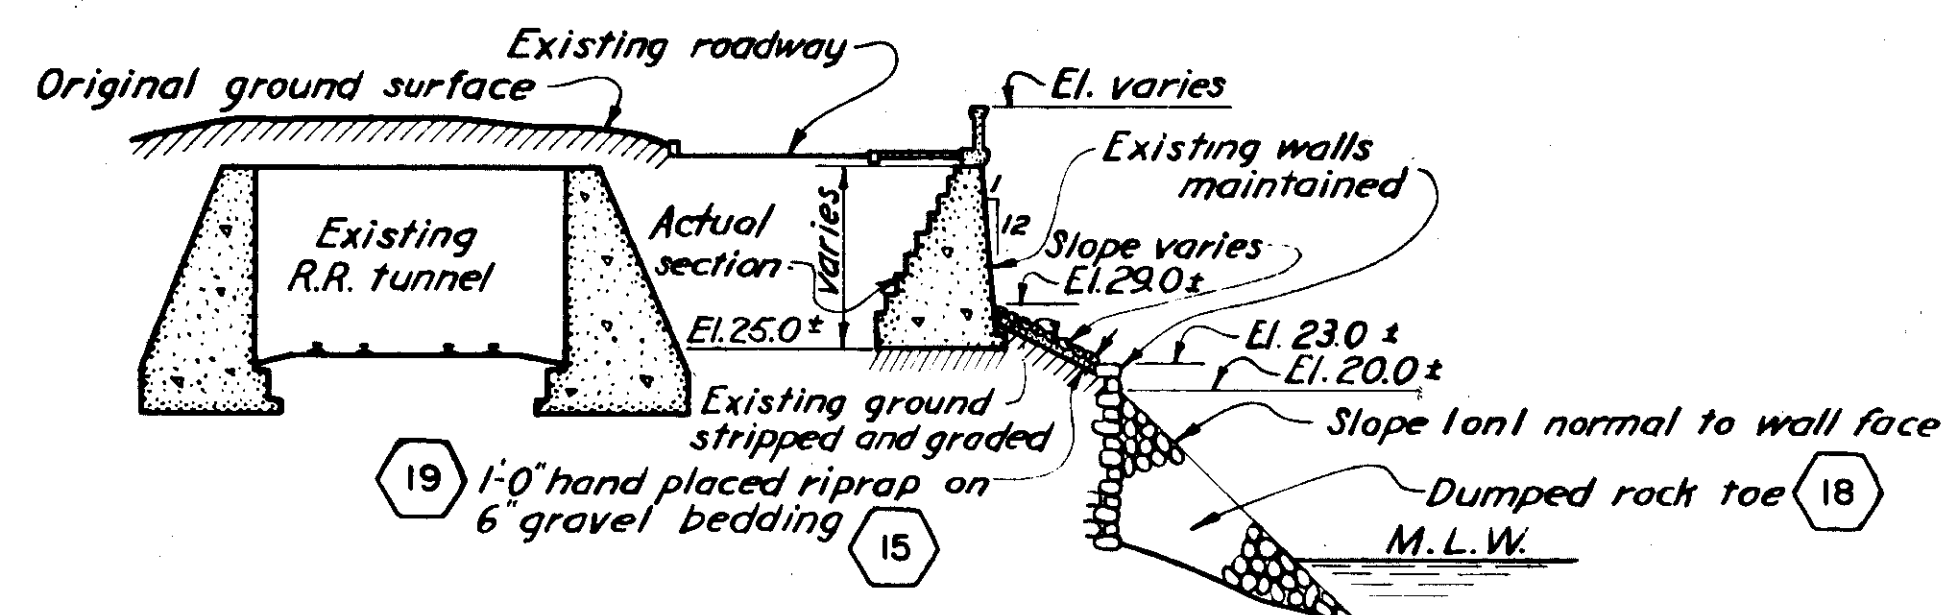


SECTION AT STA. 0+50± Δ

SCALE: 1" = 20'

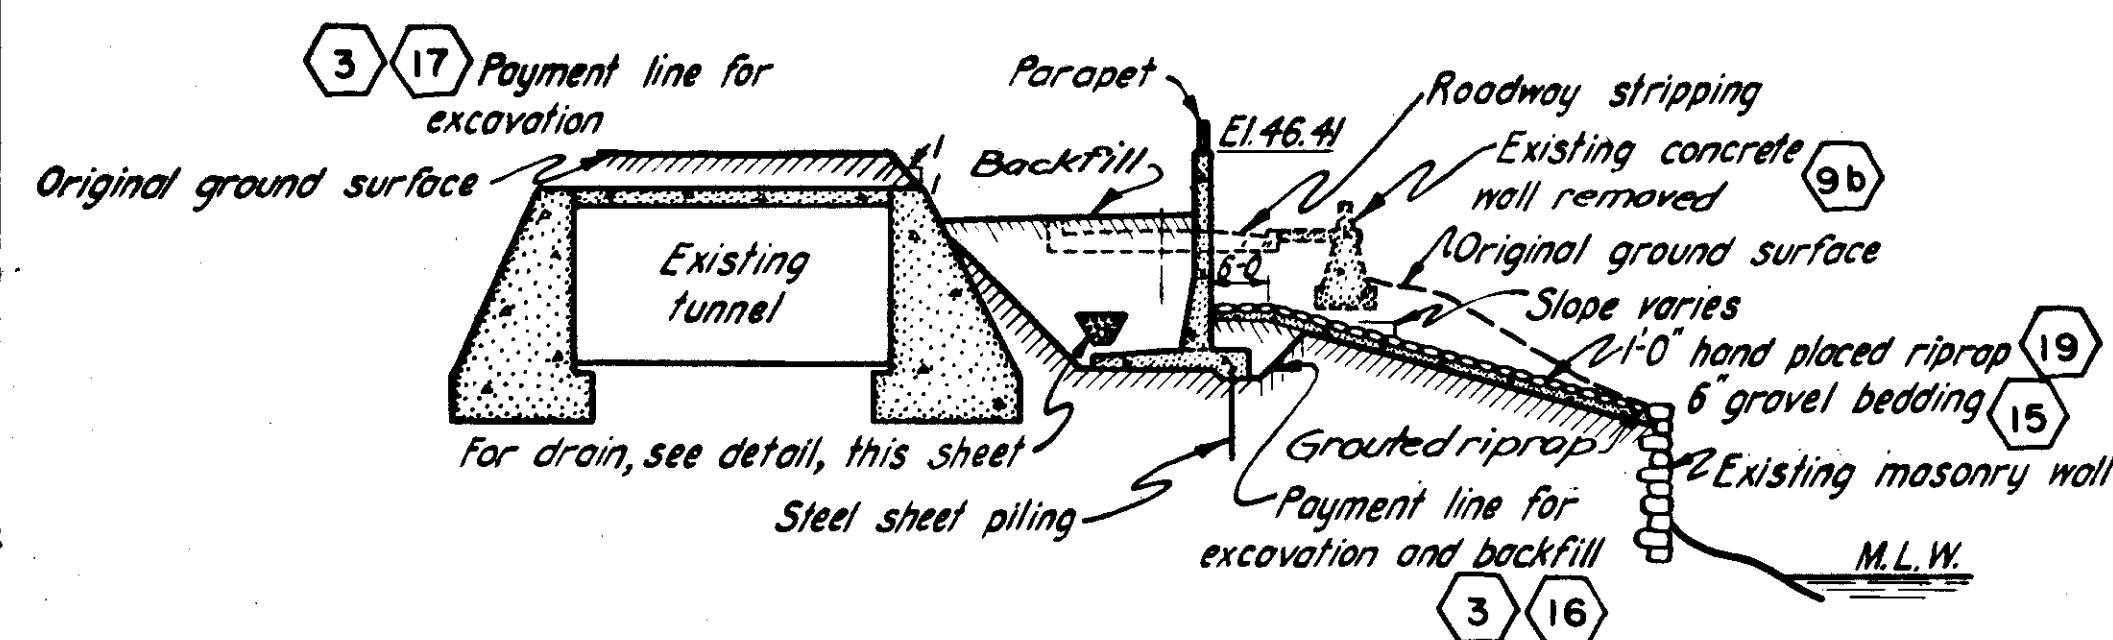


SECTION AT STA. 2+00

SCALE: 1" = 20'

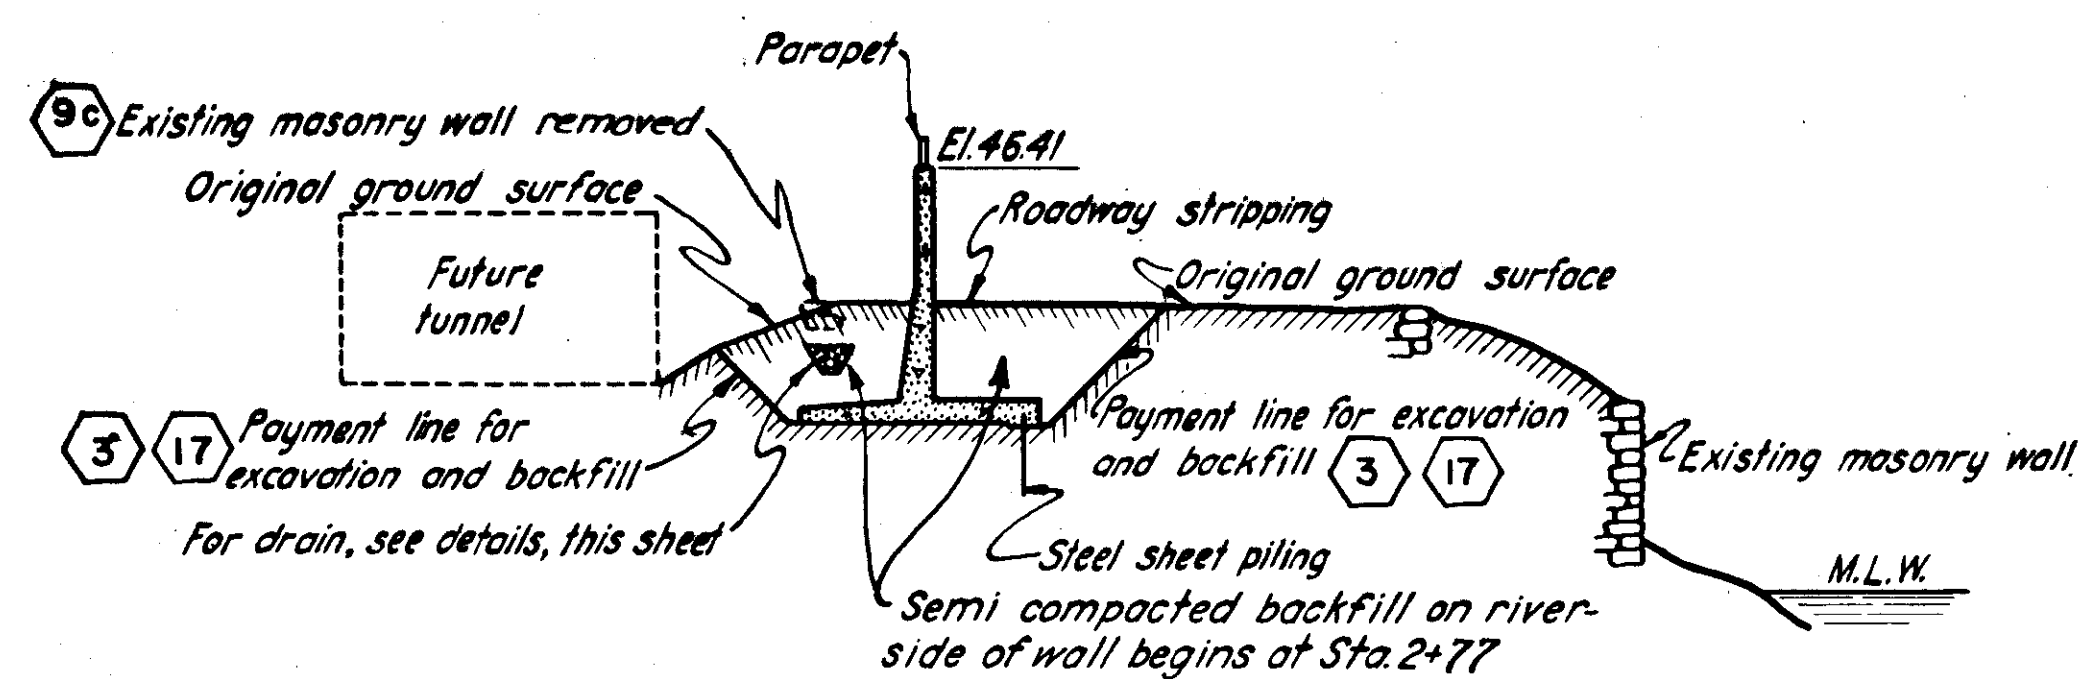


SECTION AT STA. 4+00

SCALE: 1" = 20'

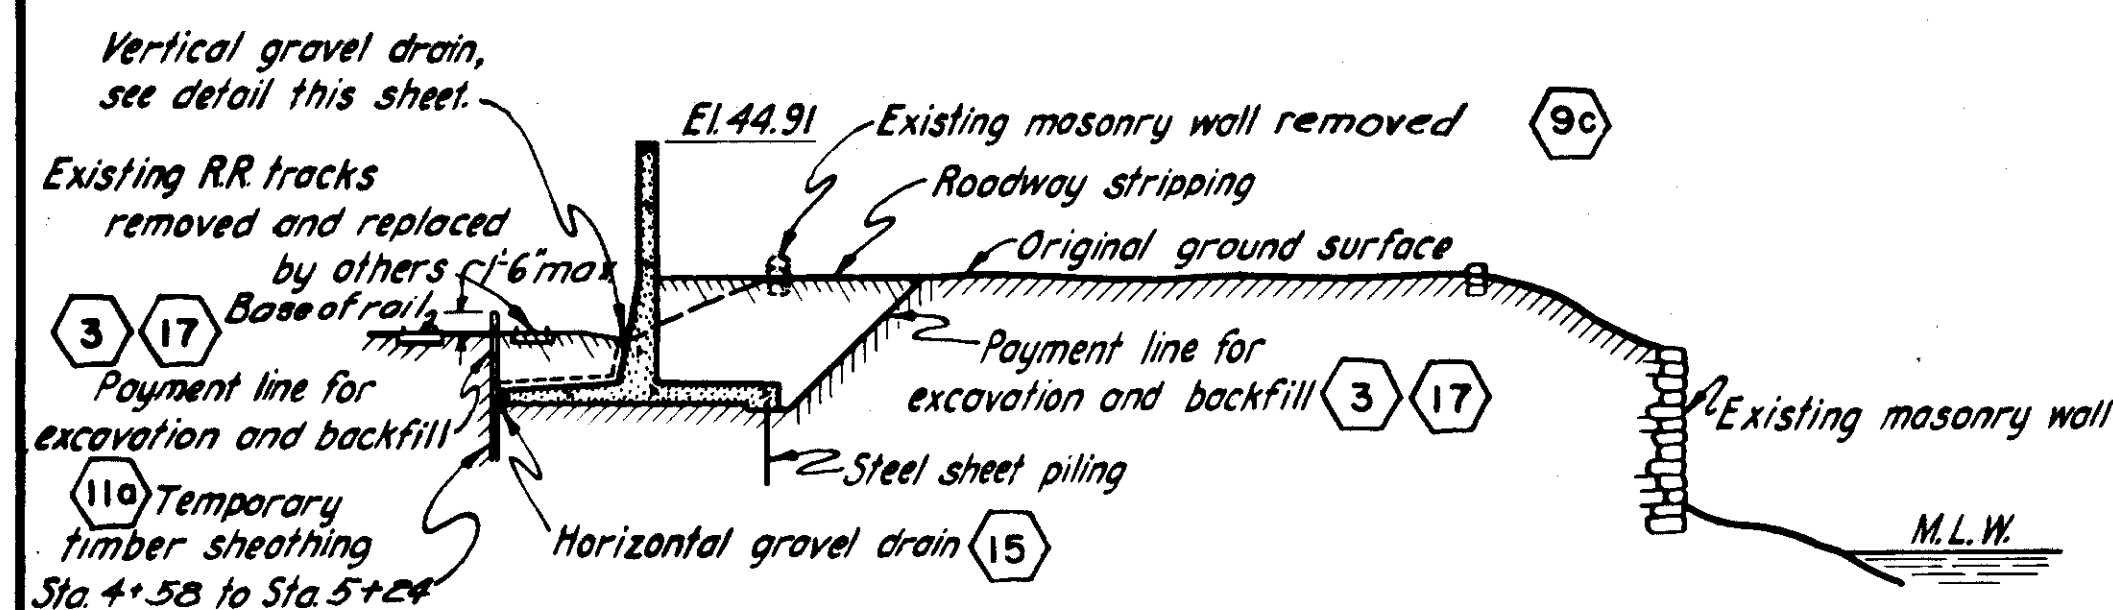


SECTION AT STA. 4+75

SCALE: 1" = 20'

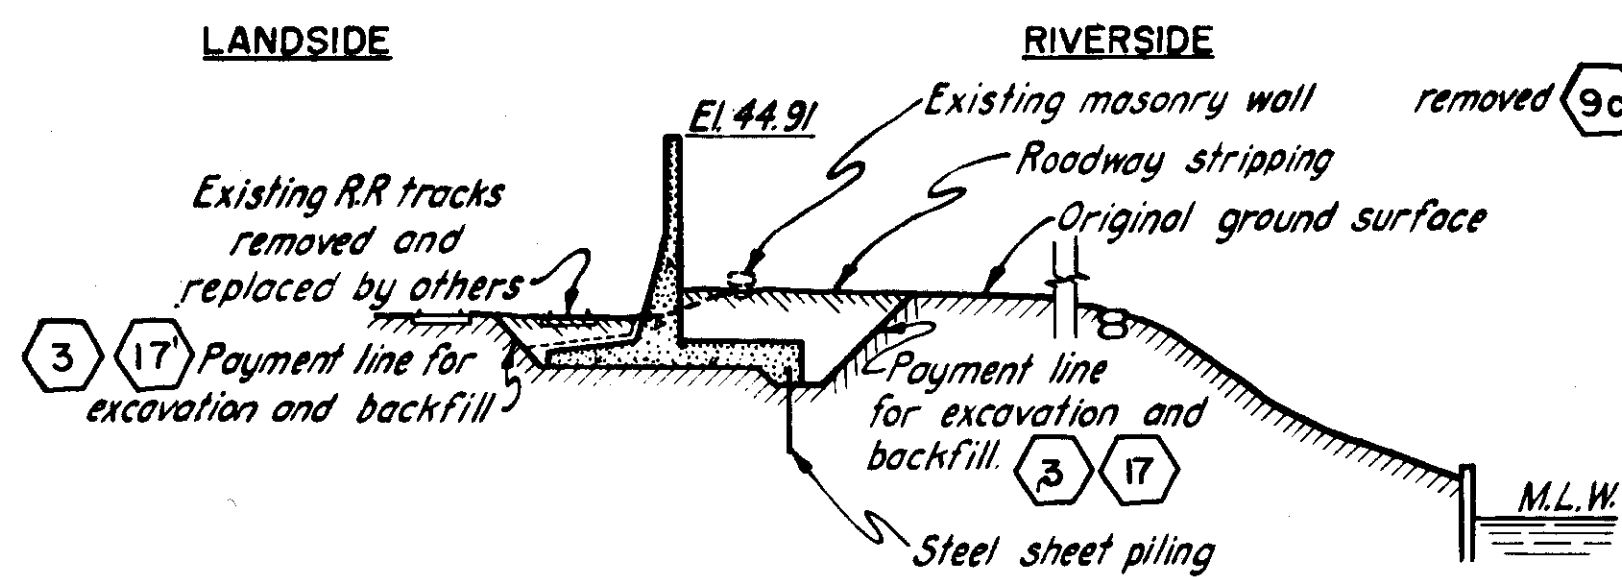

SECTION AT STA. 8+50


SCALE: 1" = 20'

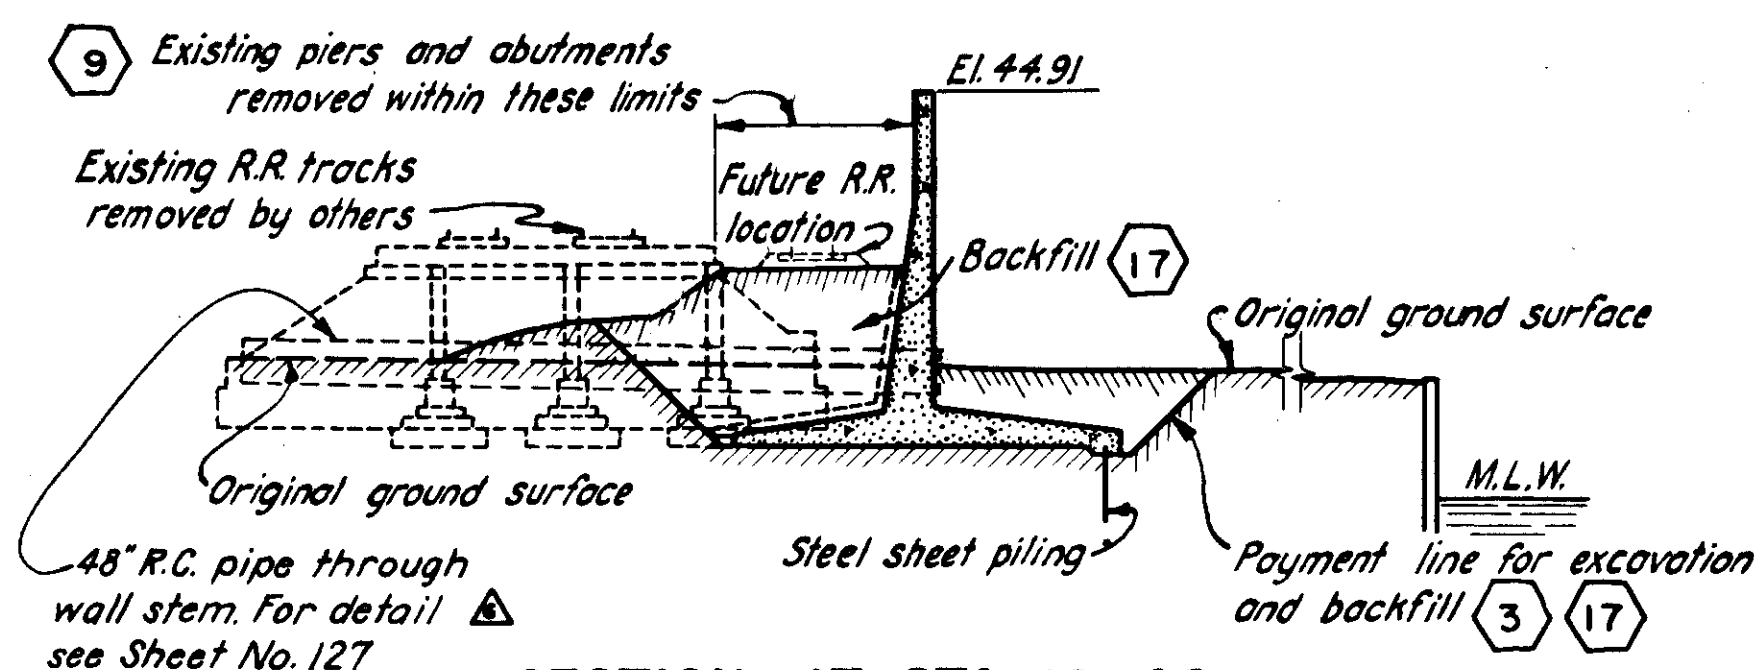

SECTION AT STA. 16+00


(STATE STREET OVERPASS)

SCALE: 1" = 20'

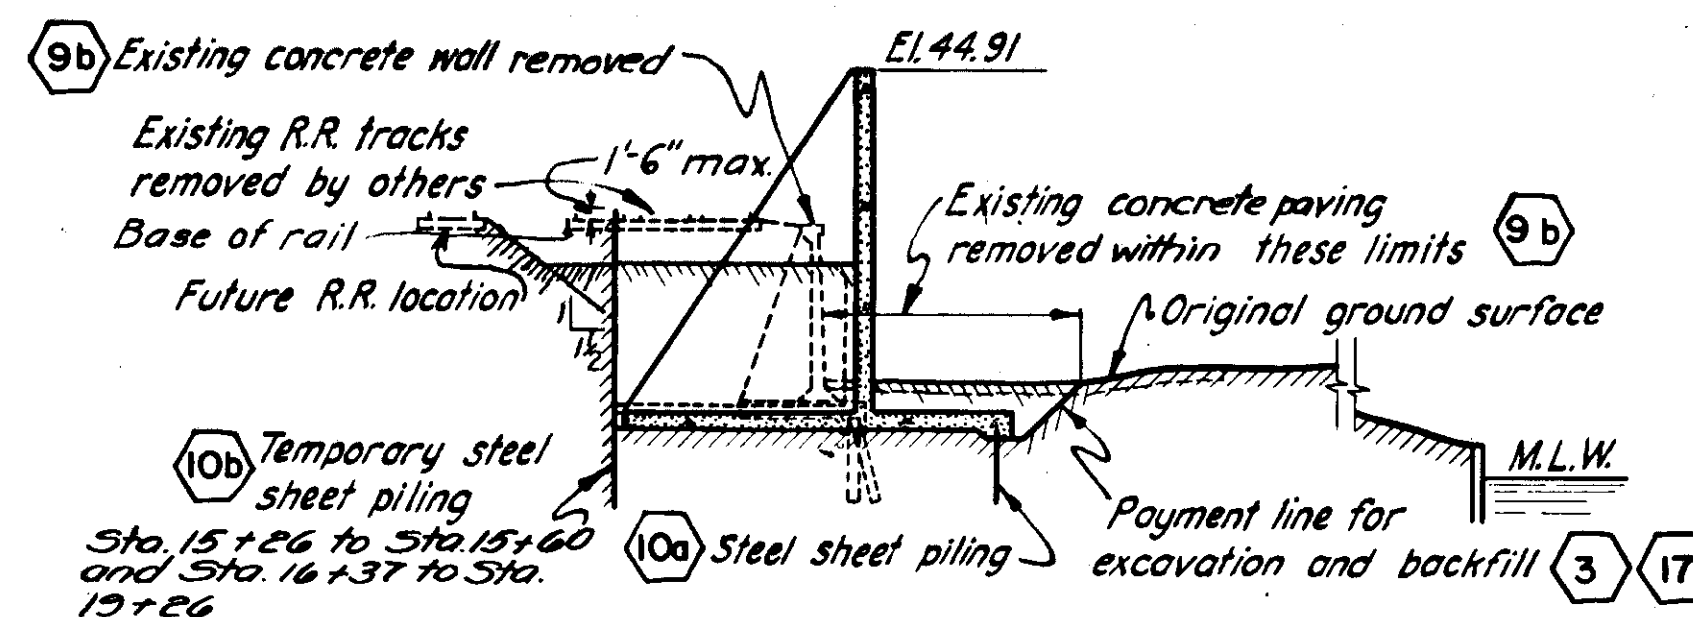

SECTION AT STA. 18+00

SCALE: 1" = 20'

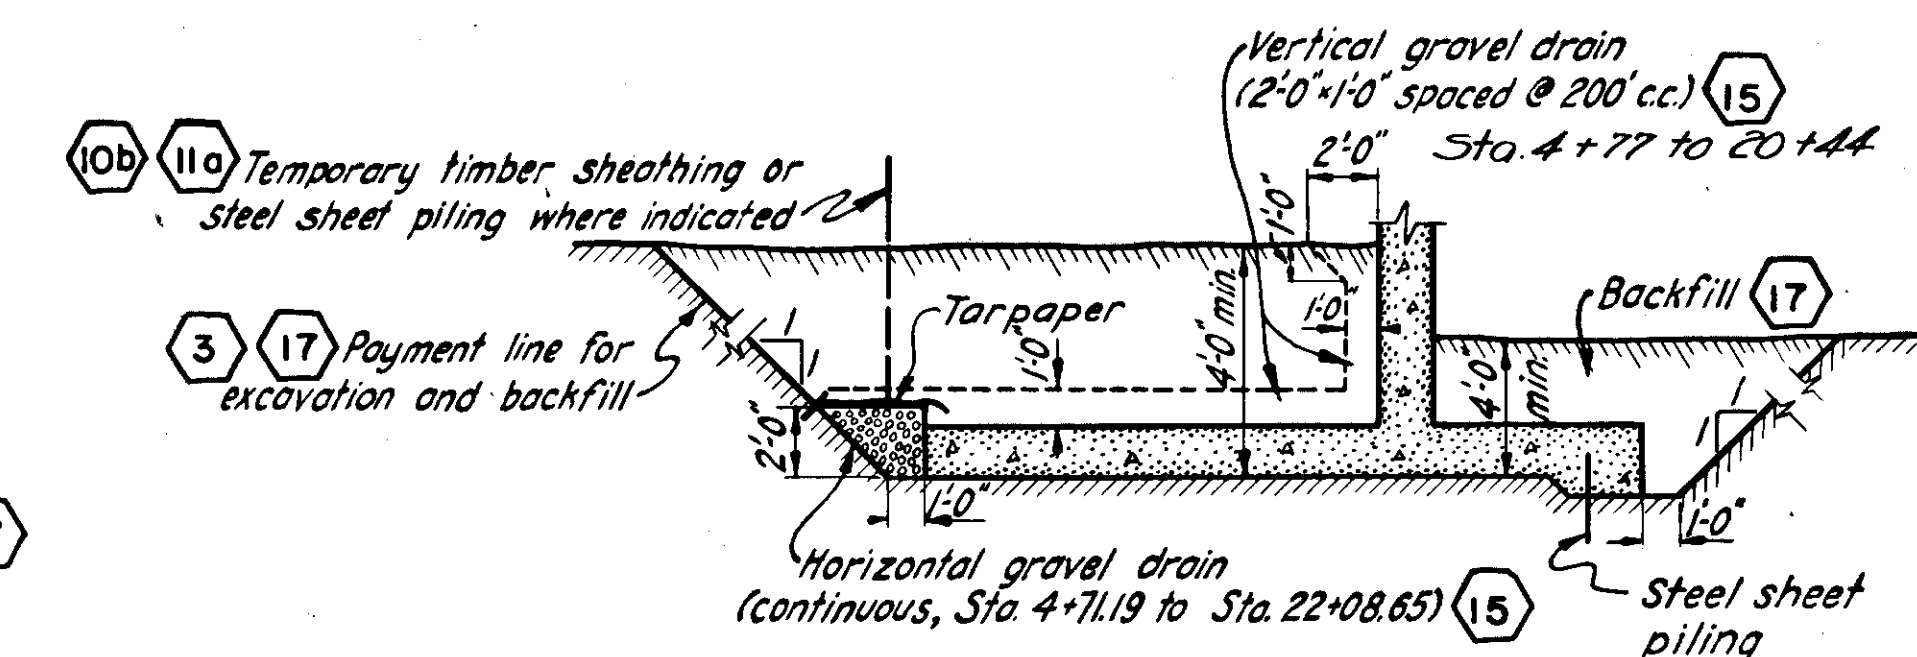


TYPICAL EXCAVATION AND DRAIN TREATMENT

SCALE: 3/16" = 1'-0"



NOTES

Elevations refer to Mean Sea Level Datum.
 Figures in hexagons indicate item numbers under which payment will be made.
 For details of steel sheet piling, see Sheets No. 77 & 78.
 For details of concrete walls, see Sheets No. 70 to 73 incl.
 For general plan, see Sheets No. 12, 13 and 14.

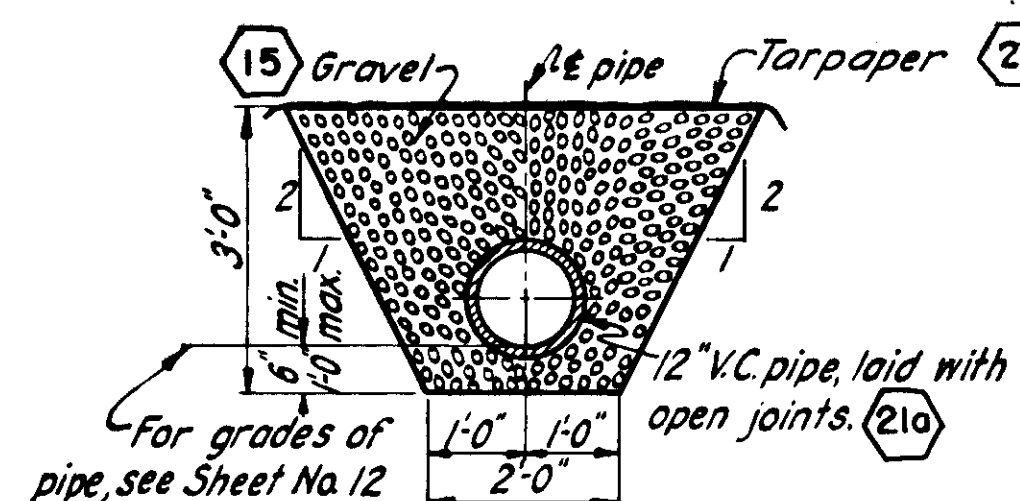

DETAIL OF GRAVEL DRAIN

Δ STA. 0+61.55 TO STA. 4+45.14

SCALE: 1/2" = 1'-0"



KEY	DATE	REVISION (Indicated by Δ)	REV. BY	CK. BY	AP. BY
Δ	12/31/45	As built revisions			
Δ	2/14/41	48" R.C. pipe added	Y.H.	154	W.B.
Δ	8/26/40	Cross section & drain sta. changed	Y.H.	154	W.B.

CONNECTICUT RIVER FLOOD CONTROL			
HARTFORD DIKE			
RIVERFRONT, MORGAN ST. TO STA. 96+73			
TYPICAL CROSS SECTIONS NO. 1			
CONNECTICUT RIVER		CONNECTICUT	
IN 135 SHEETS		SHEET NO. 24	
SCALE: 1 IN. = 20 FT.			
U.S. ENGINEER OFFICE, PROVIDENCE, R.I., MAY 1940			
SUBMITTED:	APPROVAL RECOMMENDED:	APPROVED:	
SENIOR ENGINEER	PRINCIPAL ENGINEER	CHIEF OF ENGINEERS	
HEAD DESIGN SECTION	CHIEF, F.C. ENGINEERING DIV.	DISTRICT ENGINEER	
DESIGNED:	DRAWN: K.H.W. & L.W.B.	FISCAL YEAR 1940	
ASSOC. ENGINEER	CHECKED: W.D.C.	FILE NO. CT-4-2484	