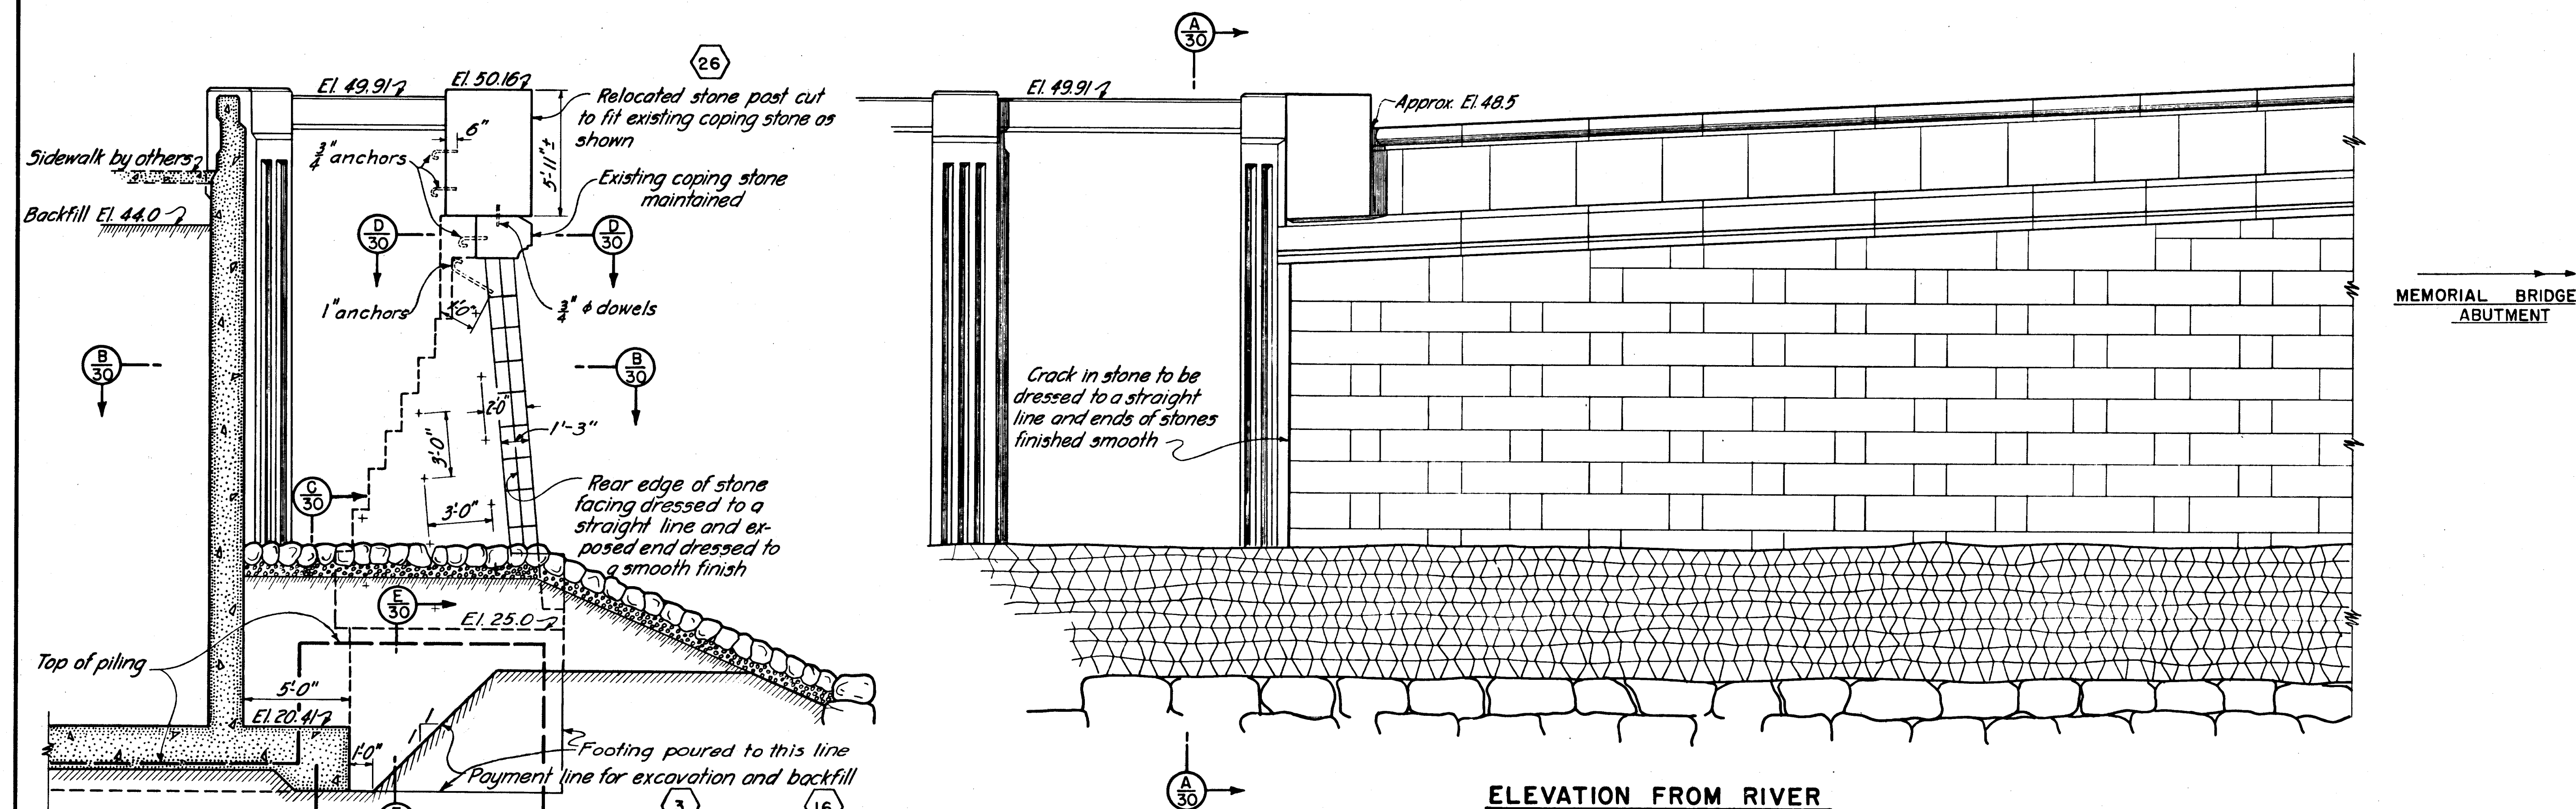
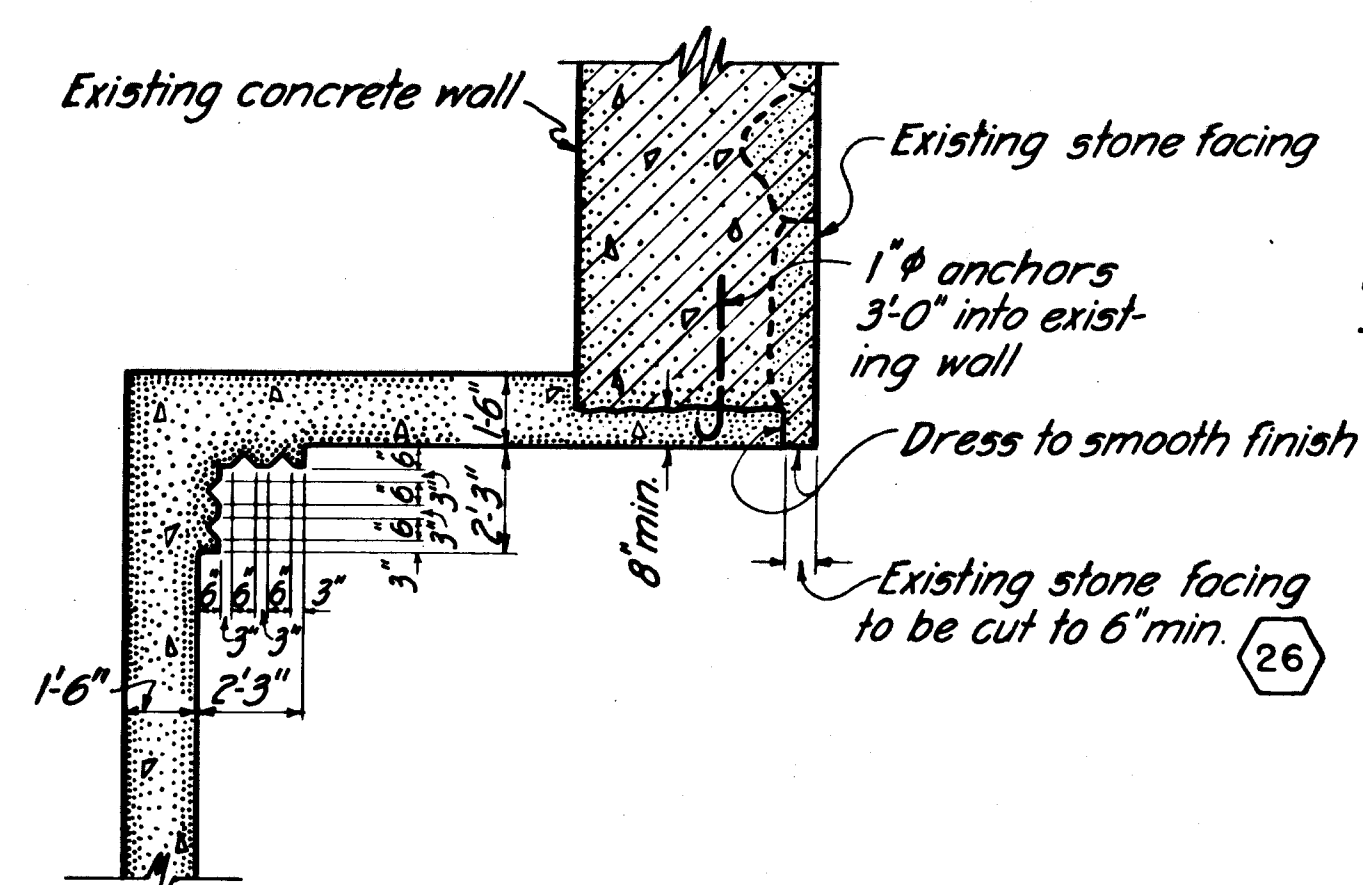
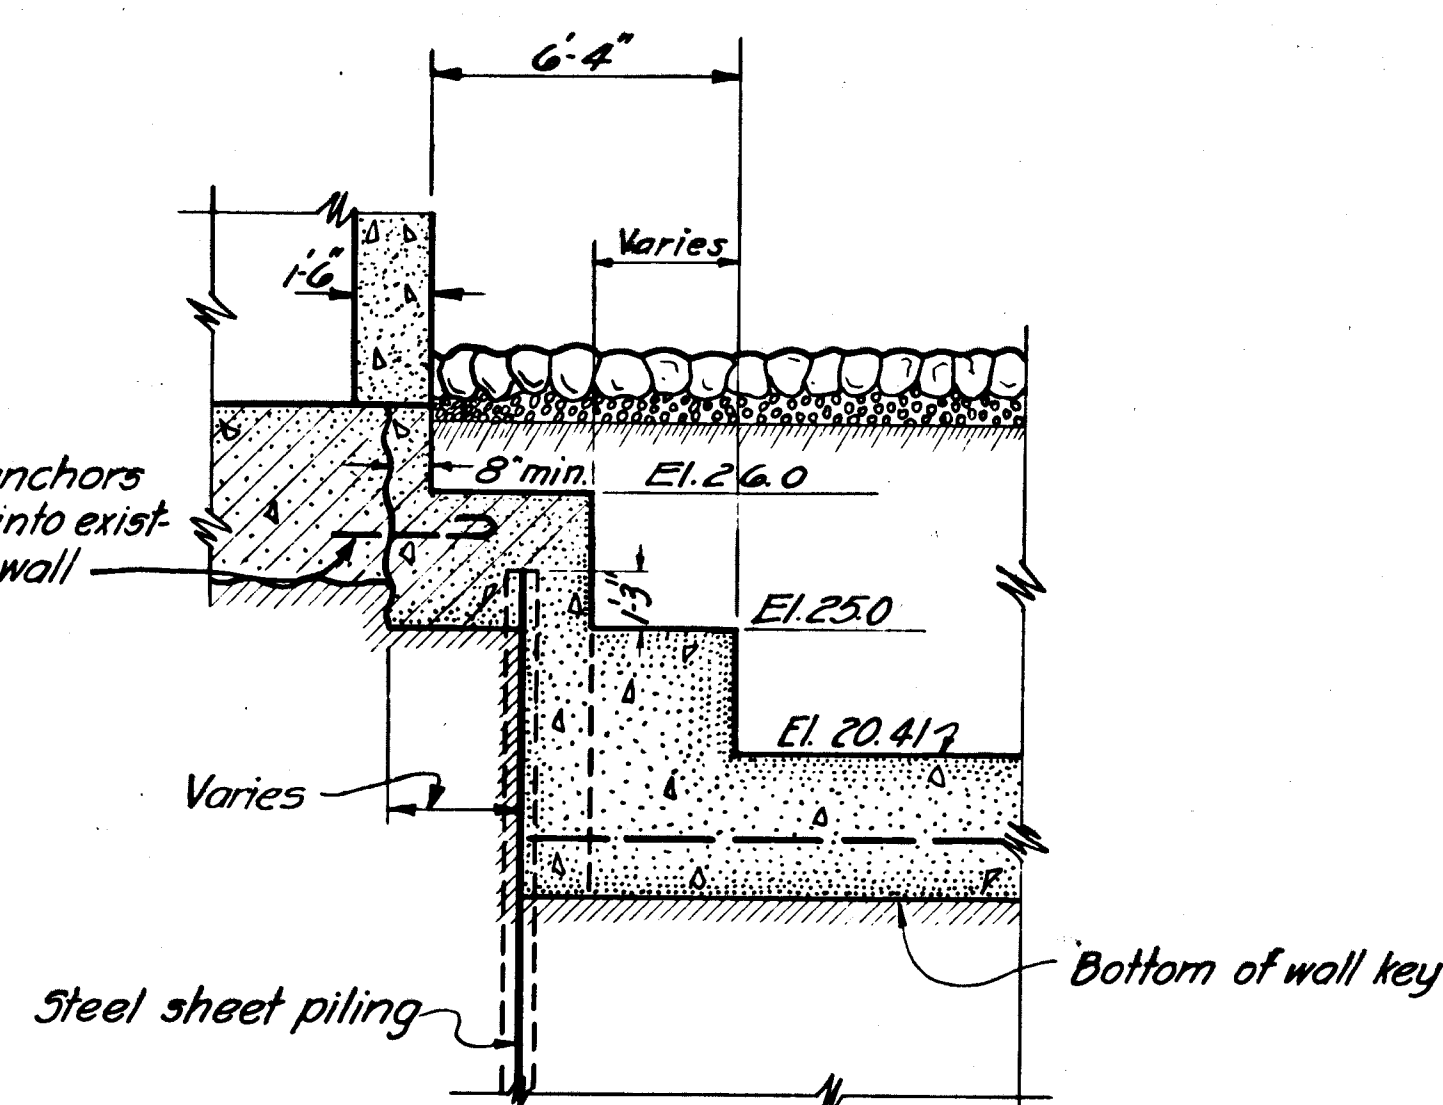
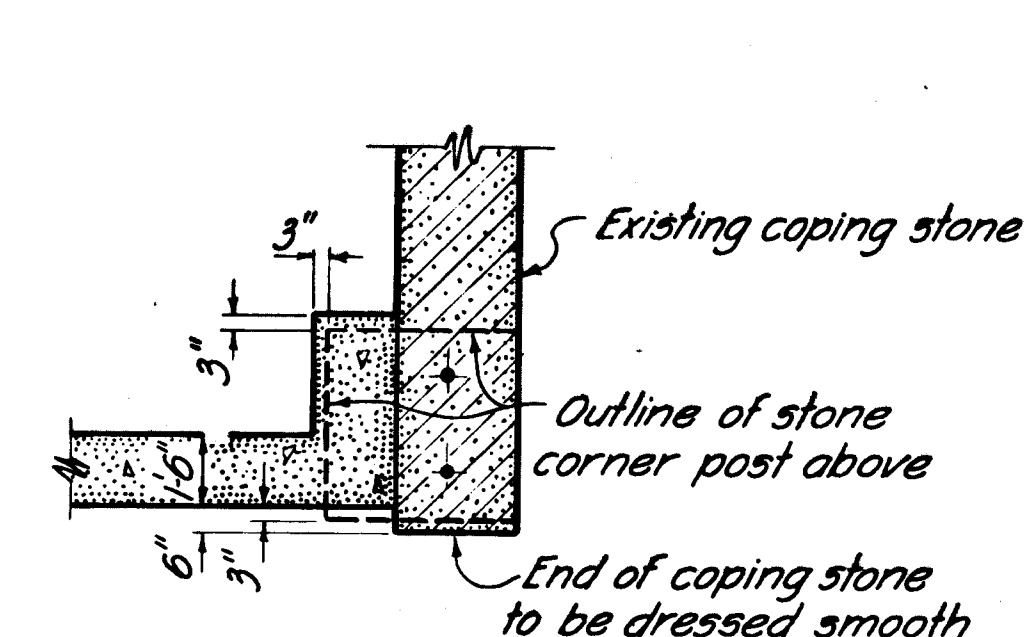
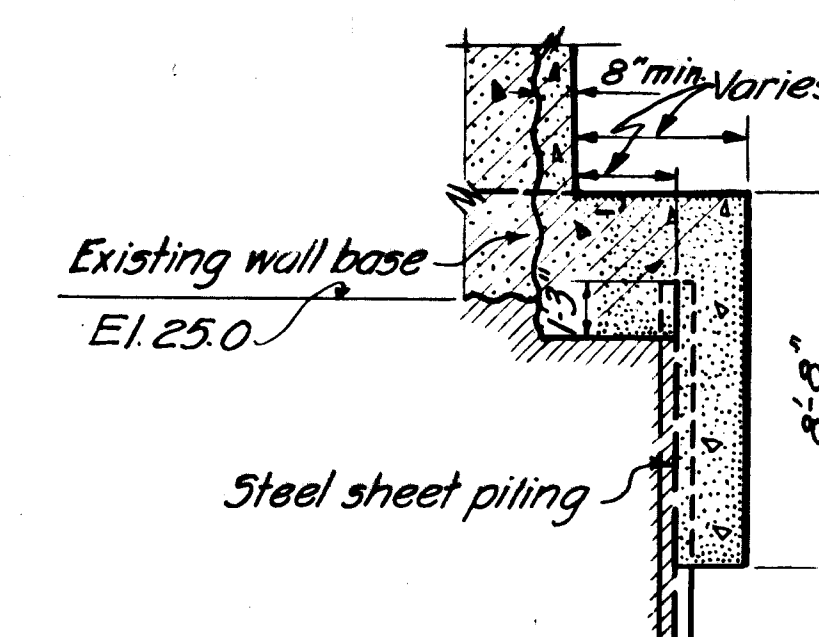


SECTION A
30SECTION B
30SECTION C
30SECTION D
30SECTION E
30

NOTE

For general notes applying to this sheet see Sheet No. 29.

THIS SHEET SUPERSEDES SHEET NO. 30, FILE NO. CT-4-2490

CONNECTICUT RIVER FLOOD CONTROL

HARTFORD DIKE

RIVERFRONT, MORGAN ST. TO STA. 96+73

MASONRY DETAILS

MEMORIAL BRIDGE WING WALL

CONNECTICUT RIVER IN 135 SHEETS SCALE: 1/4 IN. = 1 FT. SHEET NO. 30

U.S. ENGINEER OFFICE, PROVIDENCE, R.I., AUG. 1940

SUBMITTED: 12-31-45 As built revisions

DESIGNED: M. B. ME. TRACED: L. A. O. CHECKED: G. B. C.

FILE NO. CT-4-2669

KEY	DATE	REVISION (Indicated by Δ)	REV. BY	CK. BY	AP. BY
	12-31-45	As built revisions			