




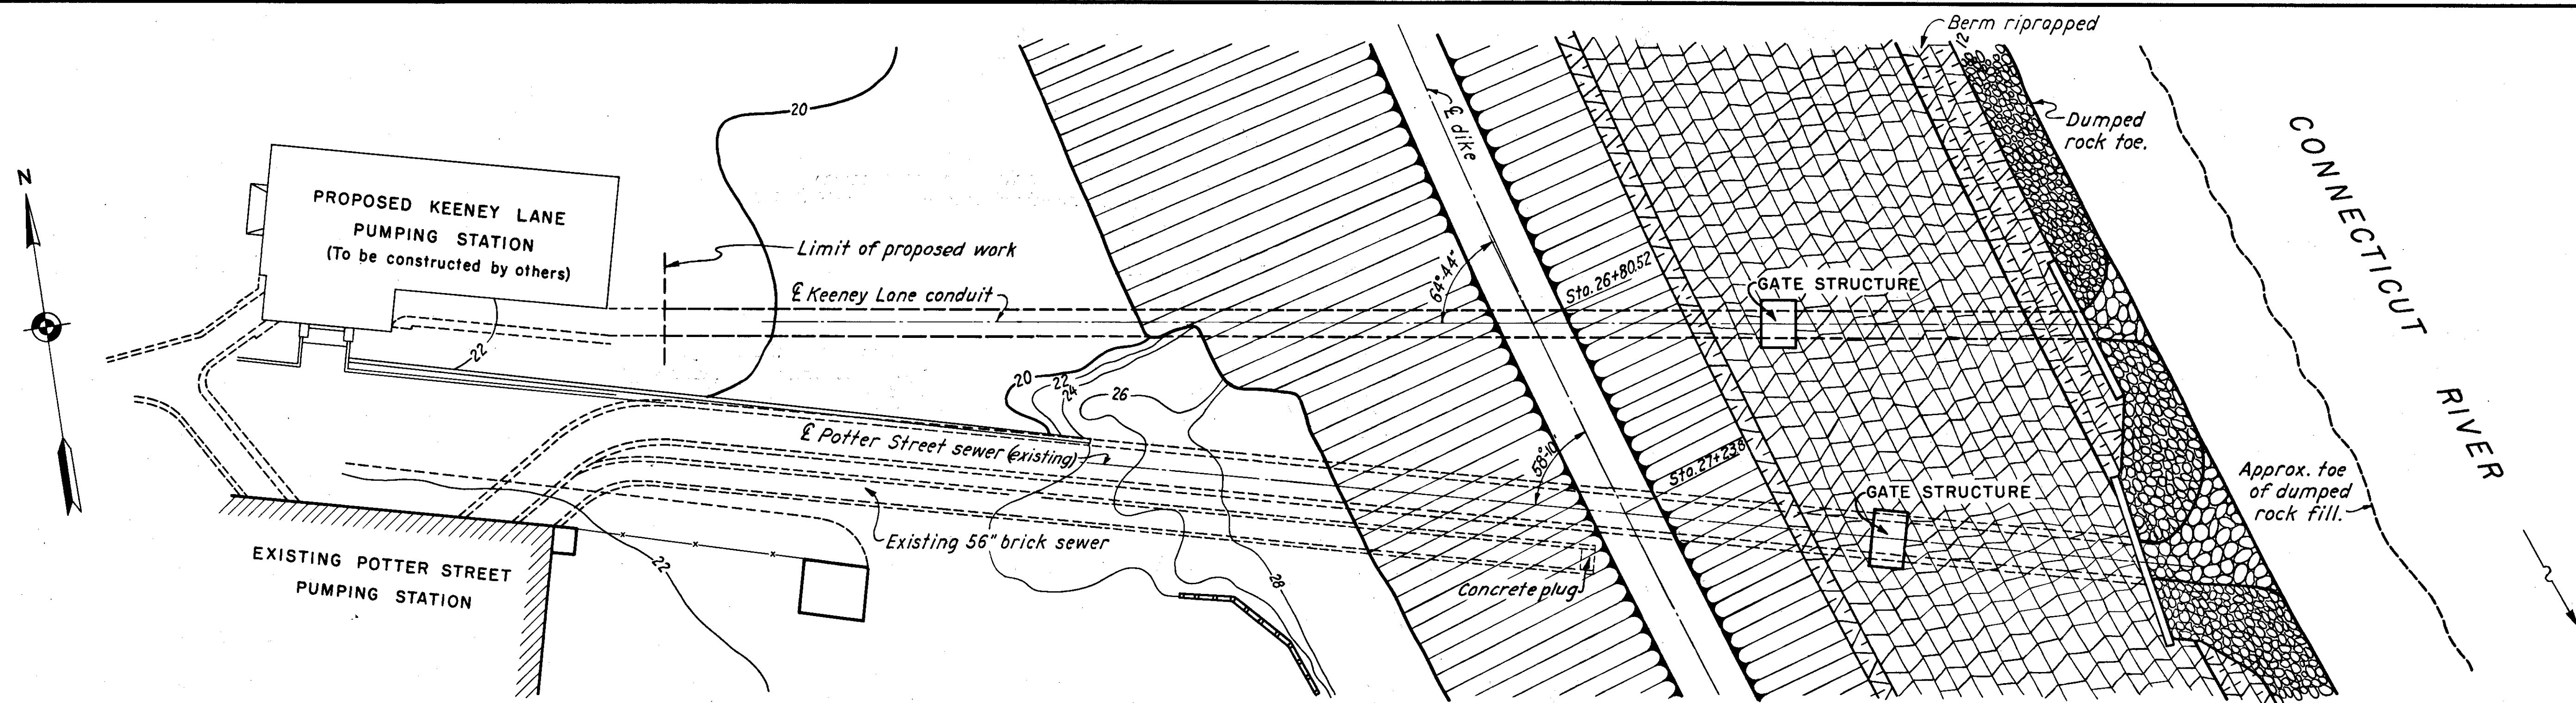

PLAN A

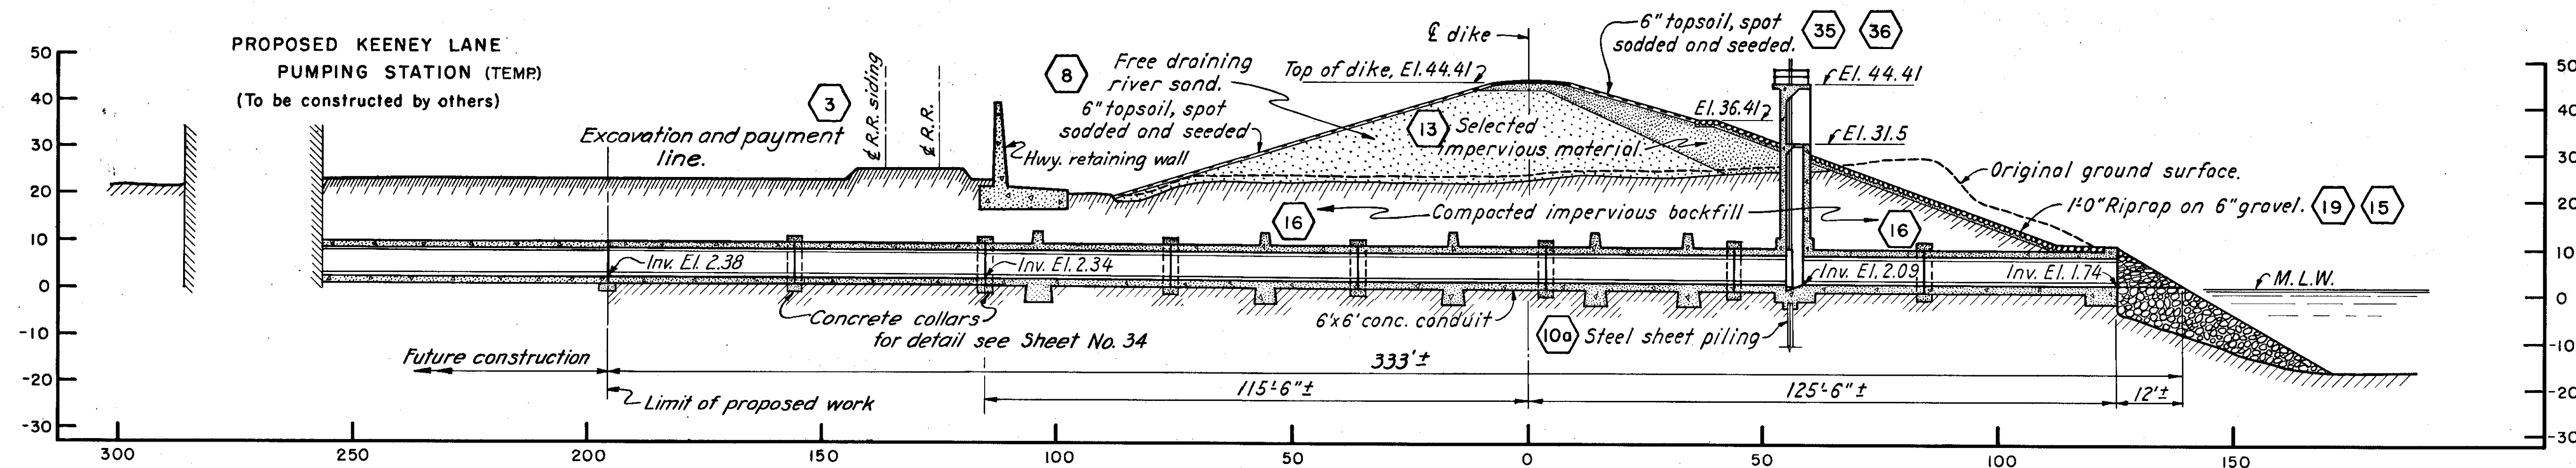

PROFILE ALONG KEENEY LANE CONDUIT

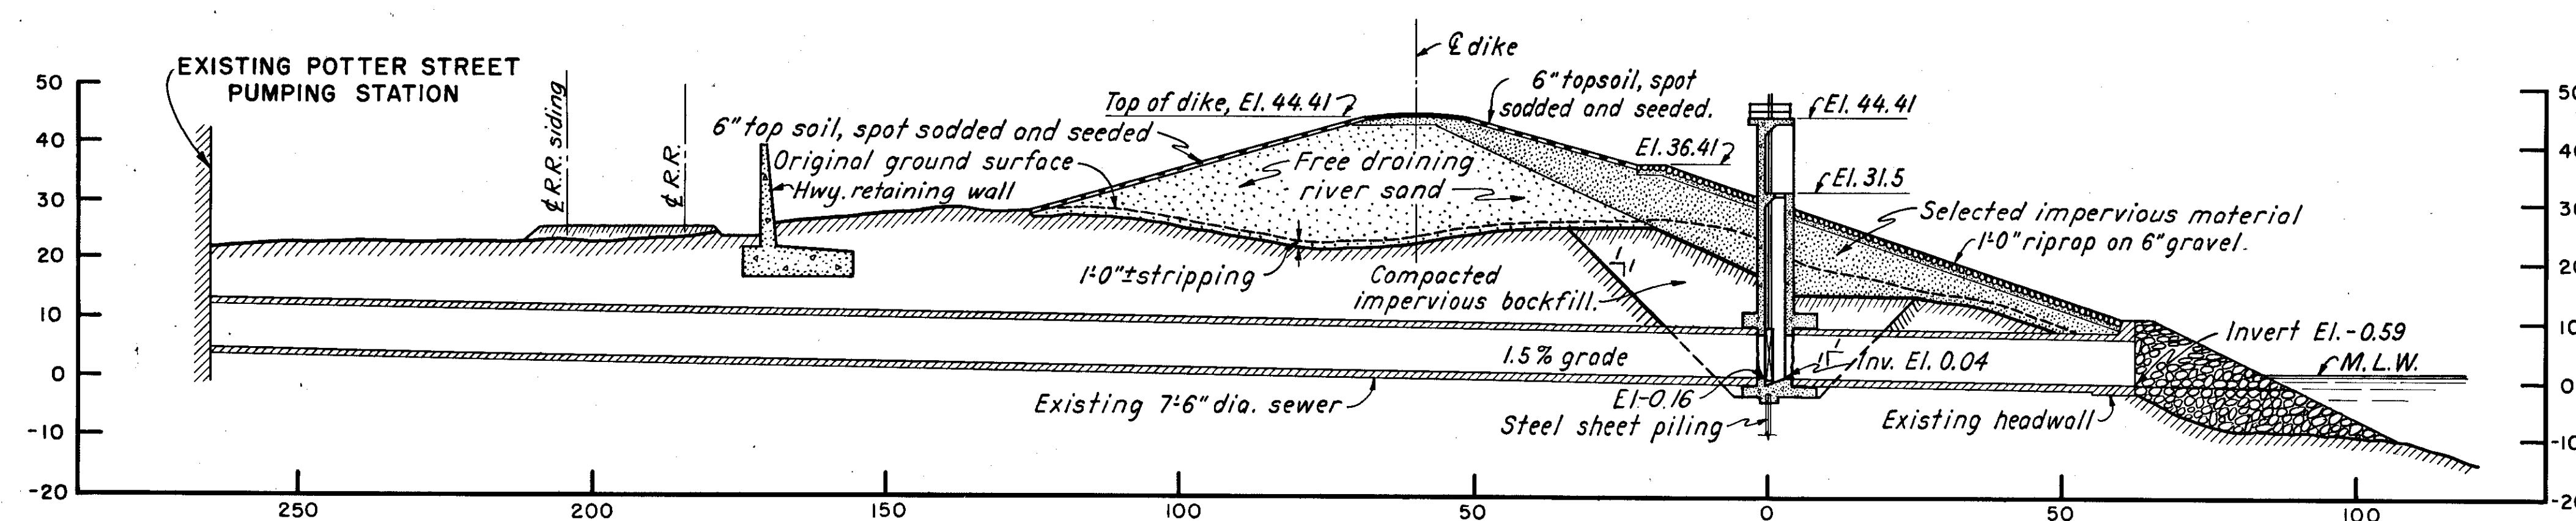

PROFILE ALONG POTTER STREET CONDUIT

NOTES

Elevations refer to Mean Sea Level Datum.
 For details of Keeney Lane conduit see Sheet No. 34.
 For details of gate structures, see Sheet No. 35.
 For details of outlet treatment see Sheet No. 37.
 All concrete on this sheet shall be class A and payment will be made under Item No. 24.
 Location shown for Keeney Lane is approximate only, and final location will be staked in field.

CONNECTICUT RIVER FLOOD CONTROL			
HARTFORD DIKE			
RIVERFRONT MORGAN ST. TO STA. 96+73			
PLAN AND PROFILE			
KEENEY LANE AND POTTER STREET OUTLETS			
CONNECTICUT RIVER			
IN 135 SHEETS		SCALE: 1"=20 FT.	
SHEET NO. 33		FISCAL YEAR 1940	
U.S. ENGINEER OFFICE, PROVIDENCE, R.I., MAY 1940			
SUBMITTED:	APPROVAL RECOMMENDED:	APPROVED:	
David B. Hibben	Principal Engineer	J. H. Hibben	
HEAD, DESIGN SECTION	CHIEF, F.C. ENGINEERING DIV.	DISTRICT ENGINEER	
DESIGNED:	DRAWN:	FISCAL YEAR 1940	
J. H. Hibben	R. A. B.	FILE NO. CT-4-2493	
ASSOC. ENGINEER	CHECKED:	LOC	

12-31-45	As built revisions			
10/11/40	Change in alignment	P.C.H.	K.N.	2818
KEY	DATE	REVISION (Indicated by Δ)	REV. BY	CK. BY