




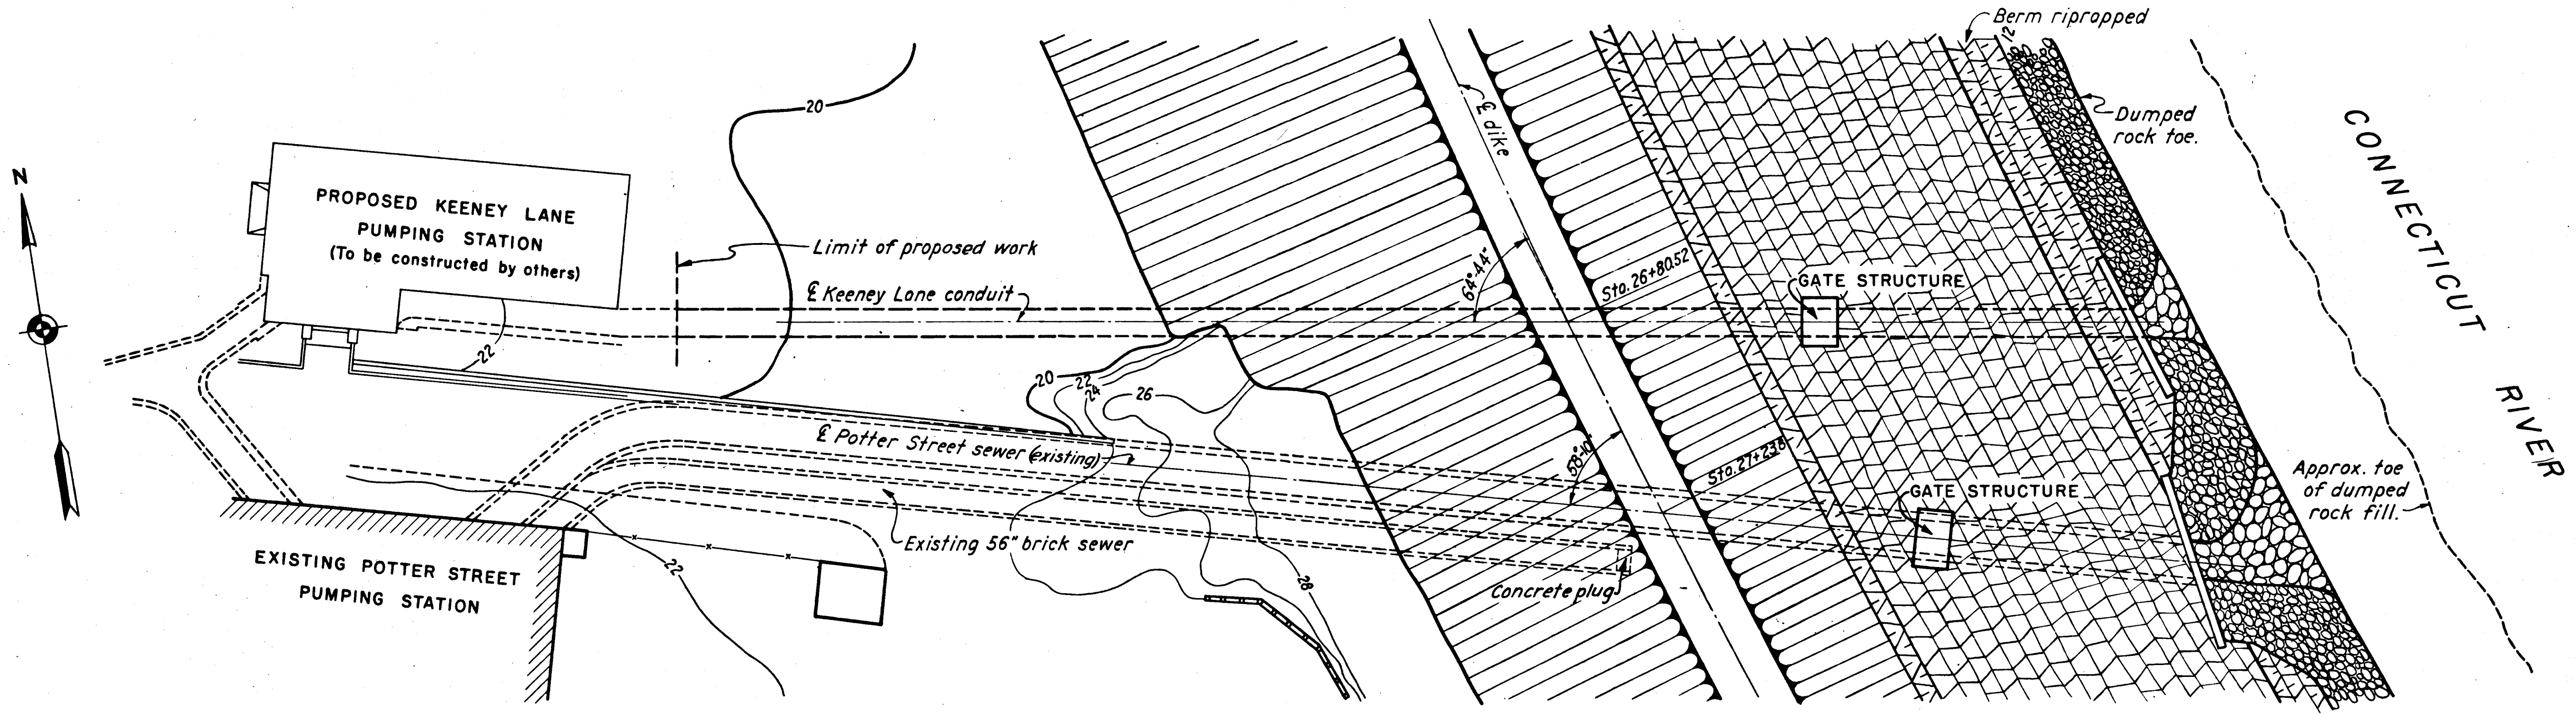

PLAN A

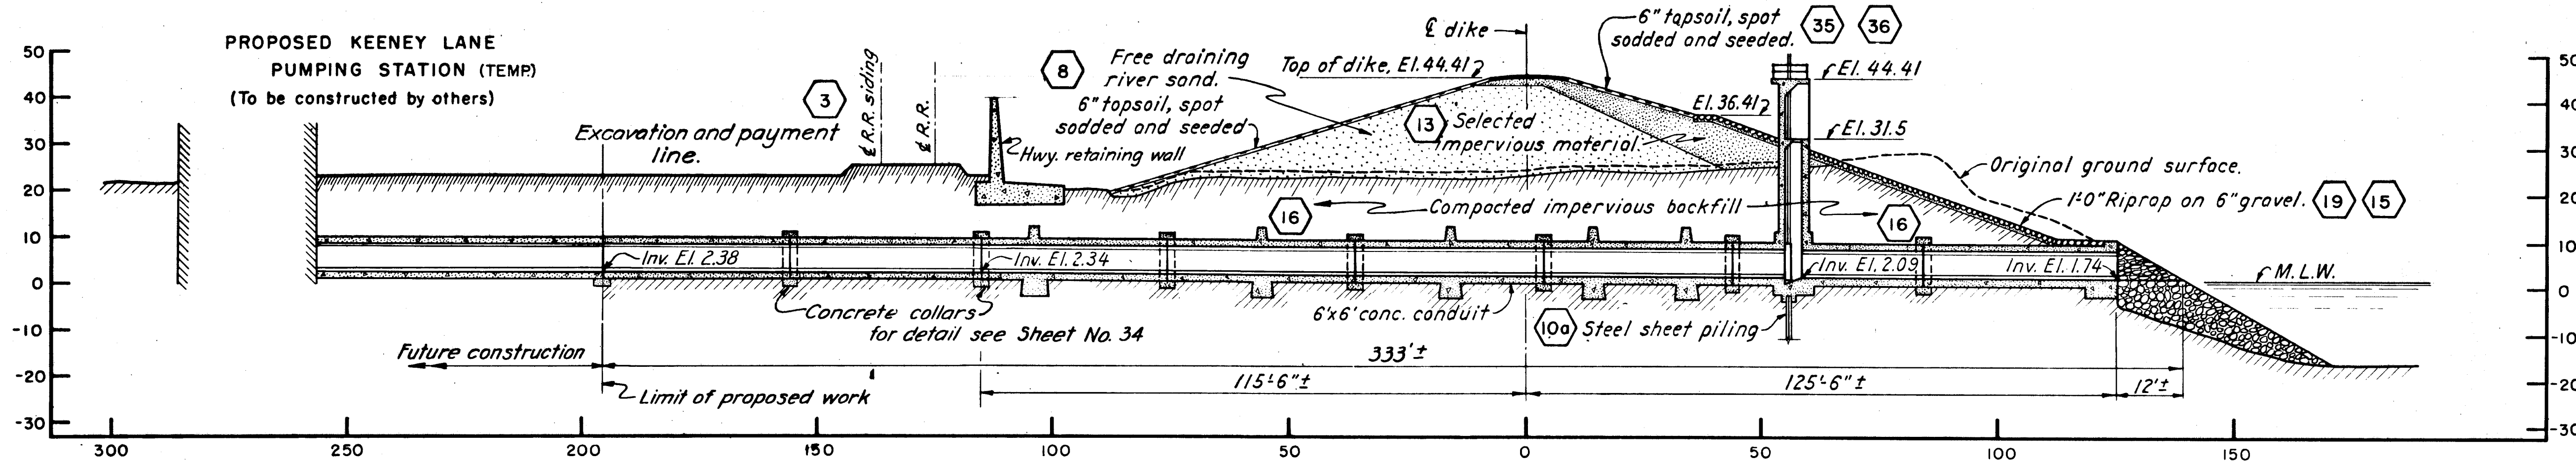

PROFILE ALONG KEENEY LANE CONDUIT

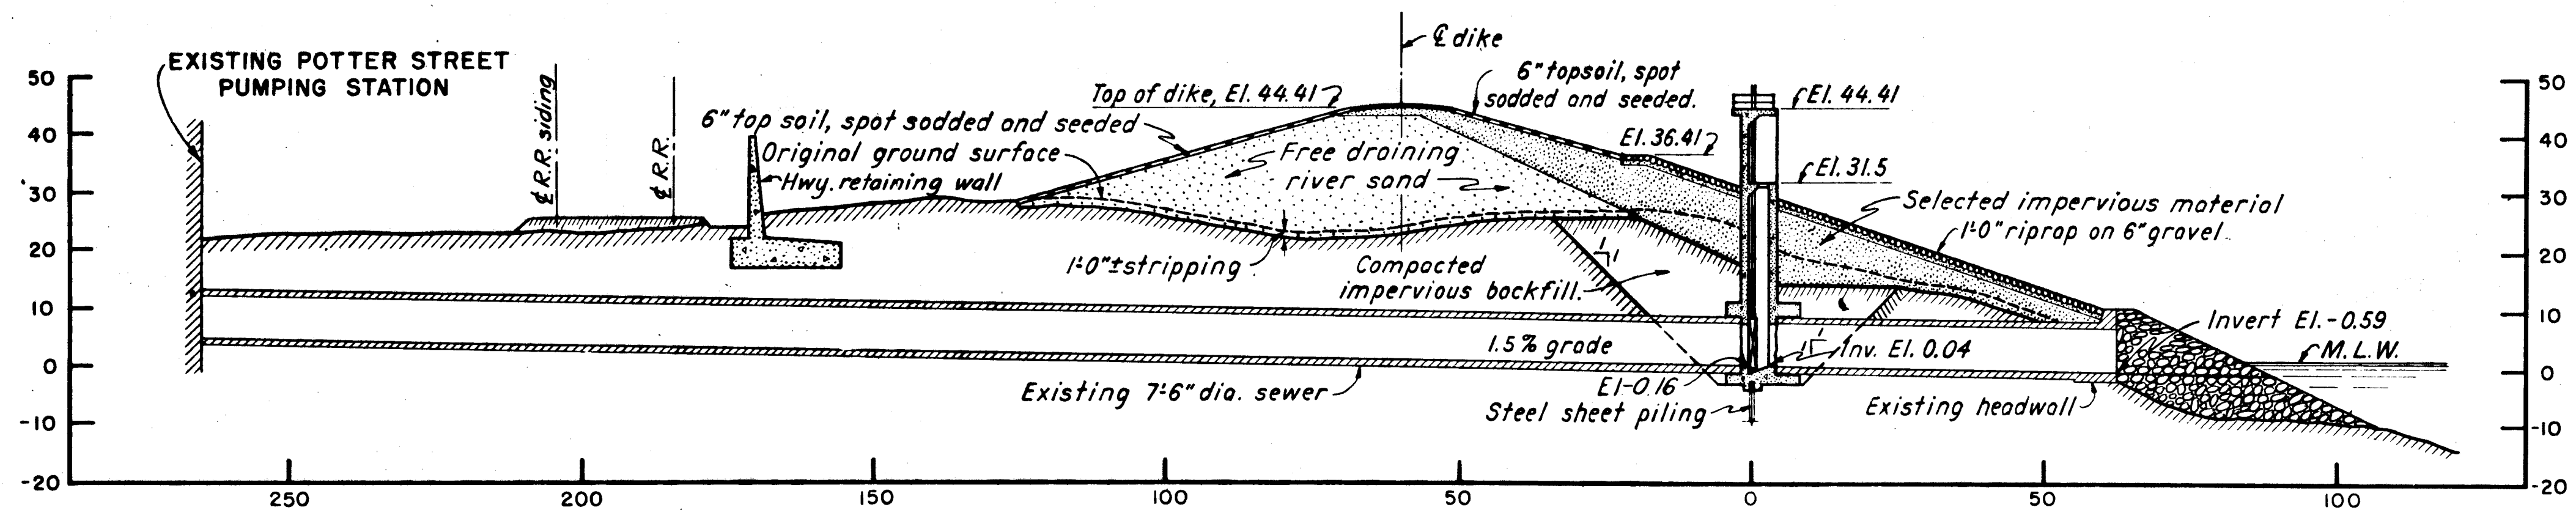

PROFILE ALONG POTTER STREET CONDUIT

NOTES
Elevations refer to Mean Sea Level Datum.
For details of Keeney Lane conduit see Sheet No. 34.
For details of gate structures, see Sheet No. 35.
For details of outlet treatment see Sheet No. 37.
All concrete on this sheet shall be class A and payment will be made under Item No. 24.
Location shown for Keeney Lane is approximate only, and final location will be staked in field.

CONNECTICUT RIVER FLOOD CONTROL			
HARTFORD DIKE			
RIVERFRONT MORGAN ST. TO STA. 96+73			
PLAN AND PROFILE			
KEENEY LANE AND POTTER STREET OUTLETS			
CONNECTICUT RIVER			
IN 135 SHEETS		SHEET NO. 33	
SCALE: 1"=20'		SCALE: 1"=20'	
U.S. ENGINEER OFFICE, PROVIDENCE, R.I., MAY 1940			
SUBMITTED: <i>W. B. H. H.</i>		APPROVED: <i>W. B. H. H.</i>	
SENIOR ENGINEER		PRINCIPAL ENGINEER	
HEAD, DESIGN SECTION		CHIEF, P.C. ENGINEERING DIV.	
DESIGNED: <i>J. H. H.</i>		DRAWN: <i>P. A. B.</i>	
ASSOC. ENGINEER		CHECKED: <i>W. B. H.</i>	
FISCAL YEAR 1940		FILE NO. CT-4-2493	

12-31-45	As built revisions	PC#	HN	2816
10/11/40	Change in alignment	REV. BY	CK. BY	AP. BY
REVISION (Indicated by Δ)				