

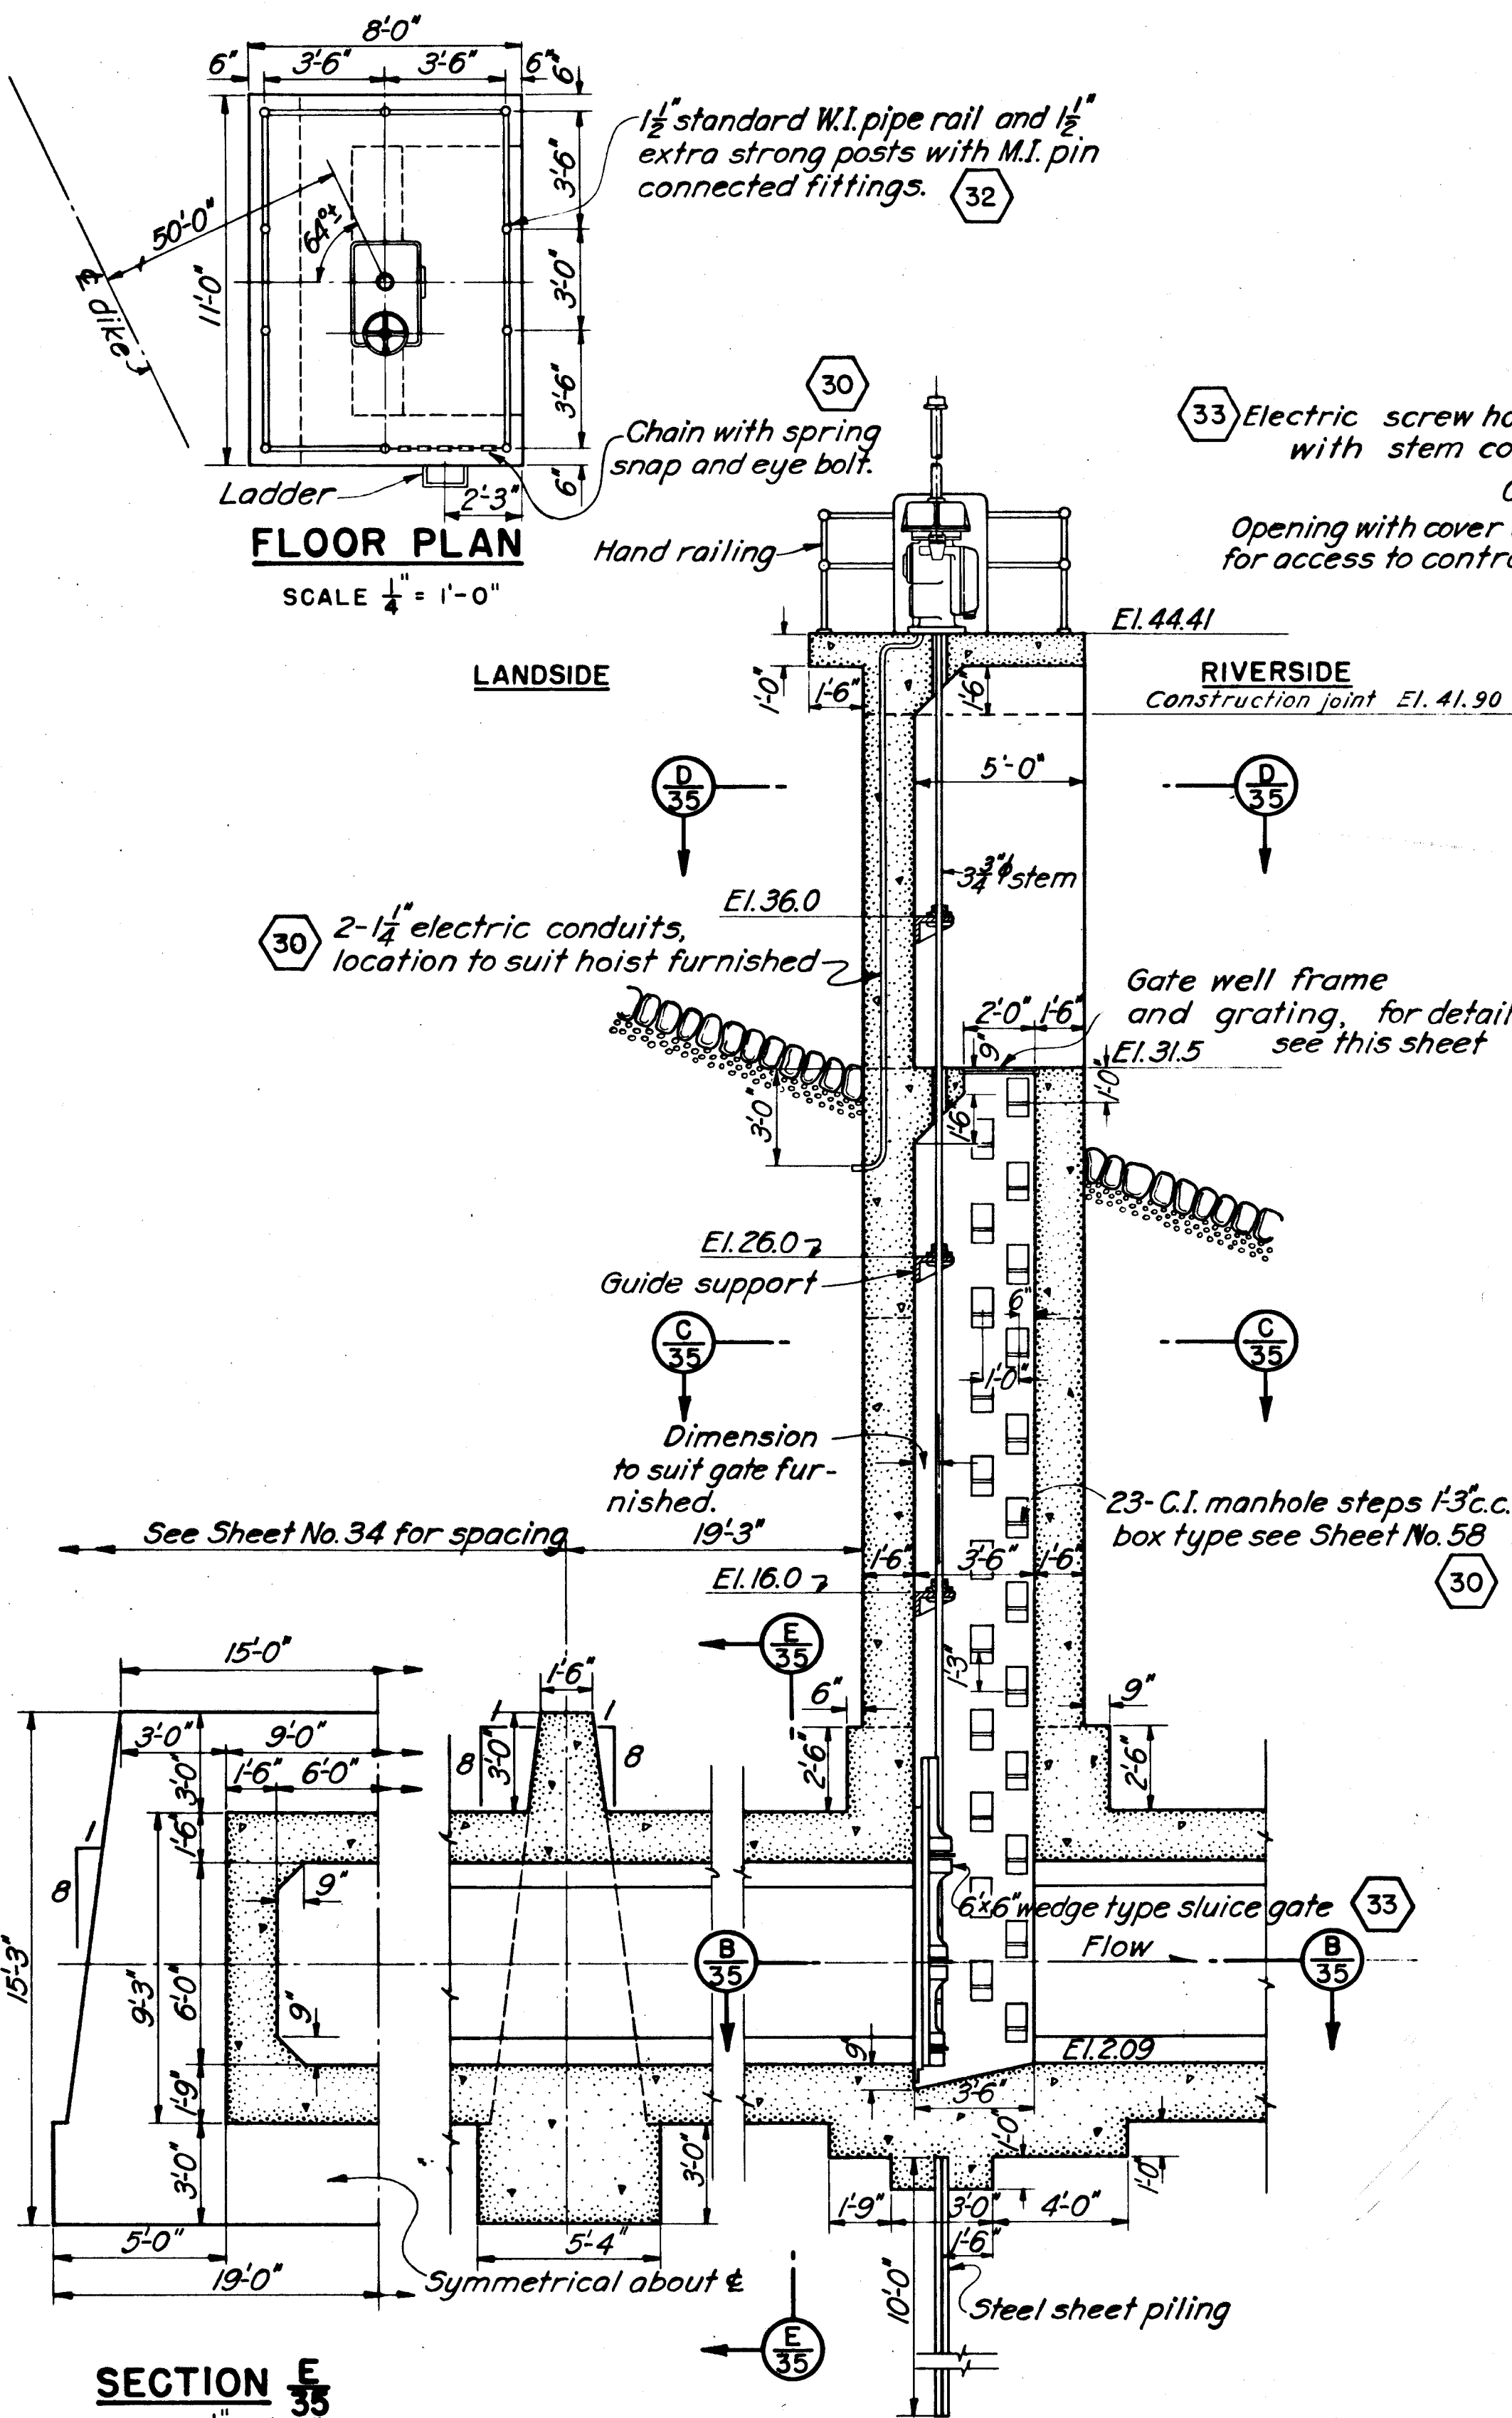
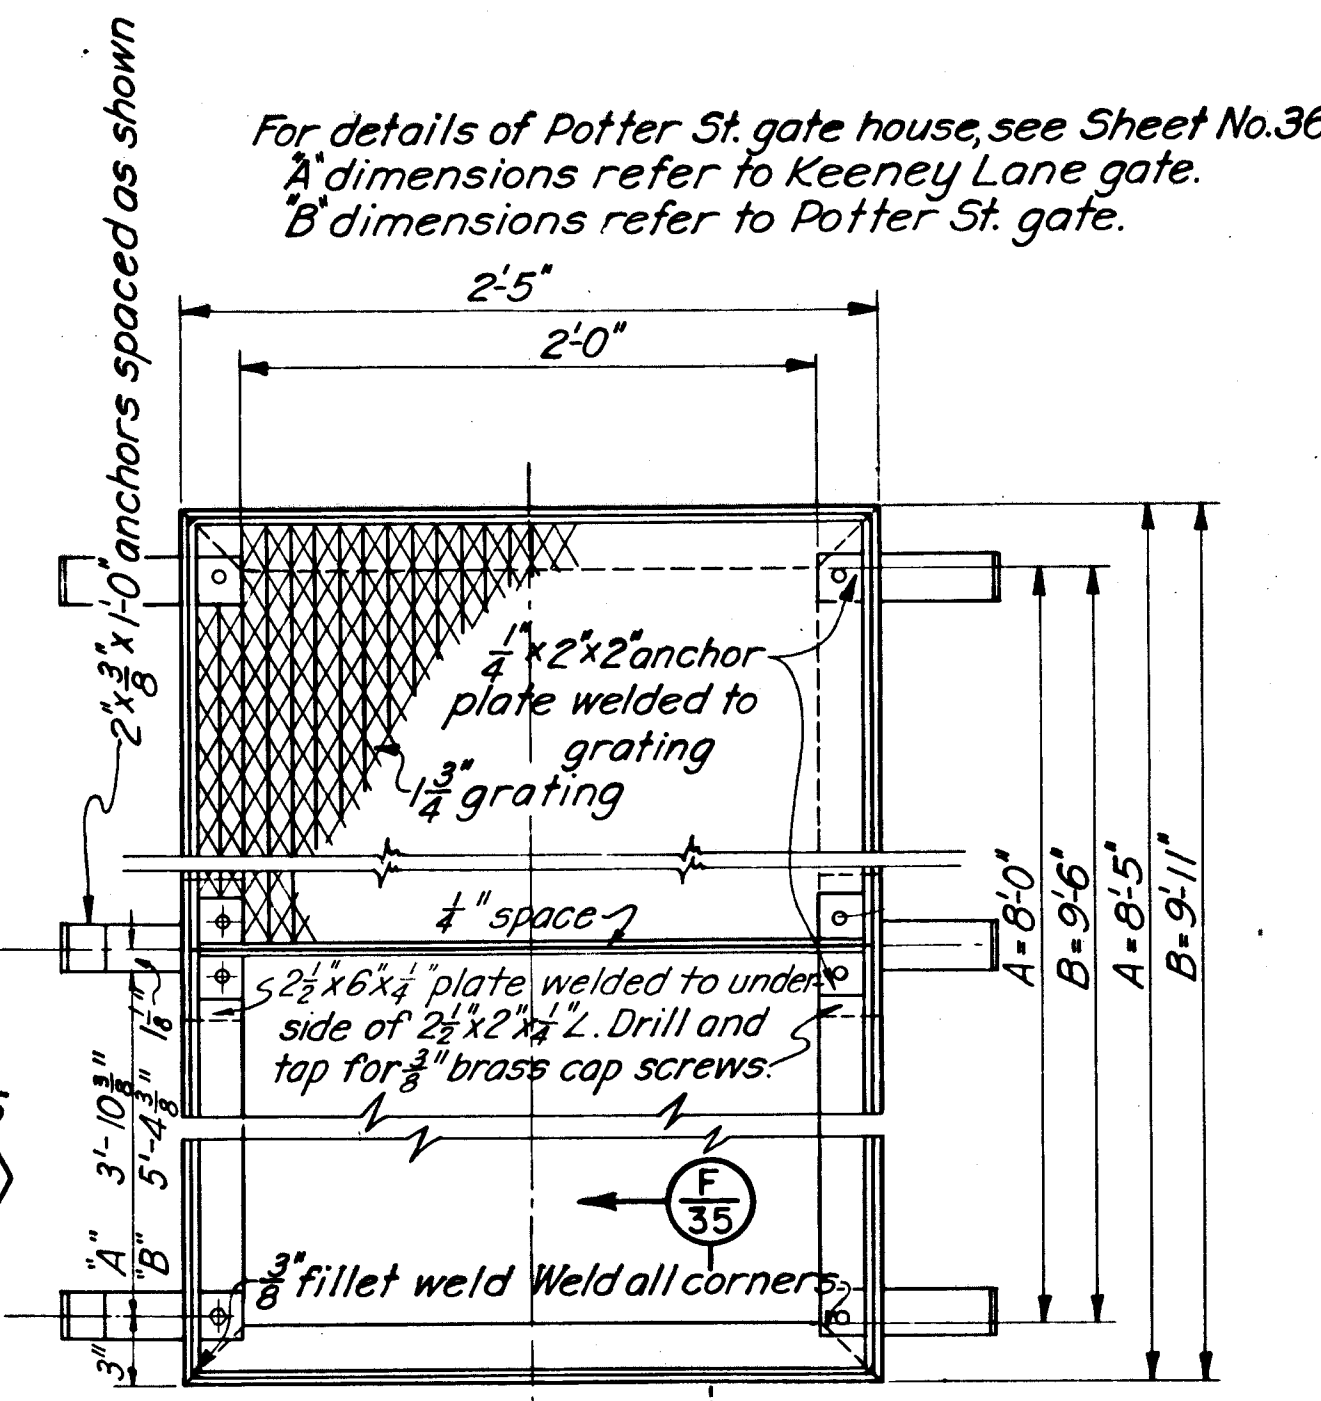
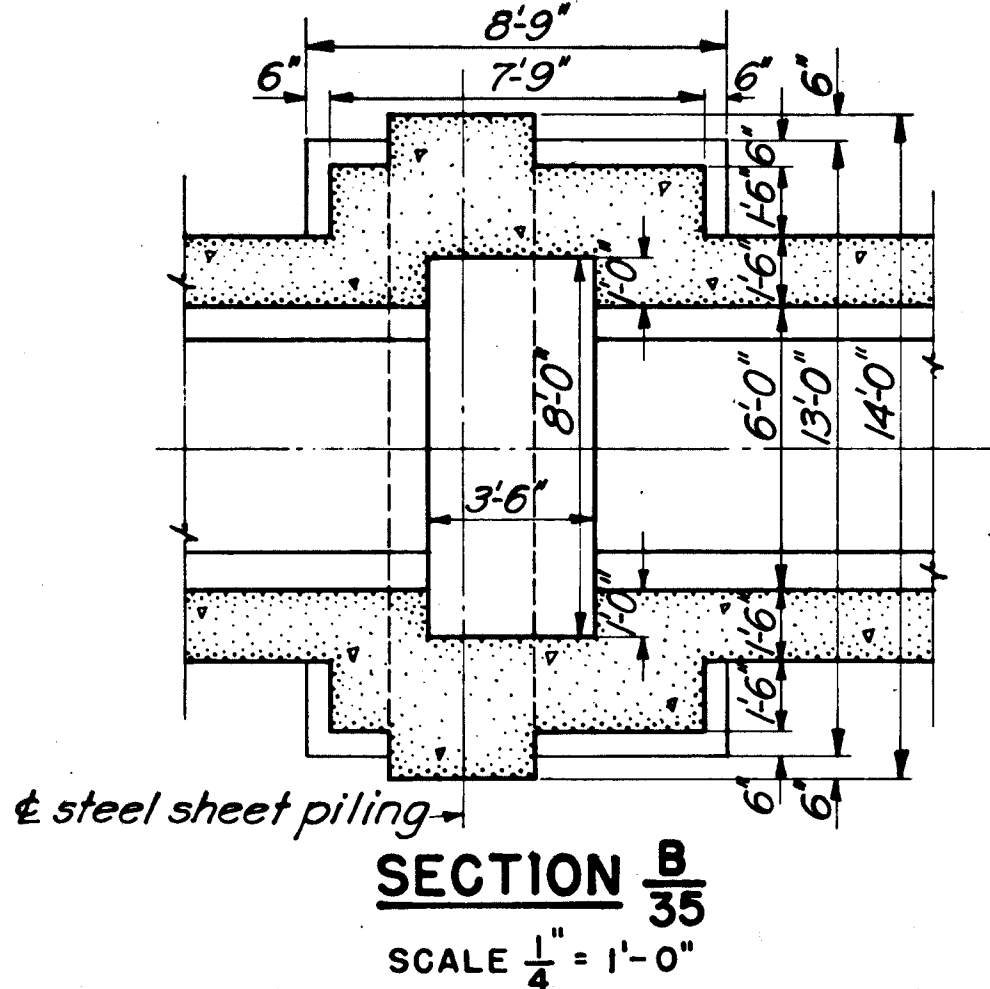
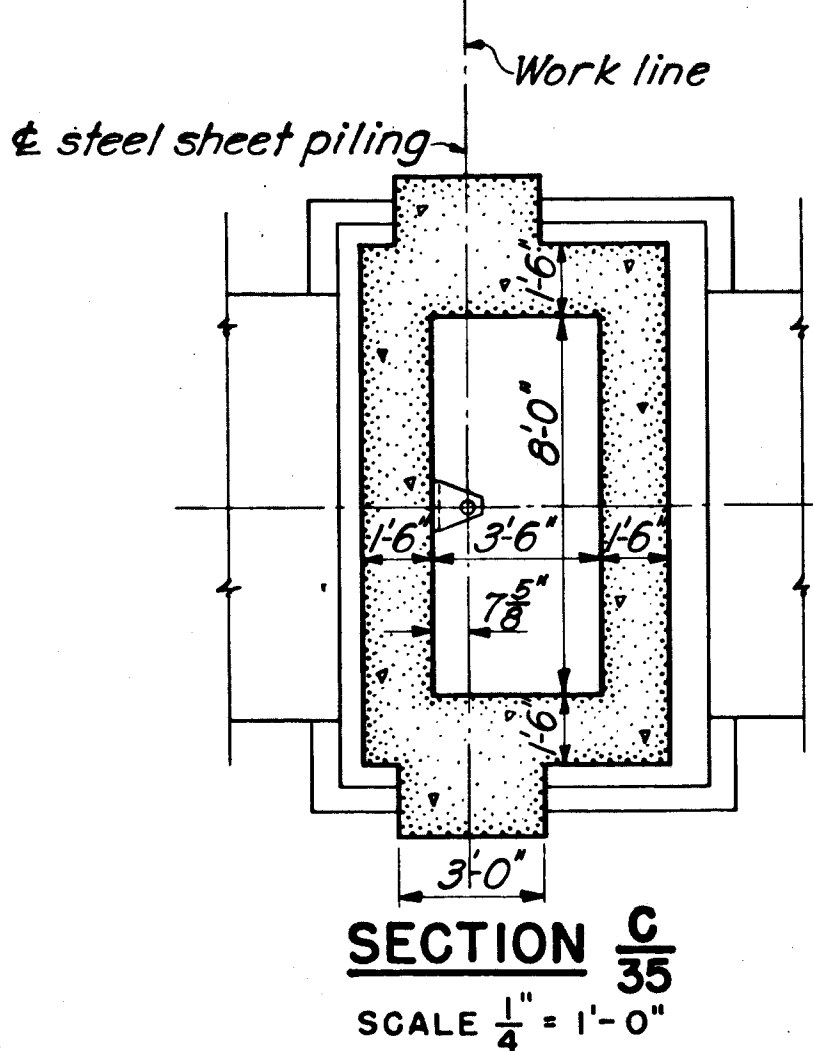


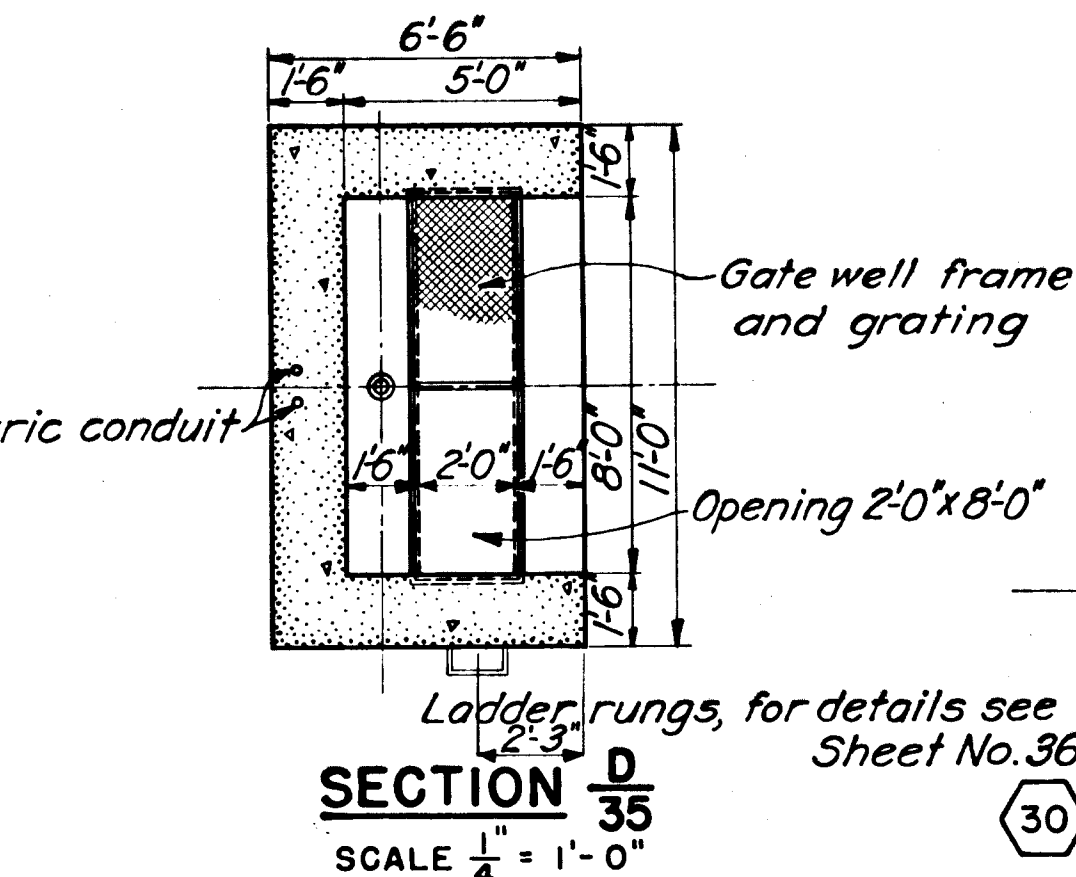

SECTION A
SCALE 1/4" = 1'-0"

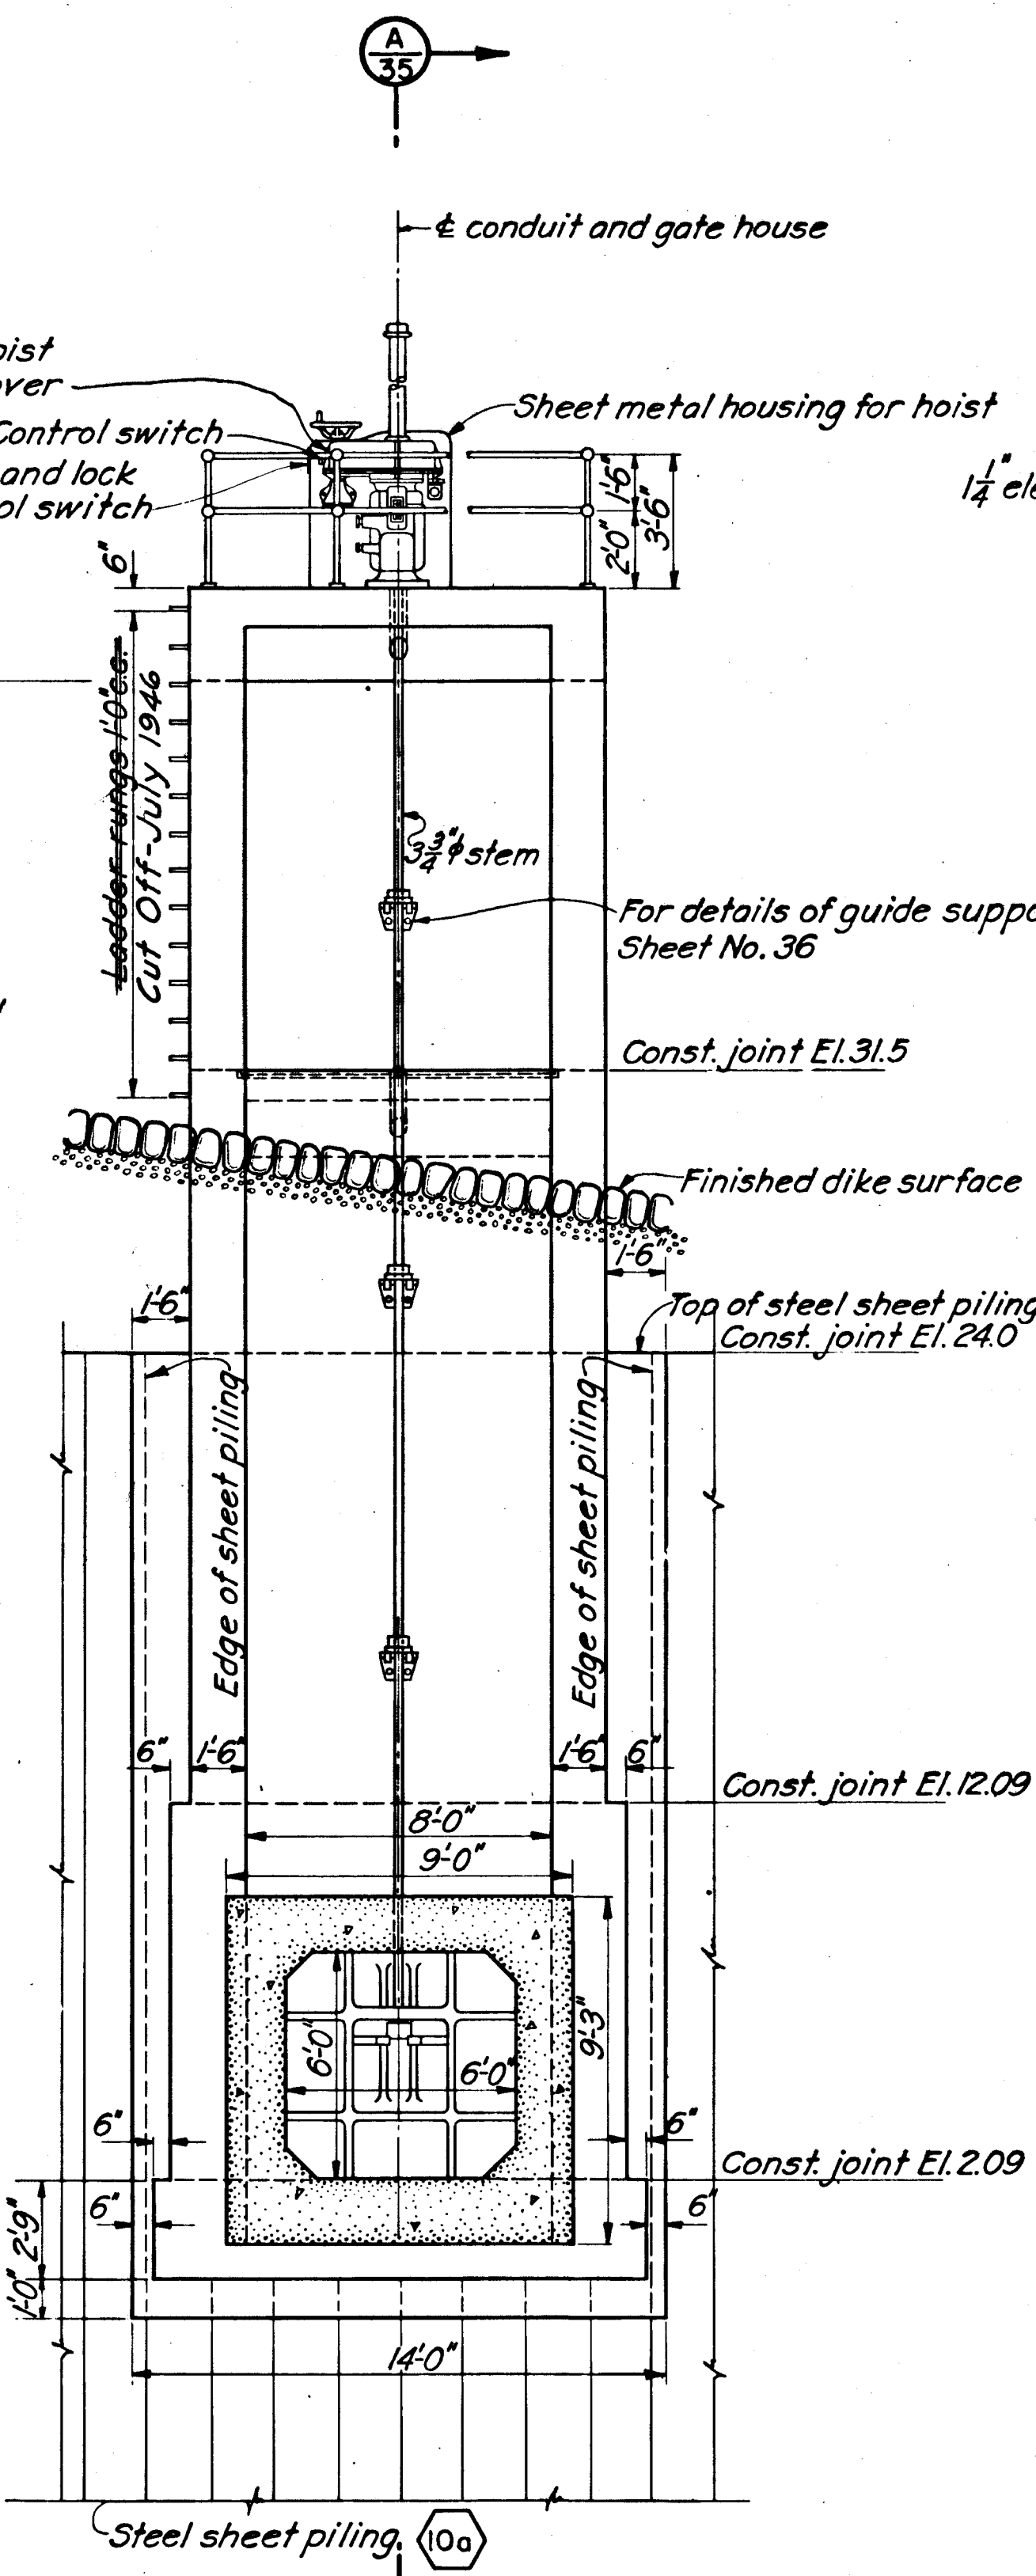

NOTES
Elevations refer to Mean Sea Level Datum.
For details of guide support anchor bolt see Sheet No. 36.

CONNECTICUT RIVER FLOOD CONTROL			
HARTFORD DIKE			
RIVERFRONT, MORGAN ST. TO STA. 96+73			
GATE STRUCTURE DETAILS			
KEENEY LANE			
CONNECTICUT RIVER	SCALE 1/4 IN. = 1 FT.	CONNECTICUT	SHEET NO. 35
IN 135 SHEETS			
U.S. ENGINEER OFFICE, PROVIDENCE, R.I., MAY 1940			
SUBMITTED:	APPROVAL RECOMMENDED:	APPROVED:	
Principal Engineer	Chief, F.C. Engineering Div.	District Engineer	
DESIGNED:	DRAWN:	FISCAL YEAR 1940	
TRACED:	CHECKED:	FILE NO. CT-4-2495	

12-31-45	As built revisions			
KEY	DATE	REVISION (Indicated by Δ)	REV. BY	CK. BY