

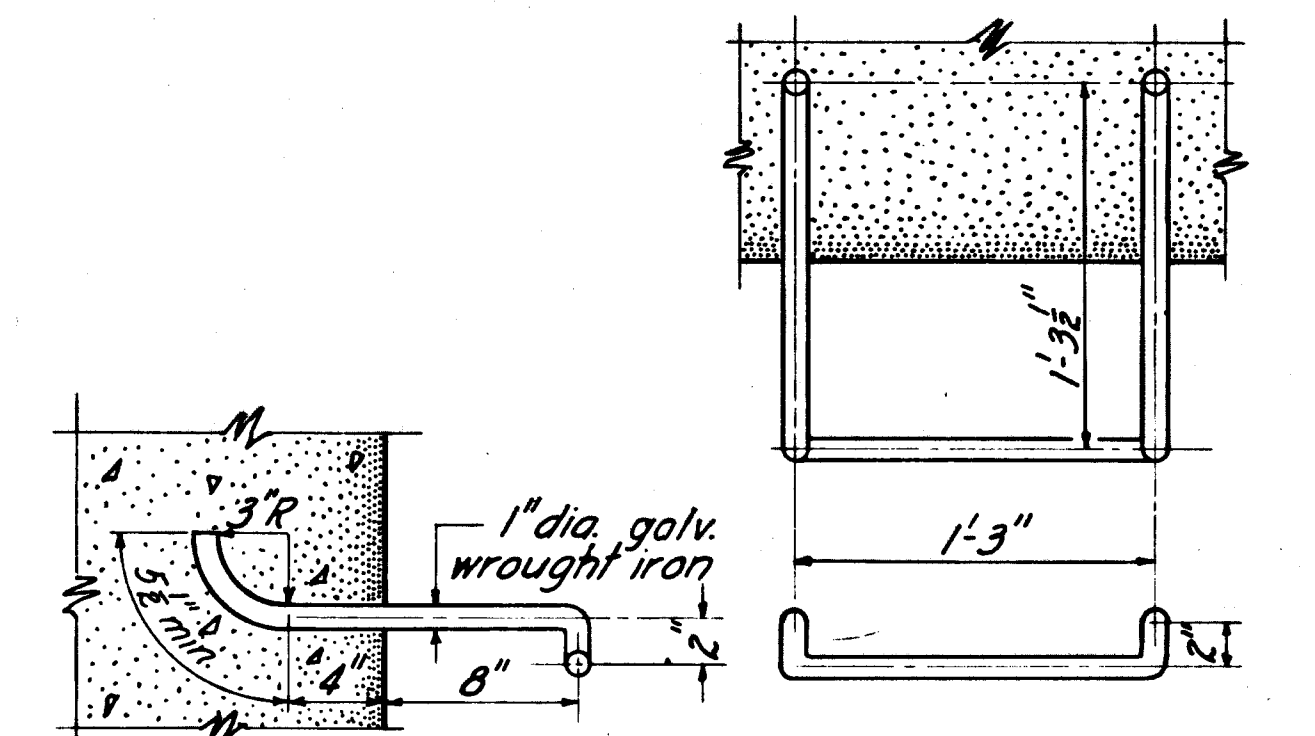


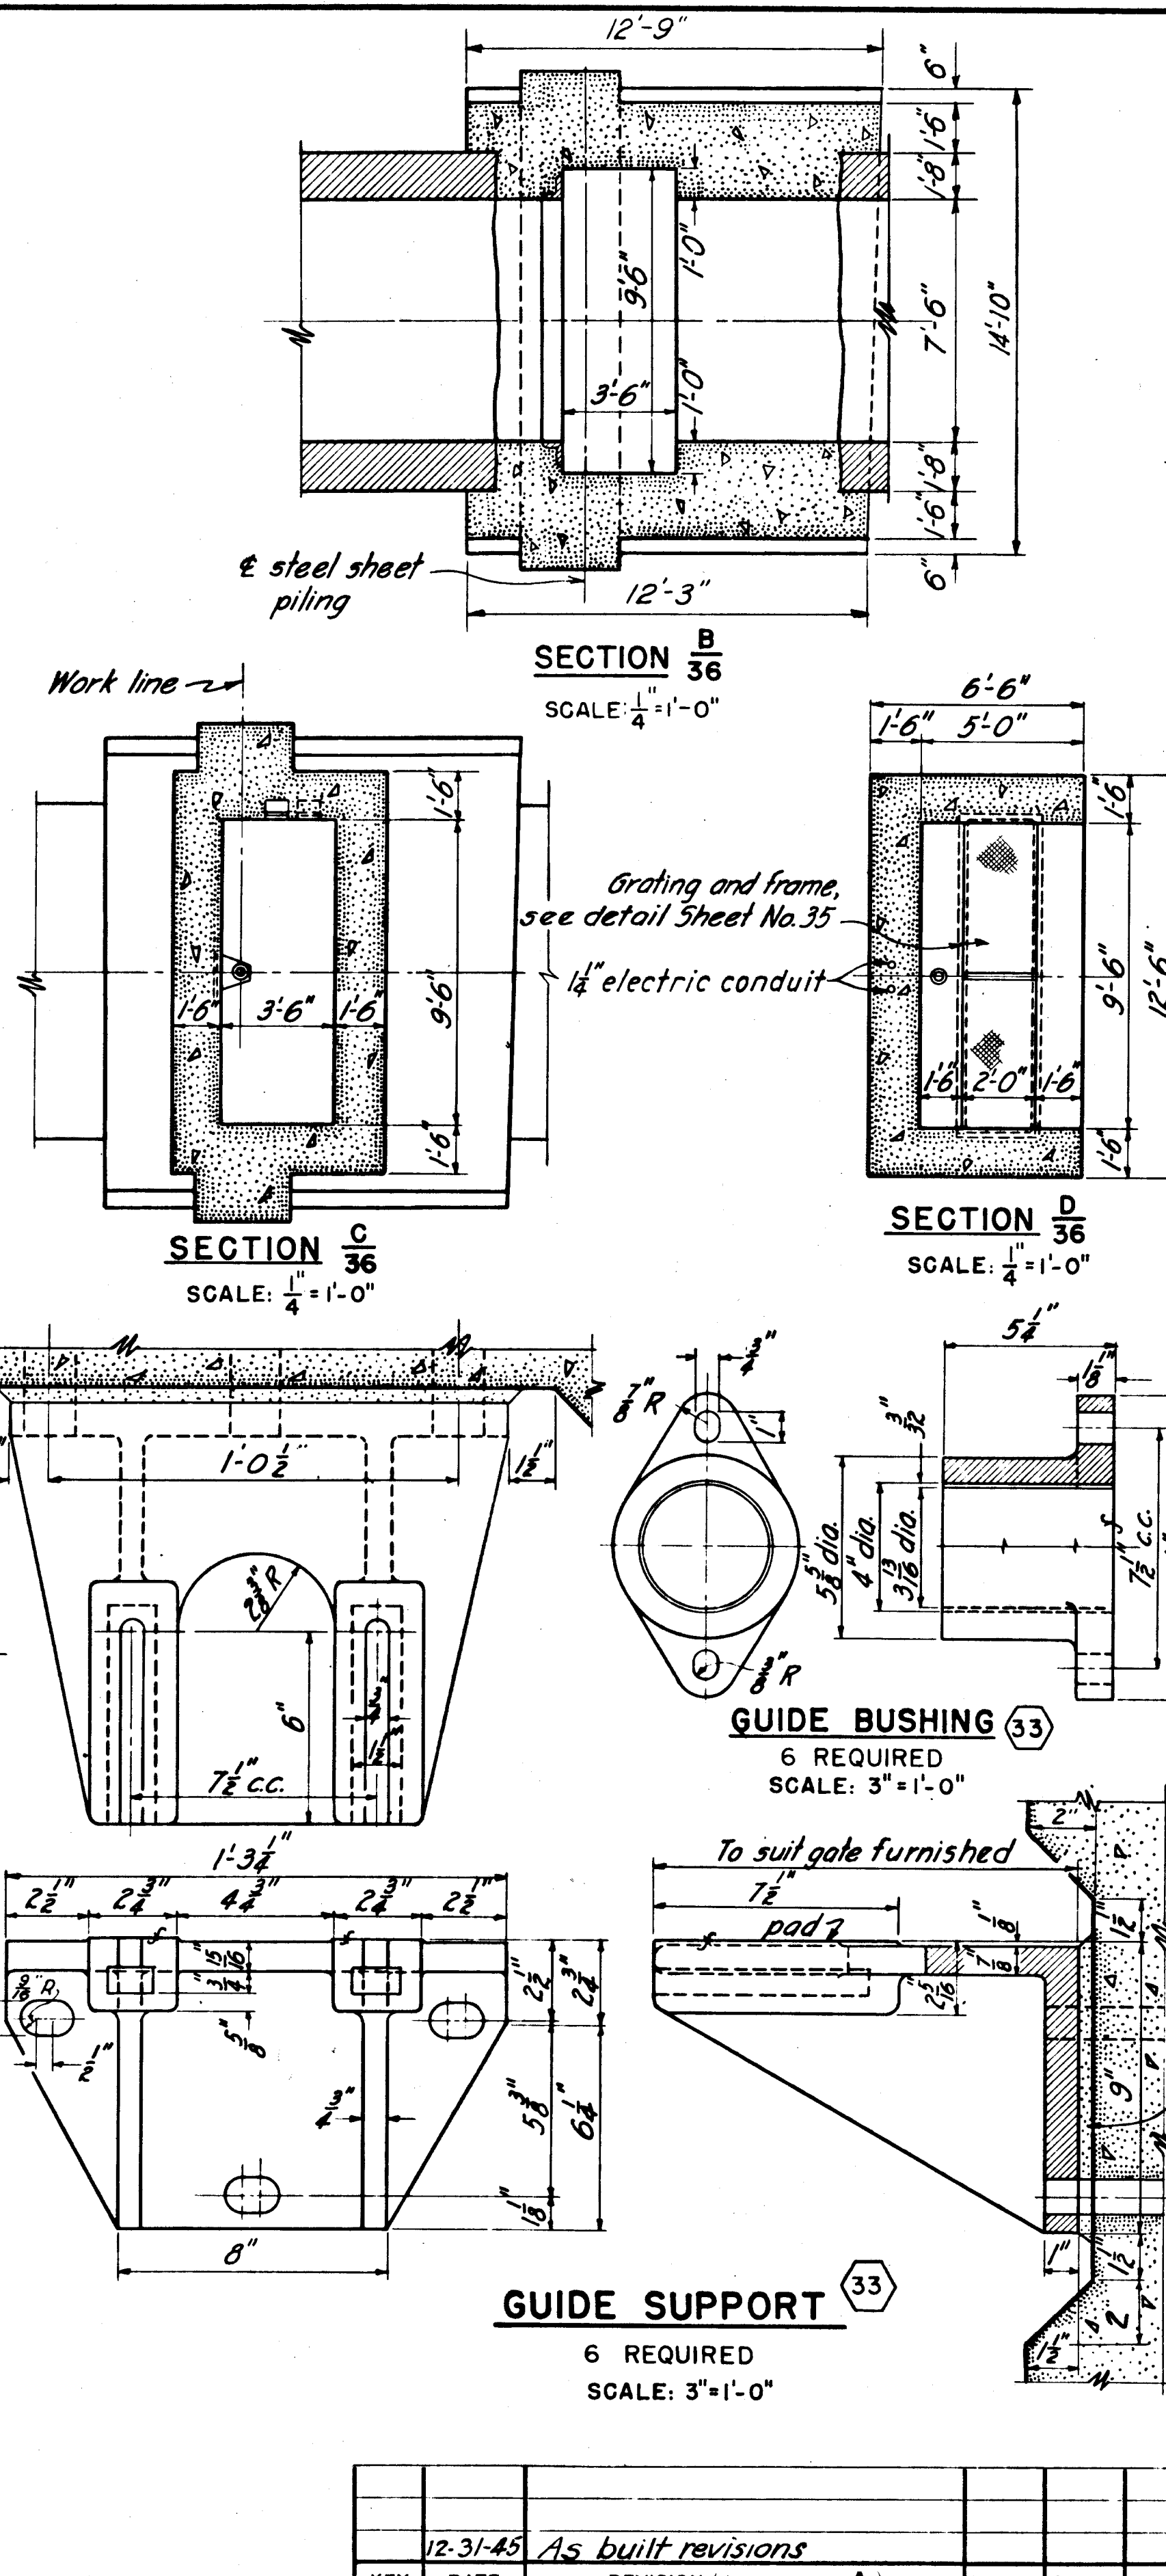

LADDER RUNG 

27 REQUIRED WEIGHT 324 LBS.

SCALE: $1\frac{1}{2}'' = 1'-0''$

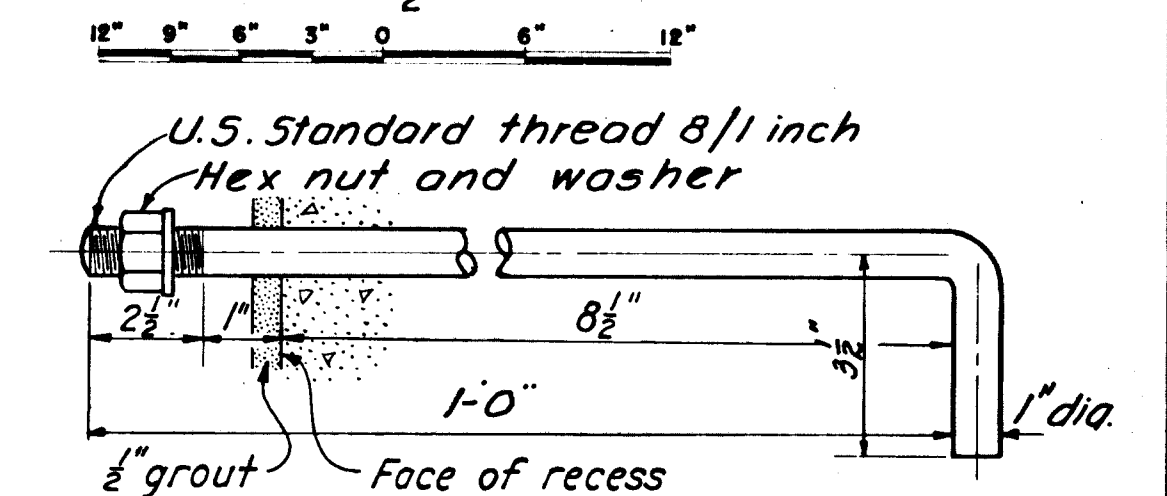

GUIDE SUPPORT ANCHOR BOLT

18 REQUIRED WEIGHT 60 LBS.

NOT TO SCALE

NOTES

Elevations refer to Mean Sea Level Datum.
For reinforcing steel see Sheet No. 109
Figures in hexagons indicate item number
under which payment will be made.
All concrete shall be class "A" and will be
paid for under item No. 24.

	12-31-45	As built revisions			
KEY	DATE	REVISION (Indicated by Δ)	REV. BY	CK. BY	AP.

CONNECTICUT RIVER FLOOD CONTROL HARTFORD DIKE RIVERFRONT, MORGAN ST. TO STA. 96+73 GATE STRUCTURE DETAILS POTTER STREET		
CONNECTICUT RIVER		CONNECTICUT
IN 135 SHEETS	SCALE: 1/4 IN. = 1 FT.	SHEET NO. 36
		
U.S. ENGINEER OFFICE, PROVIDENCE, R.I., MAY 1940		
SUBMITTED: <i>Kenneth B. Sullivan</i> SENIOR ENGINEER HEAD, DESIGN SECTION	APPROVAL RECOMMENDED: <i>J. Burns</i> PRINCIPAL ENGINEER CHIEF, F.G. ENGINEERING DIV.	APPROVED: <i>W. H. Bradley</i> COL., CORPS OF ENGINEERS DISTRICT ENGINEER
DESIGNED: <i>A. H. H. H.</i> CHIEF, F.G. DIV.	DRAWN: K. H. W. TRACED: L. A. D. CHECKED: J. O. F.	
	FISCAL YEAR 1940 FILE NO. CT-4-2496	