
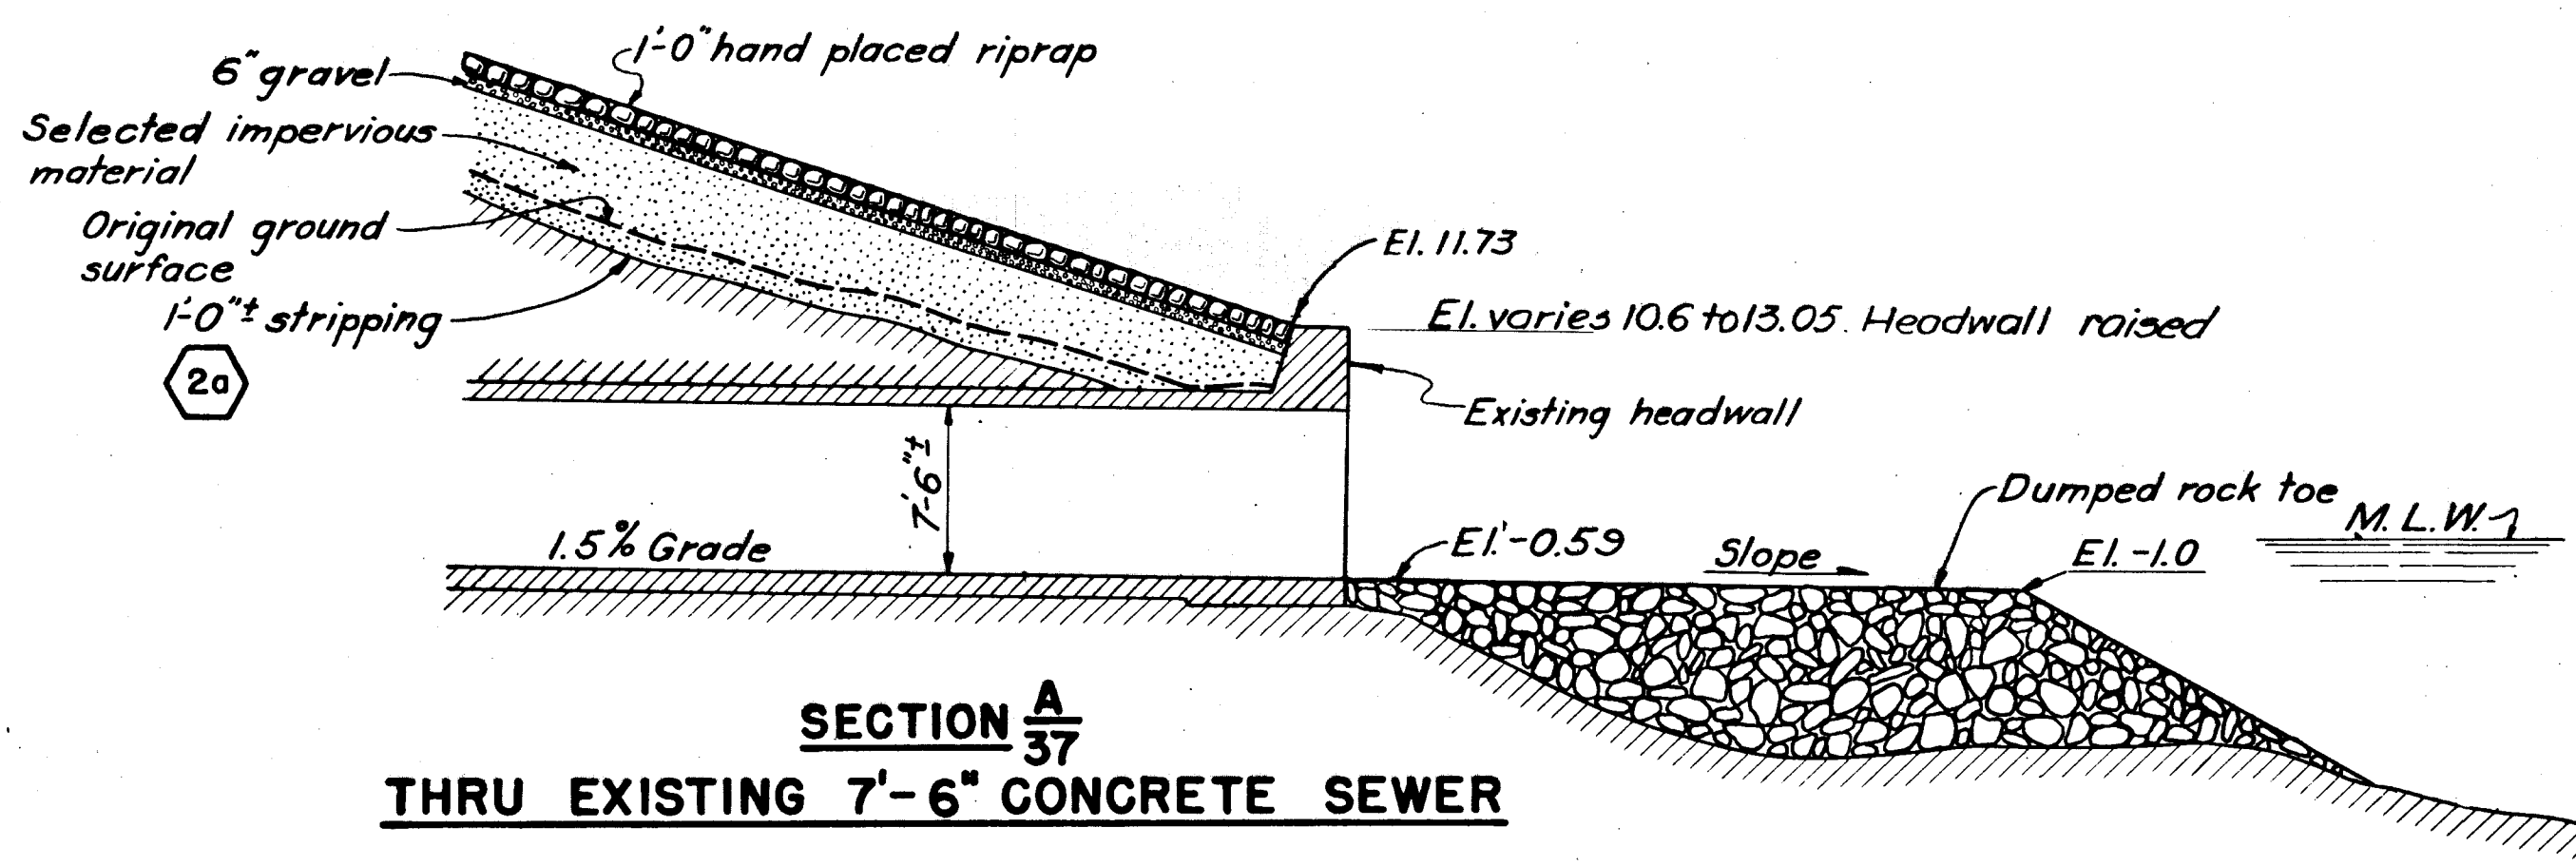
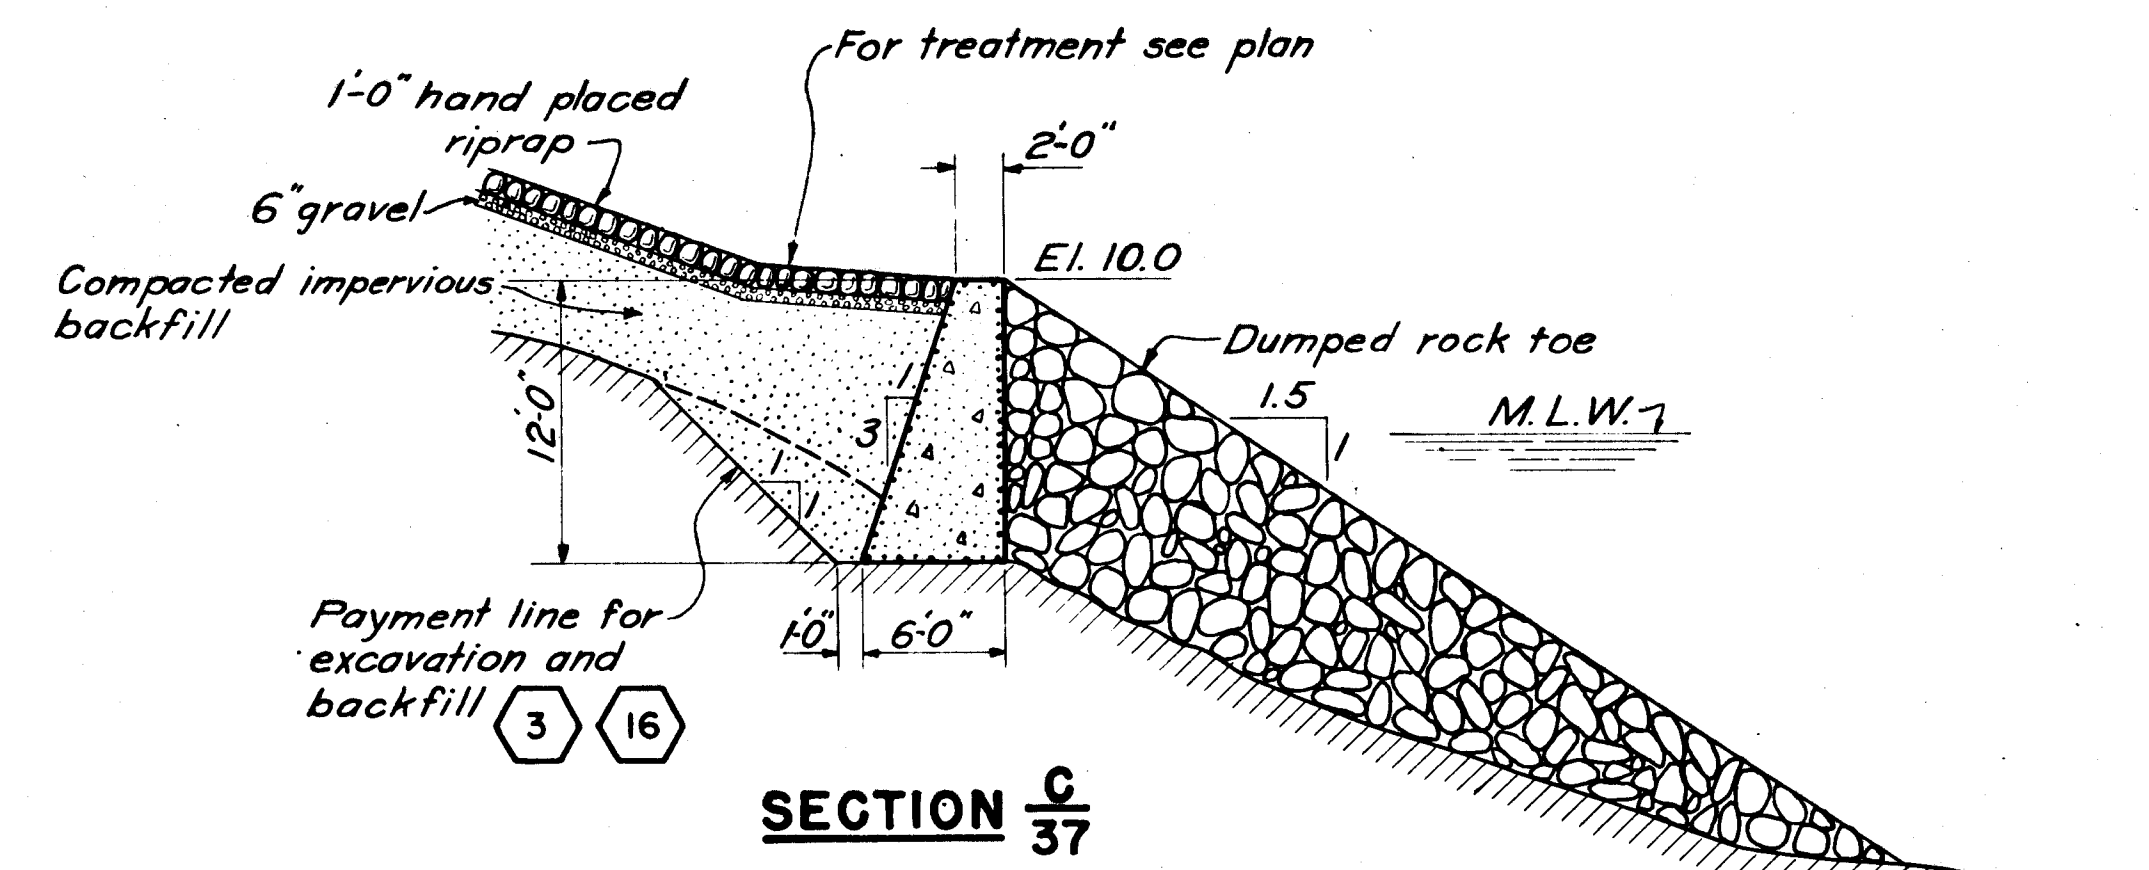
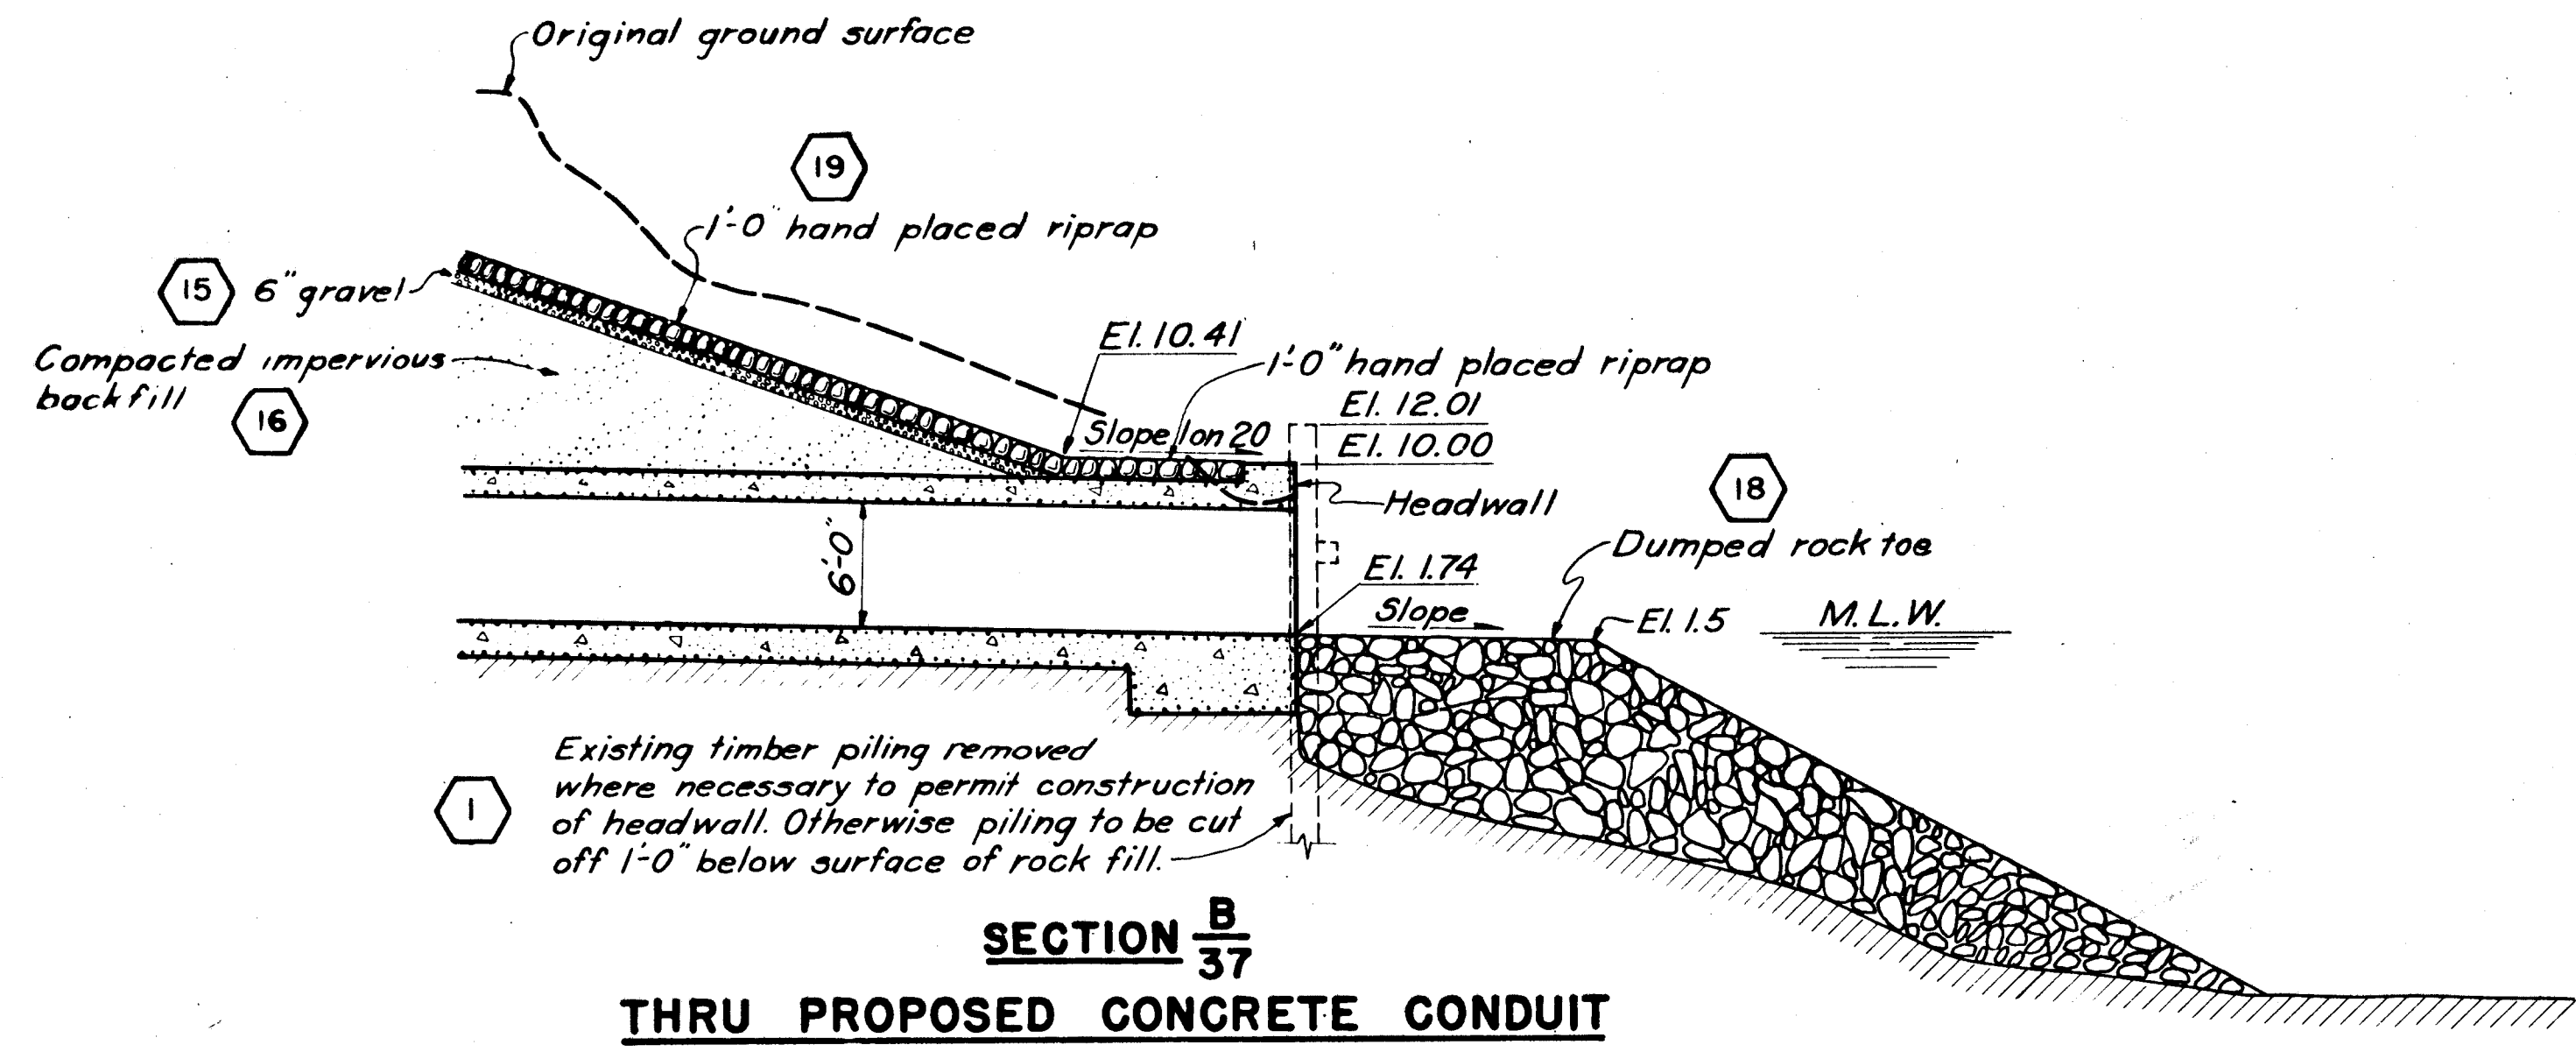


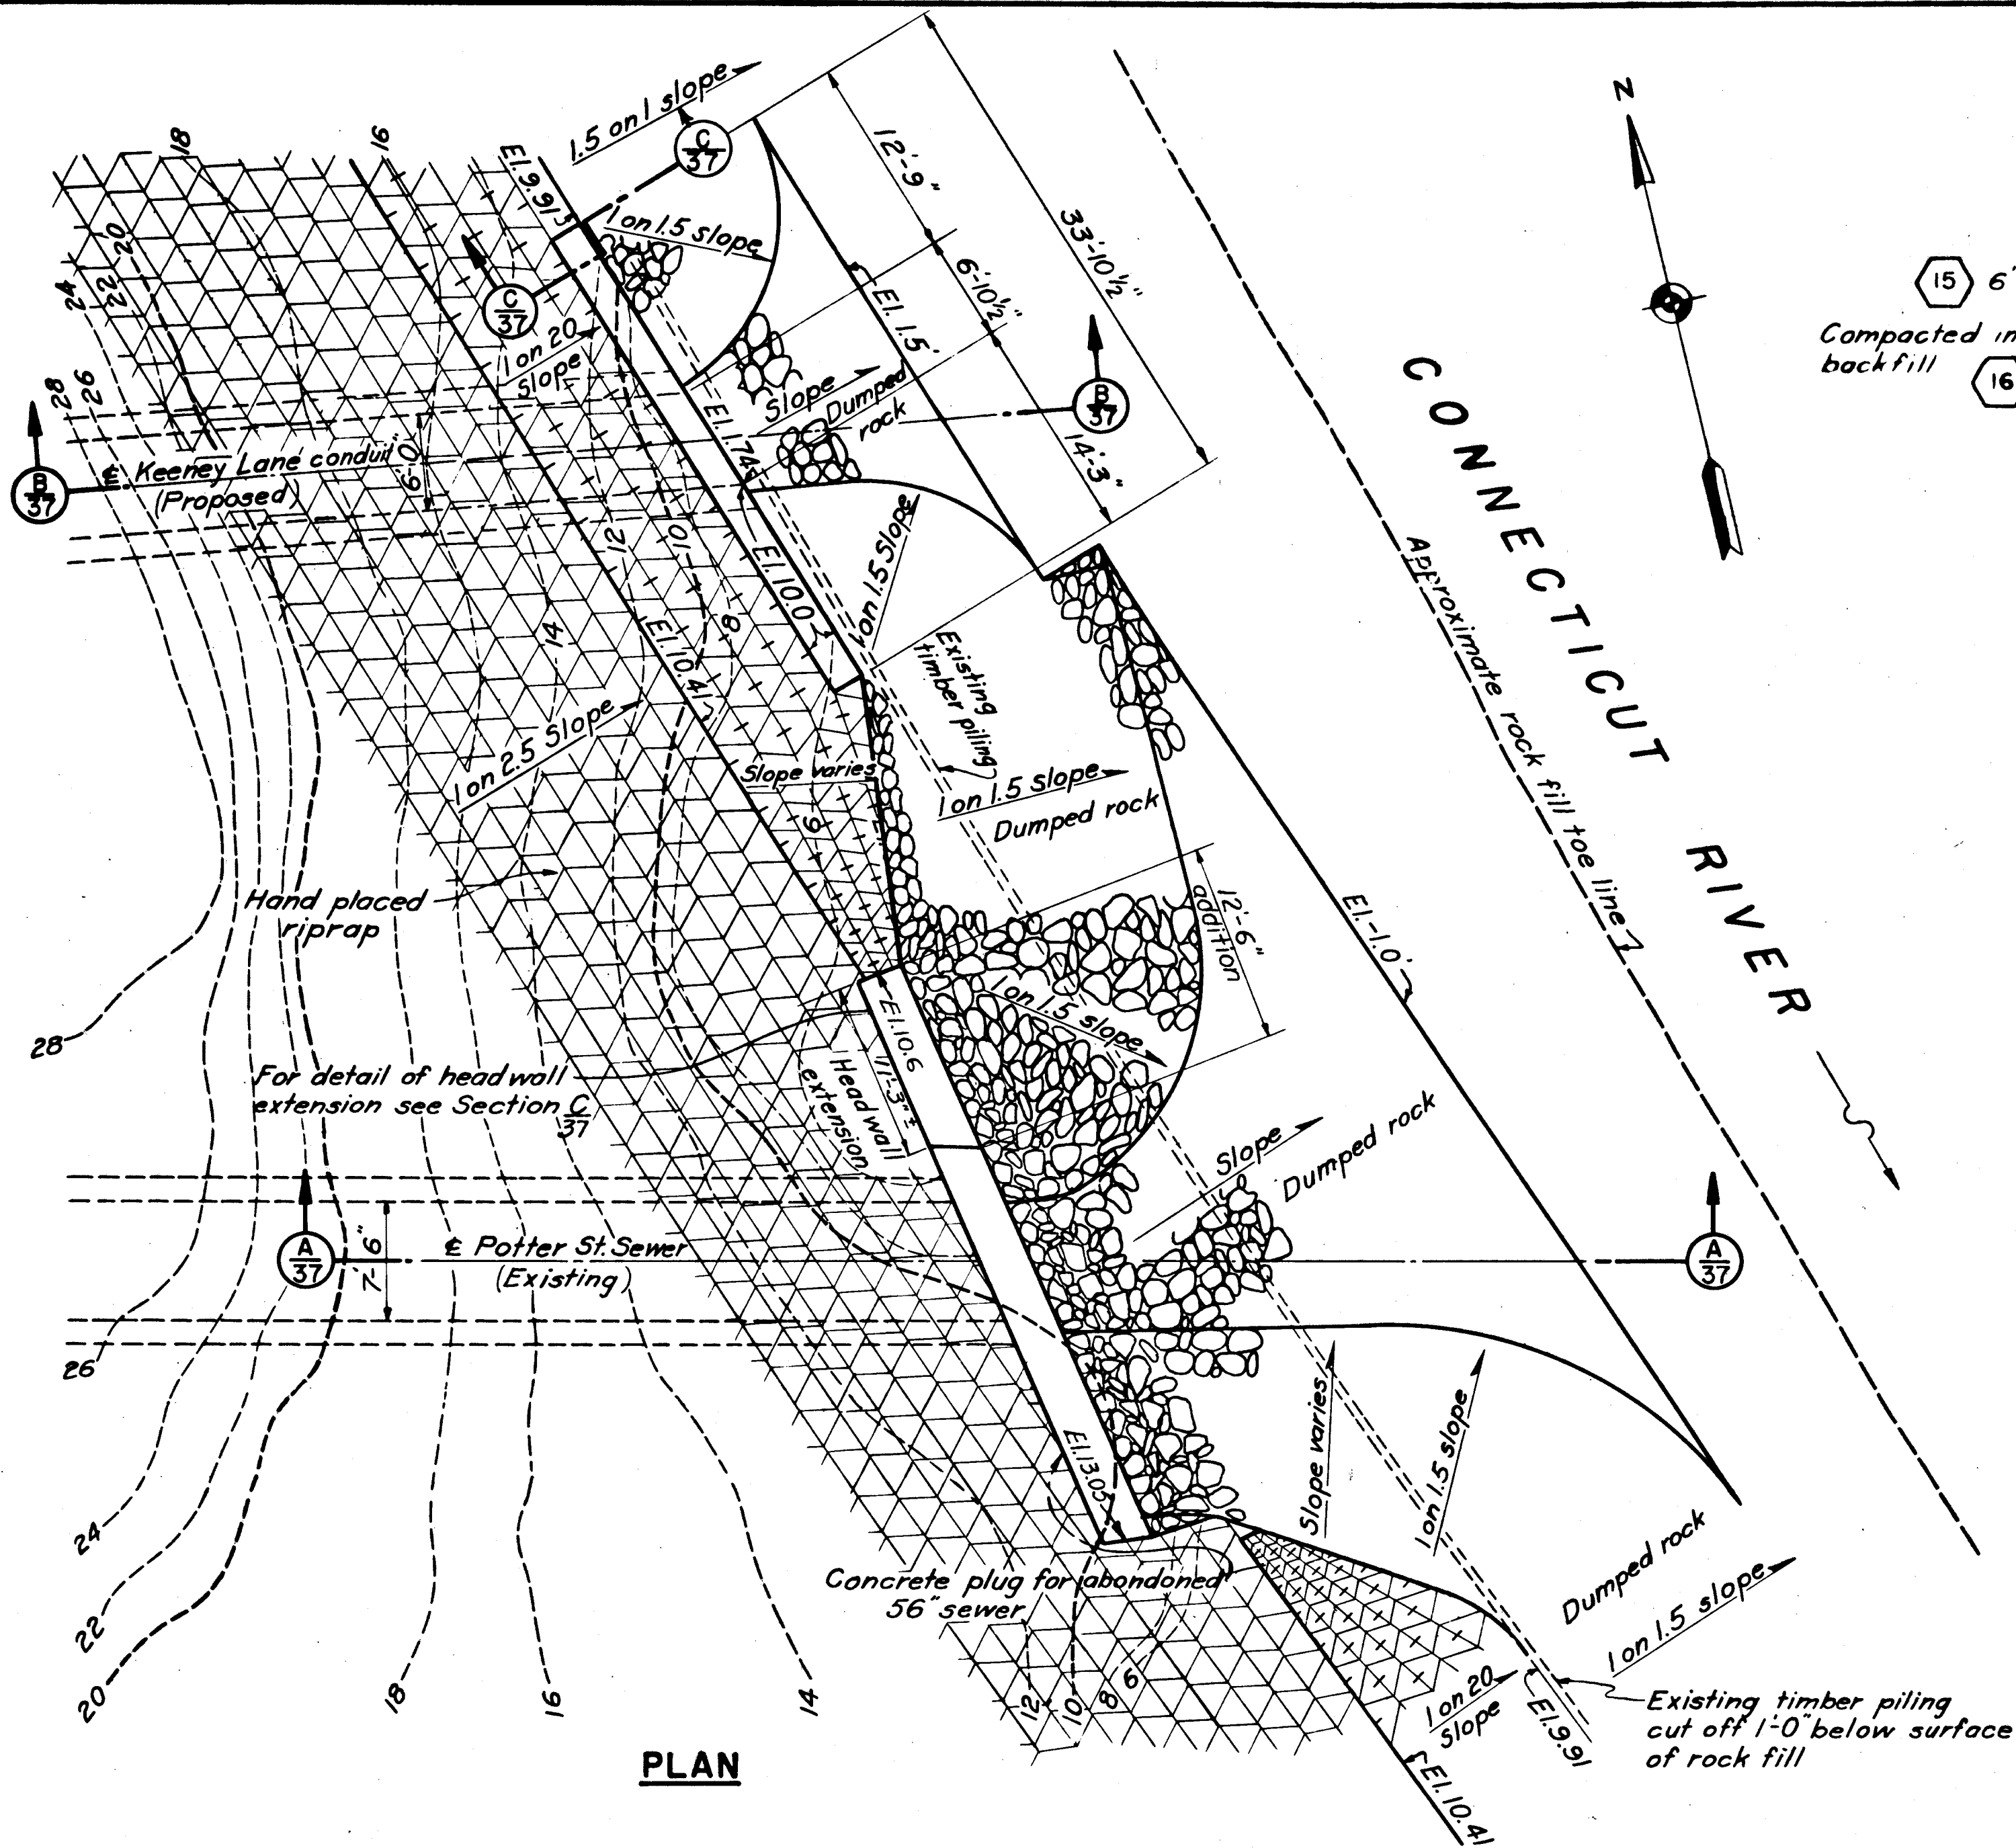

NOTES

Elevations refer to Mean Sea Level Datum.

All concrete shown on this sheet shall be Class "A" and will be paid for under Item No. 24.

For details of Potter Street sewer and Keeney Lane conduit see Sheets No. 33 and 34.

For embankment details see Sheet No. 25.

KEY	DATE	REVISION (Indicated by Δ)	REV. BY	CK. BY	AP. BY
	12-31-45	As built revisions			

CONNECTICUT RIVER FLOOD CONTROL		
HARTFORD DIKE		
RIVERFRONT, MORGAN ST. TO STA. 96+73		
PLAN, DETAILS AND SECTION		
KEENEY LANE AND POTTER ST. OUTLETS		
CONNECTICUT RIVER		
IN 135 SHEETS		
SCALE: 1/8" = 1 FT.		
SHEET NO. 37		
U.S. ENGINEER OFFICE, PROVIDENCE, R.I., MAY 1940		
SUBMITTED:	APPROVAL RECOMMENDED:	APPROVED:
DESIGNED:	PRINCIPAL ENGINEER	U.S. COL. CORPS OF ENGINEERS
HEAD. DESIGN SECTION	CHIEF, F.C. ENGINEERING DIV.	DISTRICT ENGINEER
DRAWN: W.B.	TRACED: C.J.P.	FISCAL YEAR 1940
CHECKED: W.G.C.		FILE NO. CT-4-2497