


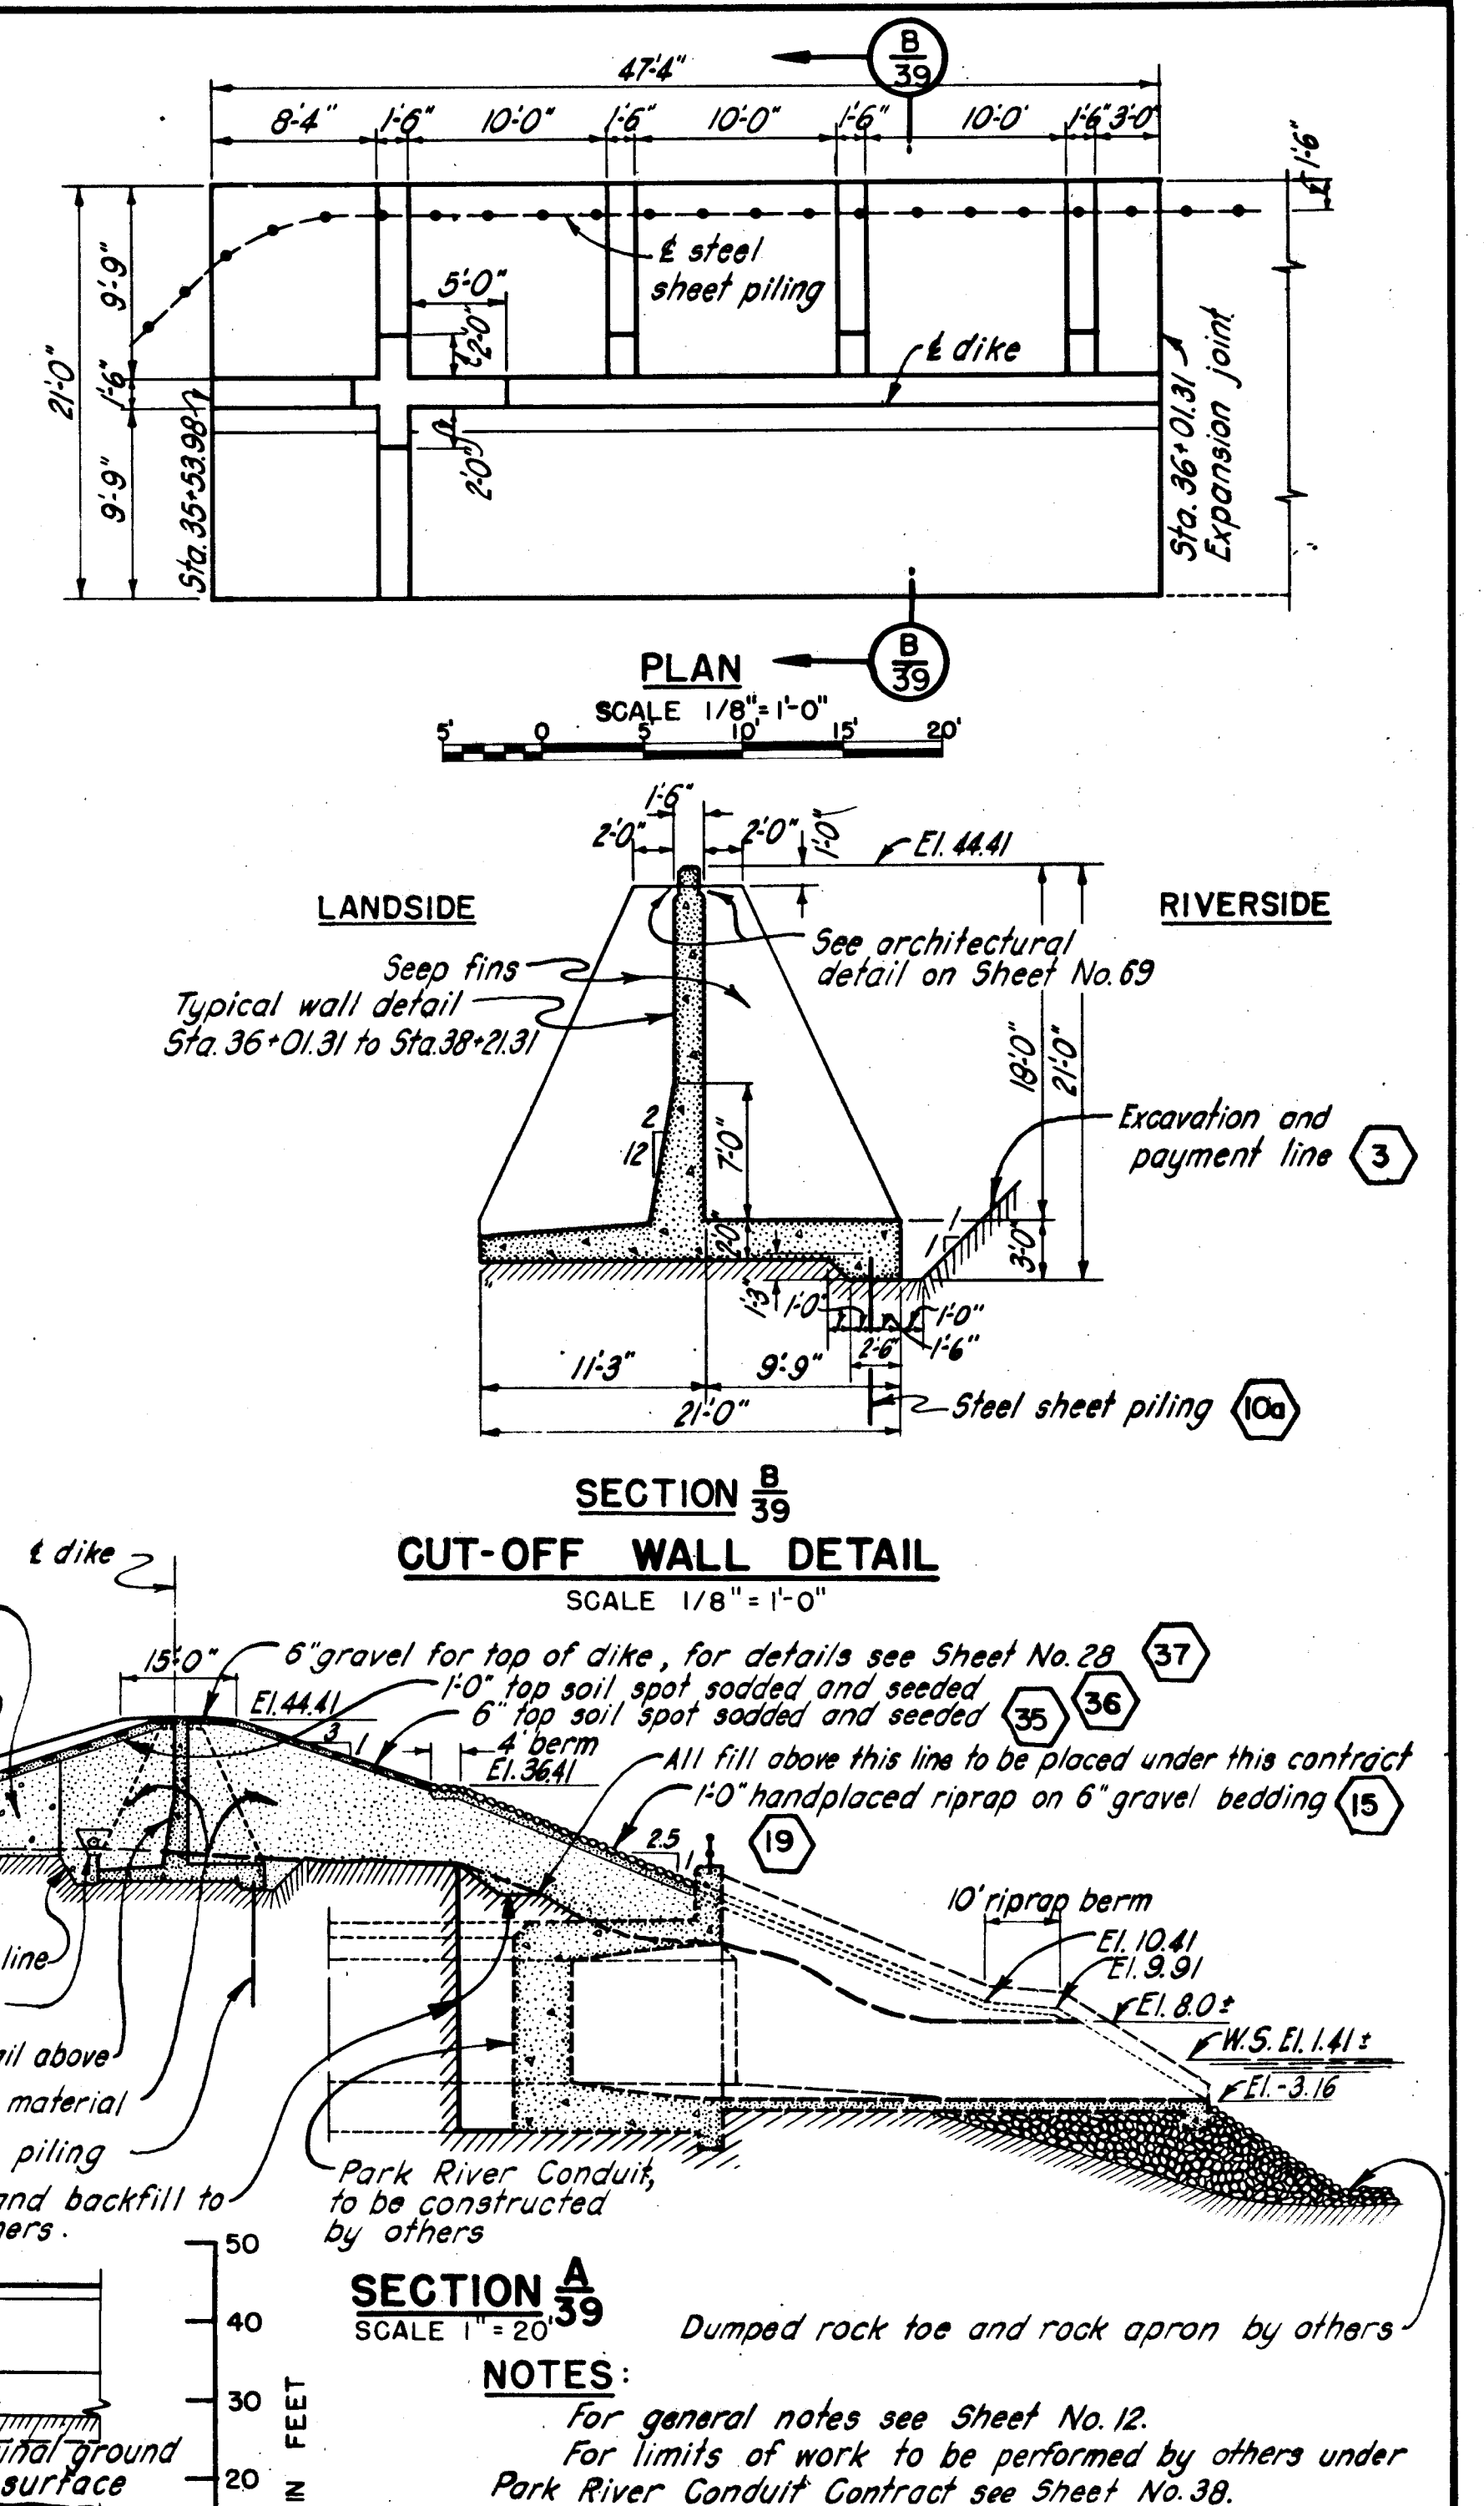

	12-31-45	As built revisions			
	10/6/41	Drain revised	P.C.H.		
	3/10/41	Riverside slope revised	W.D.C.		
KEY	DATE	REVISION (Indicated by )	REV. BY	CK. BY	AP. BY

CONNECTICUT RIVER FLOOD CONTROL		
HARTFORD DIKE		
RIVERFRONT, MORGAN ST. TO STA. 96+73		
PLAN DETAILS AND SECTIONS		
STA. 35+00 TO STA. 39+00		
CONNECTICUT RIVER	CONNECTICUT	
IN 135 SHEETS	SHEET NO. 39	
U. S. ENGINEER OFFICE, PROVIDENCE, R.I., MAY 1940		
SUBMITTED: <i>Robert B. Deane</i> SENIOR ENGINEER HEAD, DESIGN SECTION	APPROVED, RECOMMENDED: <i>J. H. Burna</i> PRINCIPAL ENGINEER CHIEF, P.C. ENGINEERING DIV.	APPROVED: <i>W. H. Mader</i> COL. CORPS OF ENGINEERS DISTRICT ENGINEER
DESIGNED: <i>J. H. Mader</i> ASSOC. ENGINEER	DRAWN: H. C. J. TRACED: J. A. C. CHECKED: <i>W. C. C.</i>	FISCAL YEAR 1940 FILE NO. CT-4-2499