

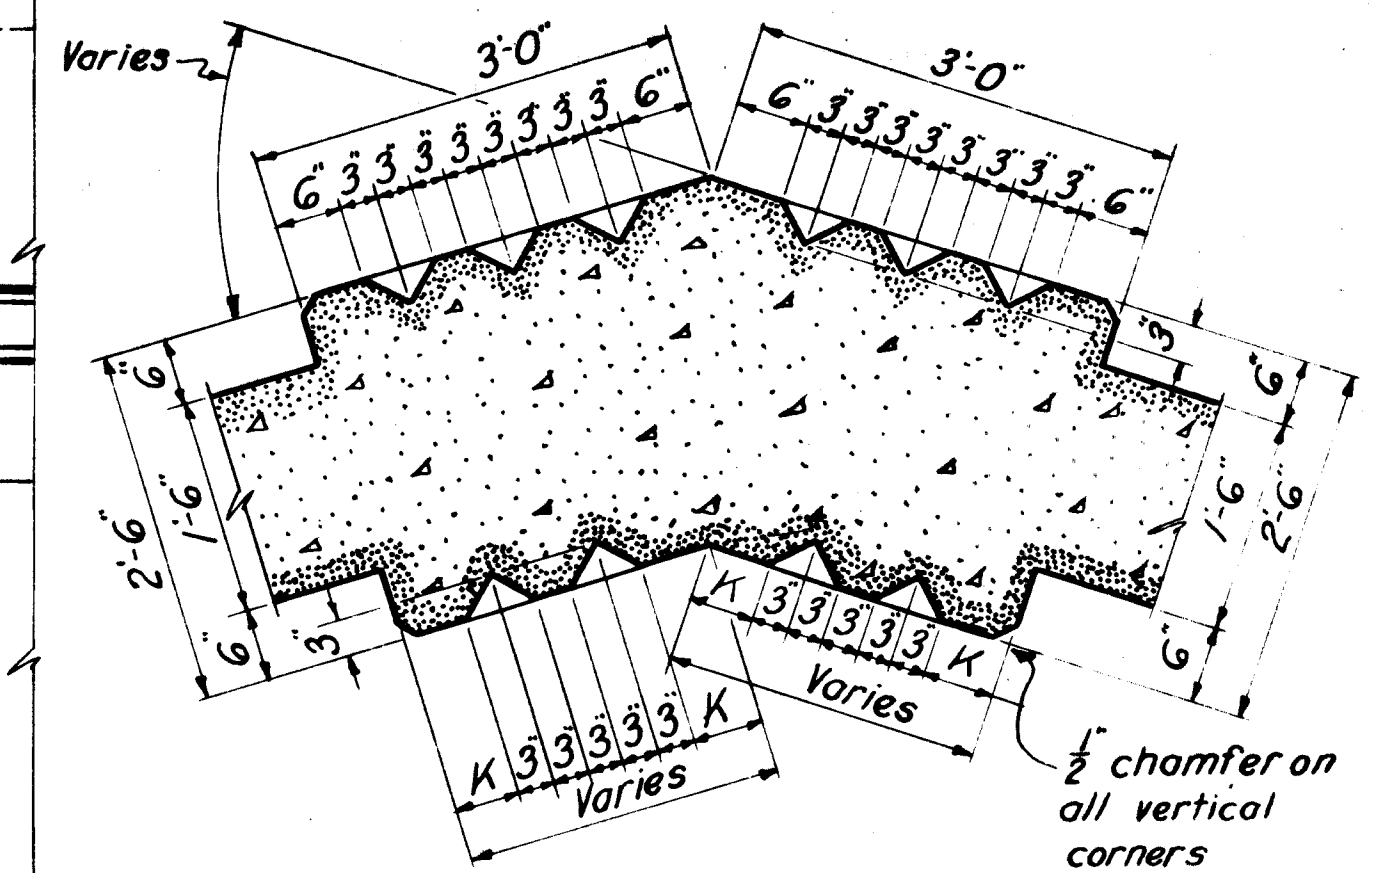
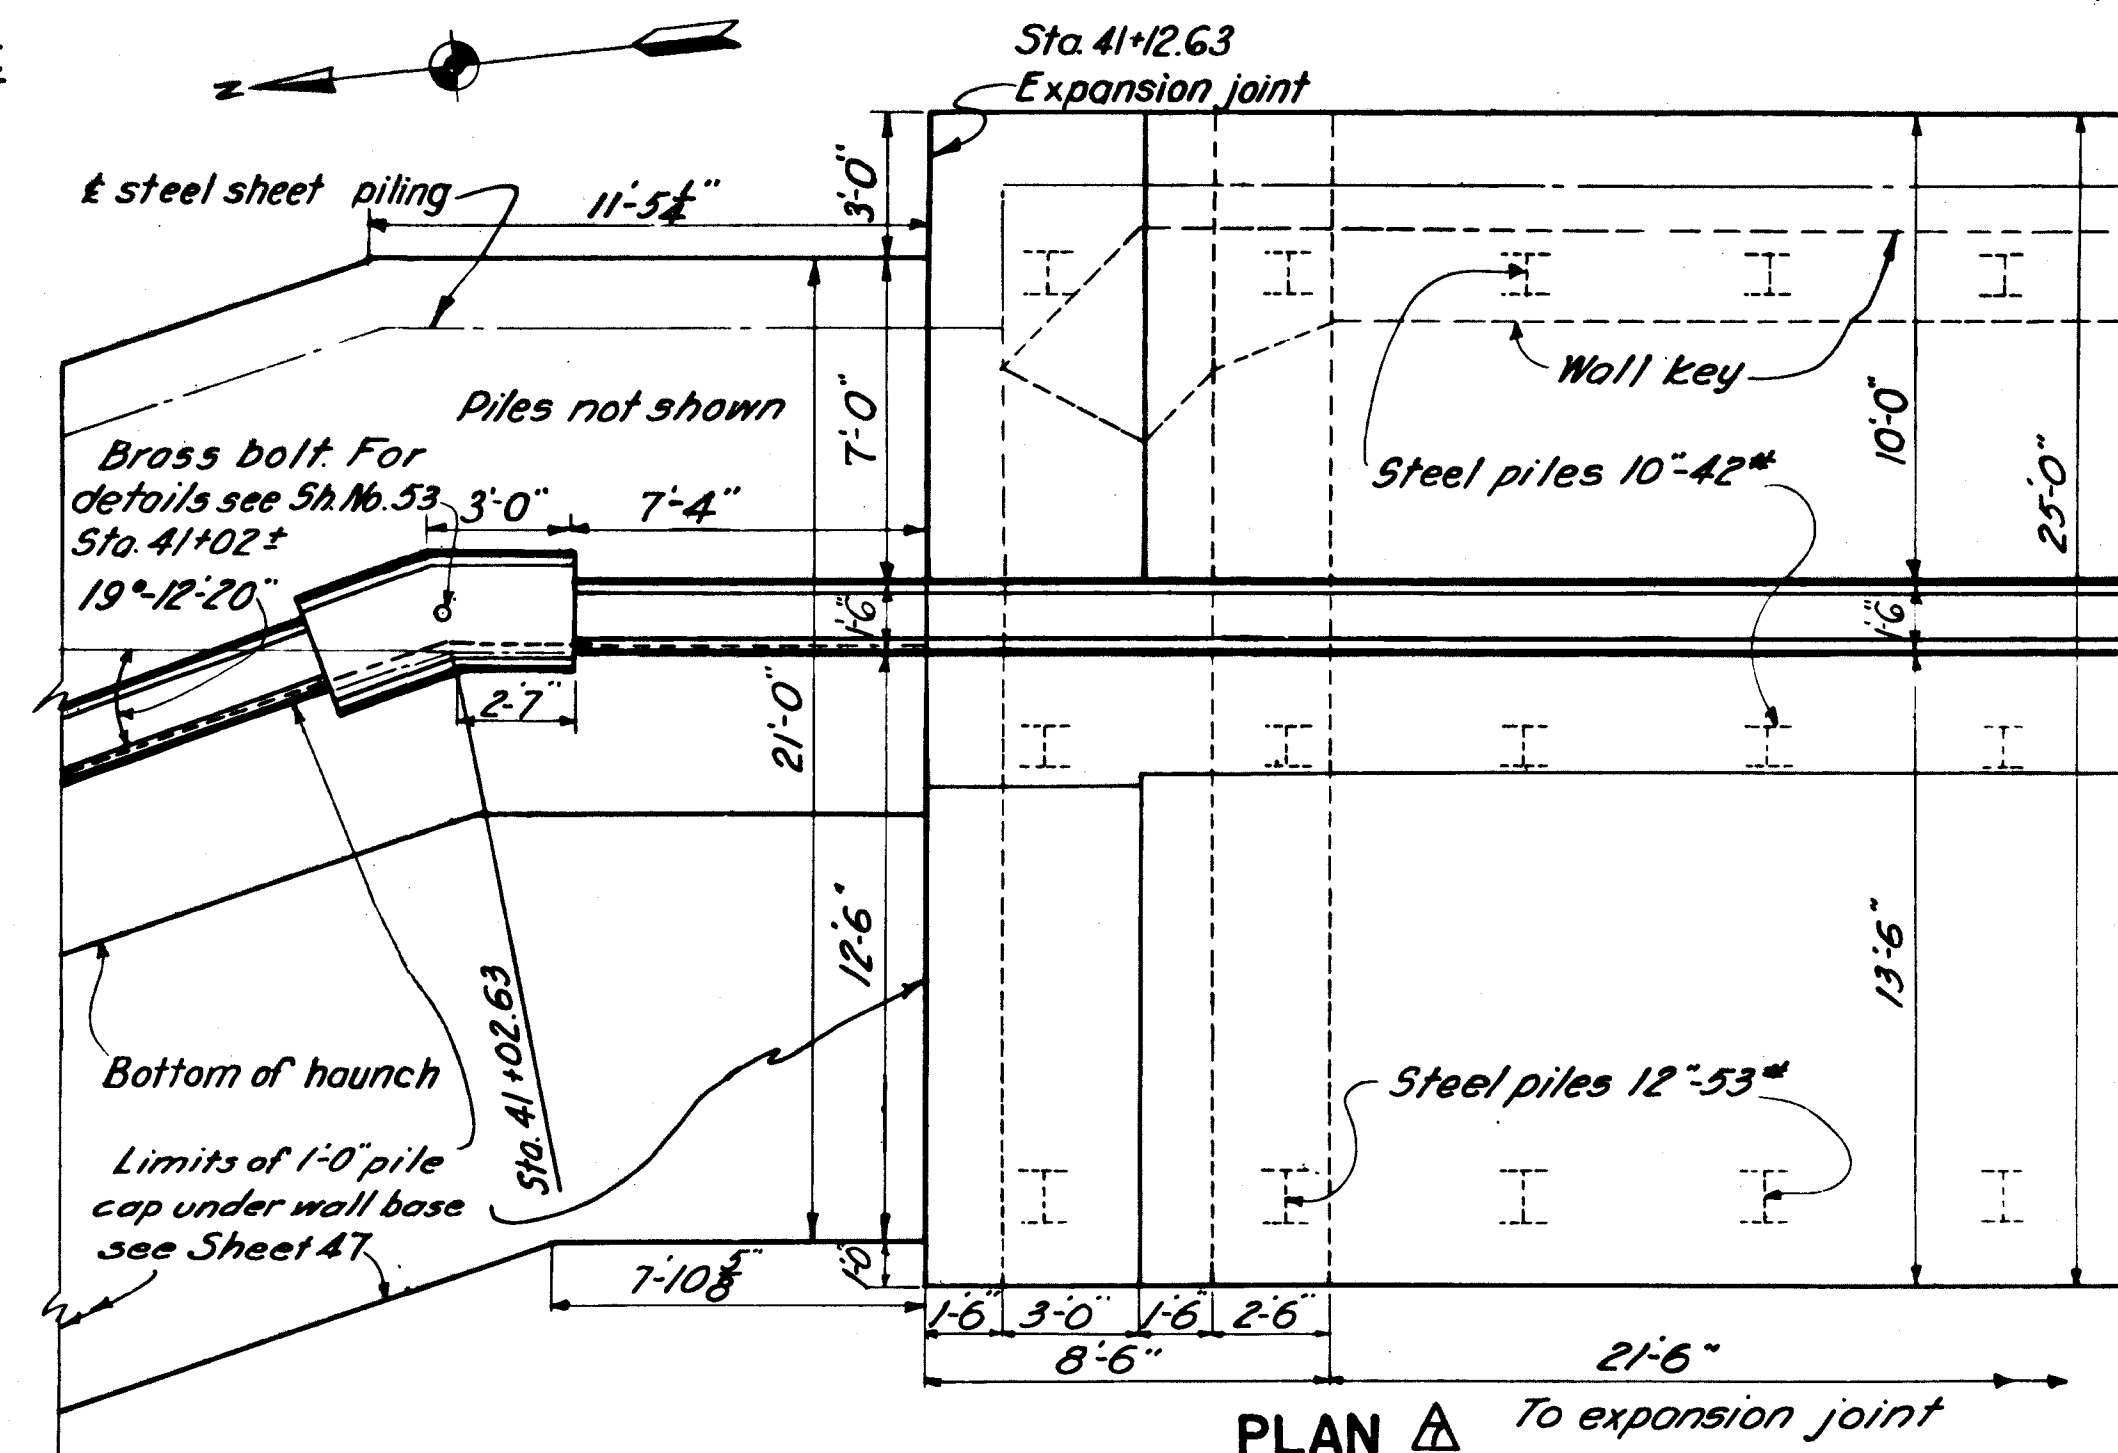


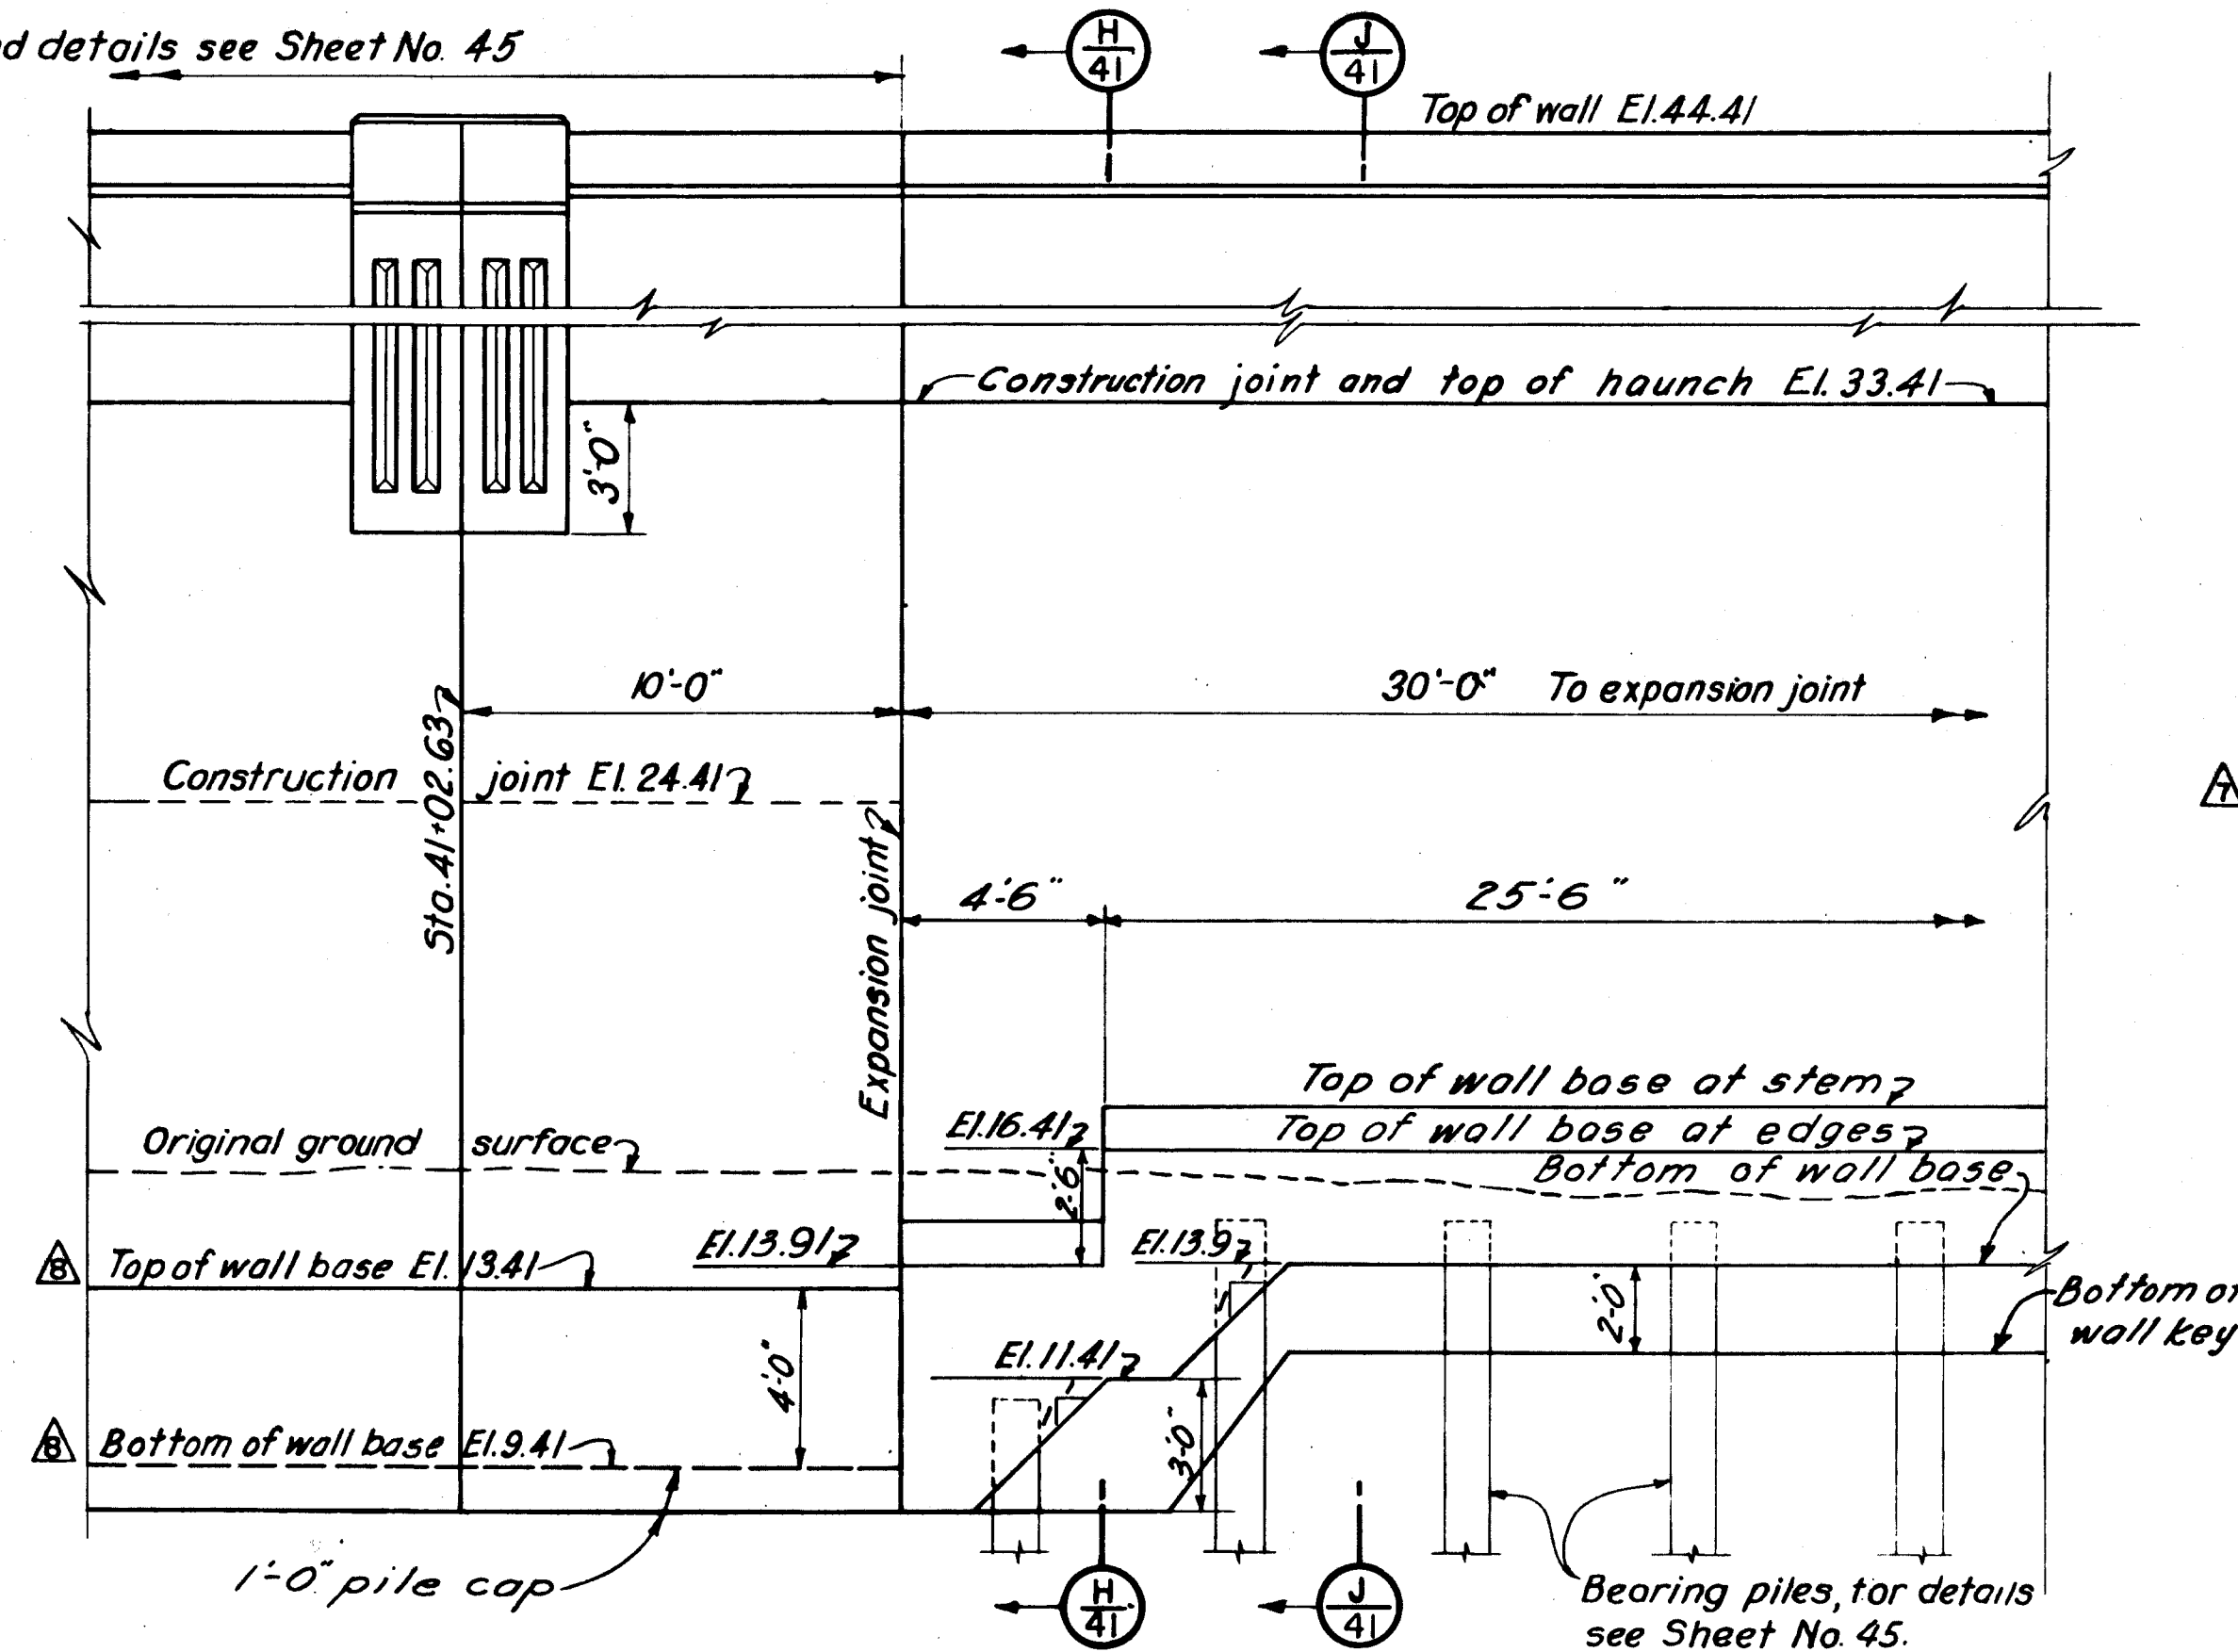

TYPICAL CORNER PILASTER

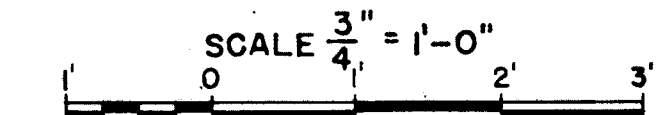

ELEVATION
DETAIL OF SOUTH CORNER A

NOTES

Elevations refer to Mean Sea Level Datum.
All exposed corners of concrete shall have 1" chamfer except as noted.
All concrete shown is class "A" and payment was made under item No. 24.
under Item No. 24.
For details of steel sheet piling see Sheet No. 80.
For details of steel reinforcement see Sheets No. 100, 105.
Construction joints from Sta 38+41.13 to Sta 44+90 located to be consistent with contractors approved drawings on similar sections.

12-31-45	As built revisions			
 6/5/41	Base of wall raised	W.D.A.	965	210
3/10/41	Wall revised	W.D.A.	1064	210
KEY	DATE	REVISION (INDICATED BY Δ)	REVIEW	CK BY
			ARBY	

CONNECTICUT RIVER FLOOD CONTROL

HARTFORD DIKE

RIVERFRONT, MORGAN ST. TO STA. 96+73

CORNER DETAILS NO. 1


STA. 38+47 AND STA. 41+02

CONNECTICUT RIVER CONNECTICUT

IN 135 SHEETS
SCALE: 1/4" = 1'-0"
SHEET NO 40



U.S. ENGINEER OFFICE, PROVIDENCE, R.I.
MAY 1940

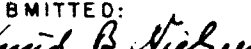SUBMITTED:  SENIOR ENGINEER MAIN DESIGN SECTION	APPROVAL RECOMMENDED  PRINCIPAL ENGINEER CHIEF OF ENGINEERING DIV.	APPROVED  LT COL. CORPS OF ENGINEERS DISTRICT ENGINEER
---	--	--

DESIGNED:

 ASST. CHIEF ENGINEER

DRAWN: K.H.W. DWC
 TRACED: P.A.B.
 CHECKED: W.D.A.

FISCAL YEAR 940
 FILE NO. CT - 4-2500