



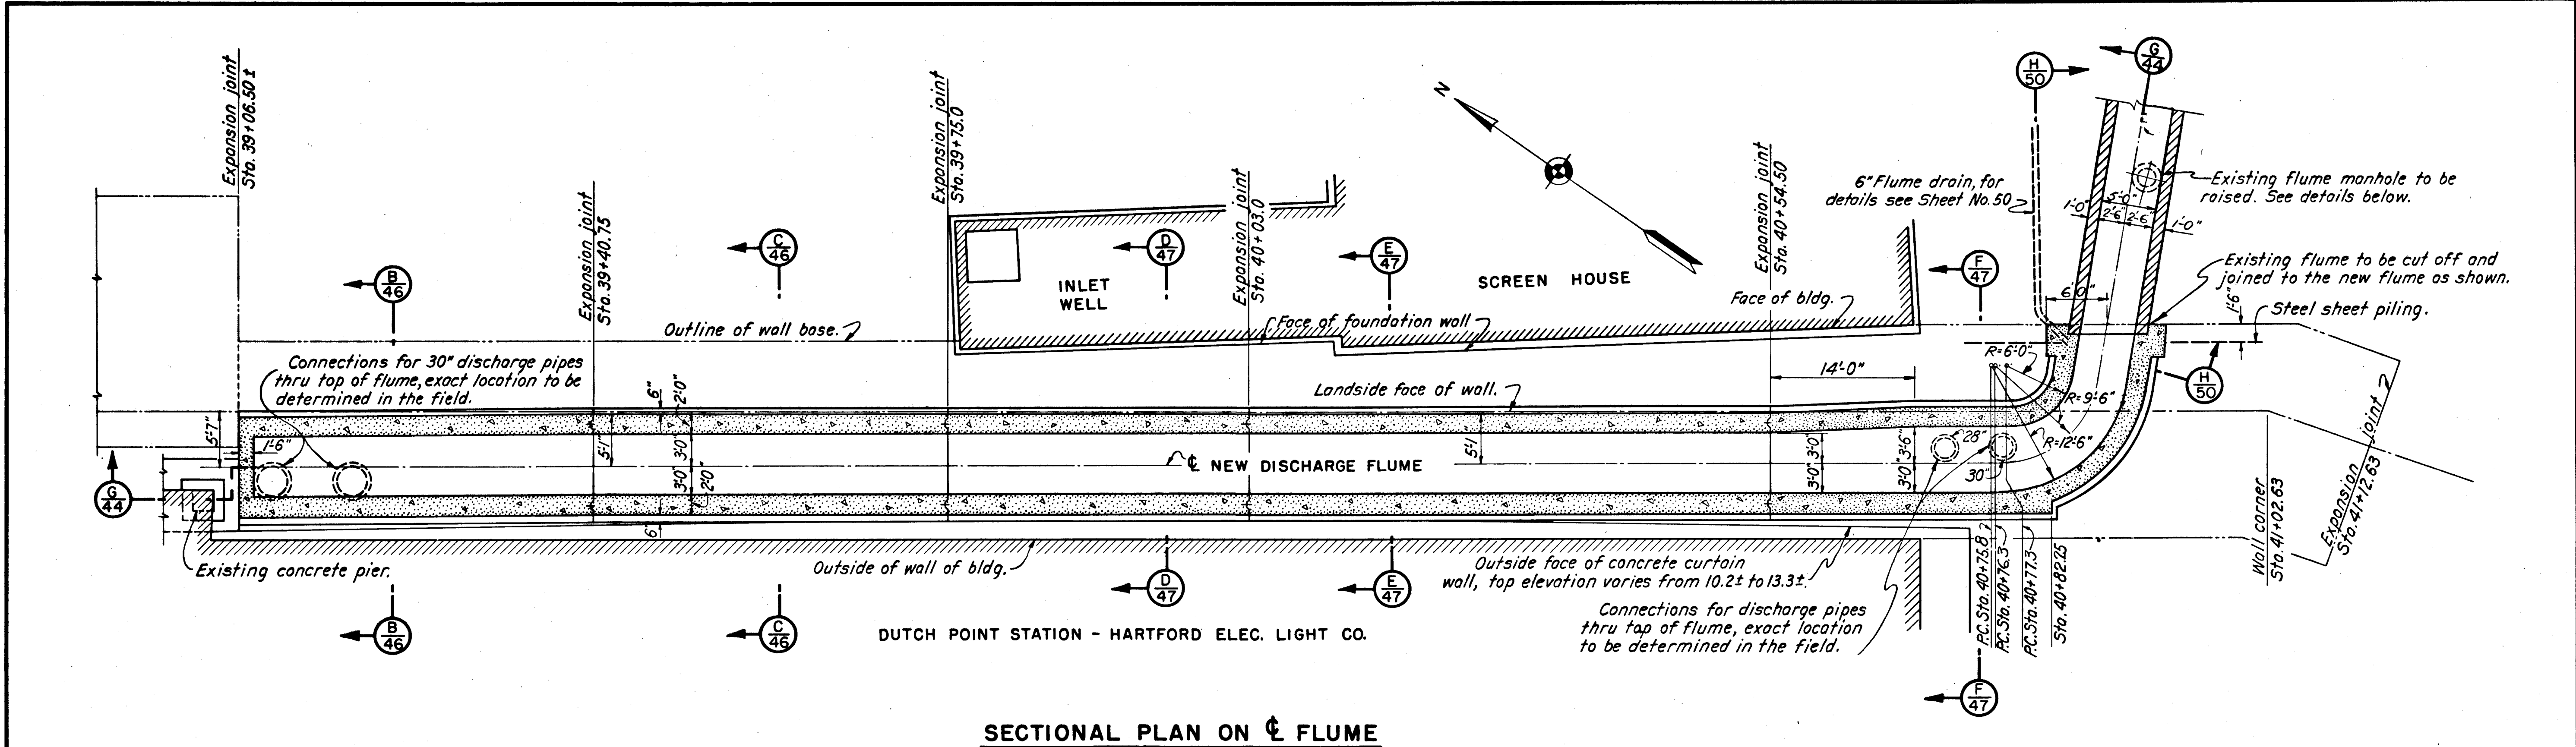

SECTIONAL PLAN ON FLUME

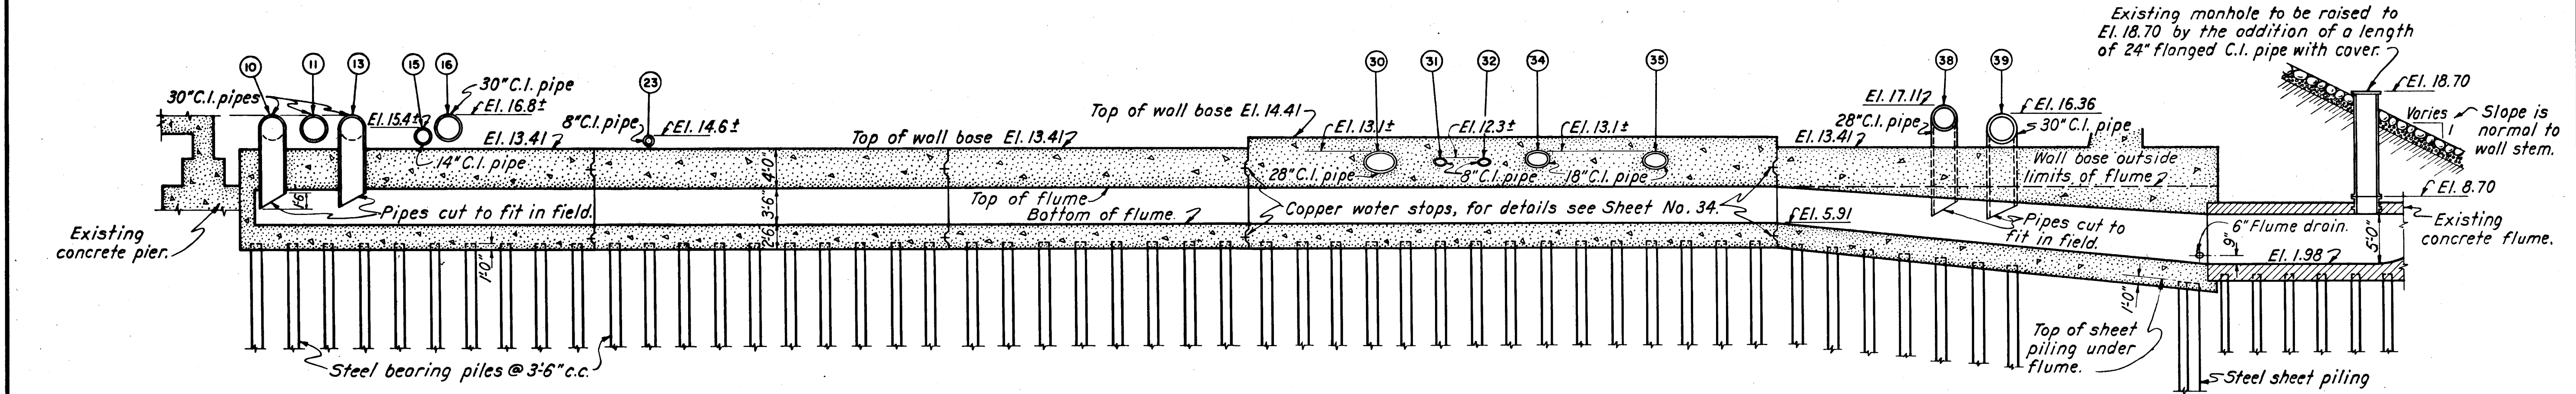

SECTION 6/44 DEVELOPED

NOTES

Elevations refer to Mean Sea Level.
For plan of steel bearing piles, see Sheet No. 45.
For plan of steel sheet piling, see Sheet No. 80.

THIS SHEET SUPERSEDES SHEET NO. 44, FILE NO. CT-4-2504

CONNECTICUT RIVER FLOOD CONTROL
HARTFORD DIKE
RIVERFRONT, MORGAN ST. TO STA. 96+73
PLAN OF CONCRETE FLUME
DUTCH POINT STATION

CONNECTICUT RIVER CONNECTICUT
1135 SHEETS SCALE: 1/8 IN. = 1 FT. SHEET NO. 44

U.S. ENGINEER OFFICE, PROVIDENCE, R.I., JUNE 1941

SUBMITTED: J.C. Dugganwall ENGINEER
APPROVED: J.C. Dugganwall PRINCIPAL ENGINEER
HEAD, DESIGN SECTION CHIEF, ENGINEERING DIV. LT. COL. CORPS OF ENGINEERS DISTRICT ENGINEER

DESIGNED: J.D. Chase ASSIST. ENGINEER
DRAWN: T.C.H. TRACED: M.B. Mc. CHECKED: JWC
FISCAL YEAR 1940
FILE NO. CT-4-2965

KEY	DATE	REVISION (Indicated by Δ)	REV. BY	CK. BY	AP. BY
	12-31-45	As built revisions			