
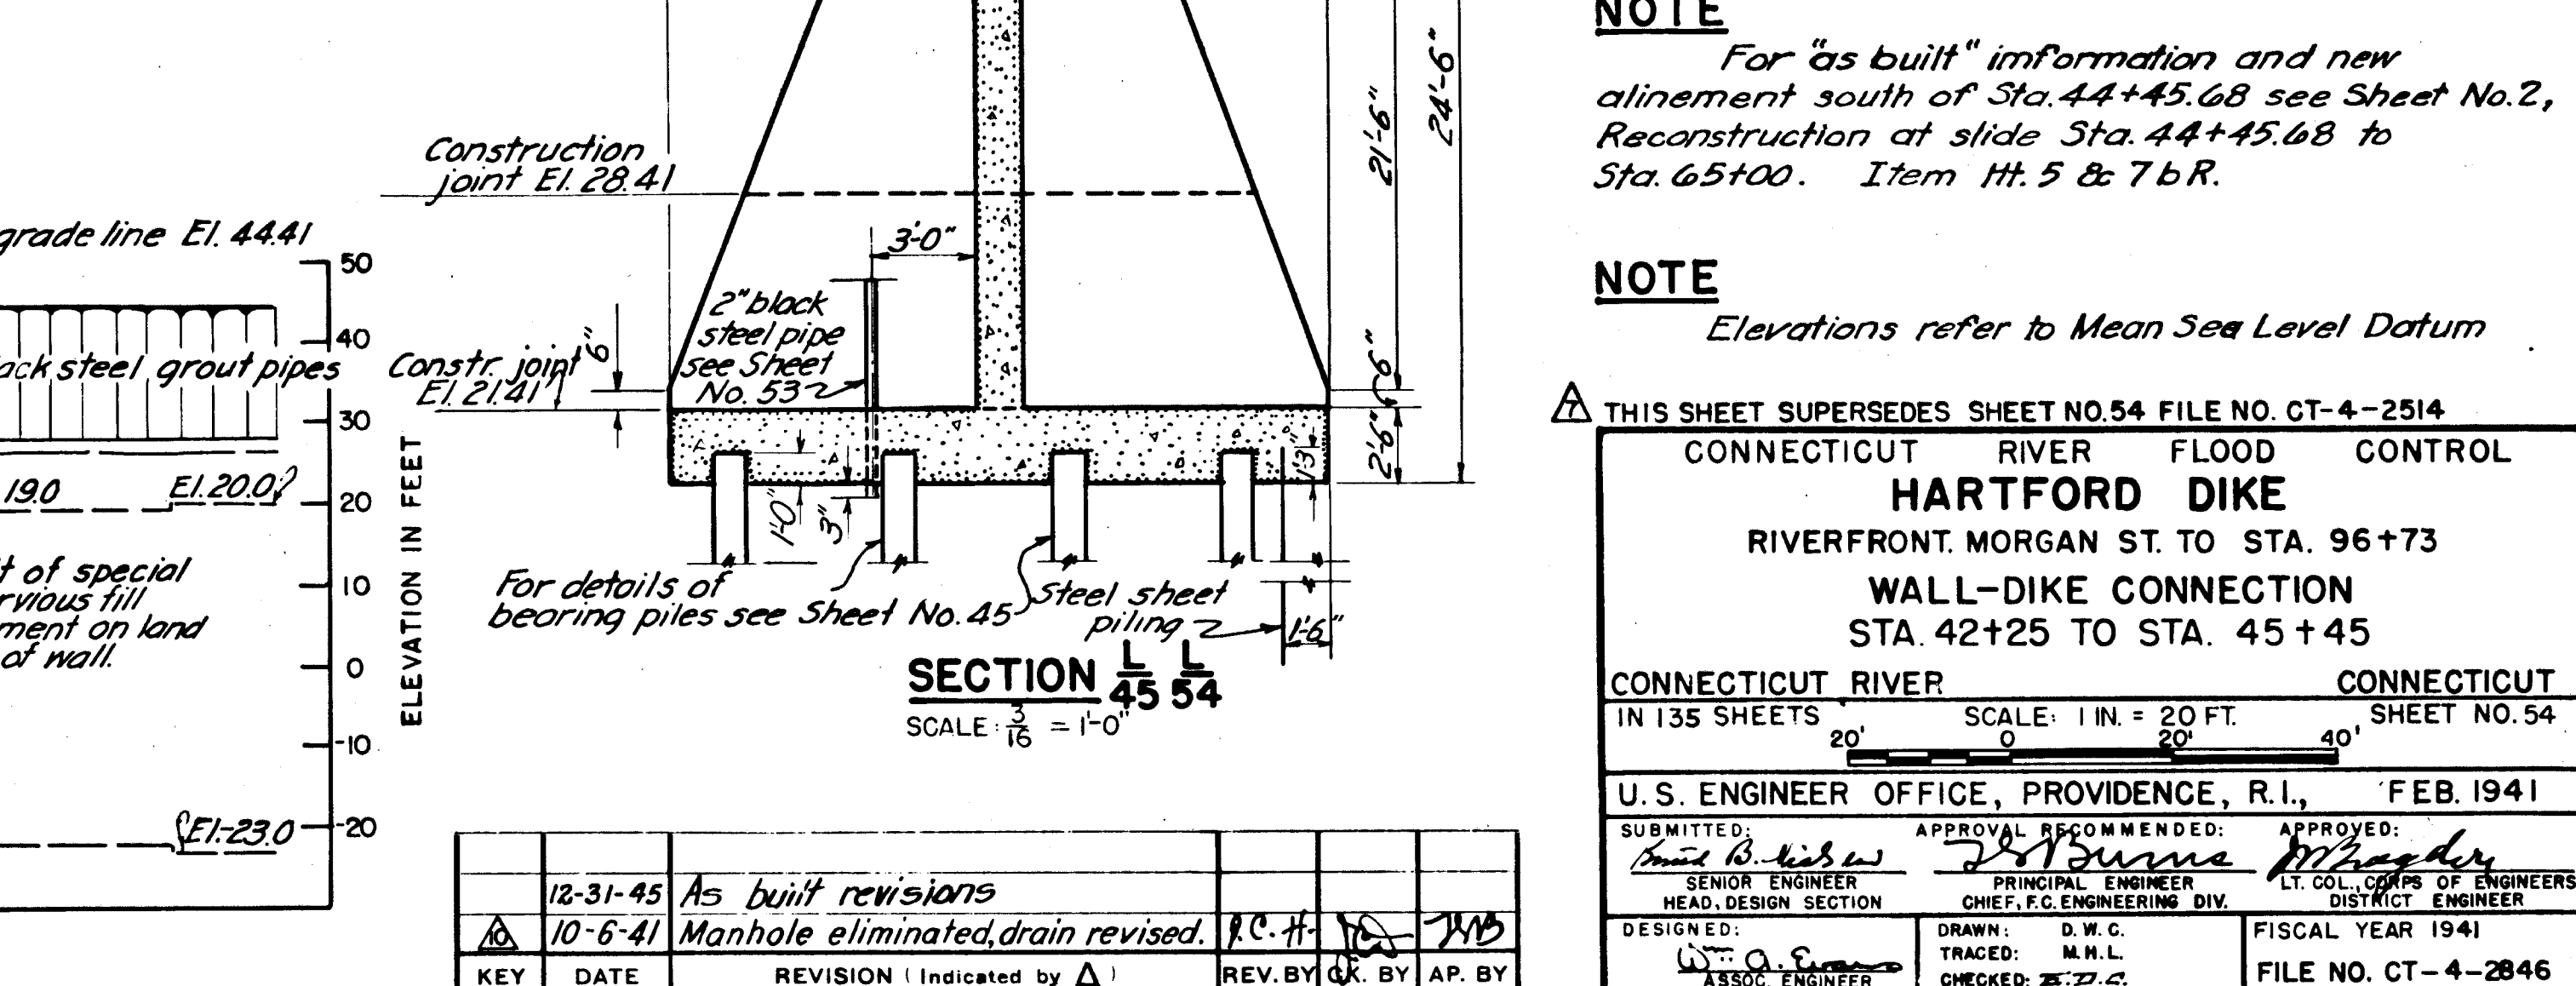
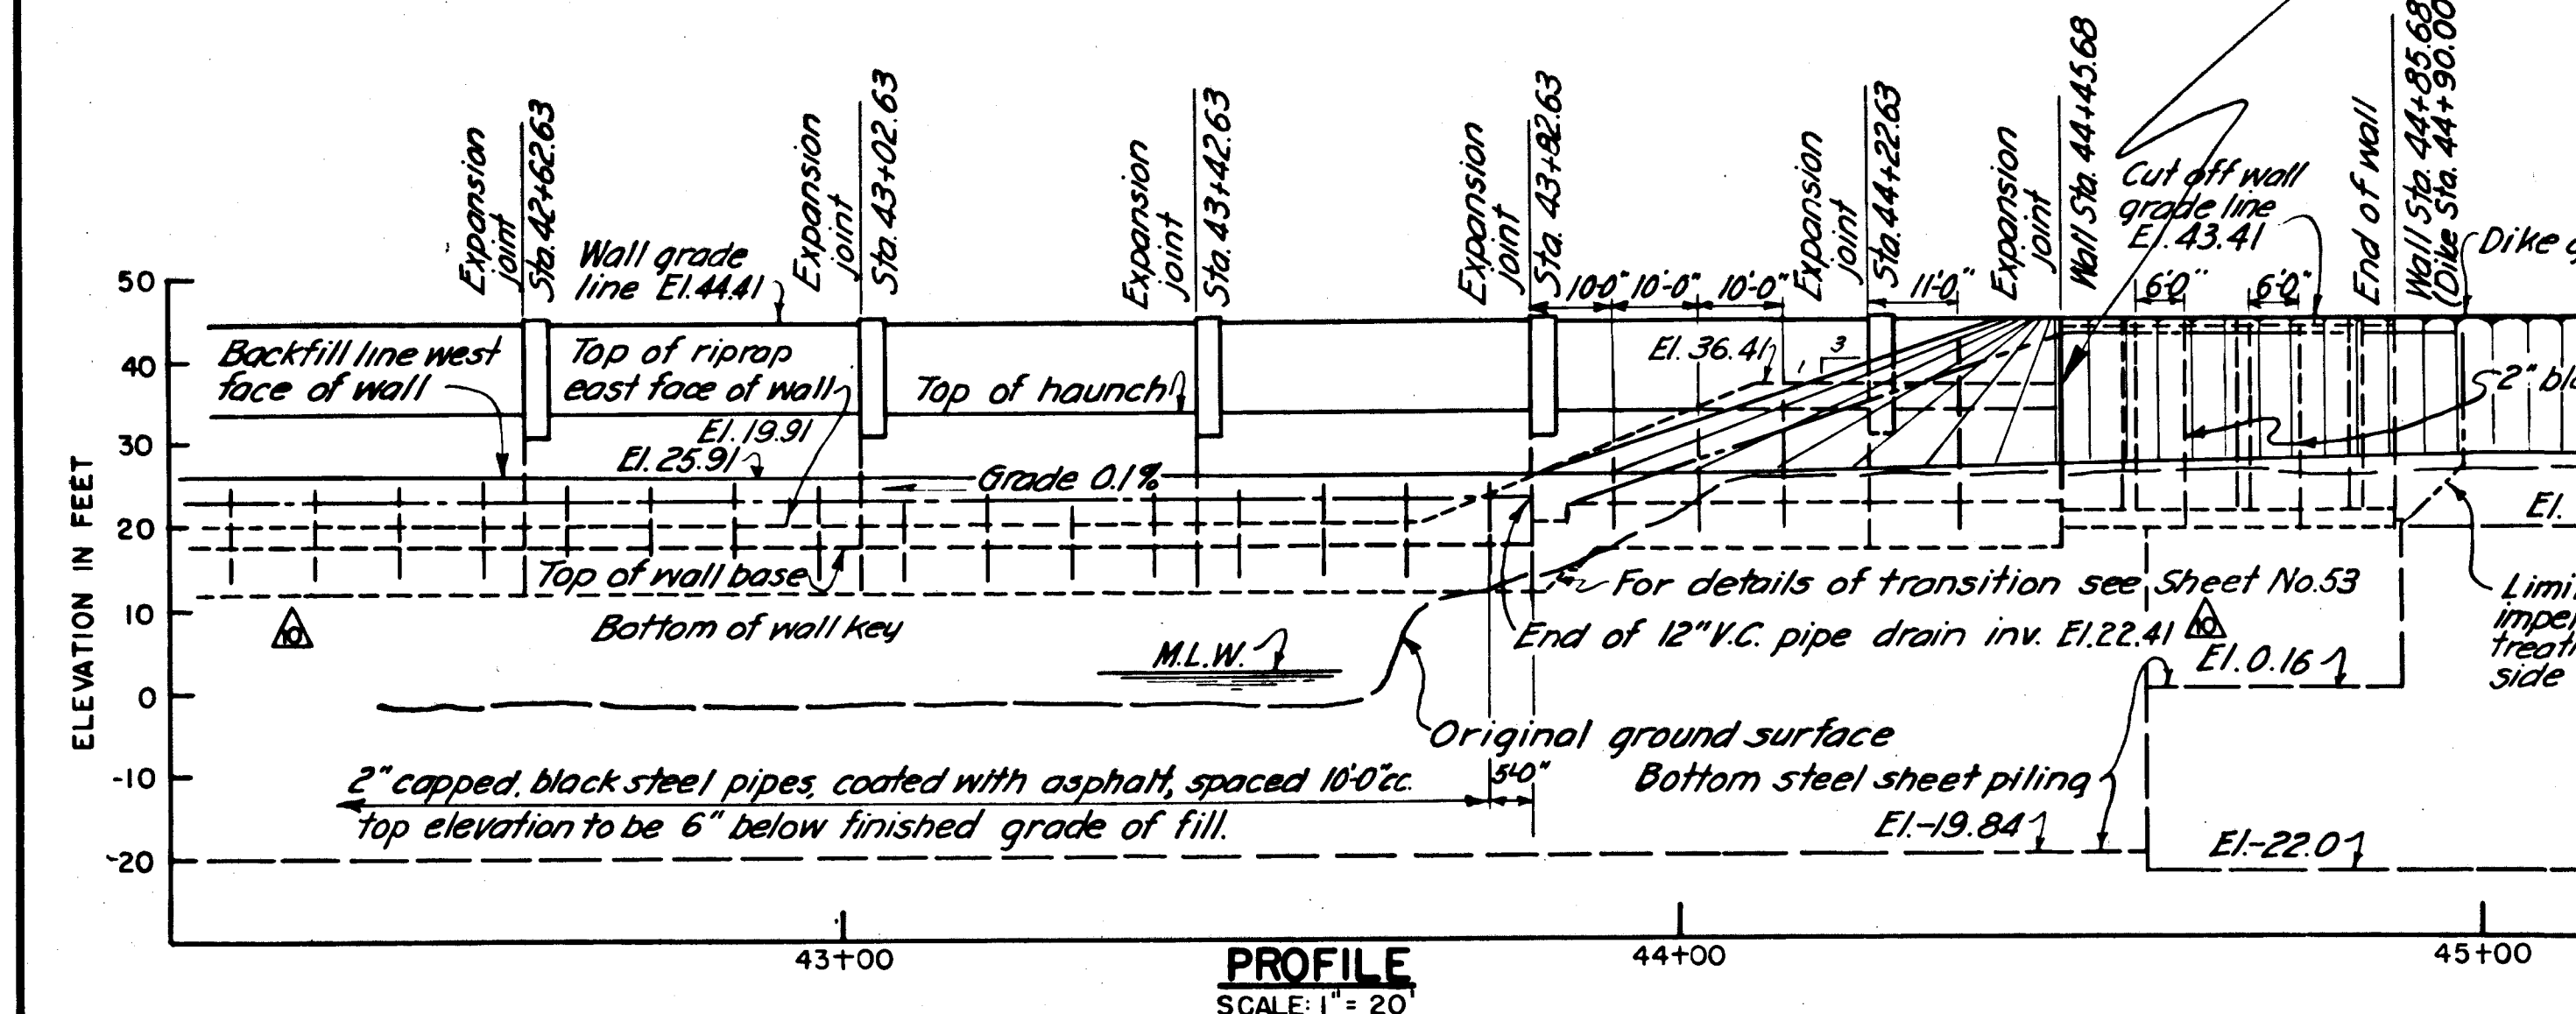
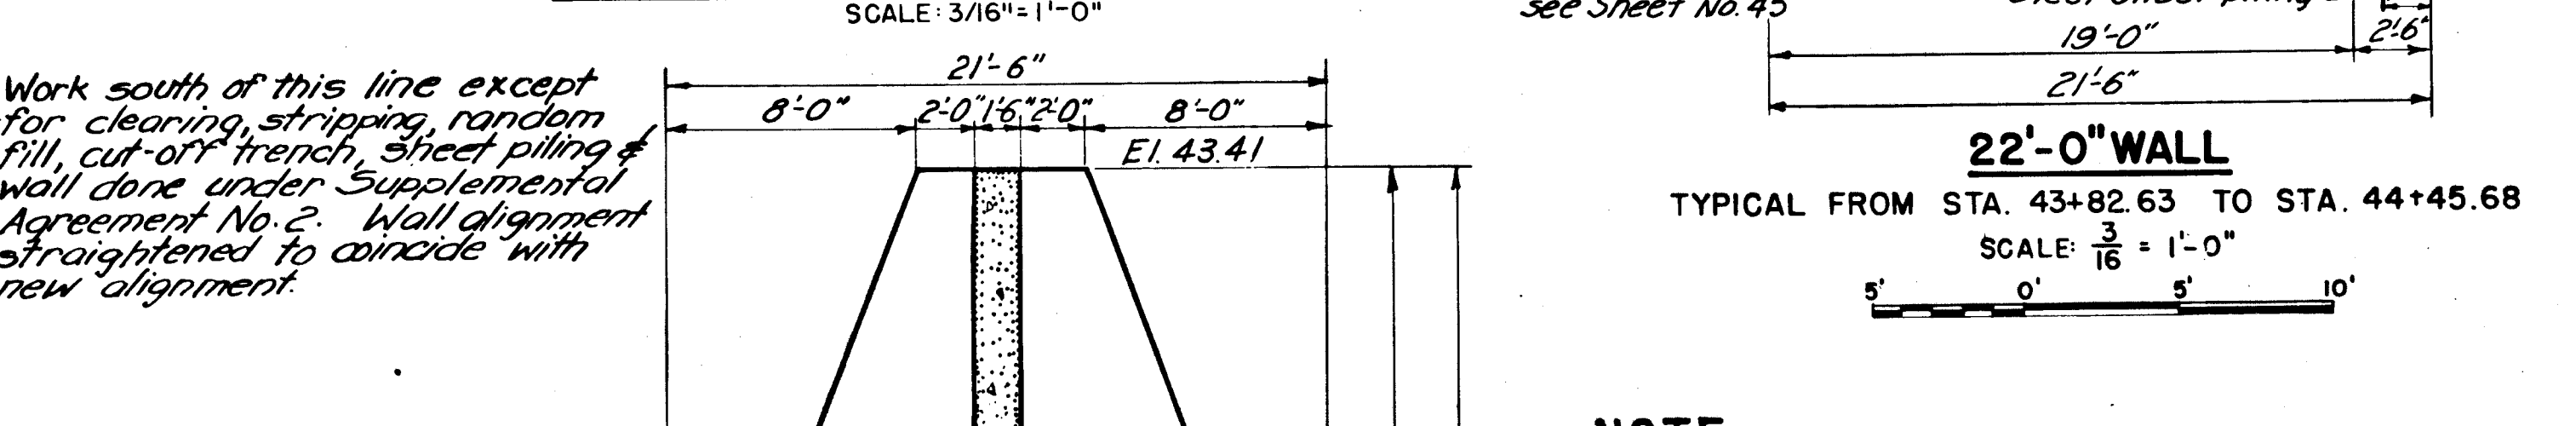
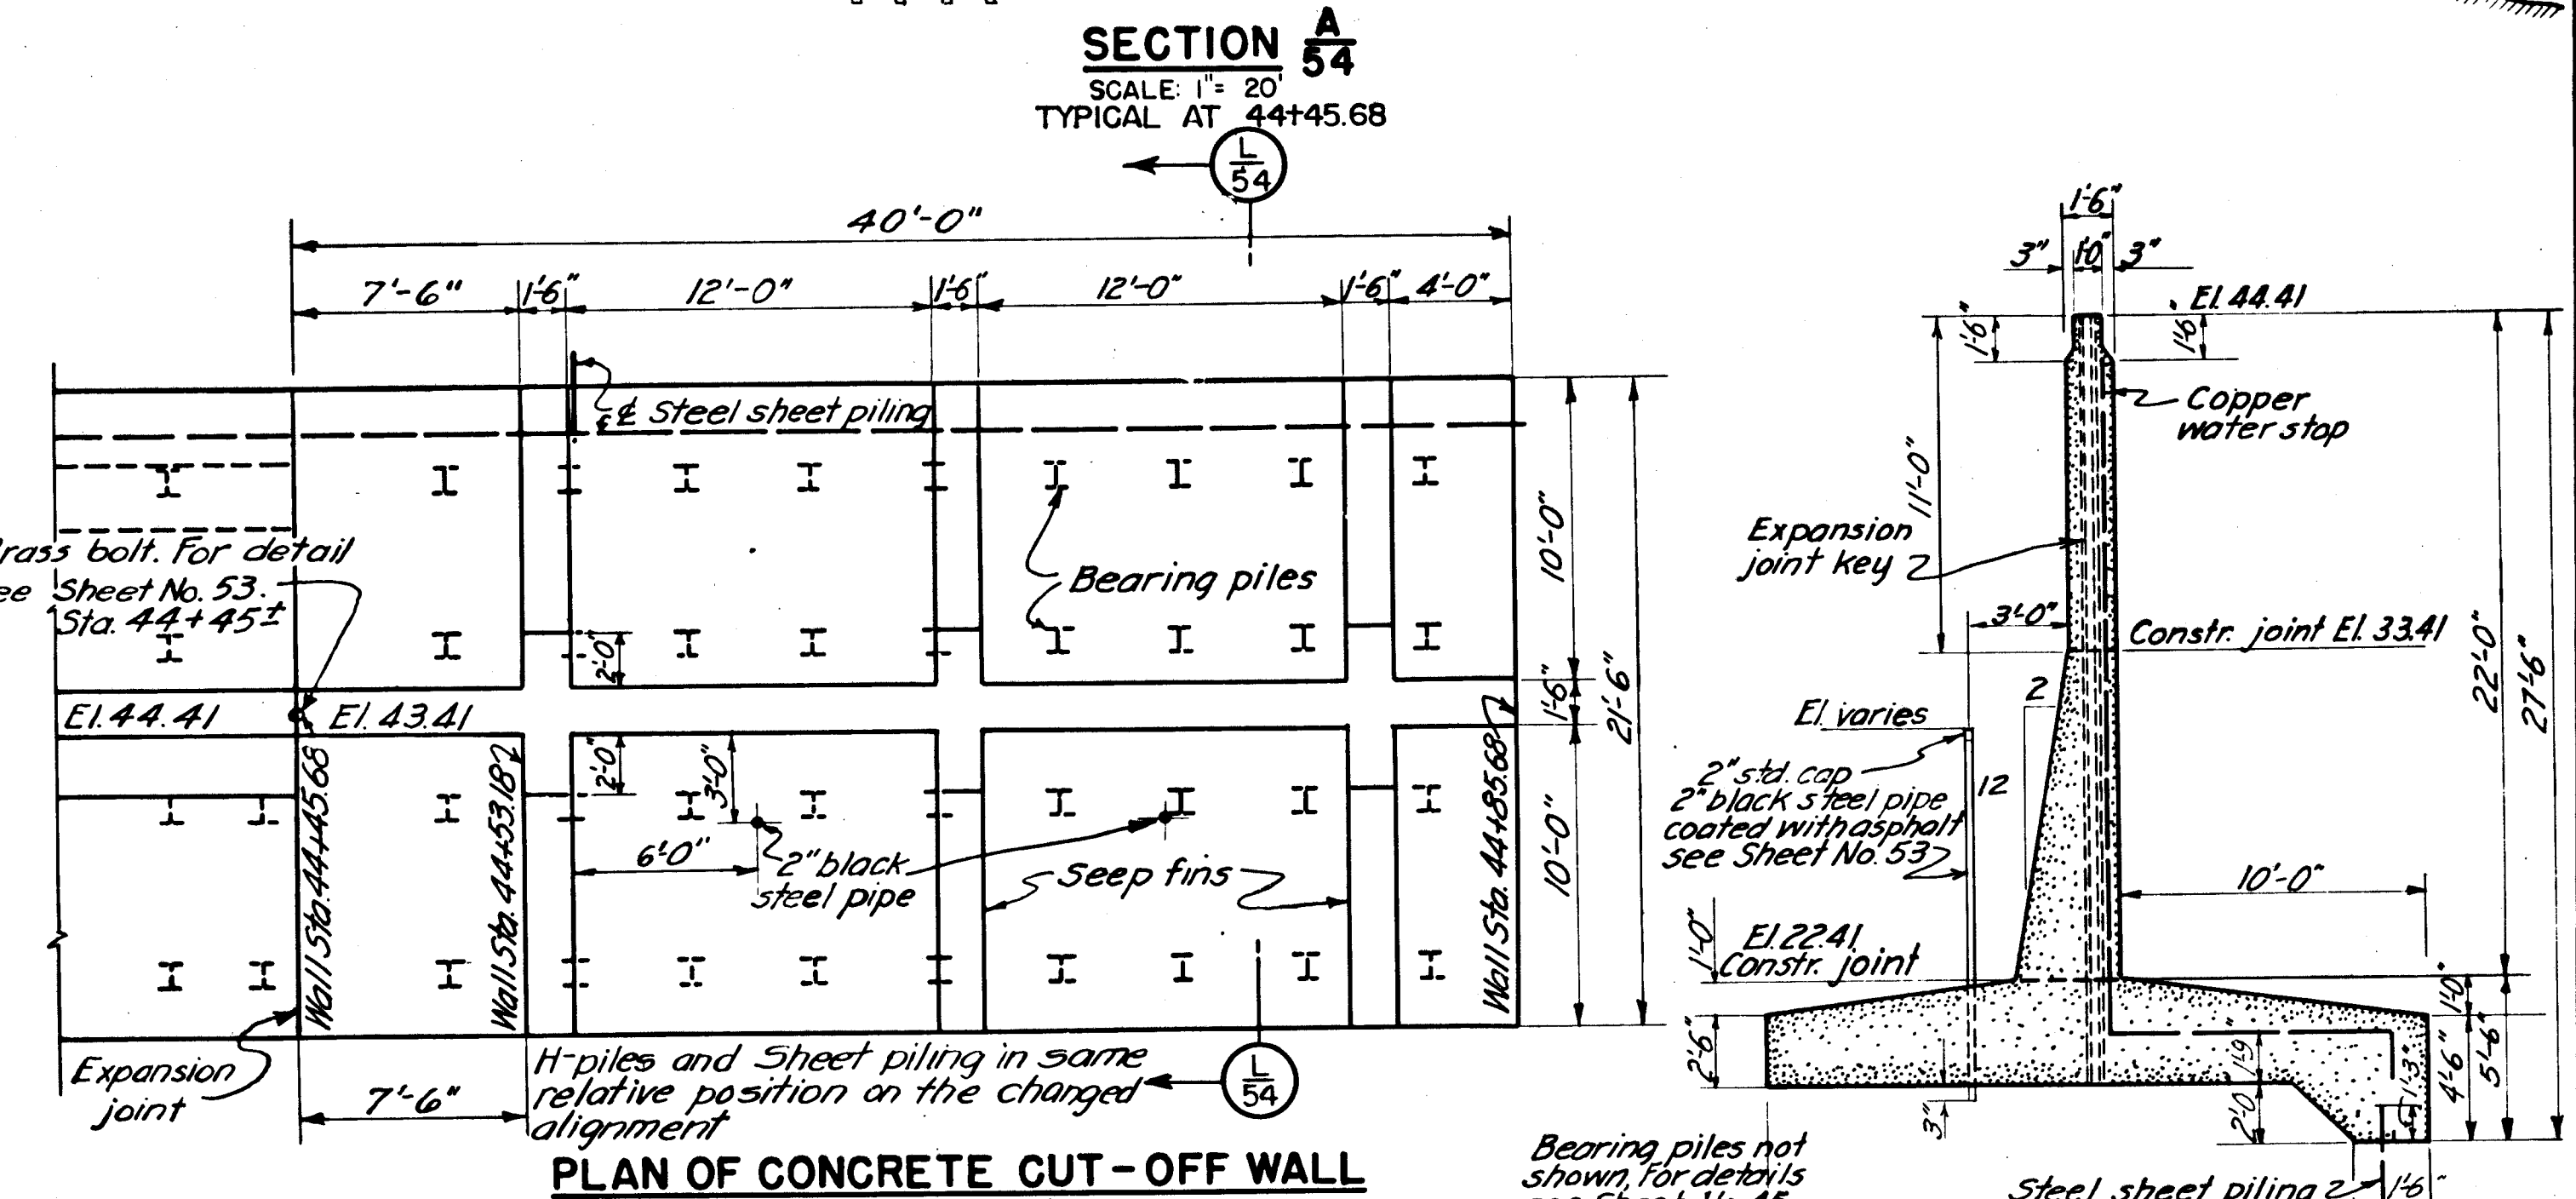
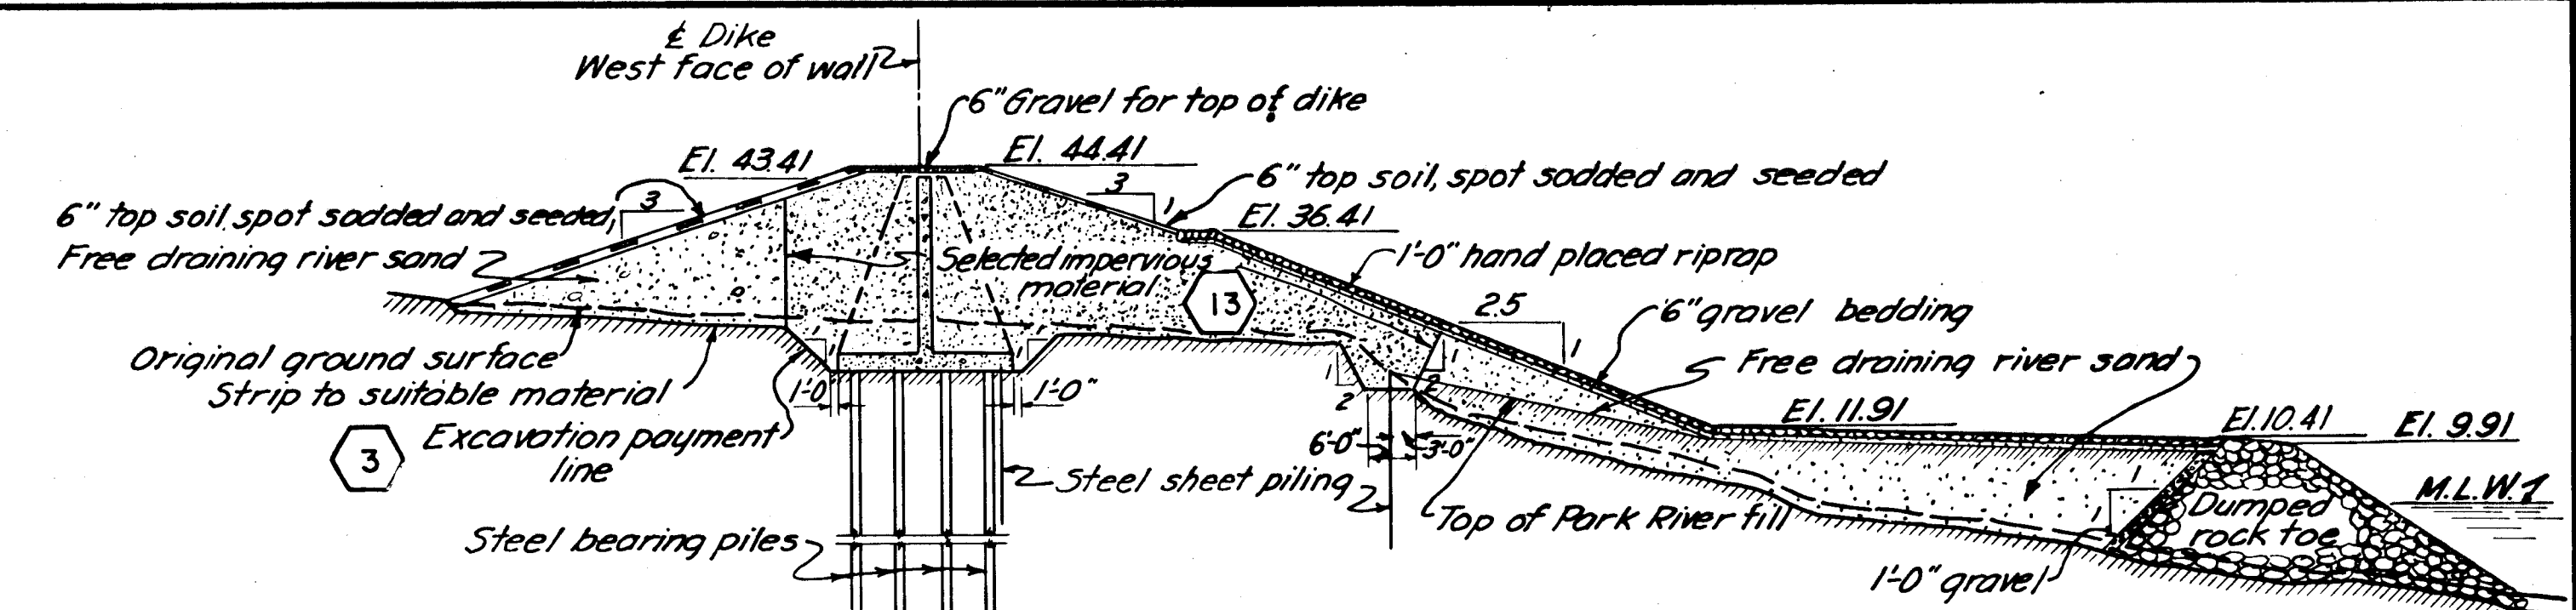


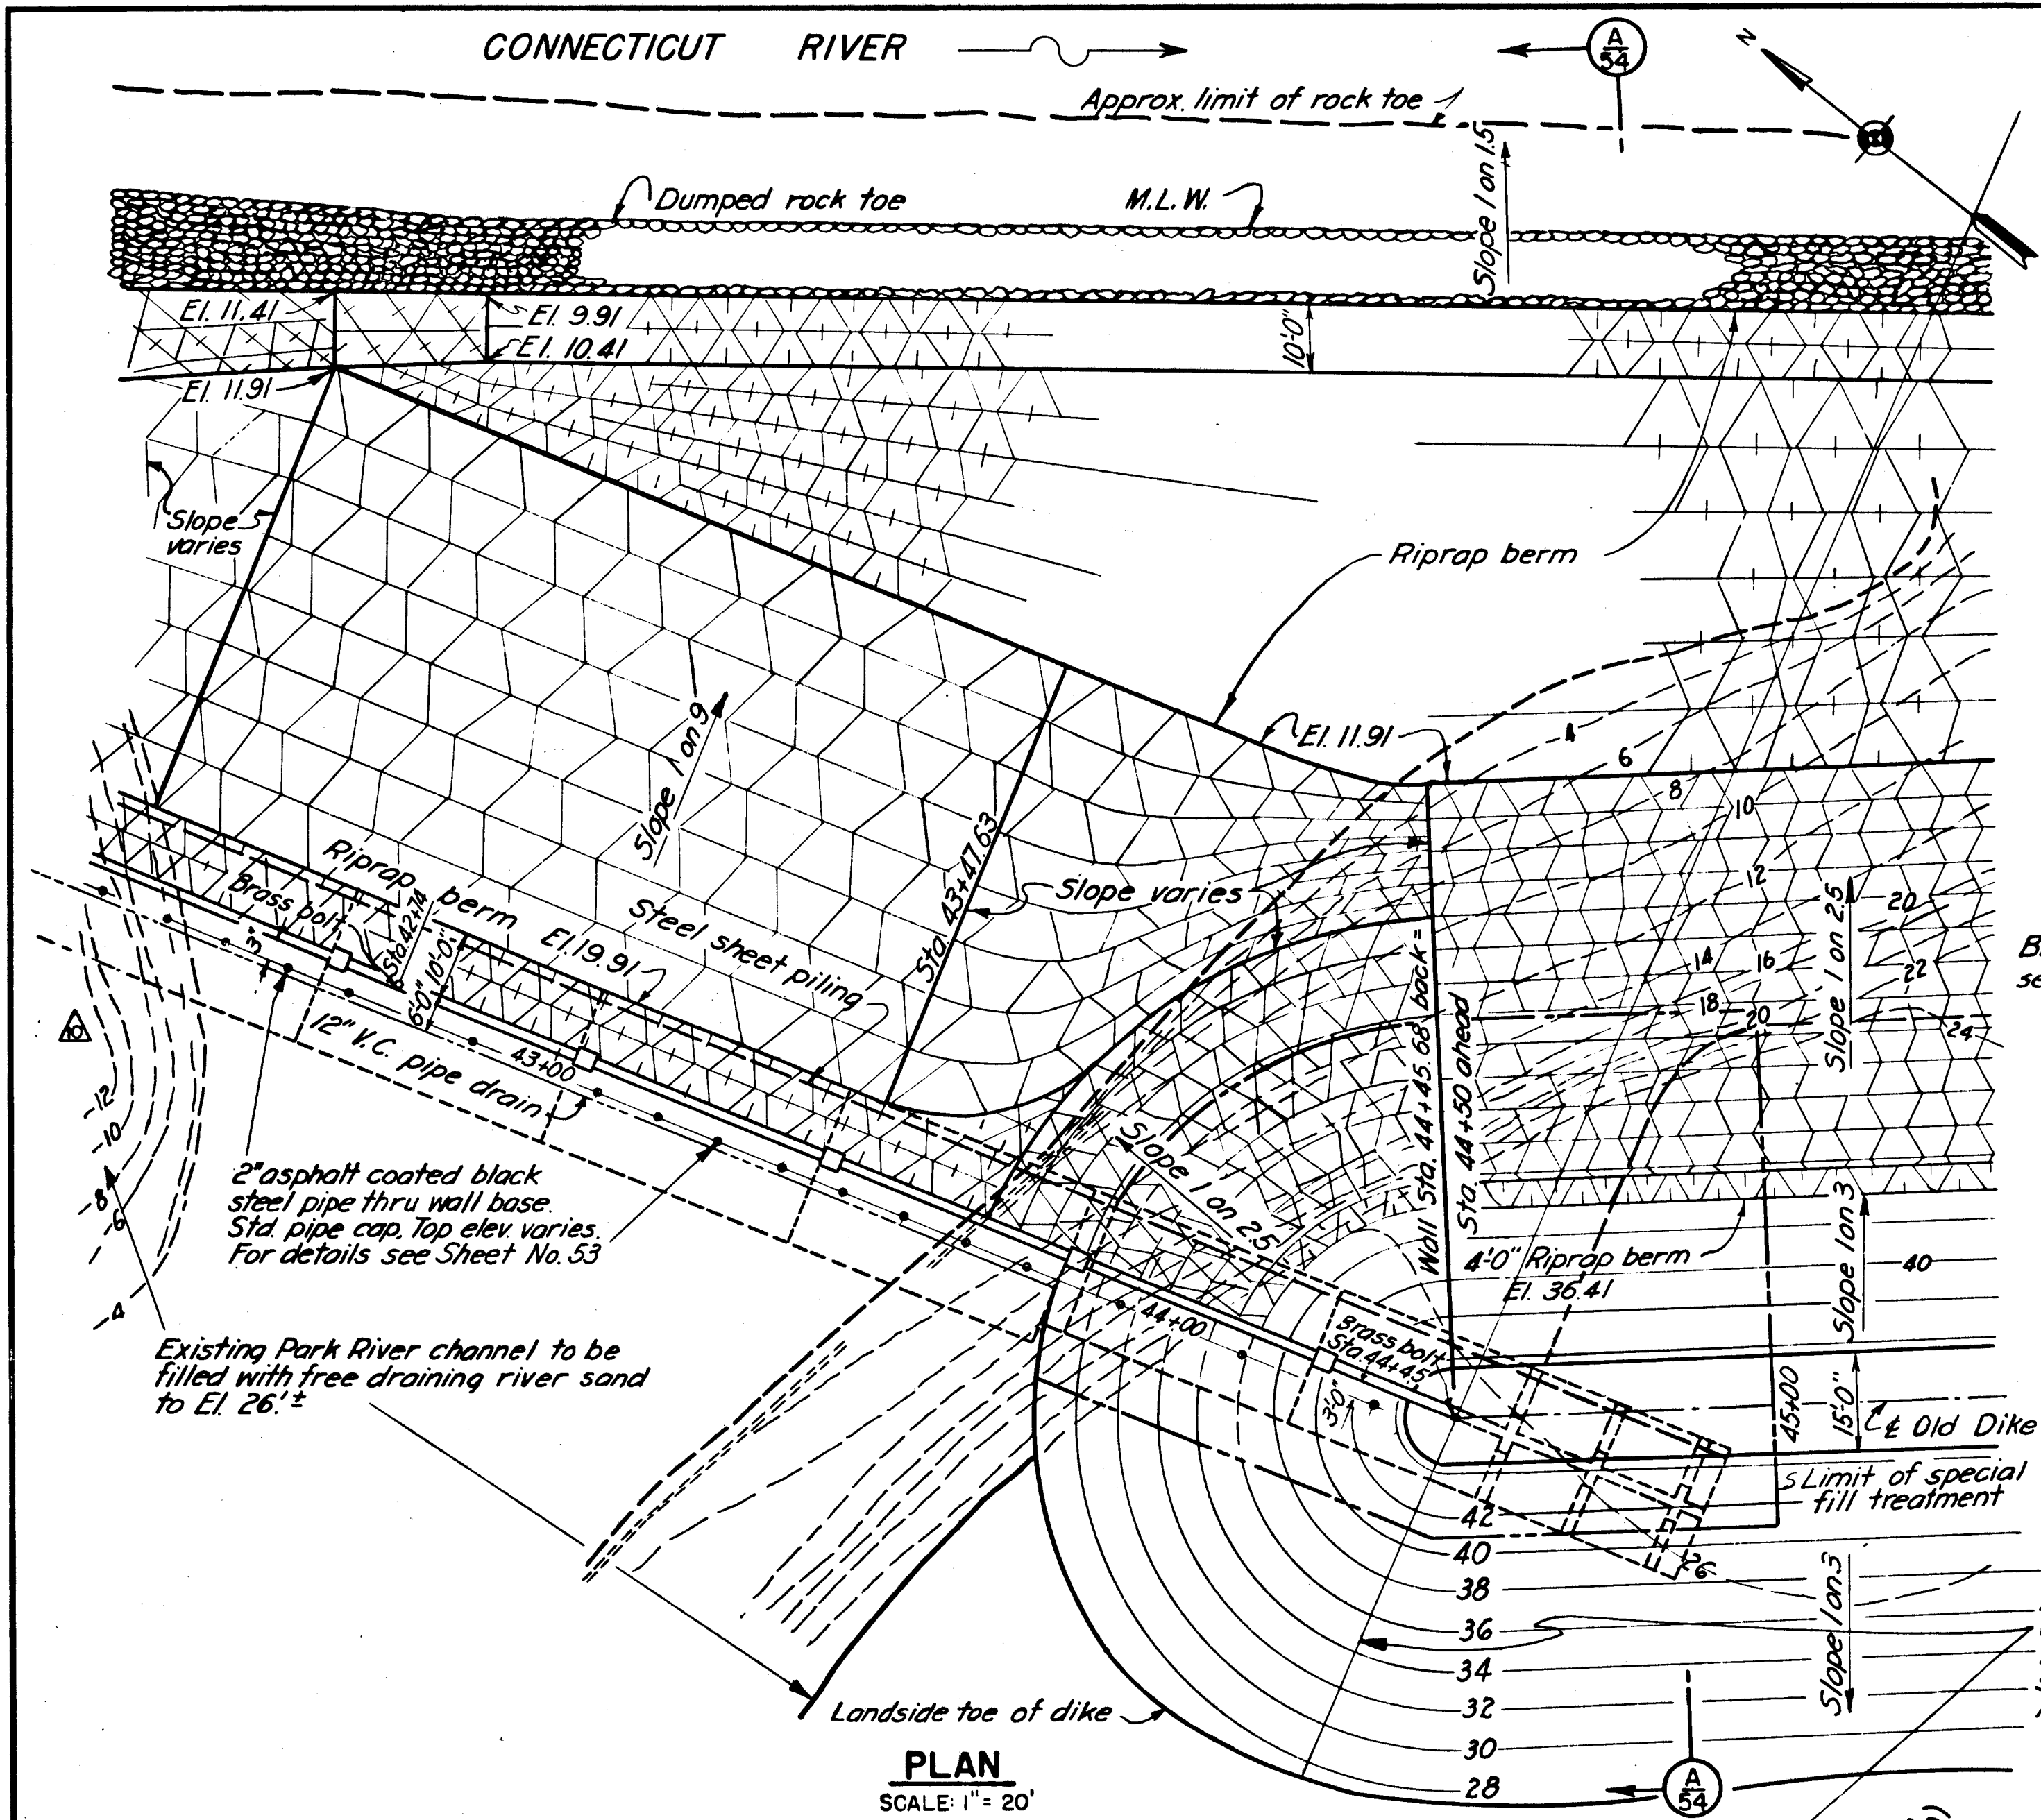

KEY	DATE	REVISION (Indicated by Δ)	REV. BY	AP. BY
Δ	12-31-45	As built revisions		
Δ	10-6-41	Manhole eliminated, drain revised.	R.C.H.	M.B.

THIS SHEET SUPERSEDES SHEET NO. 54 FILE NO. CT-4-2514

CONNECTICUT RIVER FLOOD CONTROL

HARTFORD DIKE

RIVERFRONT MORGAN ST. TO STA. 96+73

WALL-DIKE CONNECTION

STA. 42+25 TO STA. 45+45

CONNECTICUT RIVER CONNECTICUT

IN 135 SHEETS SCALE: 1 IN. = 20 FT. SHEET NO. 54

U.S. ENGINEER OFFICE, PROVIDENCE, R.I., FEB. 1941

SUBMITTED: *B. B. B.* APPROVAL: *B. B. B.* RECOMMENDED: *B. B. B.*

DESIGNED: *B. B. B.* DRAWN: *D. W. C.* FISCAL YEAR 1941

HEAD, DESIGN SECTION CHIEF, P.C. ENGINEERING DIV. LT. COL. CORPS OF ENGINEERS

ASSOC. ENGINEER CHECKED: *M. H. L.* FILE NO. CT-4-2846

H15 87b

54