
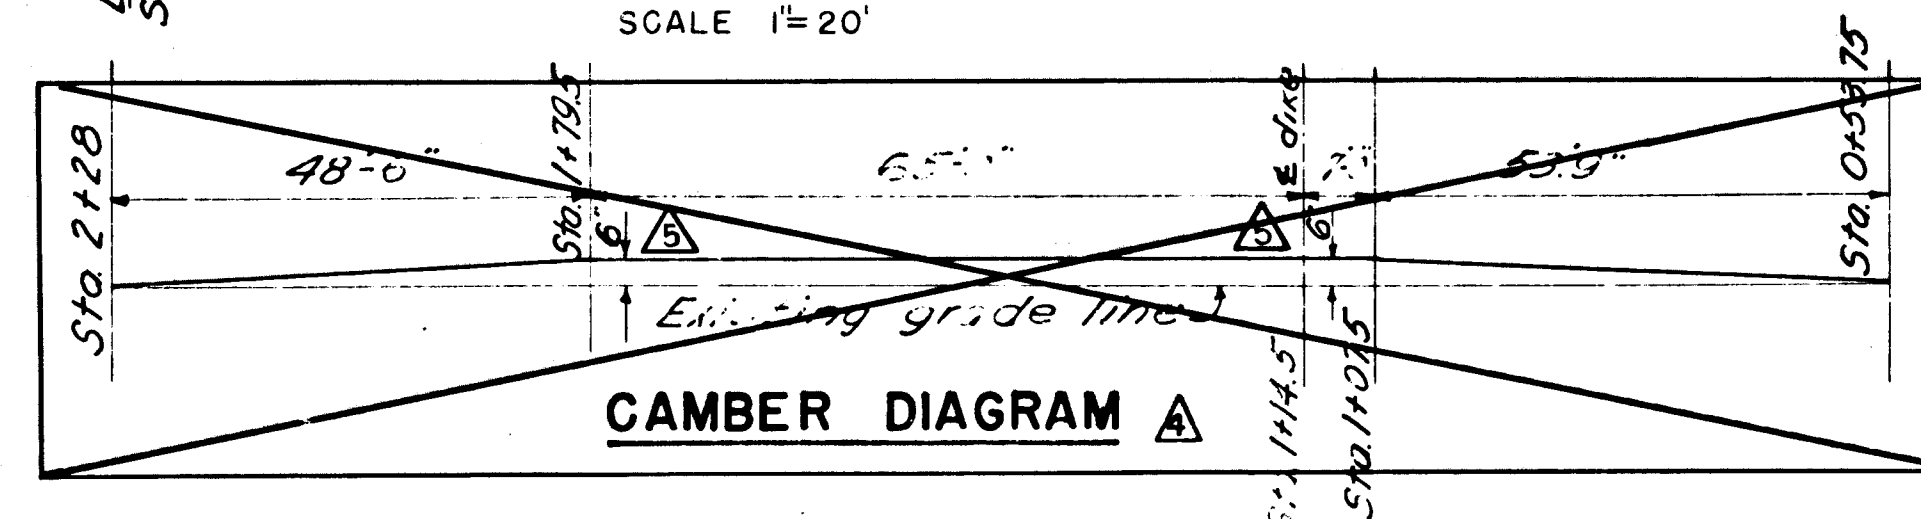
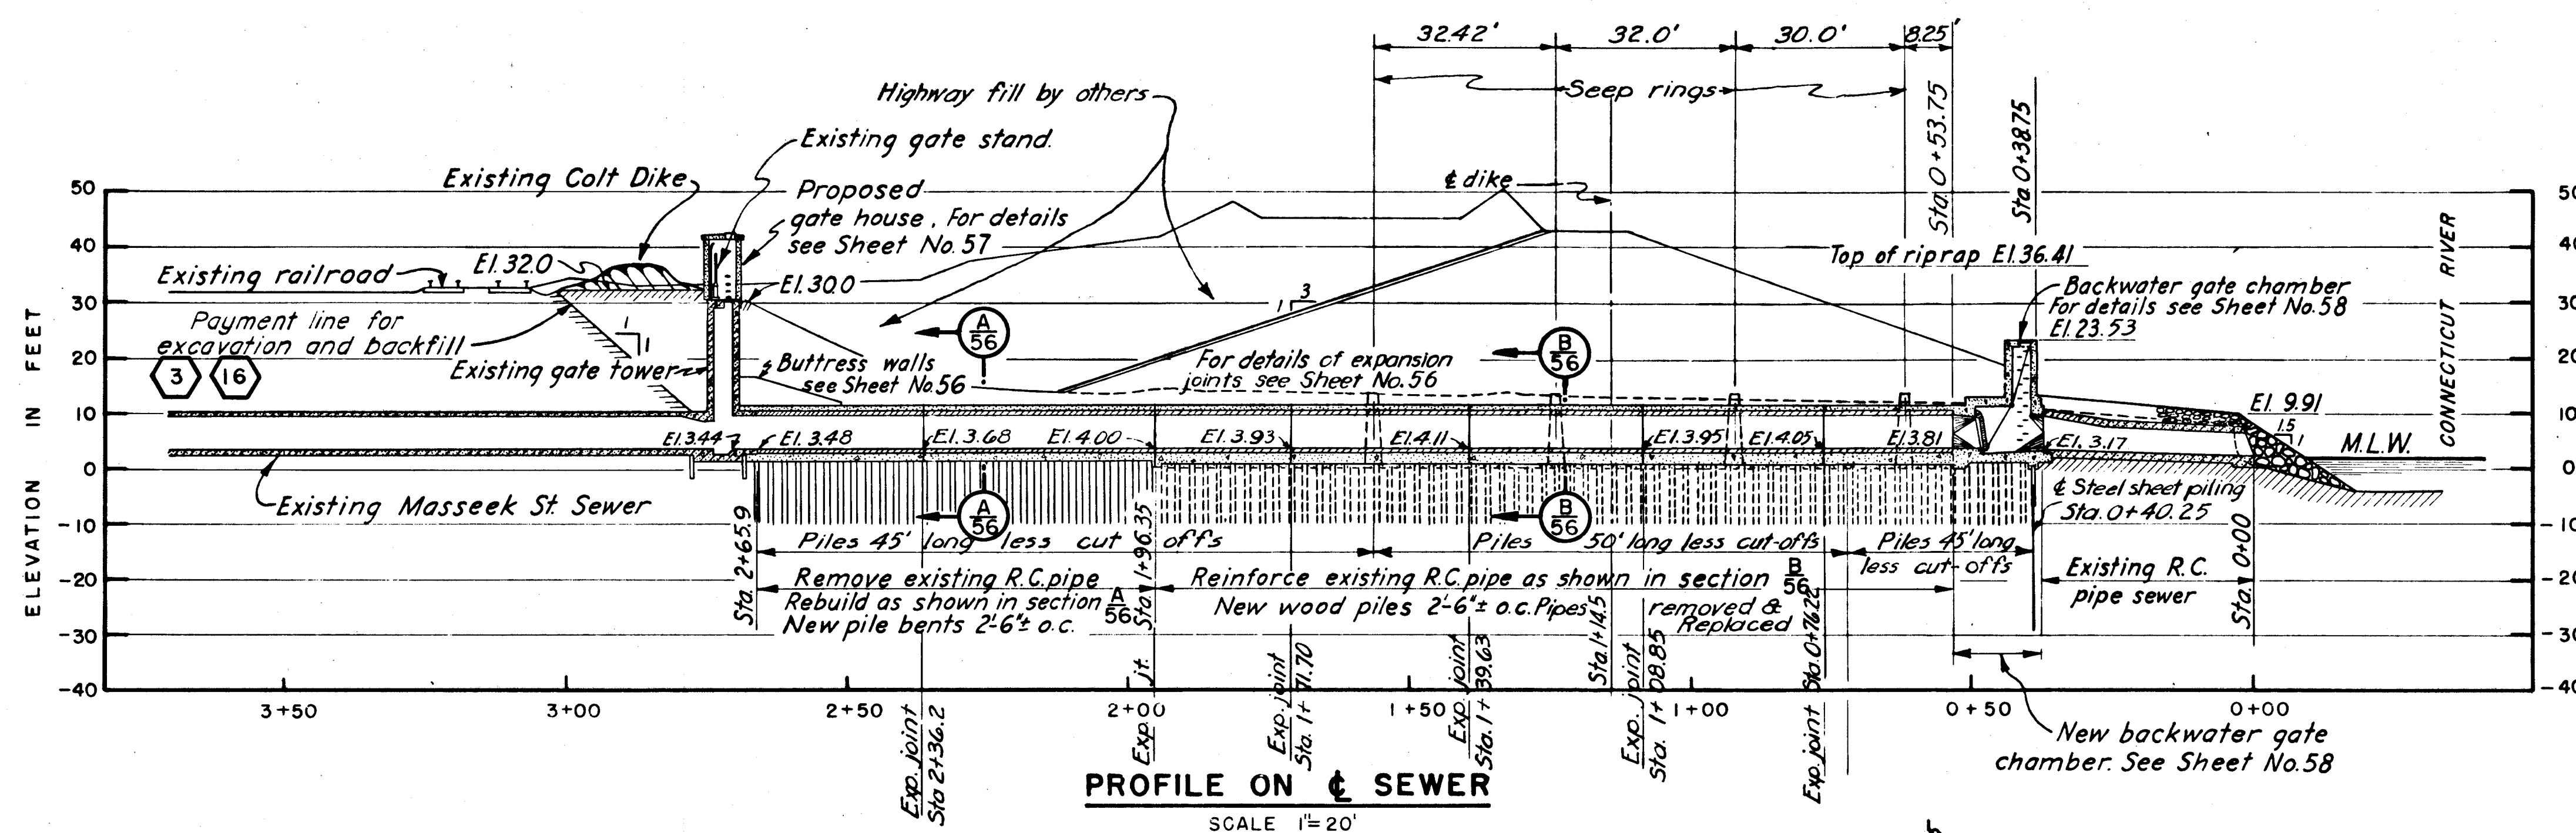


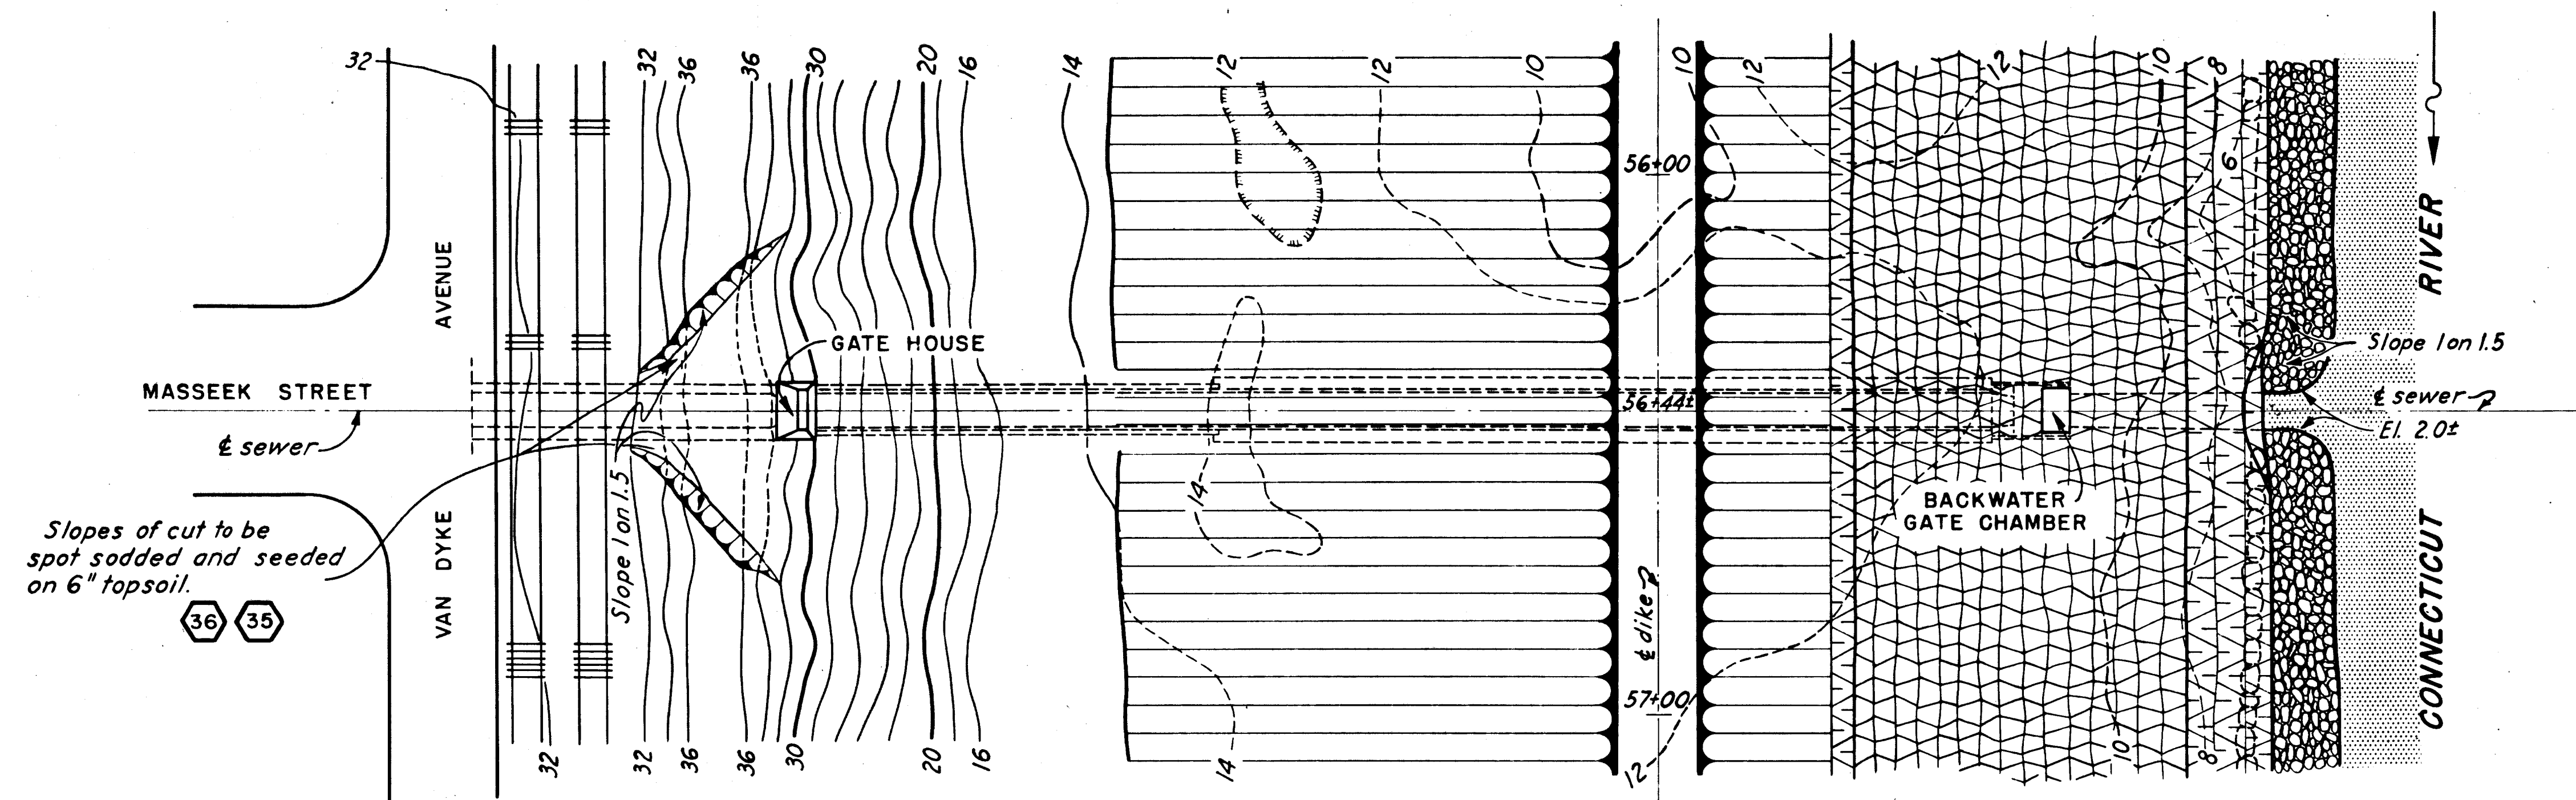

Due to slide on 24 July 1941, information shown on this sheet is not applicable. For "As built" information in this area see Sheets 1 thru 6 inclusive. Reconstruction of Masseek Street sewer item Ht. 5 & 7b R.

Slide of July 24, 1941 completely destroyed sewer riverside of Sta. 1+96.35. See Sheet No. 2 of Supplemental Agreement No. 1 Drawings.

NOTES

Elevations refer to Mean Sea Level Datum. All concrete shown shall be Class "A" and shall be paid for under Item No. 24. For typical dike section see Sheet No. 26.

12-31-45	As built revisions			
11/15/40	Camber change 8" to 6"	P.C.H.	Y.M.	7MB
10/31/40	Camber diagram added	P.C.H.	Y.M.	7MB
KEY	DATE	REVISION (Indicated by Δ)	RE BY	CK BY
CONNECTICUT RIVER FLOOD CONTROL				
HARTFORD DIKE				
RIVERFRONT, MORGAN ST. TO STA. 96+73				
PLAN AND PROFILE				
MASSEK ST. OUTLET				
CONNECTICUT RIVER			CONNECTICUT	
IN 135 SHEETS	SCALE: 1"=20 FT.		SHEET NO. 55	
U.S. ENGINEER OFFICE, PROVIDENCE, R.I., MAY 1940				
SUBMITTED:	APPROVAL RECOMMENDED:	APPROVED:		
HEAD, DESIGN SECTION	PRINCIPAL ENGINEER	LOCAL CORPS OF ENGINEERS		
DESIGNED:	DRAWN: M.B. MC. & D.G.	FISCAL YEAR 1940		
ASSOC. ENGINEER	CHECKED: W.G.C.	FILE NO. CT-4-2515		