
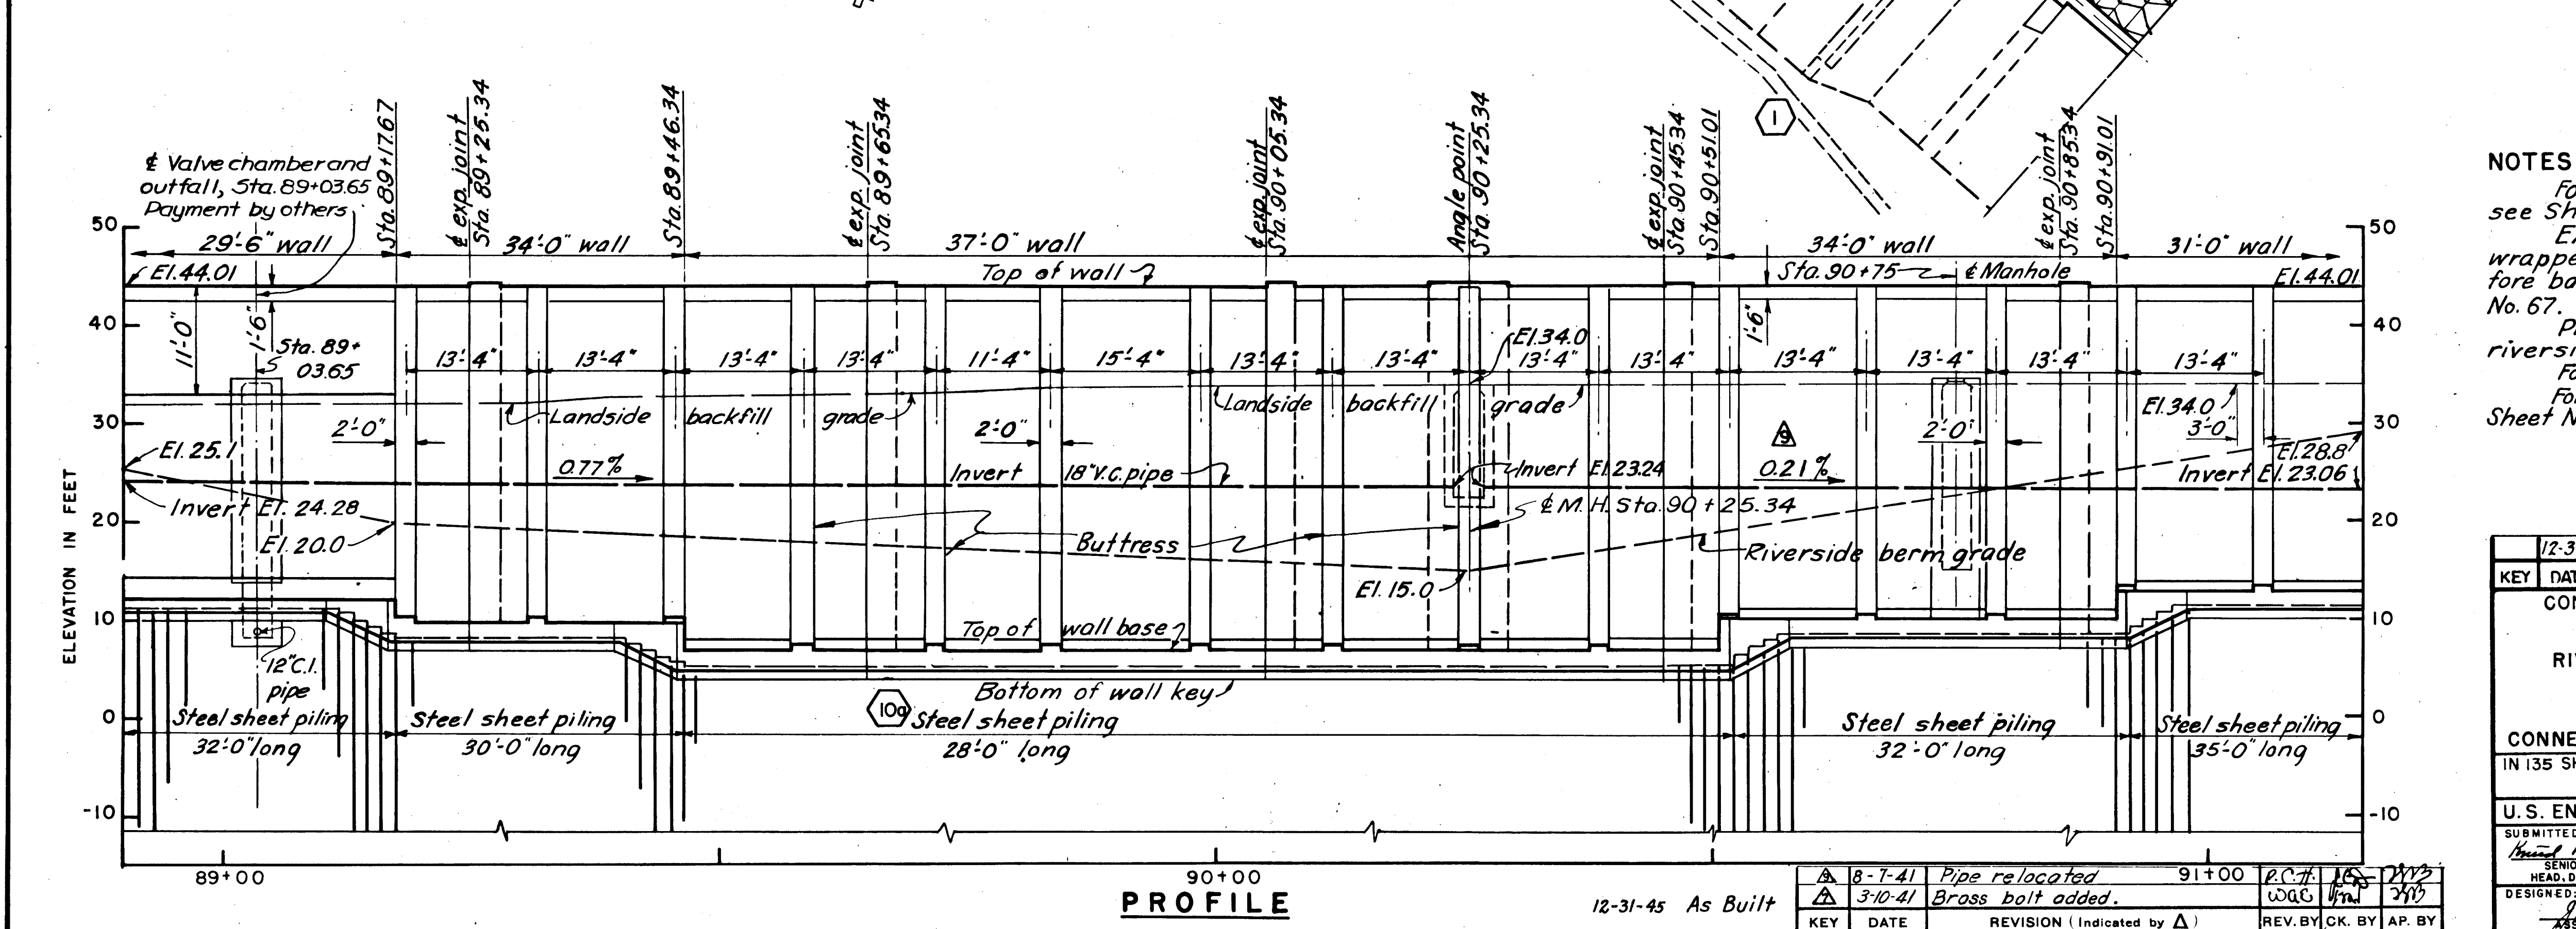


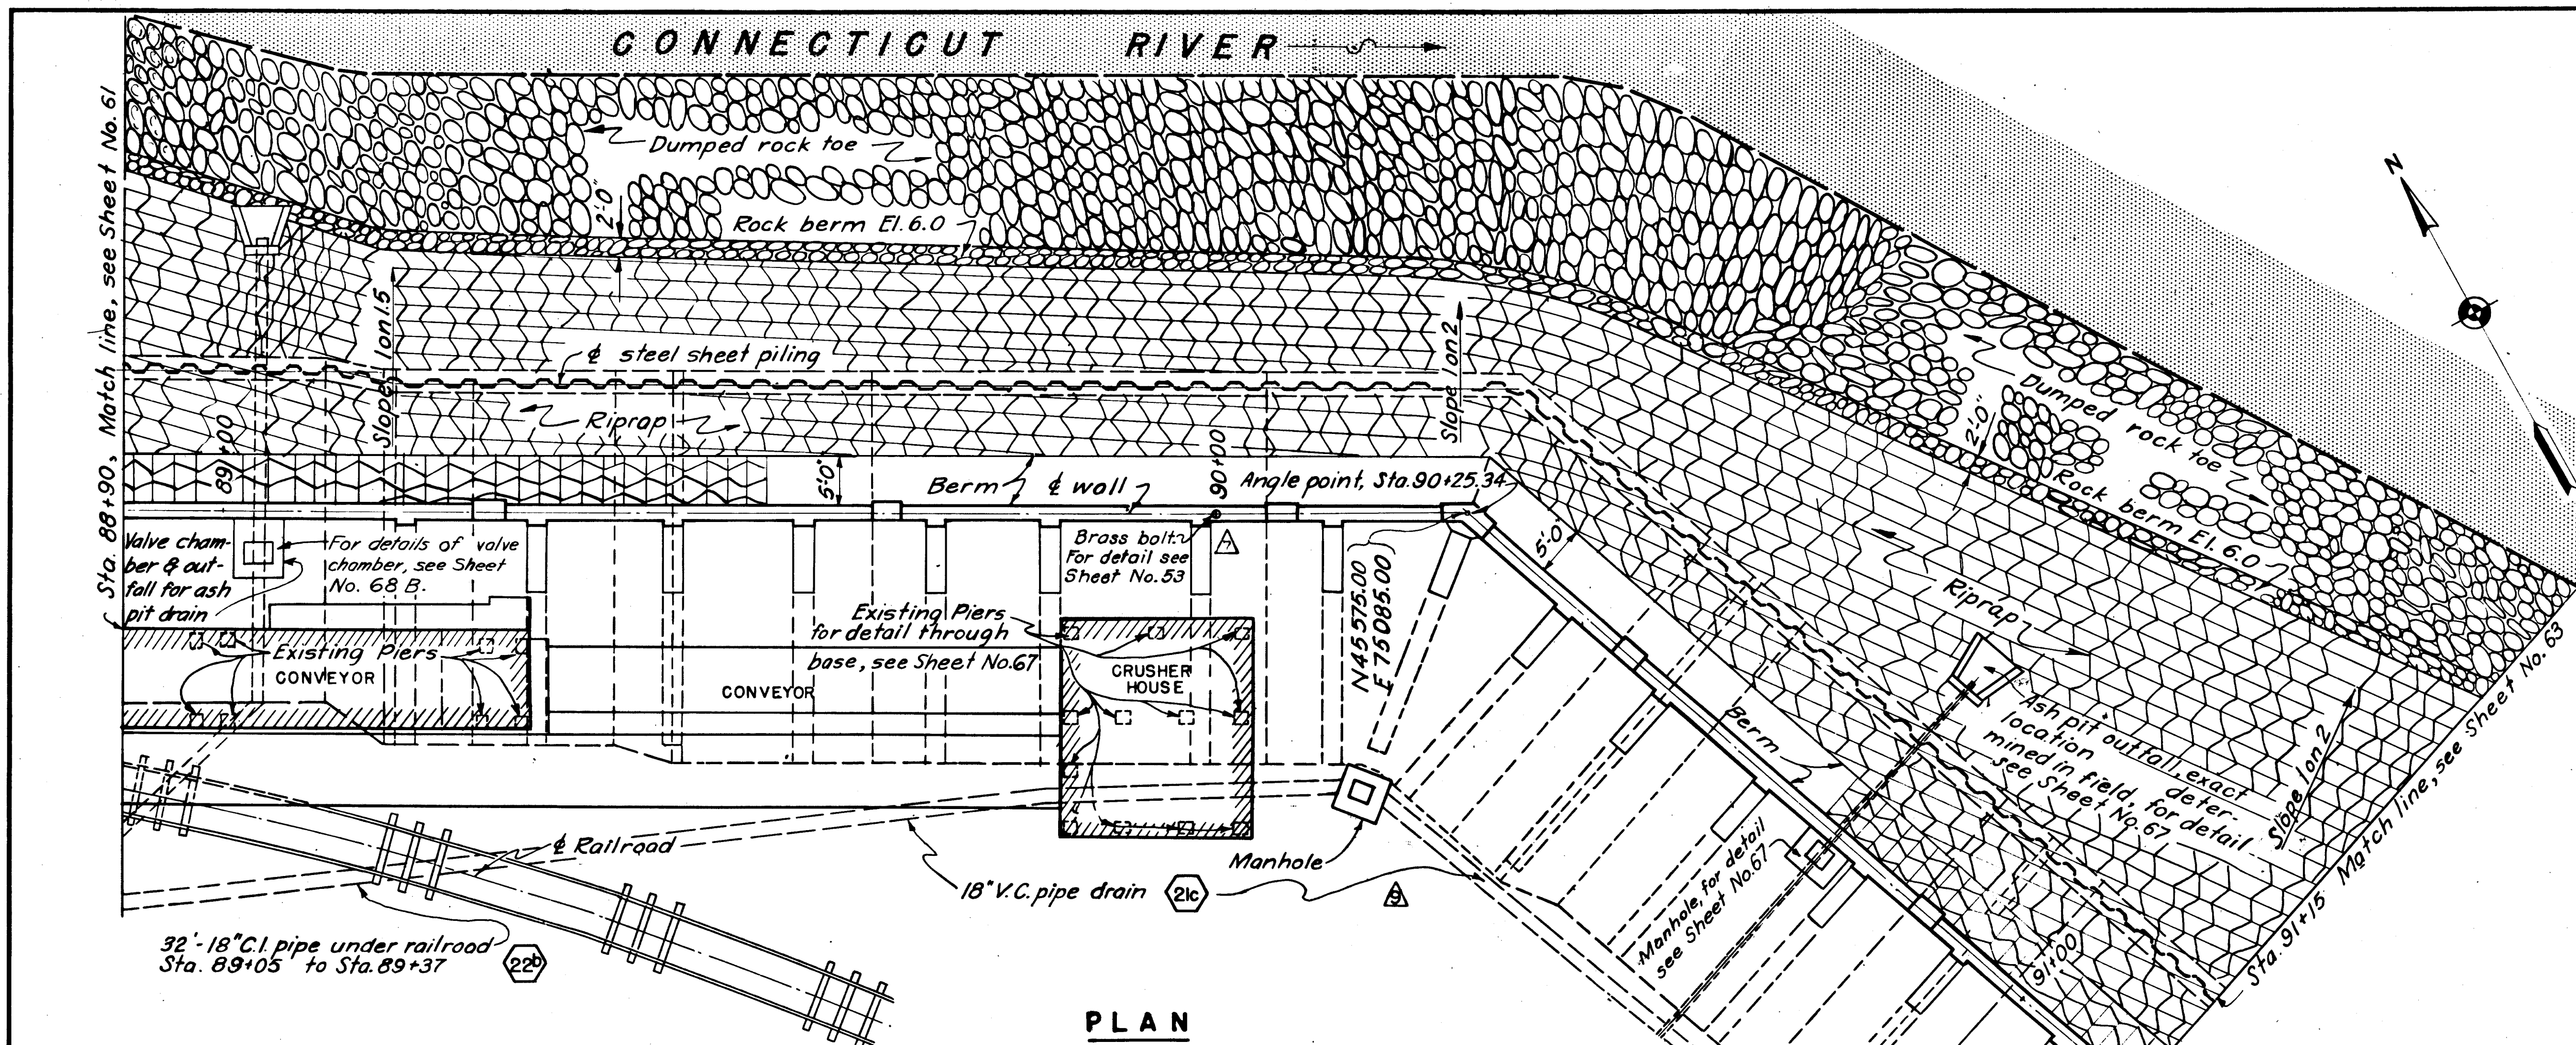

NOTES



For general notes applying to this sheet see Sheet No. 20.

Existing piers encountered shall be wrapped with 1" expansion joint material before base slab is poured, for detail see Sheet No. 67.

Pilasters on buttressed walls are on riverside only.

For concrete details, see Sheet No. 75.

For landside backfill grading scheme, see Sheet No. 23.

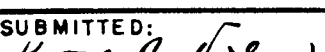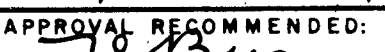12-31-45		As built revisions			
KEY	DATE	REVISION (Indicated by Δ)		REV. BY	CK. BY / AP. BY
CONNECTICUT RIVER FLOOD CONTROL					
HARTFORD DIKE					
RIVERFRONT, MORGAN ST. TO STA. 97+05					
DETAIL PLAN AND PROFILE					
STA. 88+90. TO STA. 91+15.					
CONNECTICUT RIVER			CONNECTICUT		
IN 135 SHEETS		SCALE: 1" = 10' FT.		SHEET NO. 62	
					
U.S. ENGINEER OFFICE, PROVIDENCE, R.I., MAY 1940					
SUBMITTED:		APPROVAL RECOMMENDED:		APPROVED:	
					
SENIOR ENGINEER		PRINCIPAL ENGINEER		CH. COL. CORPS OF ENGINEERS	
HEAD, DESIGN SECTION		CHIEF, F.C. ENGINEERING DIV.		DISTRICT ENGINEER	
DESIGNED:		DRAWN:		FISCAL YEAR 1940	
		W.R.H.		FILE NO. CT-4-2522	
ASSOC. ENGINEER		CHECKED: W.O.B.			

Δ 8-7-41	Pipe relocated	91+00	REV. BY	CK. BY	AP. BY
Δ 3-10-41	Brass bolt added.				
KEY	DATE	REVISION (Indicated by Δ)	REV. BY	CK. BY	AP. BY