
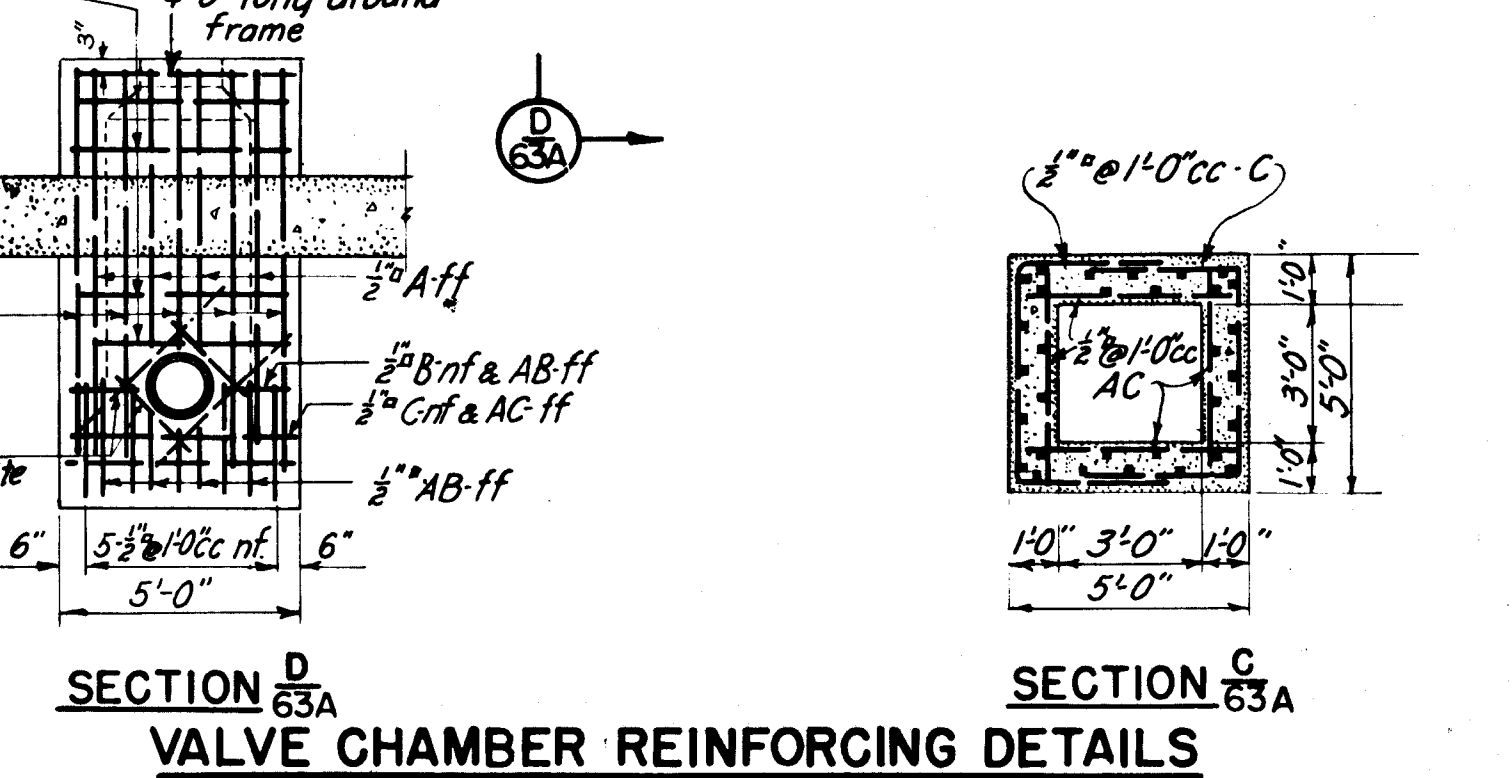
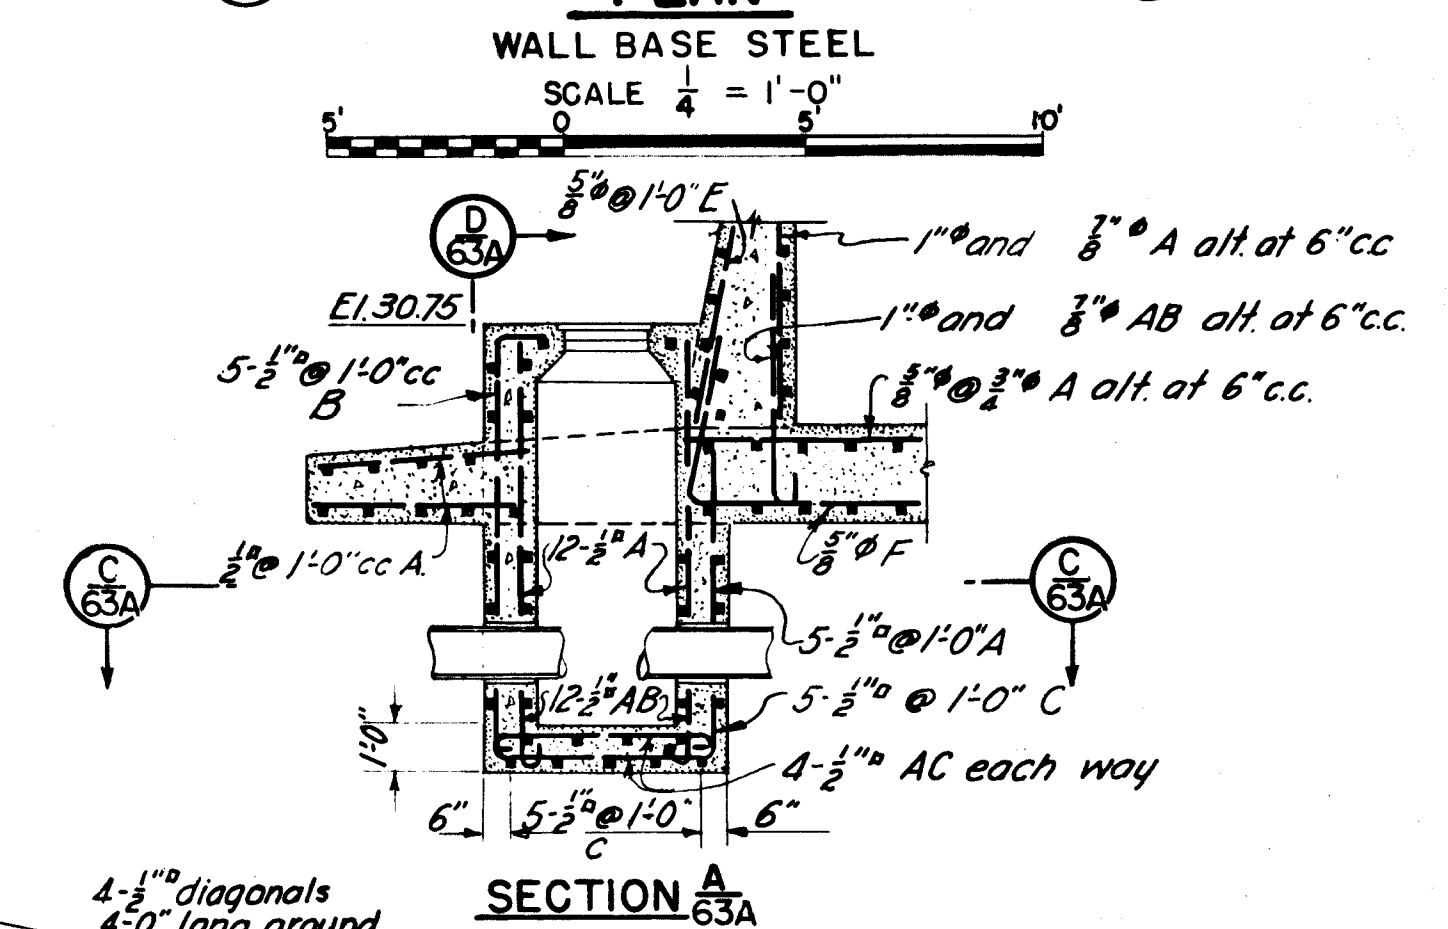
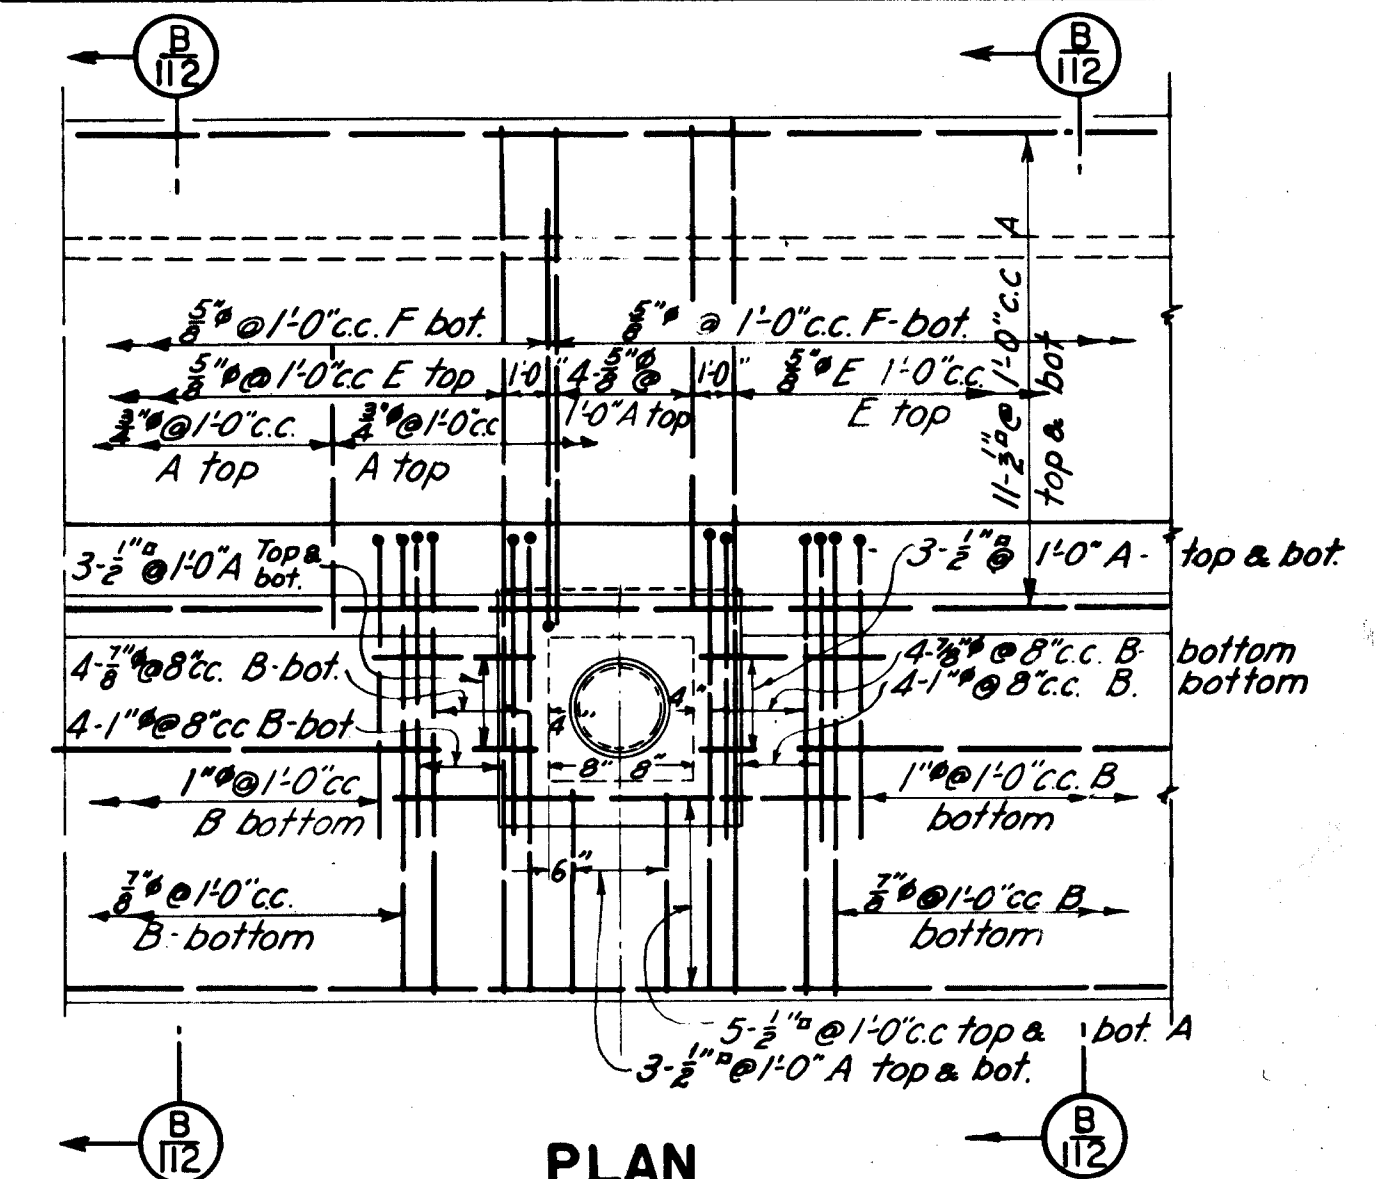
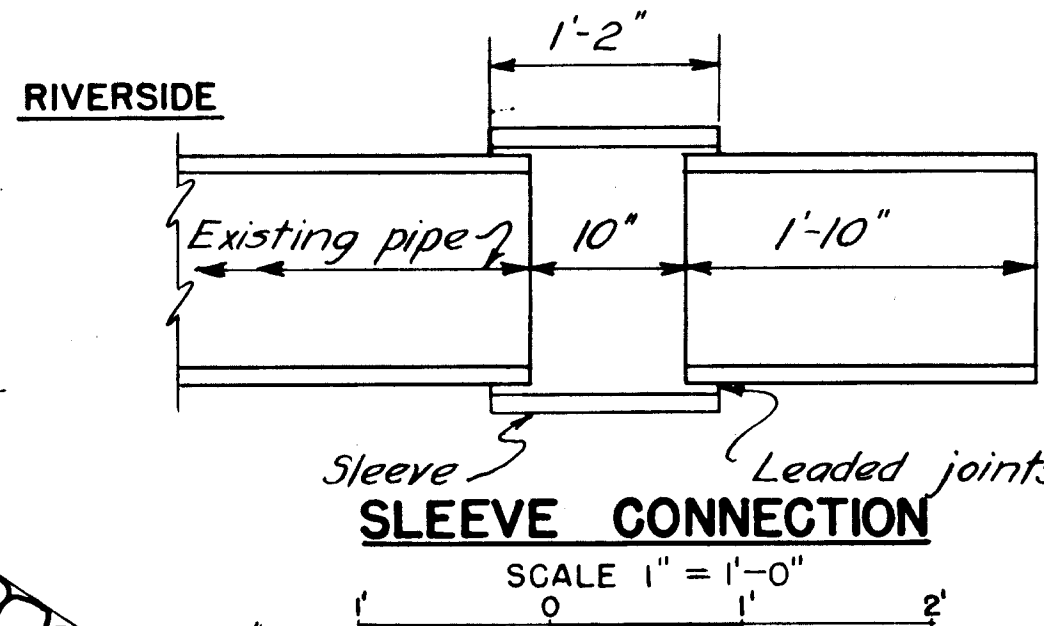
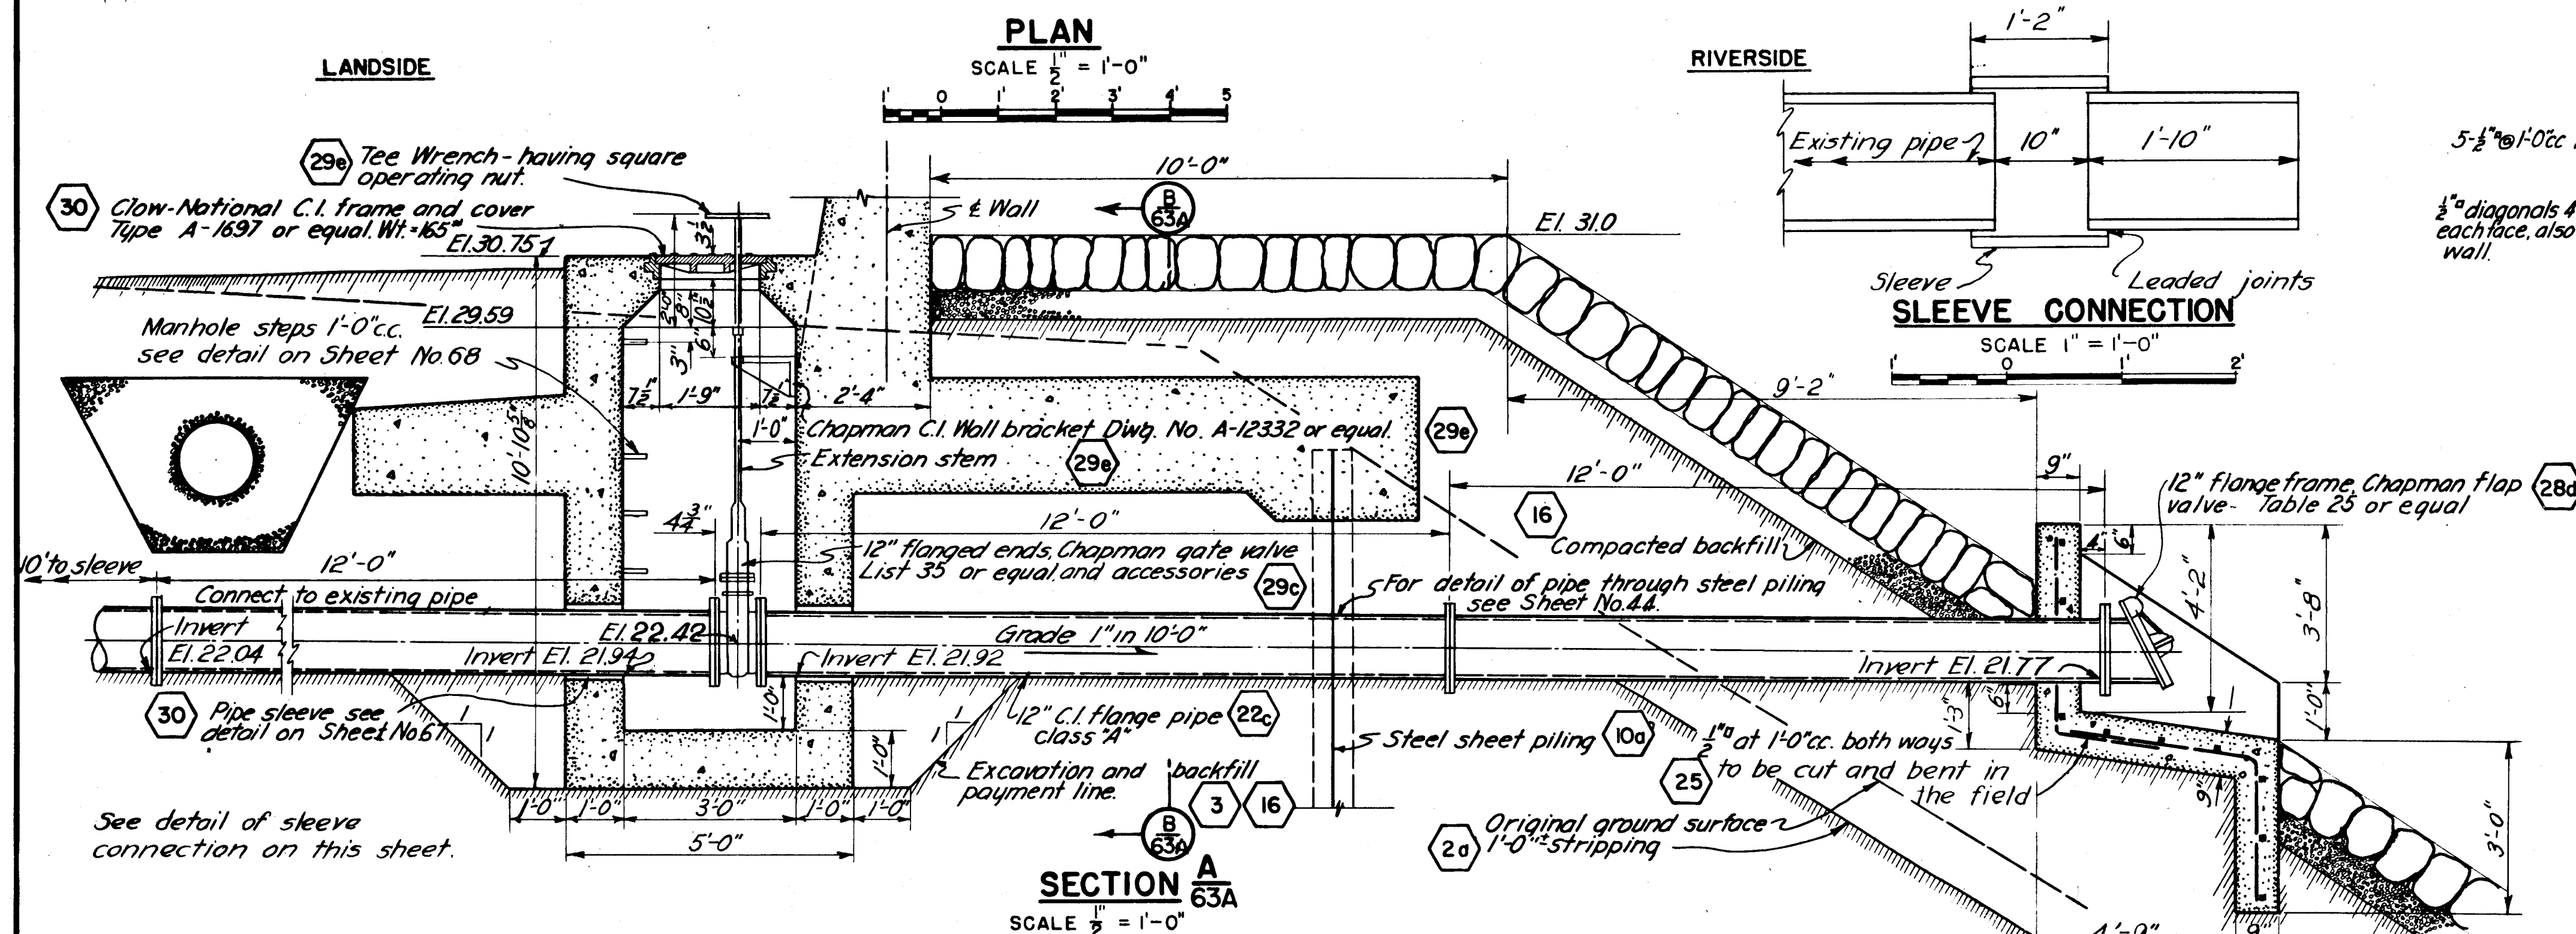
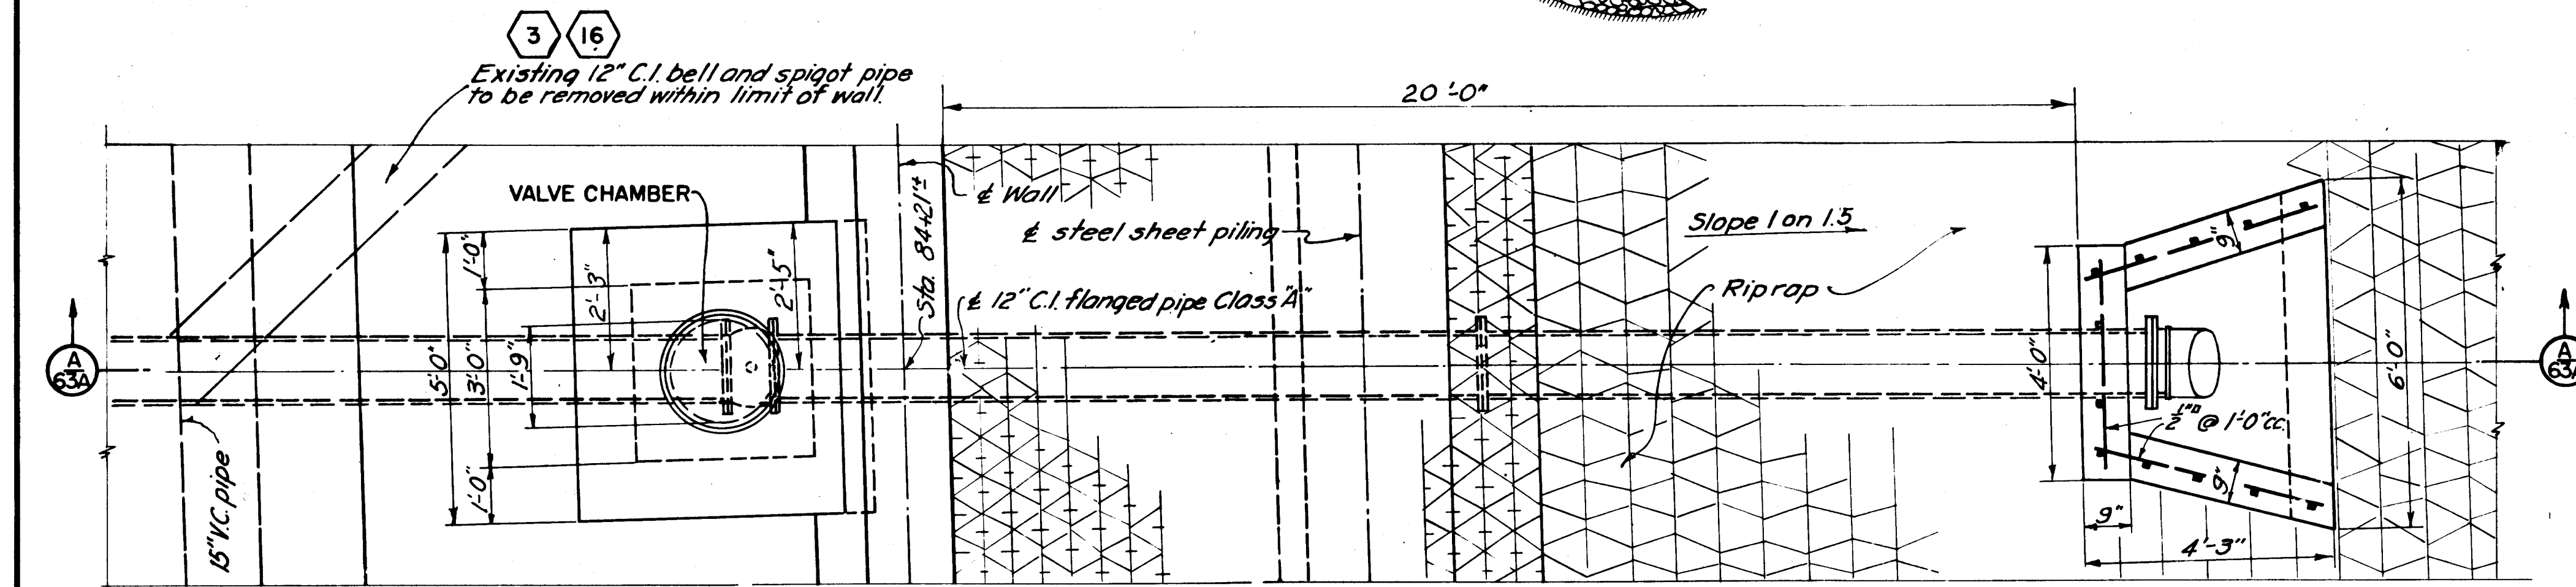
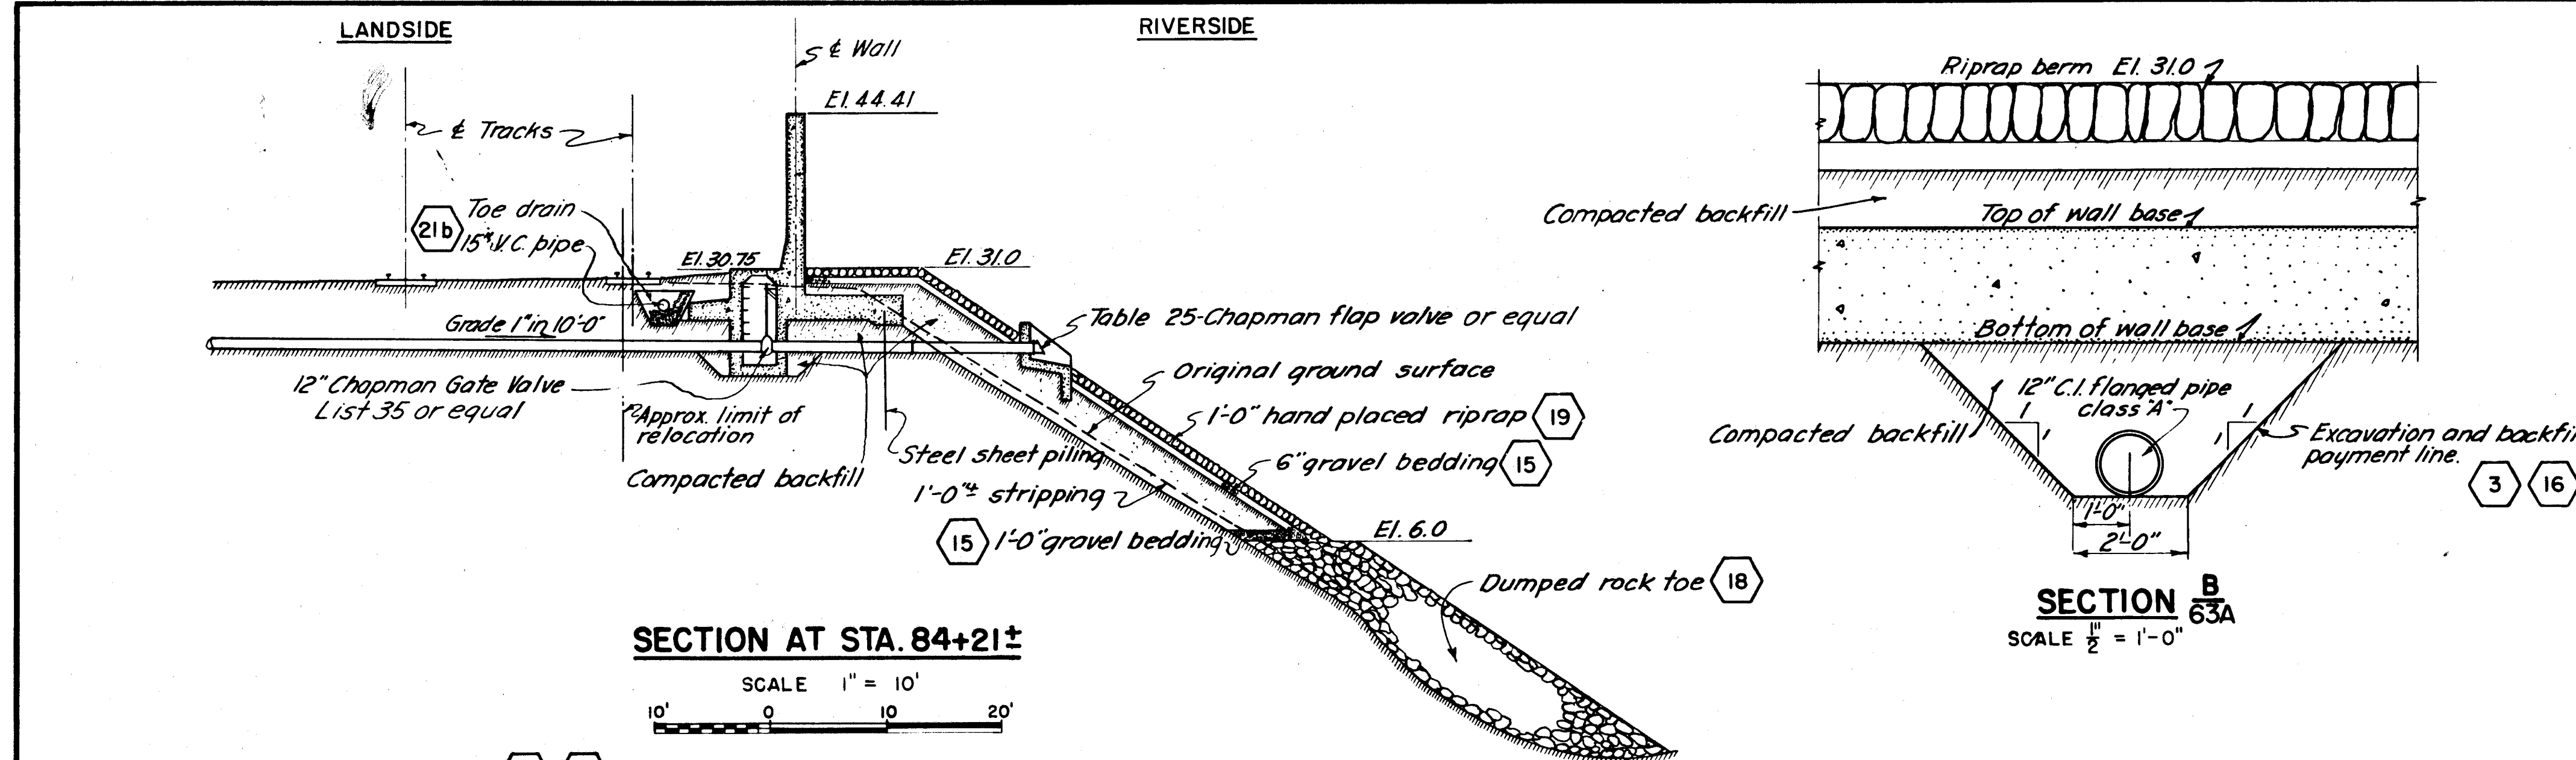
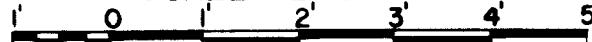
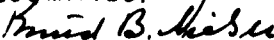


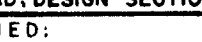

THIS SHEET ADDED TO SET AS OF CHANGE ORDER NO. 5

12/31/45	As built revisions				
KEY	DATE	REVISION (INDICATED BY Δ)			REV.BY CHK. BY AP. BY
CONNECTICUT RIVER FLOOD CONTROL					
HARTFORD DIKE					
RIVERFRONT. MORGAN ST. TO STA. 96+73					
DETAIL OF ROOF DRAIN OUTFALL AT STA. 84+21±					
SOUTH MEADOWS STATION					
CONNECTICUT RIVER			CONNECTICUT		
IN 135 SHEETS			SHEET NO. 63A		
					
U.S. ENGINEER OFFICE, PROVIDENCE, R.I.,					FEB. 1941
SUBMITTED:		APPROVAL RECOMMENDED:		APPROVED:	
					
SENIOR ENGINEER		PRINCIPAL ENGINEER		DISTRICT ENGINEER	
HEAD, DESIGN SECTION		CHIEF, F.C. ENGINEERING DIV.		U.S. ARMY CORPS OF ENGINEERS	
DESIGNED:		DRAWN:		FISCAL YEAR 1941	
		CHECKED: N. M. L.		FILE NO. CT. 4-2849	
ASSOC. ENGINEER		D. W. C.			