



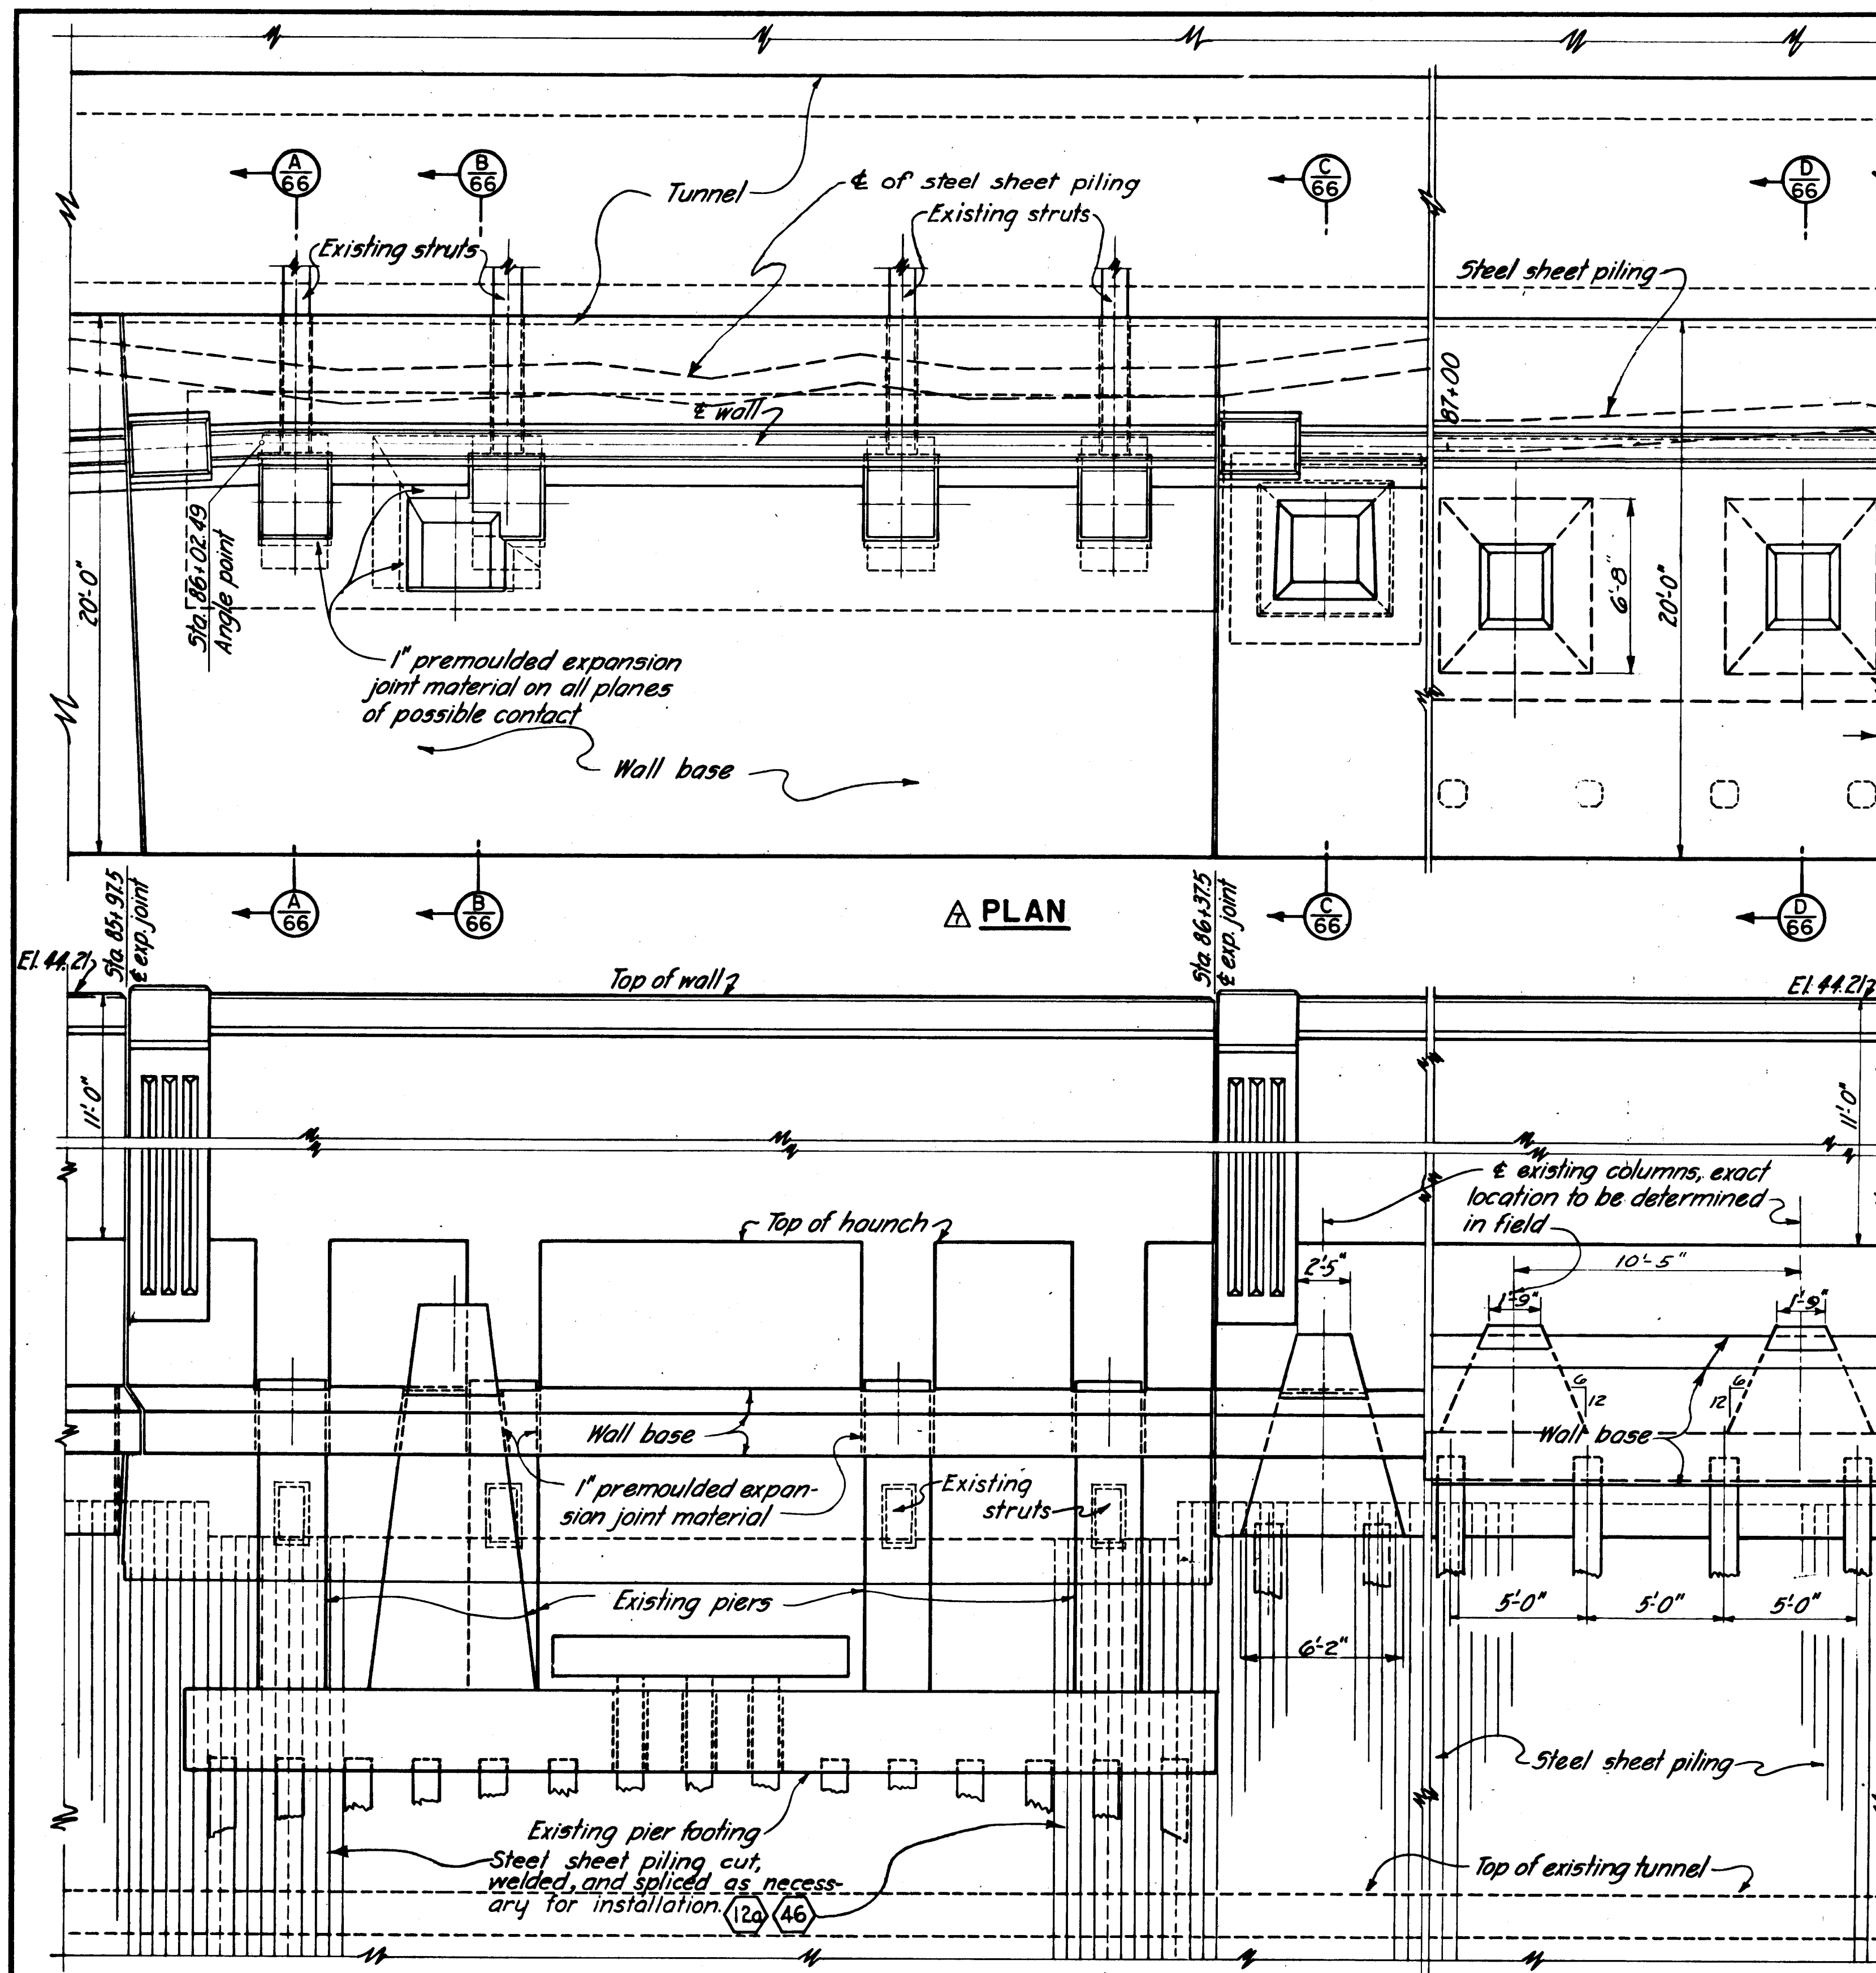


PLAN

LANDSIDE ELEVATION

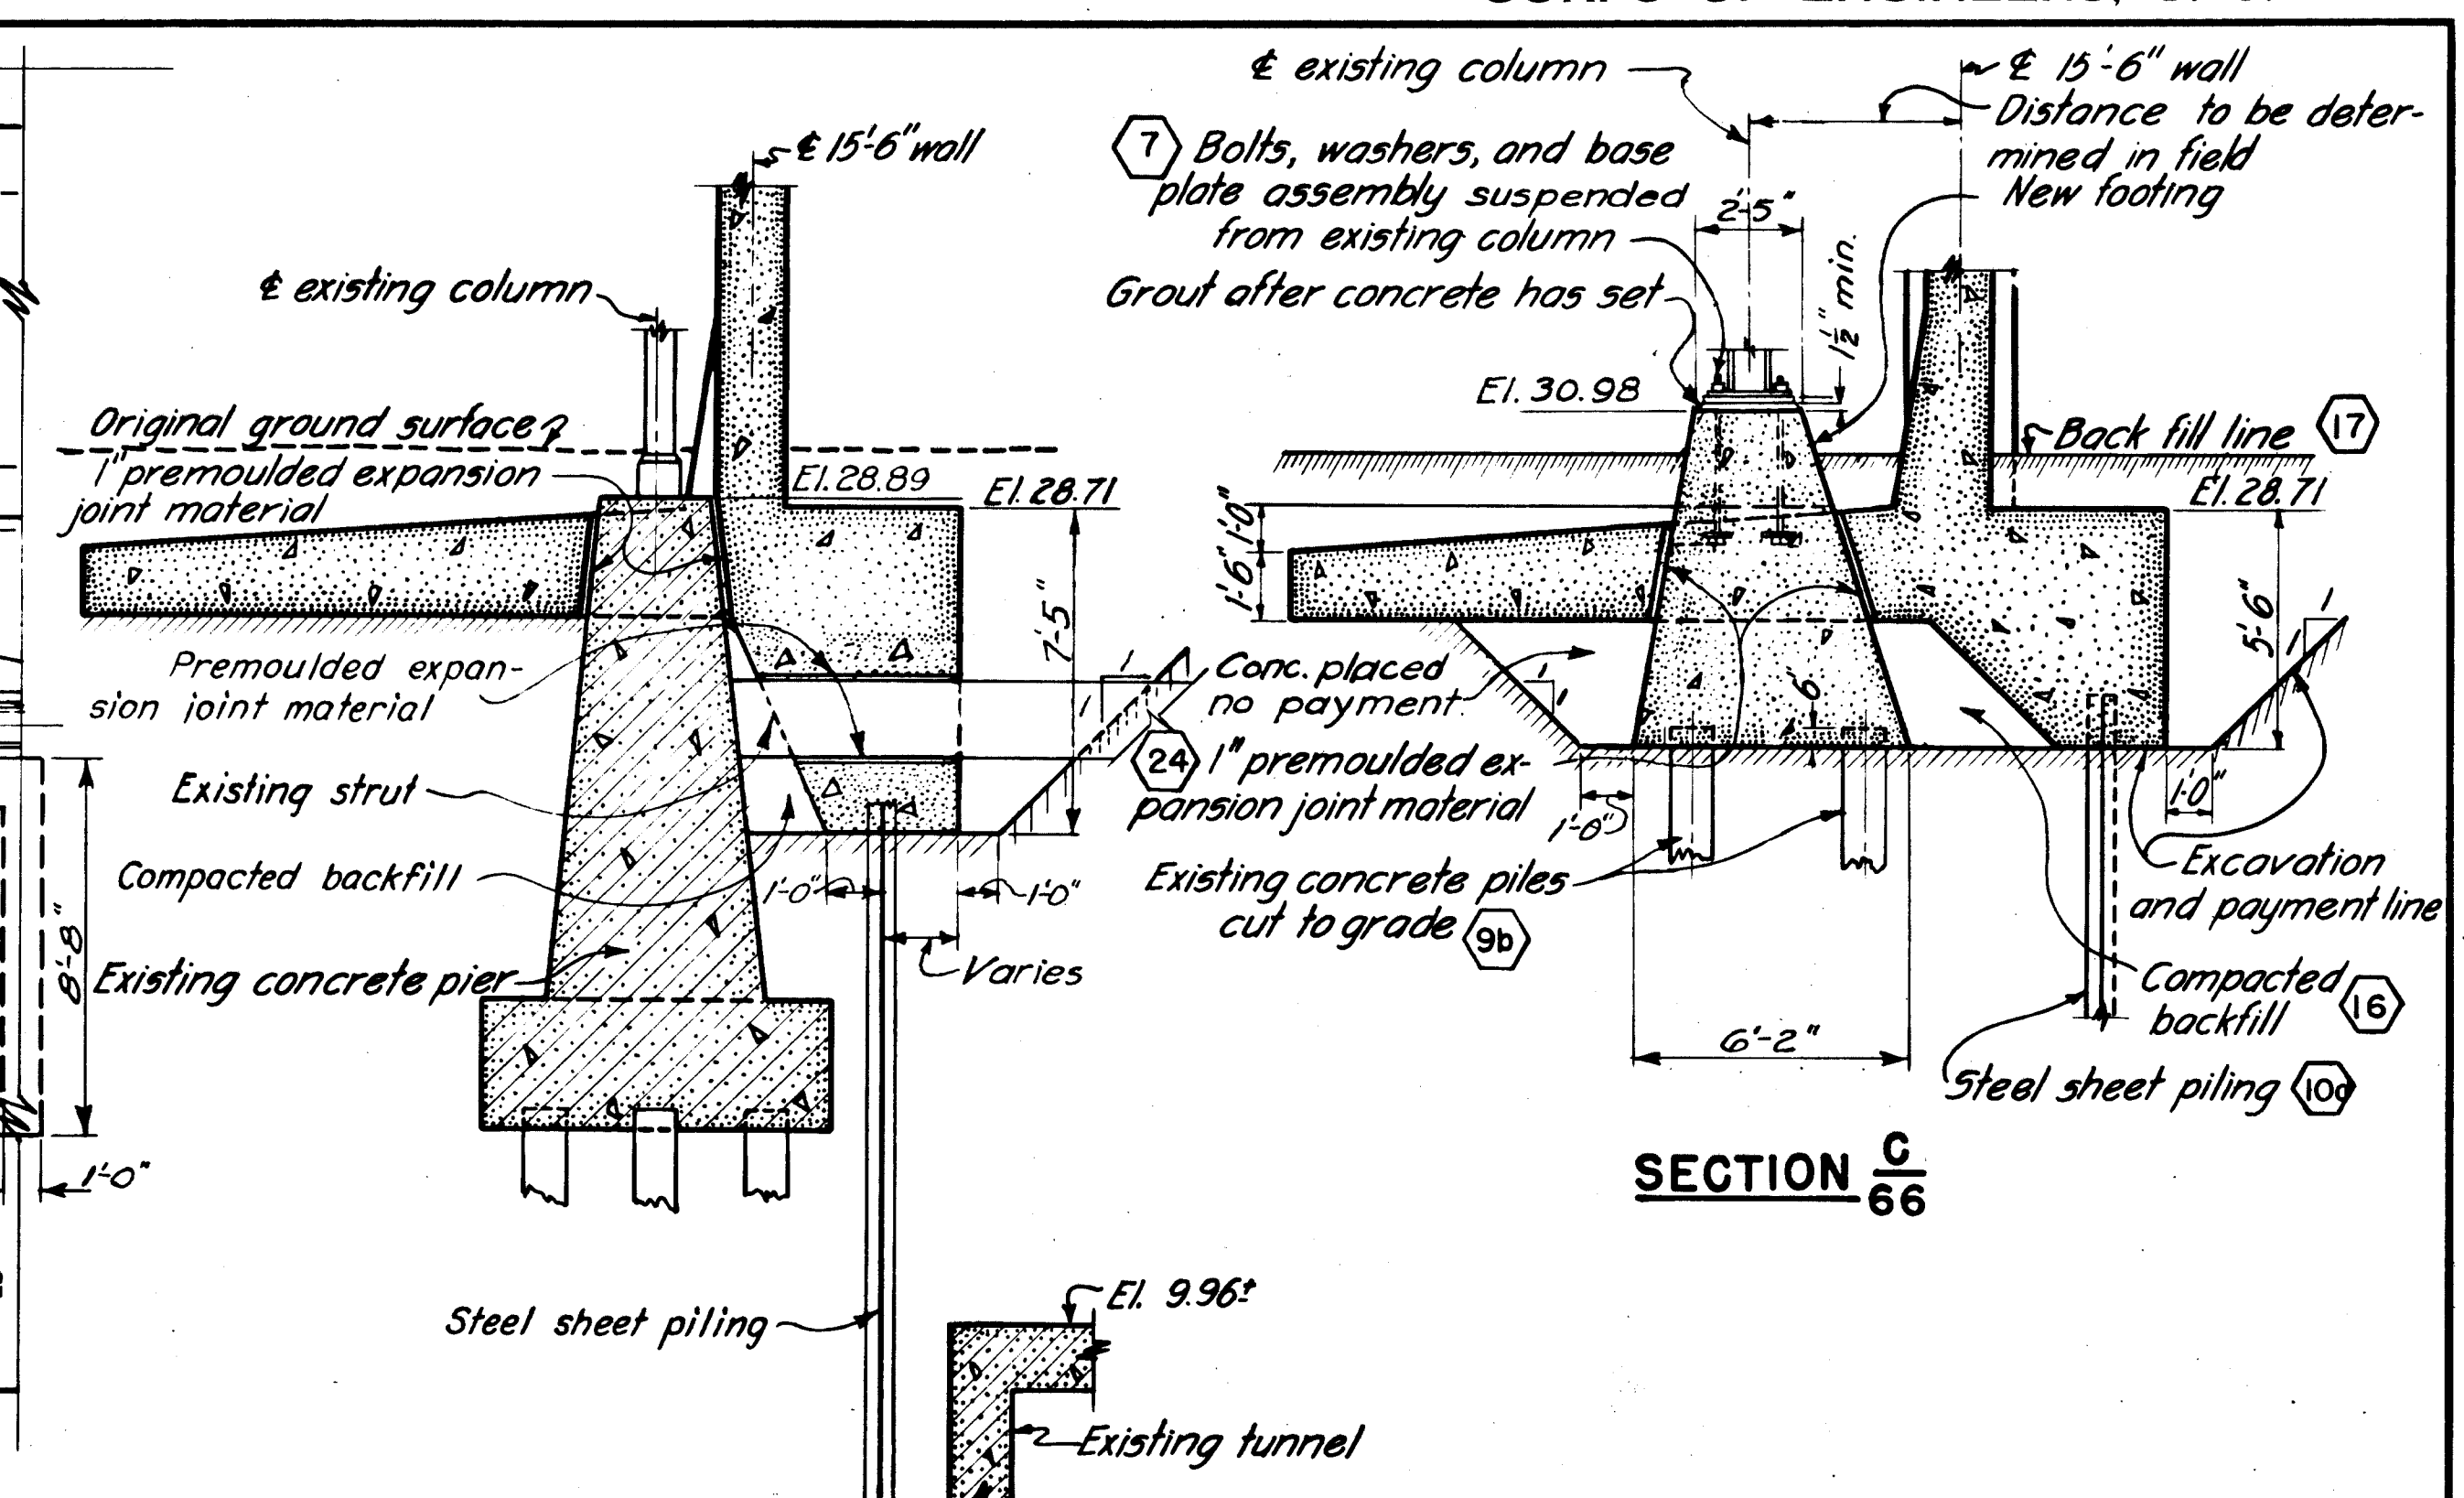

SECTION C/66

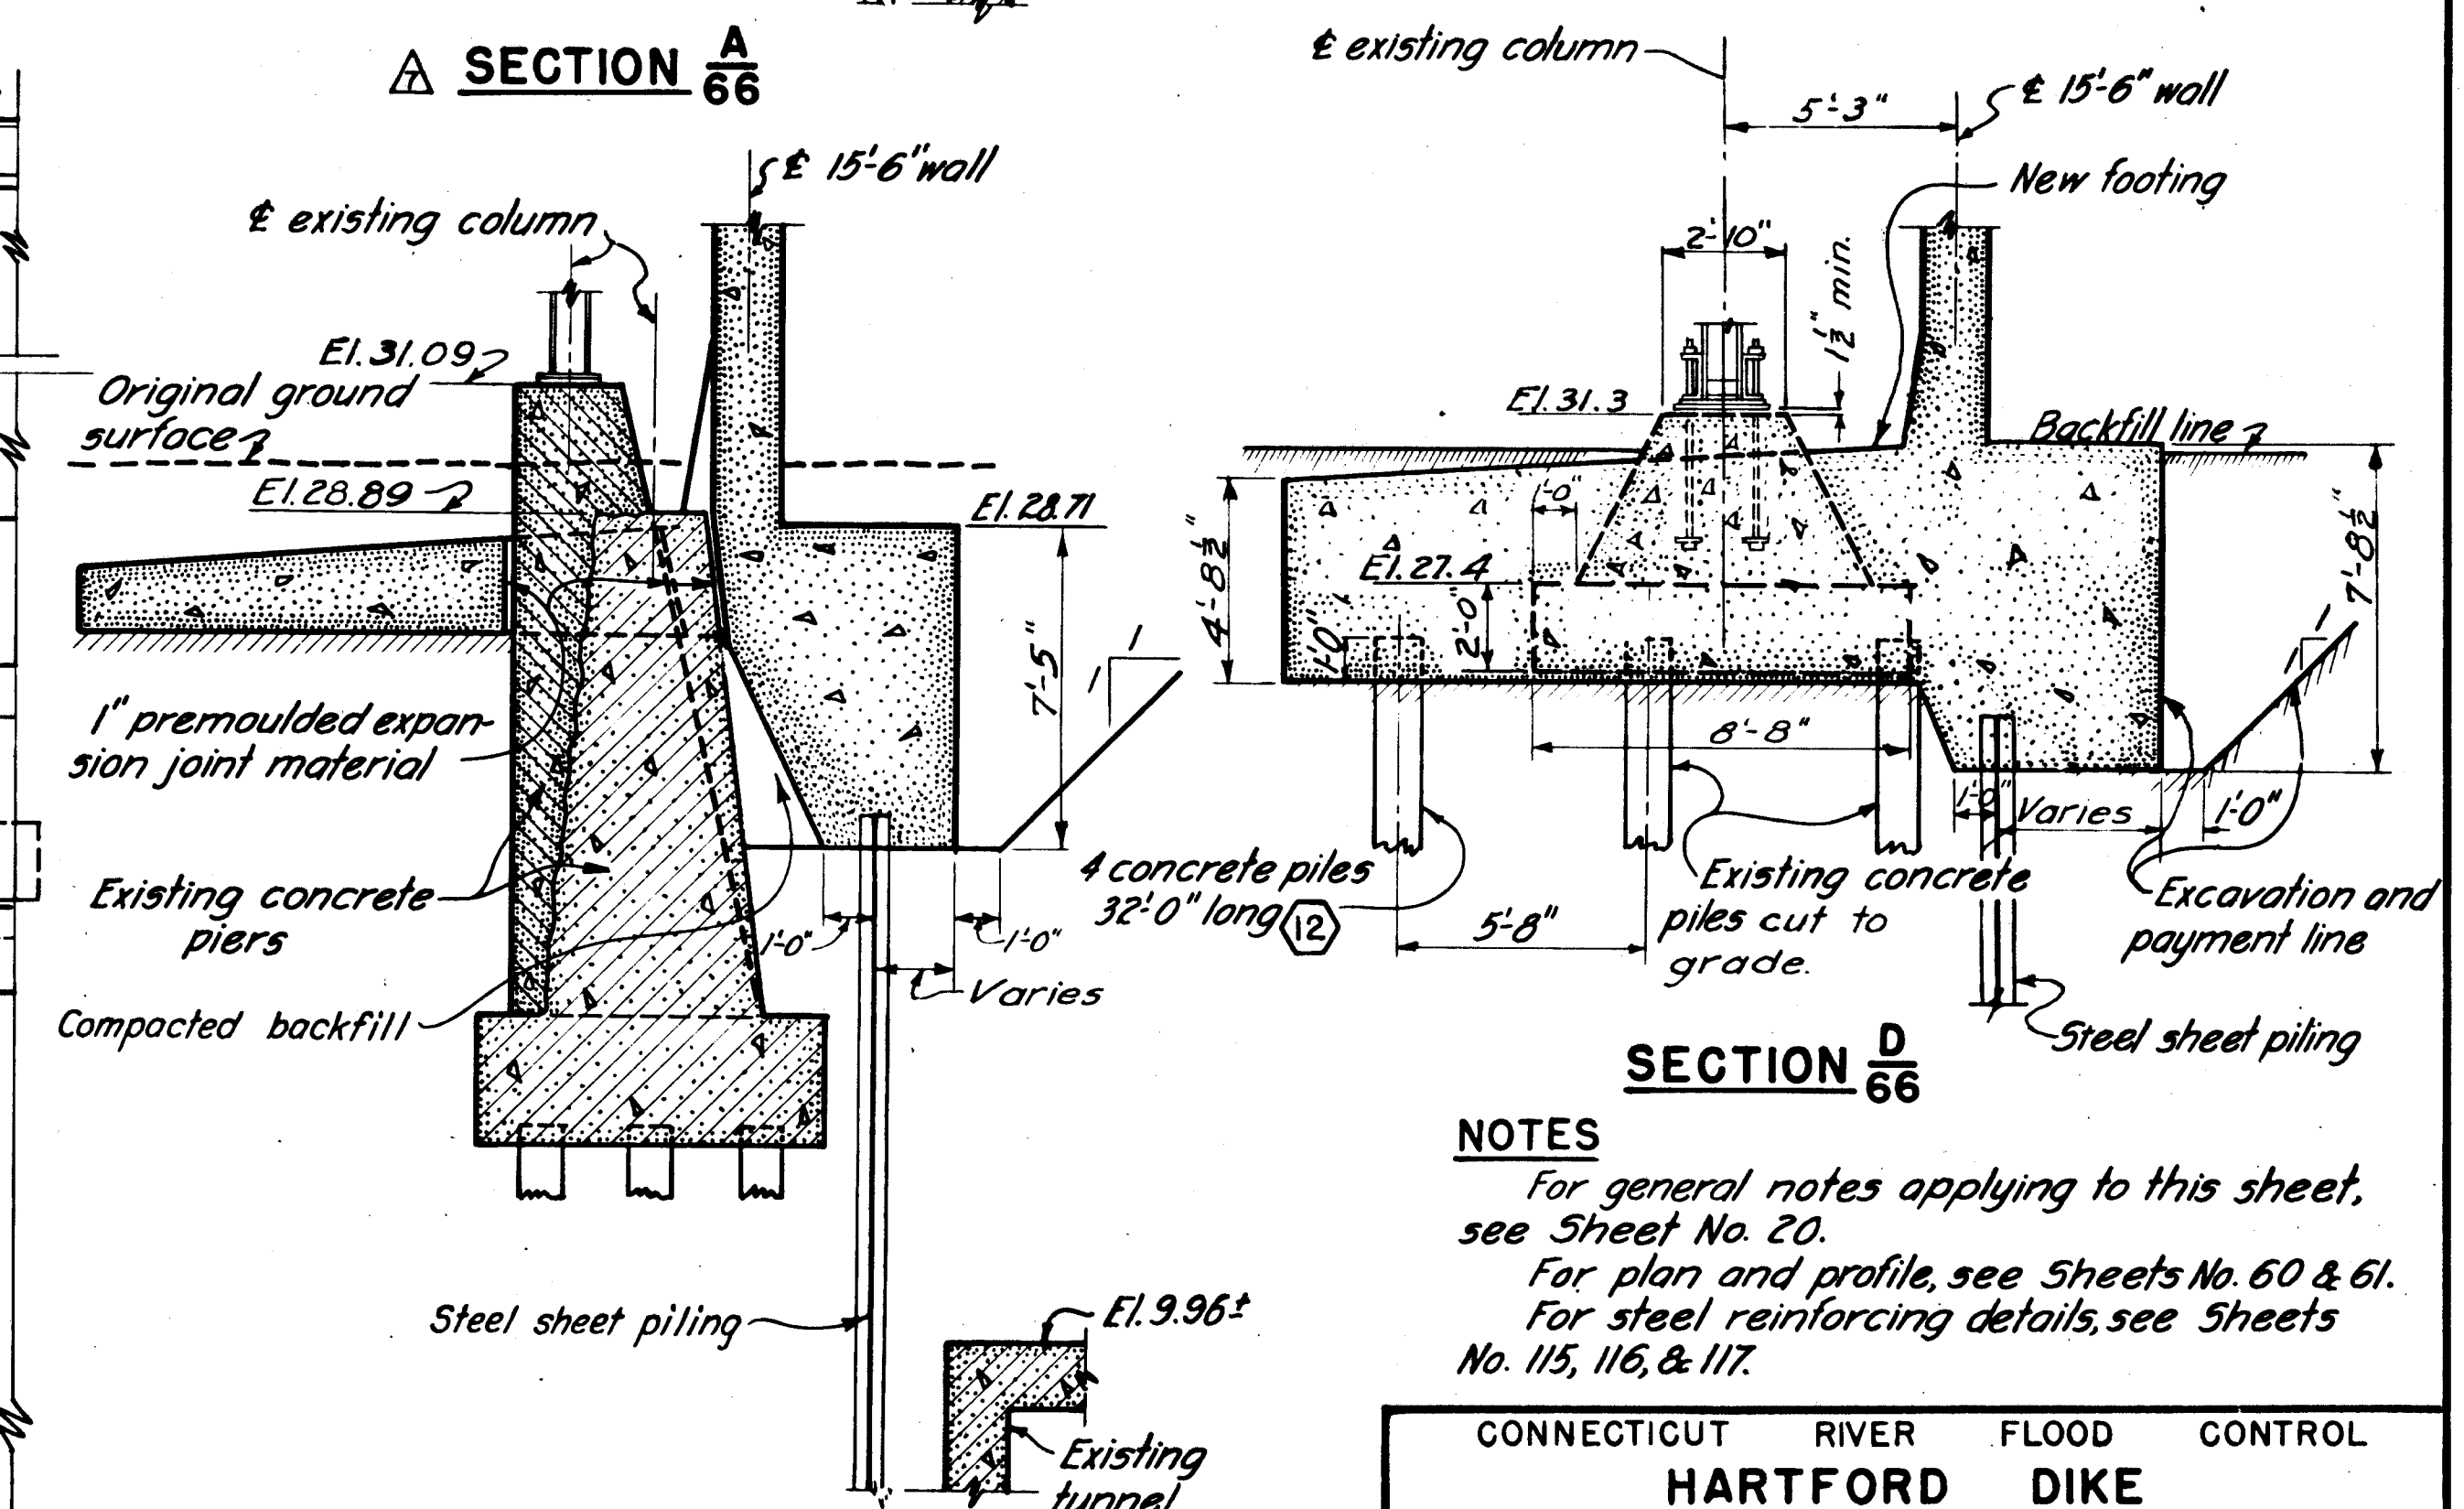

SECTION B/66

NOTES

For general notes applying to this sheet, see Sheet No. 20.

For plan and profile, see Sheets No. 60 & 61.
For steel reinforcing details, see Sheets No. 115, 116, & 117.

CONNECTICUT RIVER FLOOD CONTROL
HARTFORD DIKE
RIVERFRONT, MORGAN ST. TO STA. 96+73
MISCELLANEOUS CONCRETE DETAILS NO. 1
SOUTH MEADOWS STATION

CONNECTICUT RIVER CONNECTICUT
IN 135 SHEETS SCALE: 1/4 IN. = 1 FT. SHEET NO. 66

U.S. ENGINEER OFFICE, PROVIDENCE, R.I., MAY 1940

SUBMITTED: *Handwritten signature* APPROVAL RECOMMENDED: *Handwritten signature* APPROVED: *Handwritten signature*
SENIOR ENGINEER PRINCIPAL ENGINEER
HEAD, DESIGN SECTION CHIEF, F.O. ENGINEERING DIV. DISTRICT ENGINEER
DESIGNED: *Handwritten signature* DRAWN: R.S.S. & A.K. TRACED: L.A.O. CHECKED: W.Q.E. FISCAL YEAR 1940
ASSOC. ENGINEER

FILE NO. CT-4-2526

12-31-45	As built revisions				
3-10-41	Curtain wall raised	W.Q.E.	1921	W.B.	
KEY	DATE	REVISION (Indicated by Δ)	REV. BY	CK. BY	AP. BY