

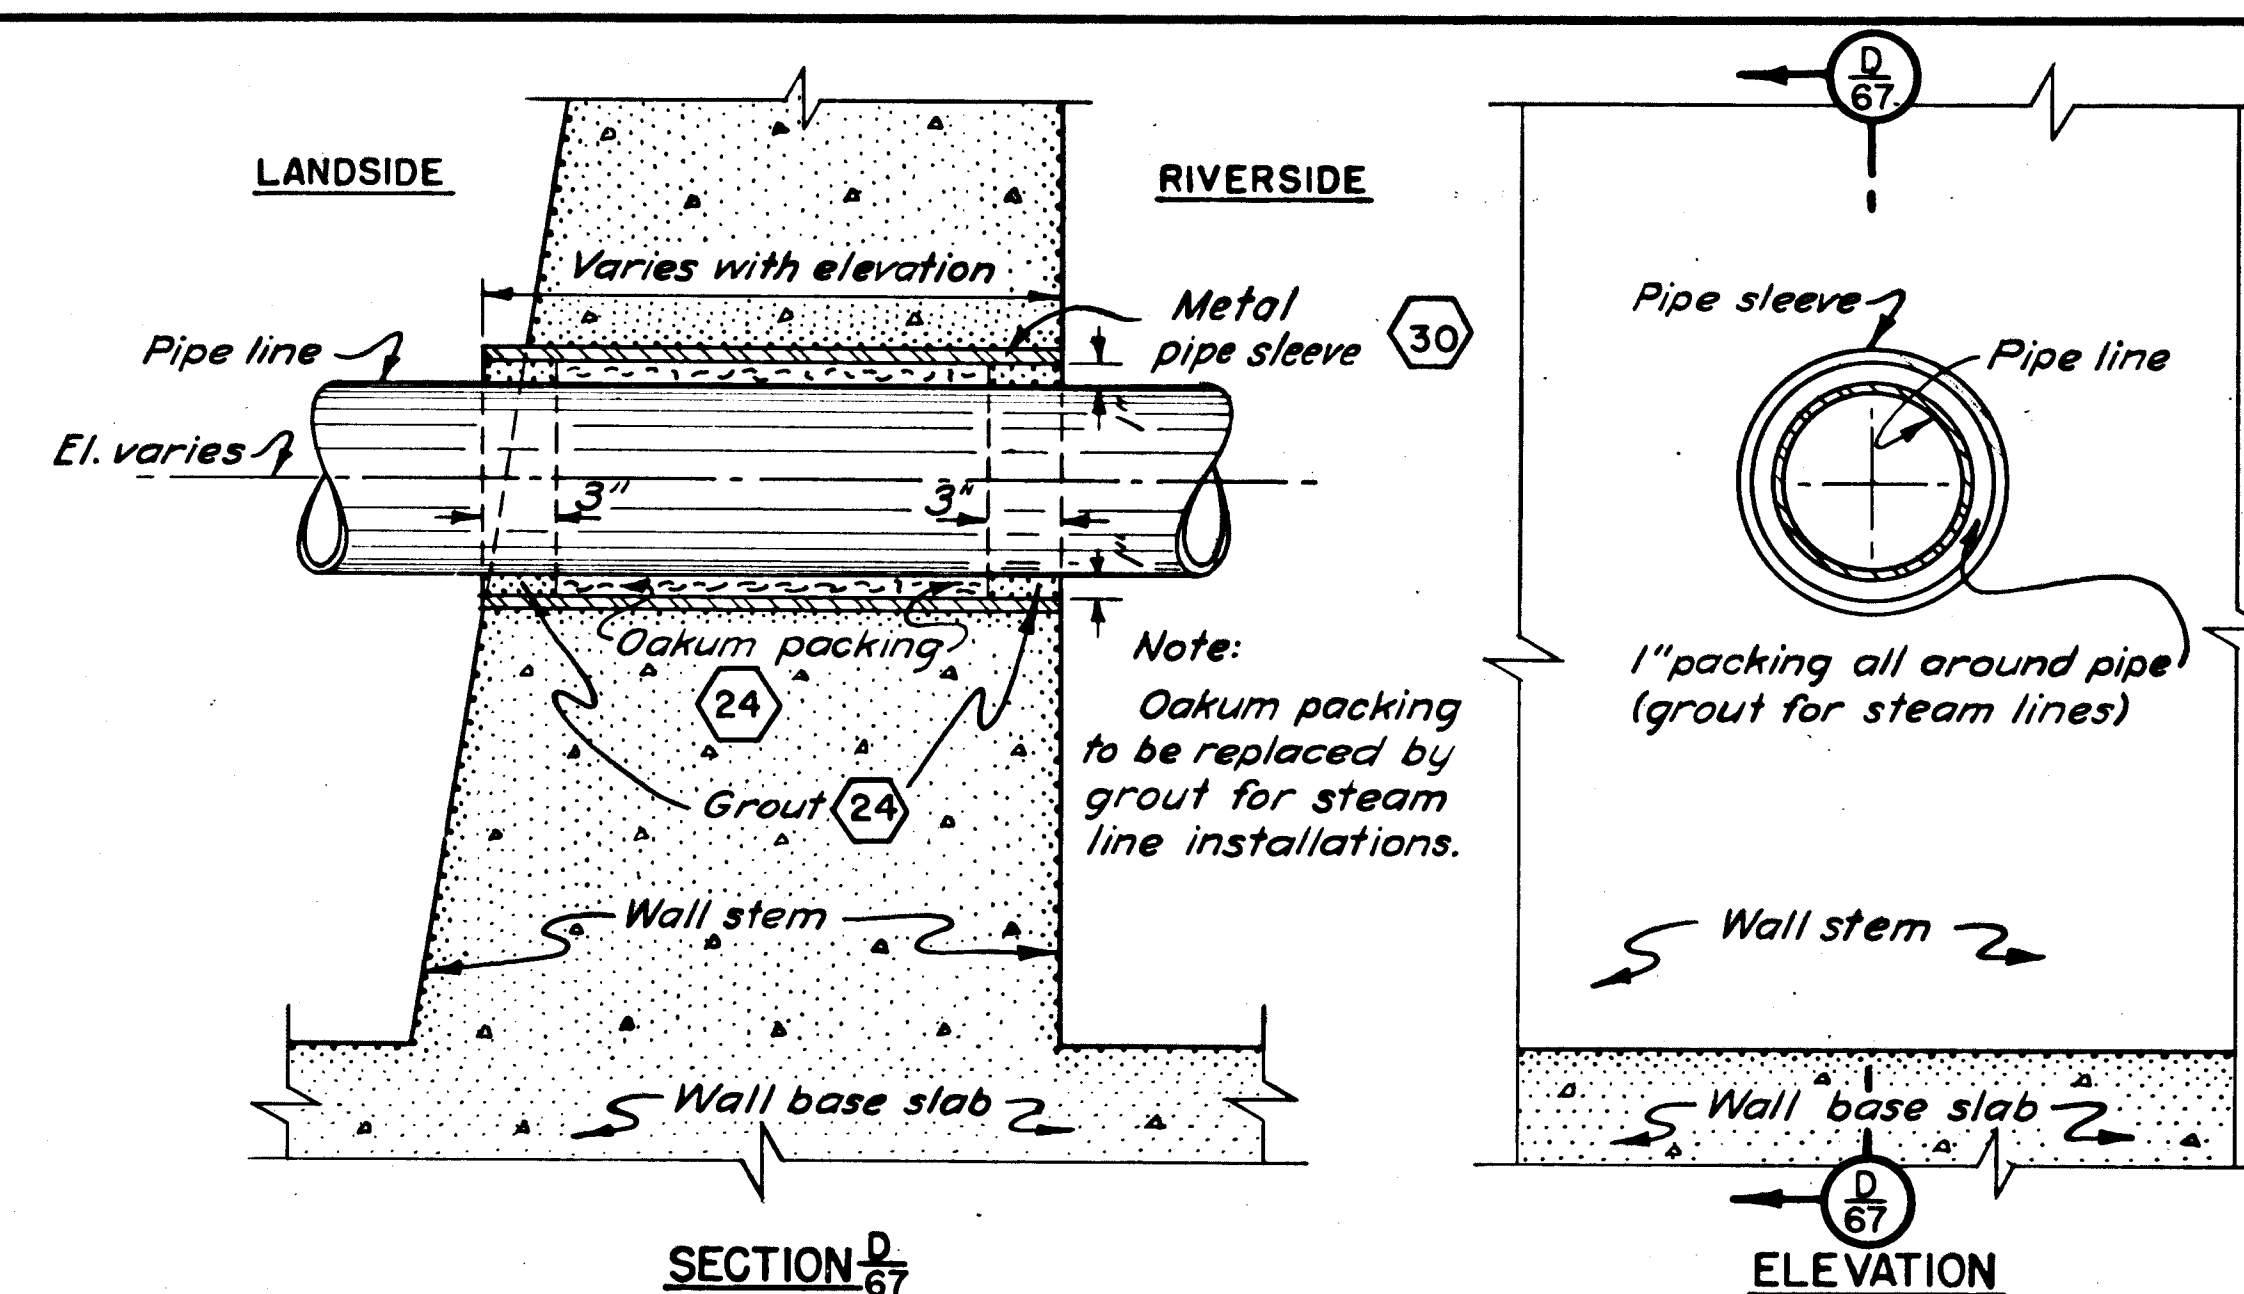
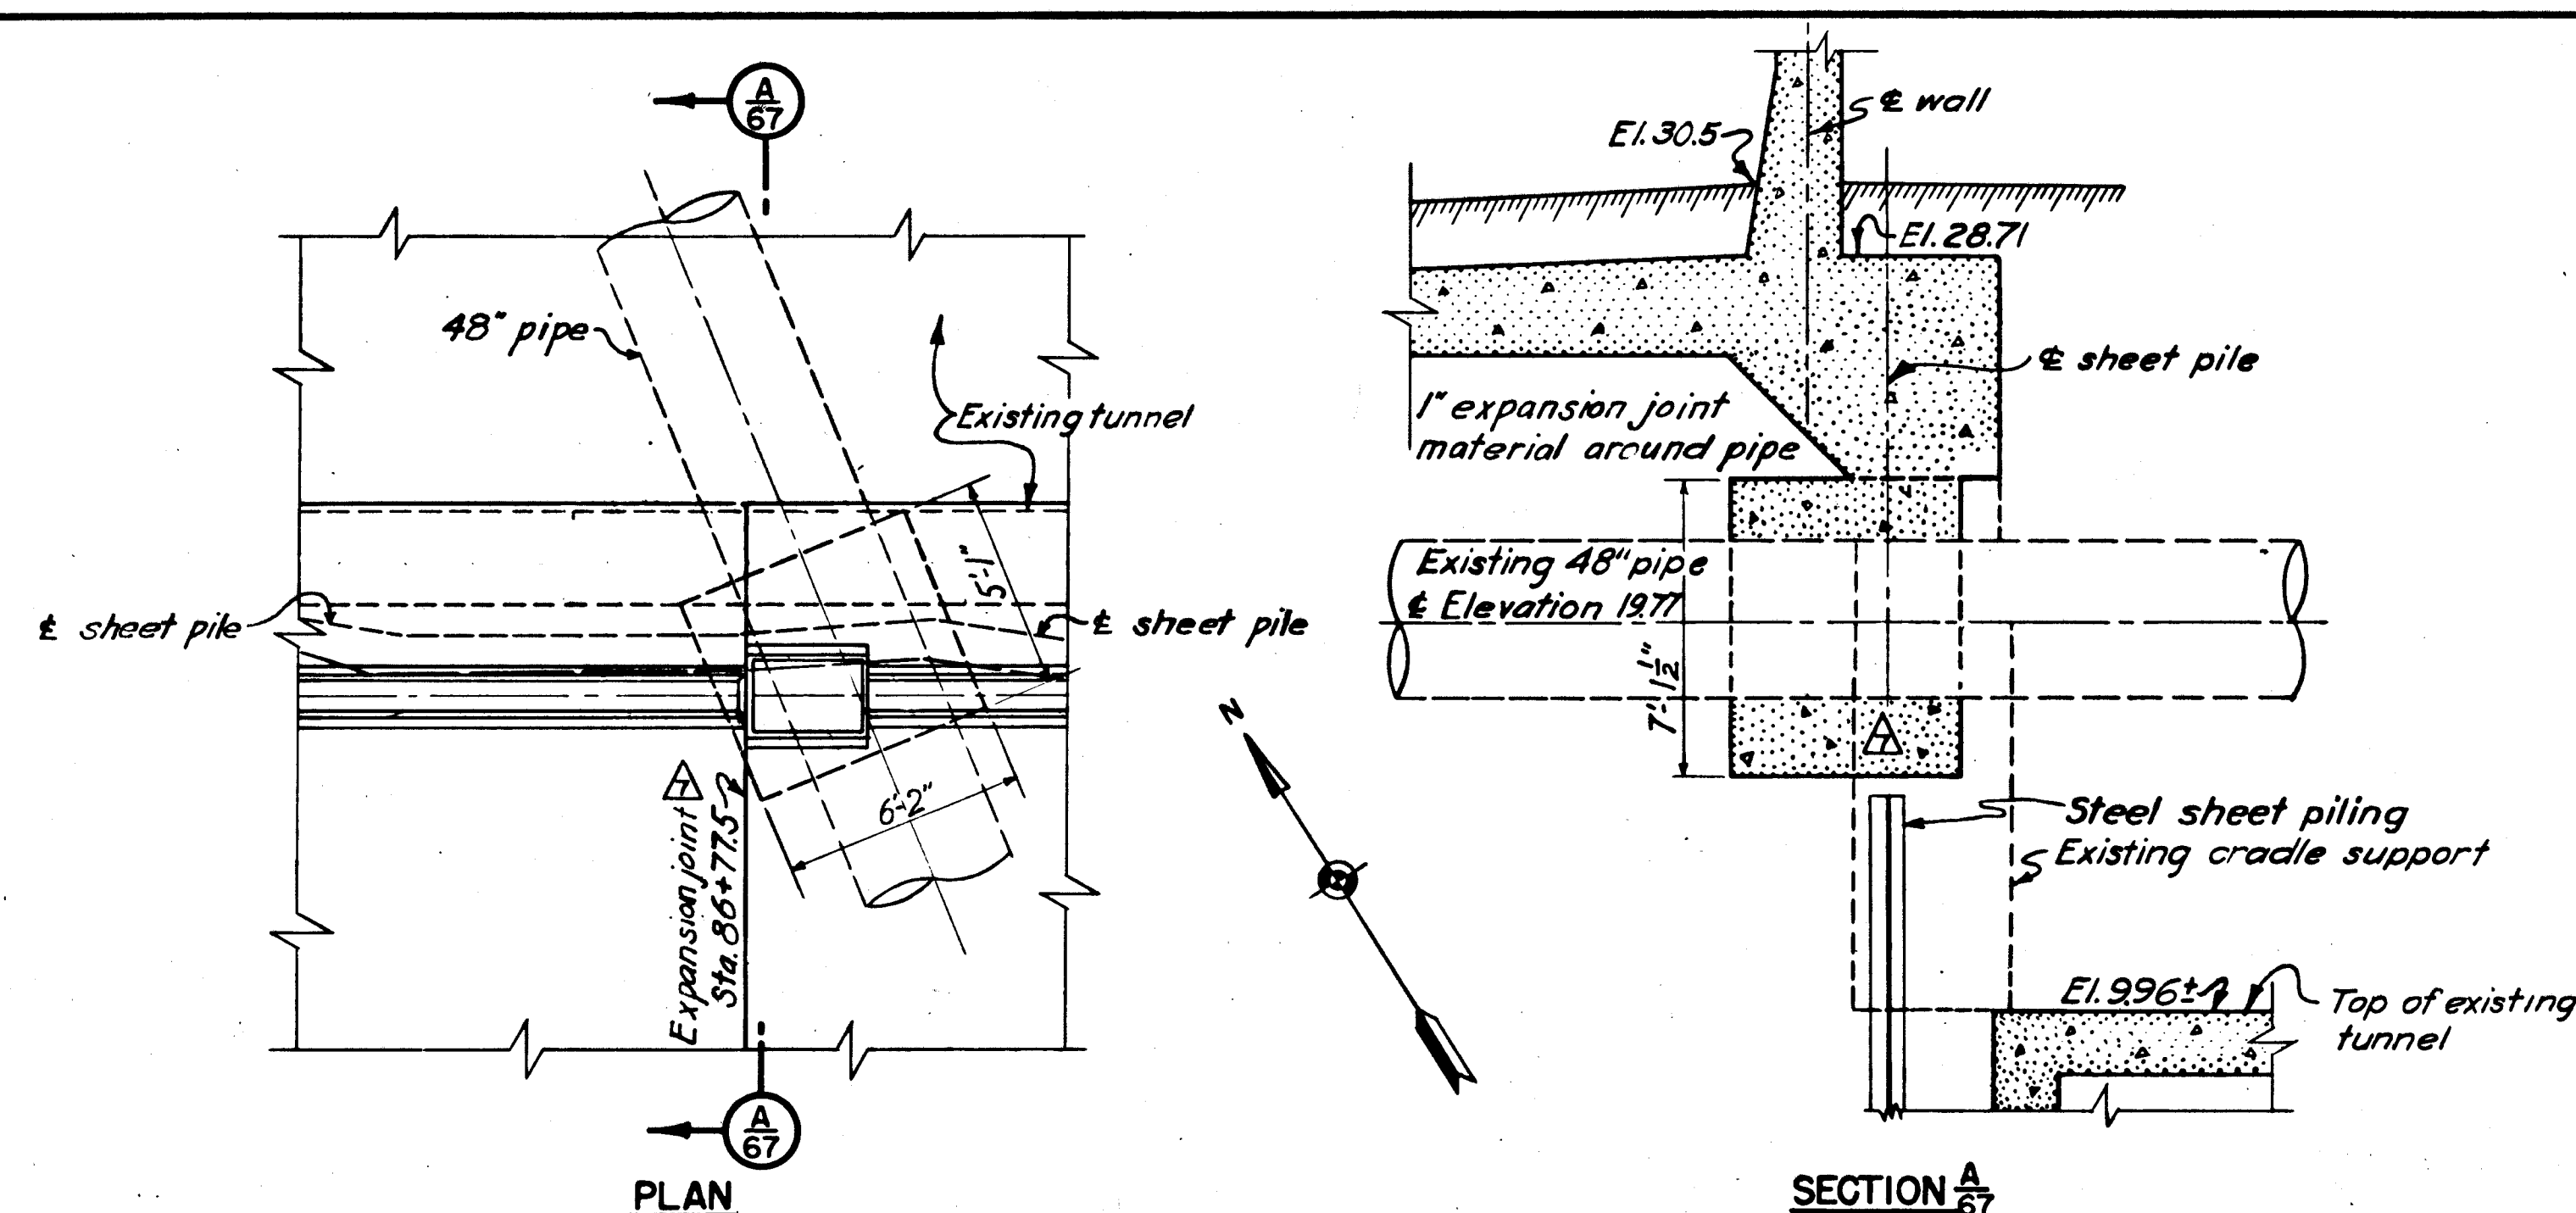
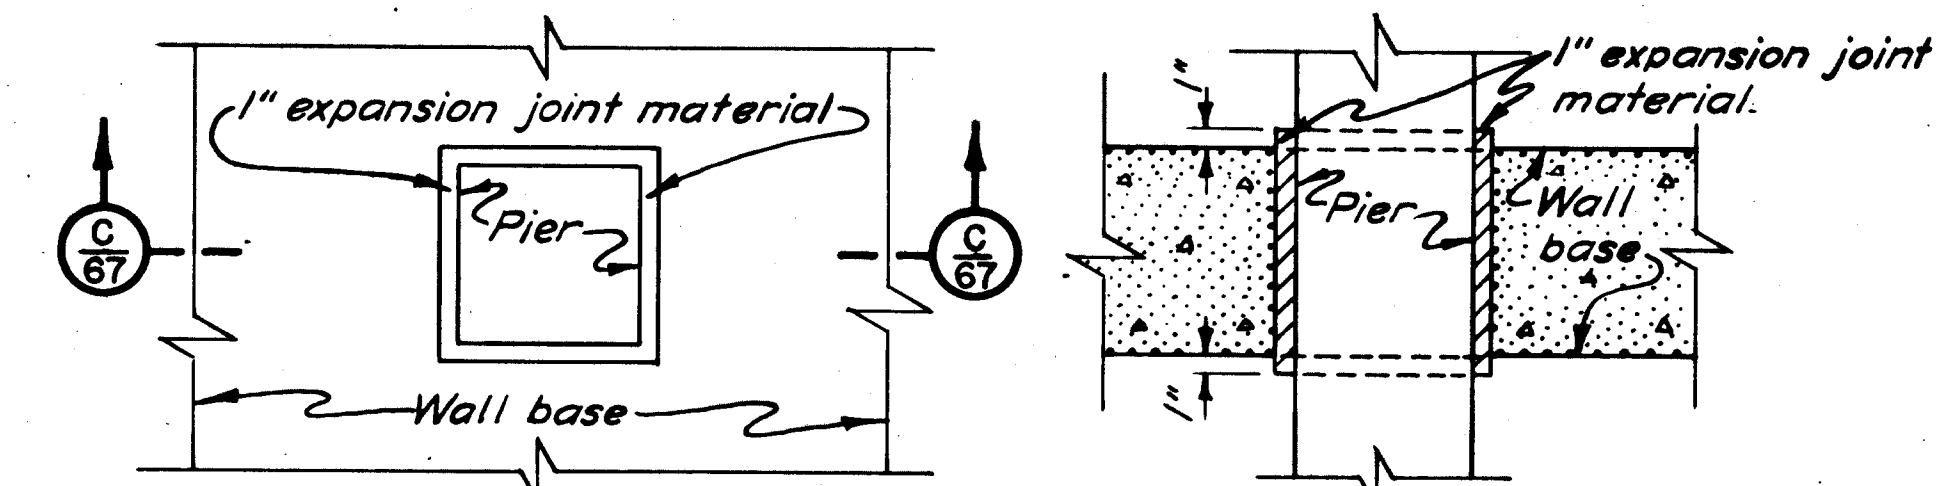


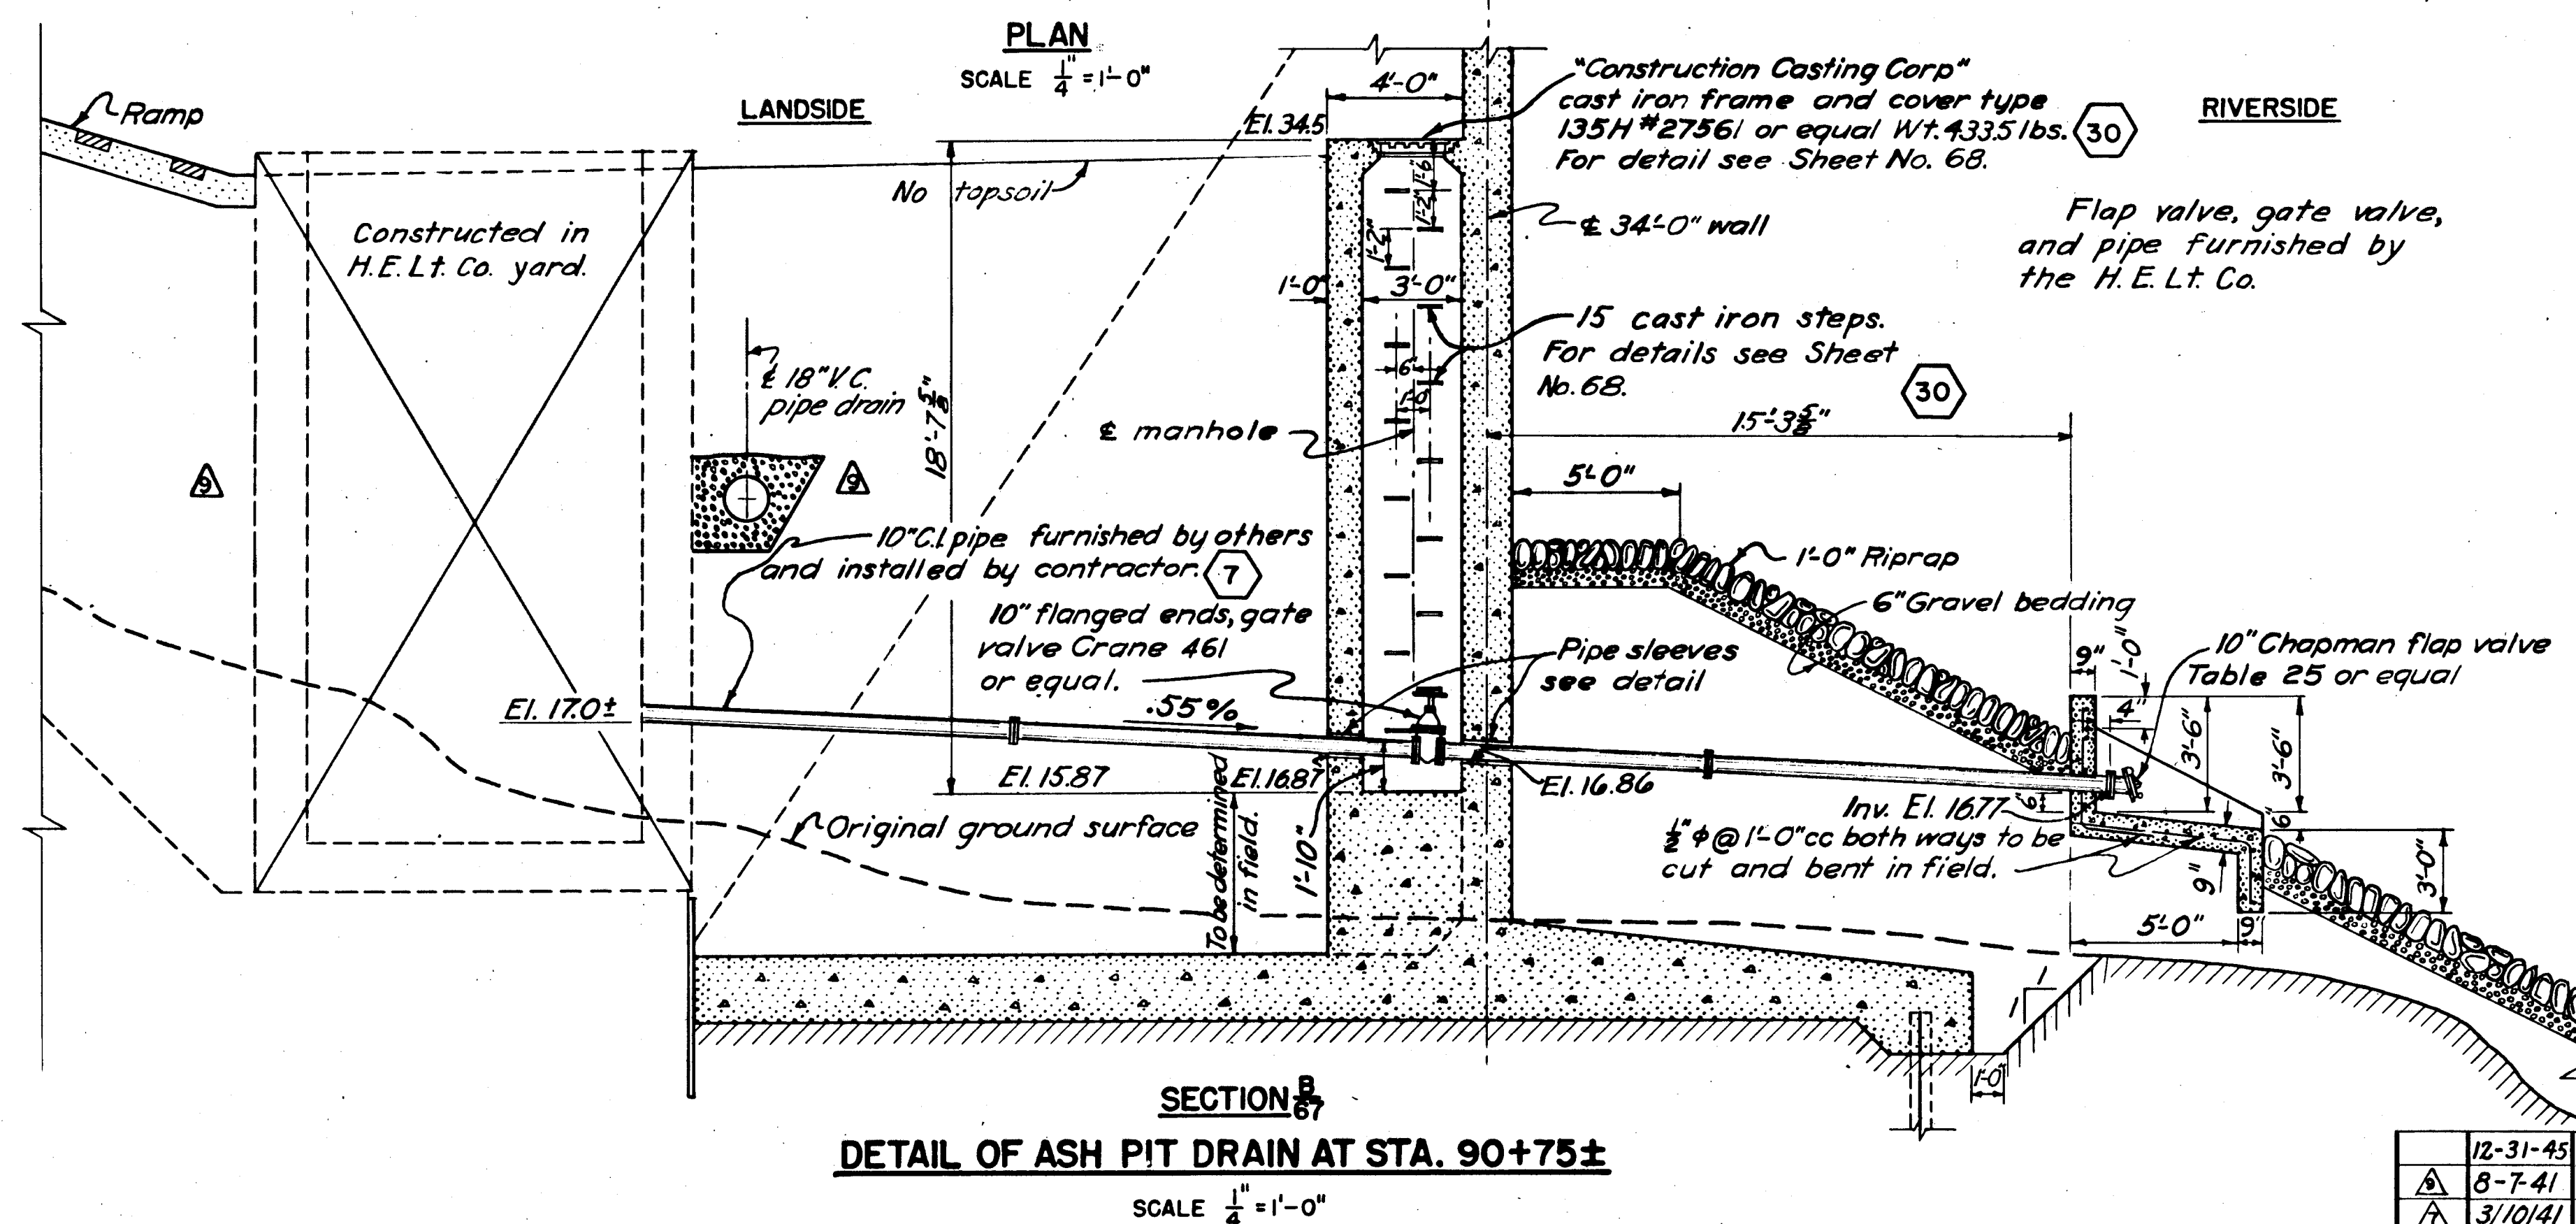

SCALE $\frac{1}{4} = 1'-0"$
12' 9' 6' 3' 0' 6' 12'

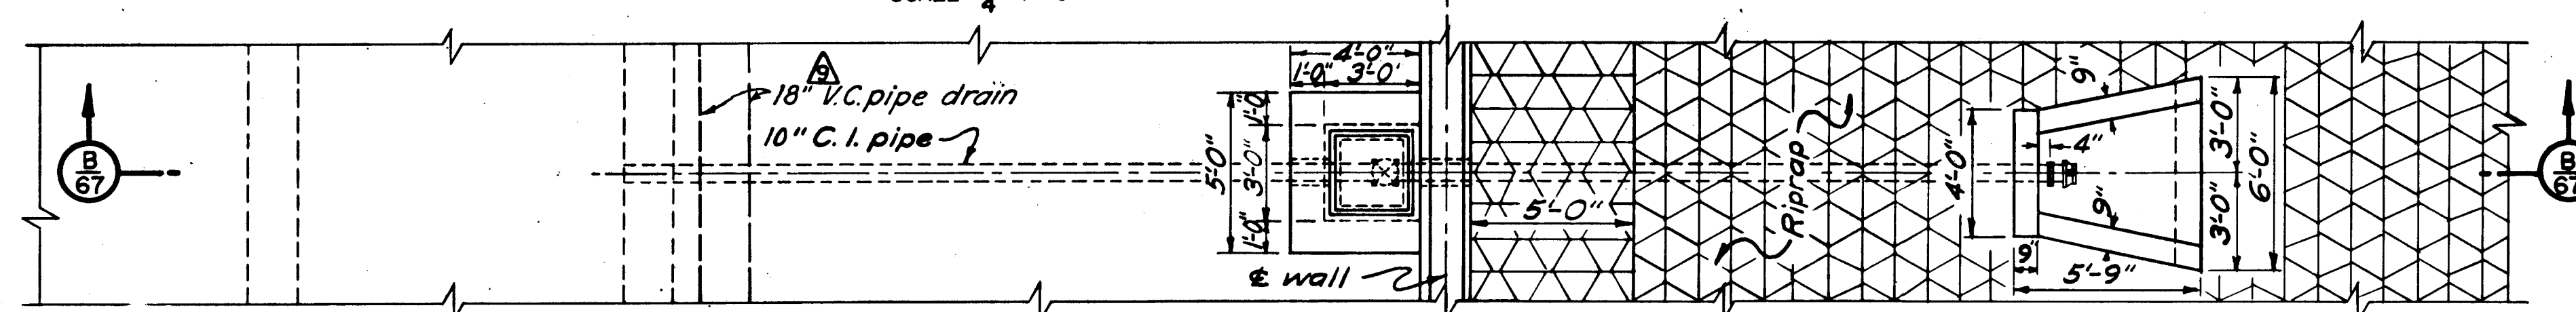

FOR LOCATION SEE SHEET NO. 62
NOT TO SCALE

NOTES

For general notes applying to this sheet see Sheet No. 20.
For Plan and Profile see Sheet No. 62.
For steel reinforcing details see Sheets No. 120 & 126.

CONNECTICUT RIVER FLOOD CONTROL			
HARTFORD DIKE			
RIVERFRONT, MORGAN ST. TO STA. 96+73			
MISCELLANEOUS CONCRETE DETAILS NO. 2			
SOUTH MEADOWS STATION			
CONNECTICUT RIVER		CONNECTICUT	
IN 135 SHEETS		SHEET NO. 67	
SCALE 1/4" = 1'-0"			
U.S. ENGINEER OFFICE, PROVIDENCE, R.I., MAY 1940			
SUBMITTED:		APPROVED:	
DESIGNED:		CHECKED:	
DRAWN:		FISCAL YEAR 1940	
FILE NO. CT-4-2527			

12-31-45	As built revisions			
8-7-41	18" V.C. pipe drain relocated	WQE	WQE	WQE
3/10/41	Curtain wall removed.	WQE	WQE	WQE
KEY	DATE	REVISION (Indicated by Δ)	REV. BY	CK. BY